
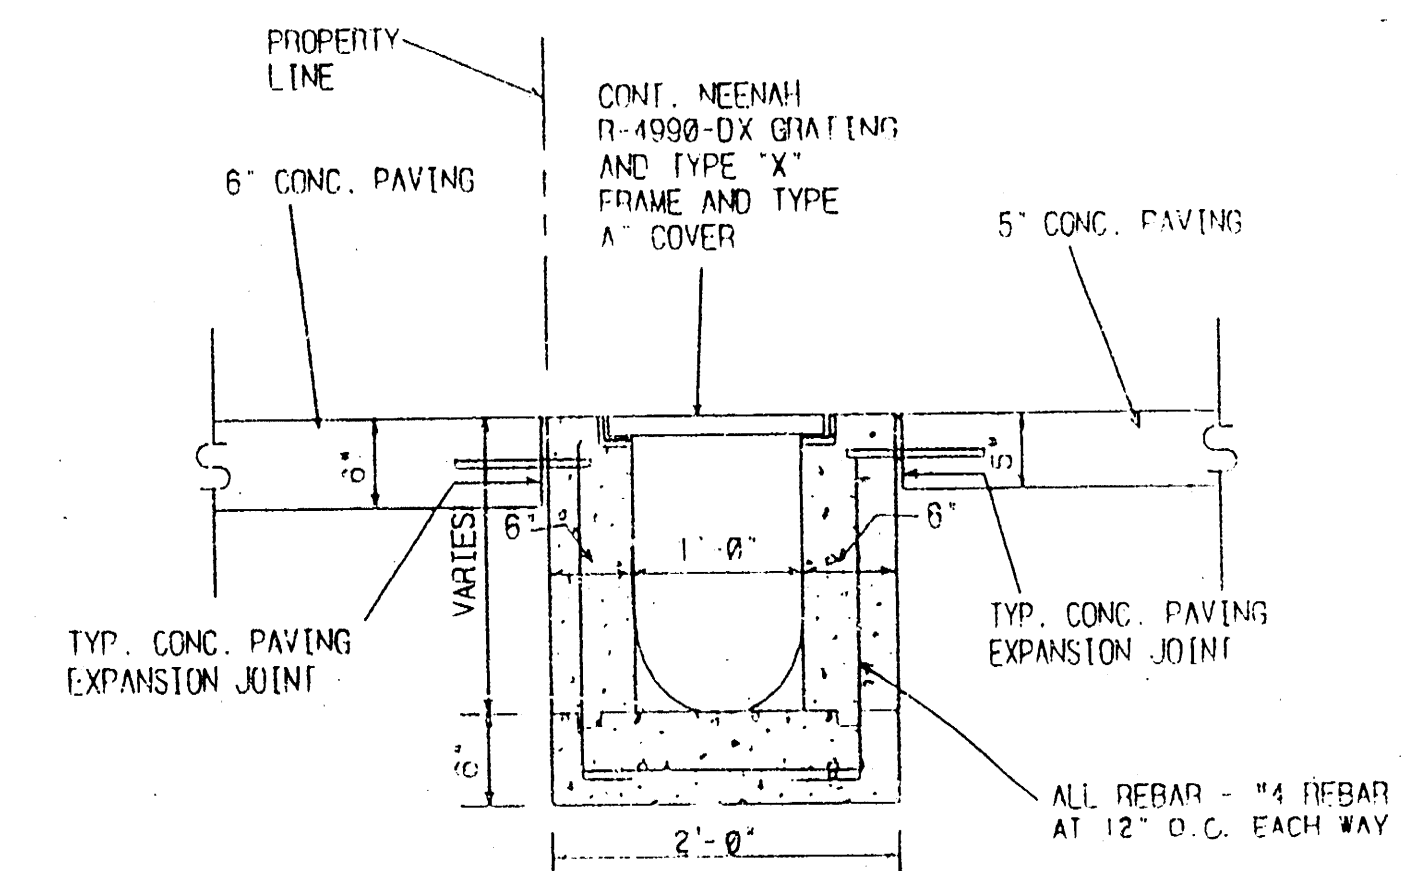


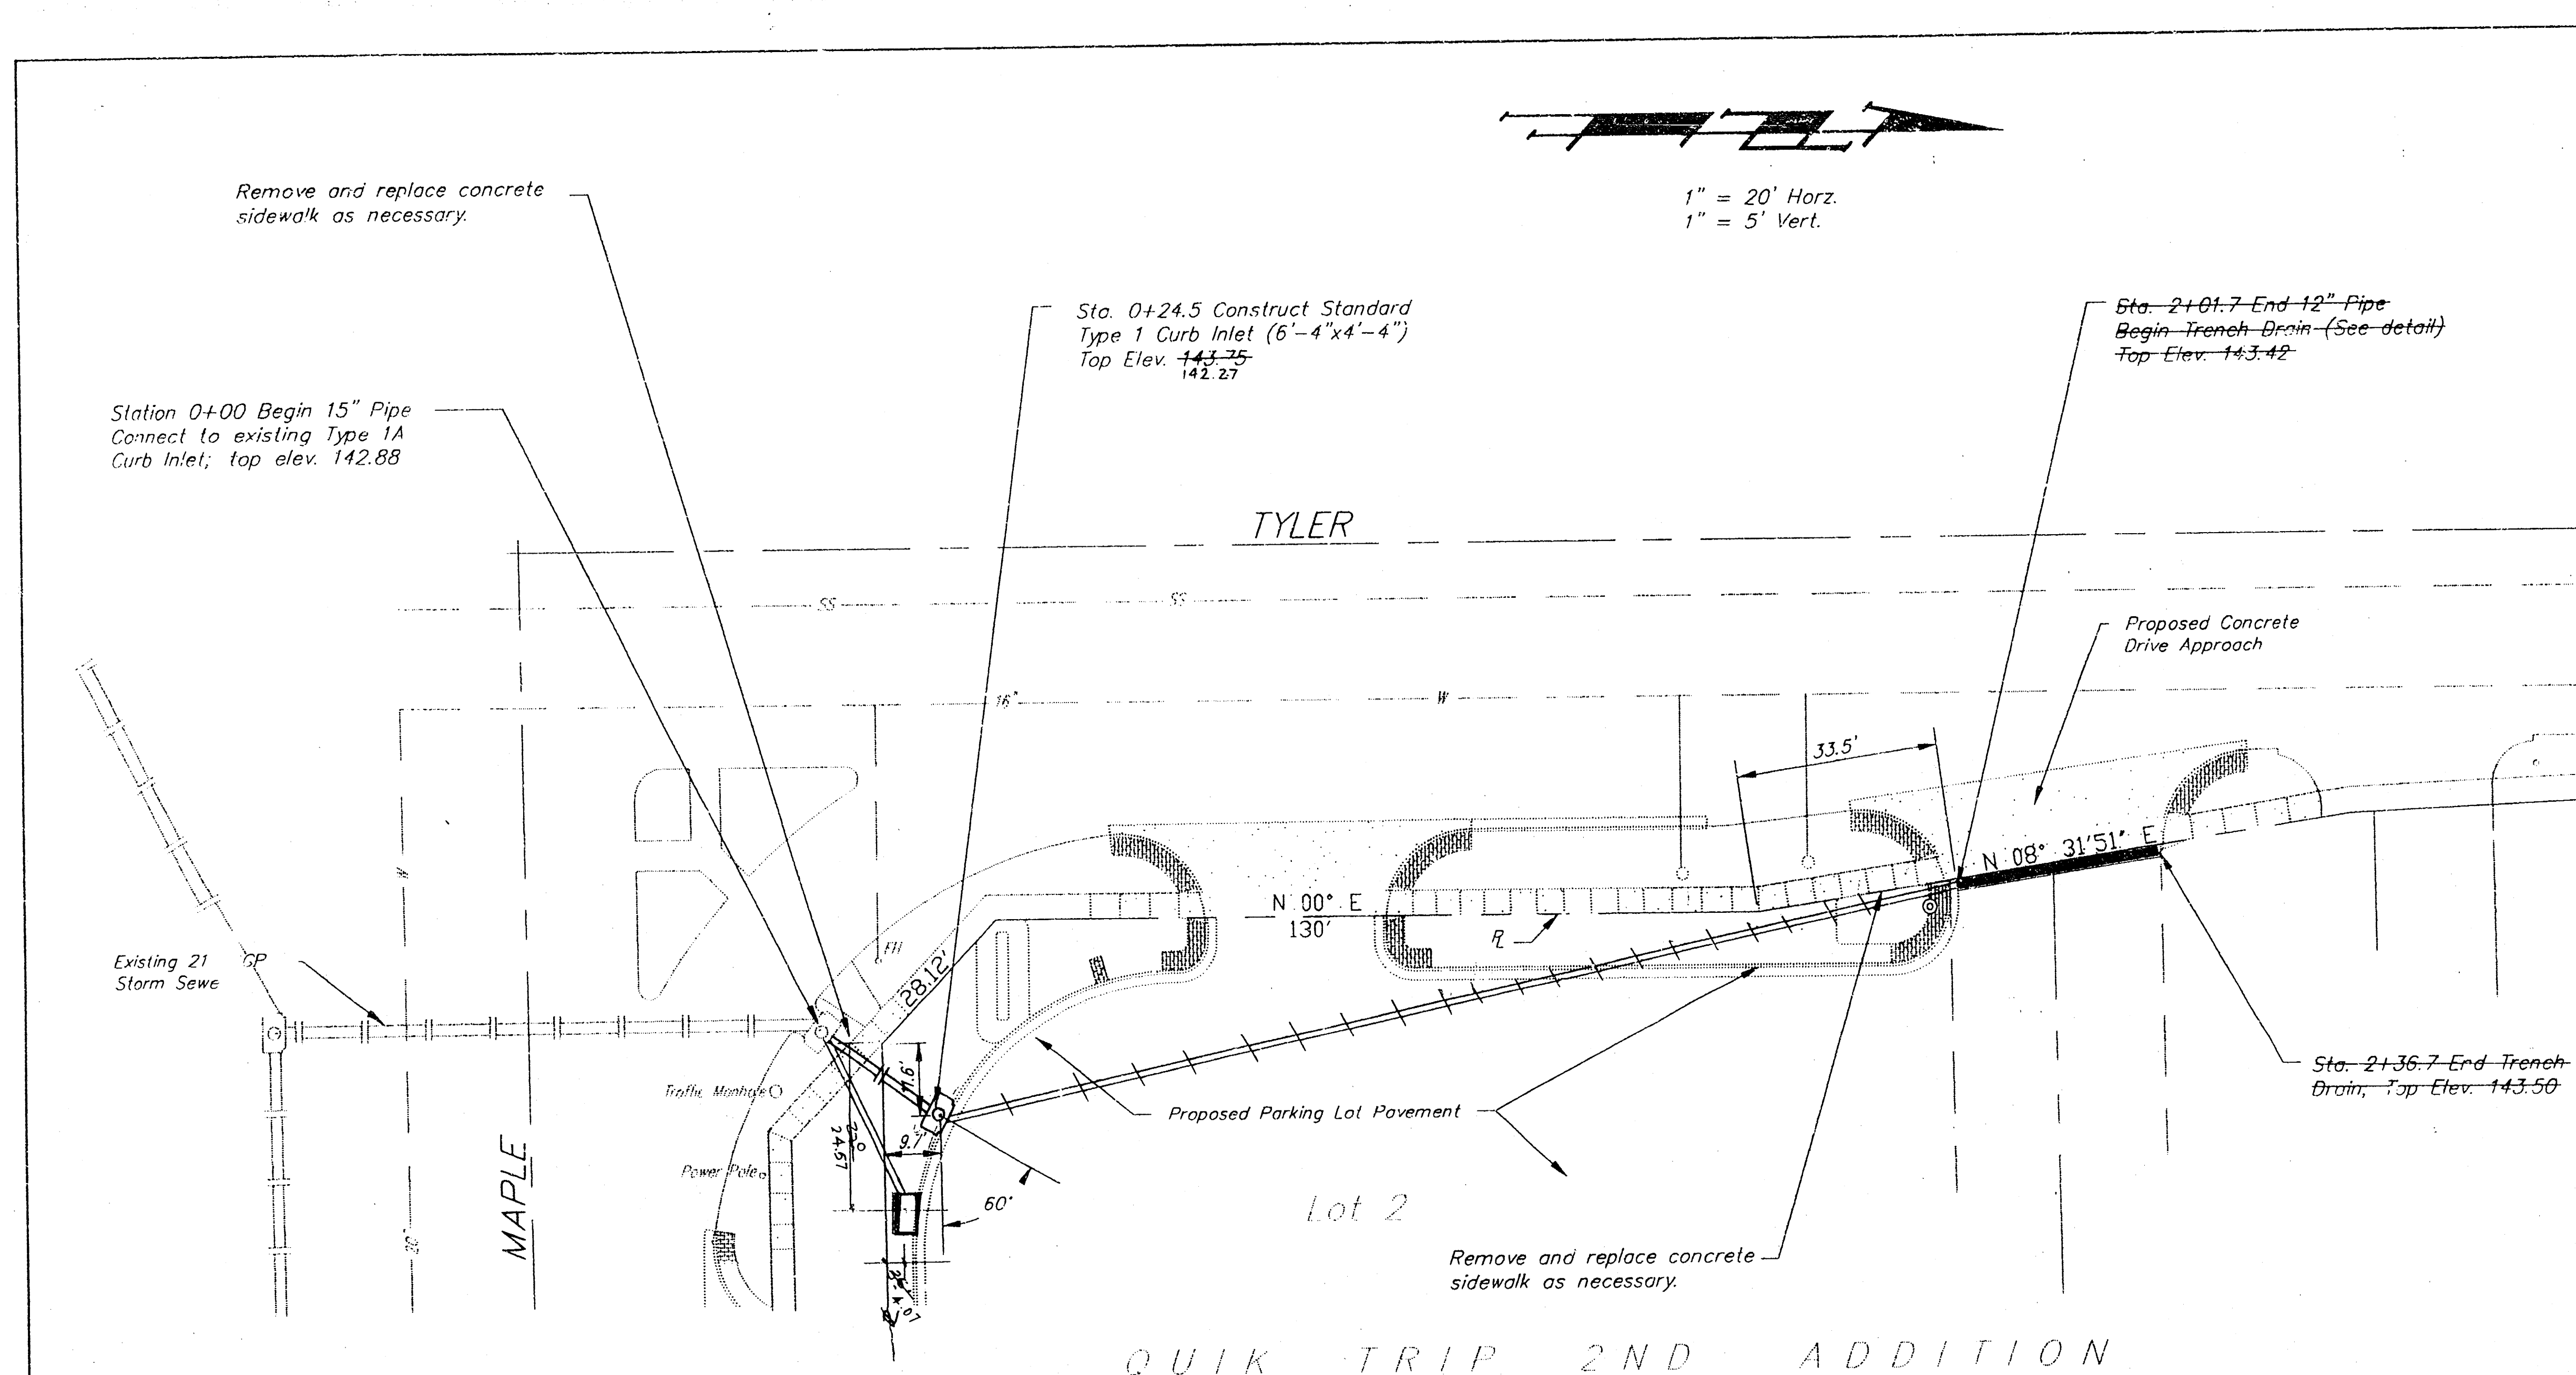

TRENCH DRAIN SECTION

SCALE: 3/4" = 1'-0"

BENCH MARK:

City Standard Disc, located 50.7 feet north and 39.0 feet
east of the center lines of Tyler Road and Maple Street,
on concrete island at northeast corner of intersection;
Elev. 144.12, City Datum


NOTE TO CONTRACTOR:

INSPECTION AND TEST FOR THIS PROJECT, FROM STATION 0+00
TO STATION 0+24.5, IS TO BE PROVIDED BY A LICENSED CON-
SULTING ENGINEERING FIRM UNDER CONTRACT WITH THE OWNER/
DEVELOPER. SAID INSPECTION TO BE IN ACCORDANCE WITH THE
CITY OF WICHITA STANDARD CONSTRUCTION ENGINEERING PRAC-
TICES AND CERTIFIED BY A LICENSED PROFESSIONAL ENGINEER.
NO WORK SHALL BE PERFORMED IN DEDICATED EASEMENTS OR
PUBLIC RIGHT-OF-WAY BY THE CONTRACTOR WITHOUT SUCH IN-
SPECTION, NOR SHALL ANY WORK BE COMMENCED WITHOUT
WRITTEN AUTHORIZATION BY THE CITY ENGINEER.

APPROVED AS NOTED
By CITY ENGINEER OF WICHITA

Sanitary Sewers _____
Storm Sewers VRH 9/13/90
Driveway Approaches _____
Water Mains _____
Paving _____

As Built 6-8-93 A.Z.

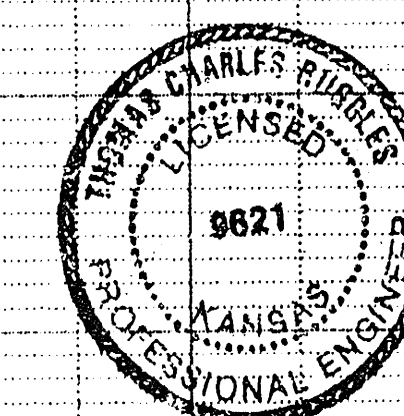

QUICK TRIP 2ND ADDITION PRIVATE STORM SEWER QUICK TRIP 343R					
BAUGHMAN COMPANY P.A. SURVEYING & ENGINEERING 316/262-7271 • 315 ELLIS • WICHITA, KANSAS 67211					
PROJECT NUMBER 266 PPS 607861					
DESIGN TCR	DRAWN TCR	APPROVED	DATE 9-11-90	SCALE 1" = 20'	SHEET 1 OF 2

