


PLAN	DATE	BY	CHKD
REVISIONS			
NOTED			
ALIGNED			
CHECKED			
NO.			

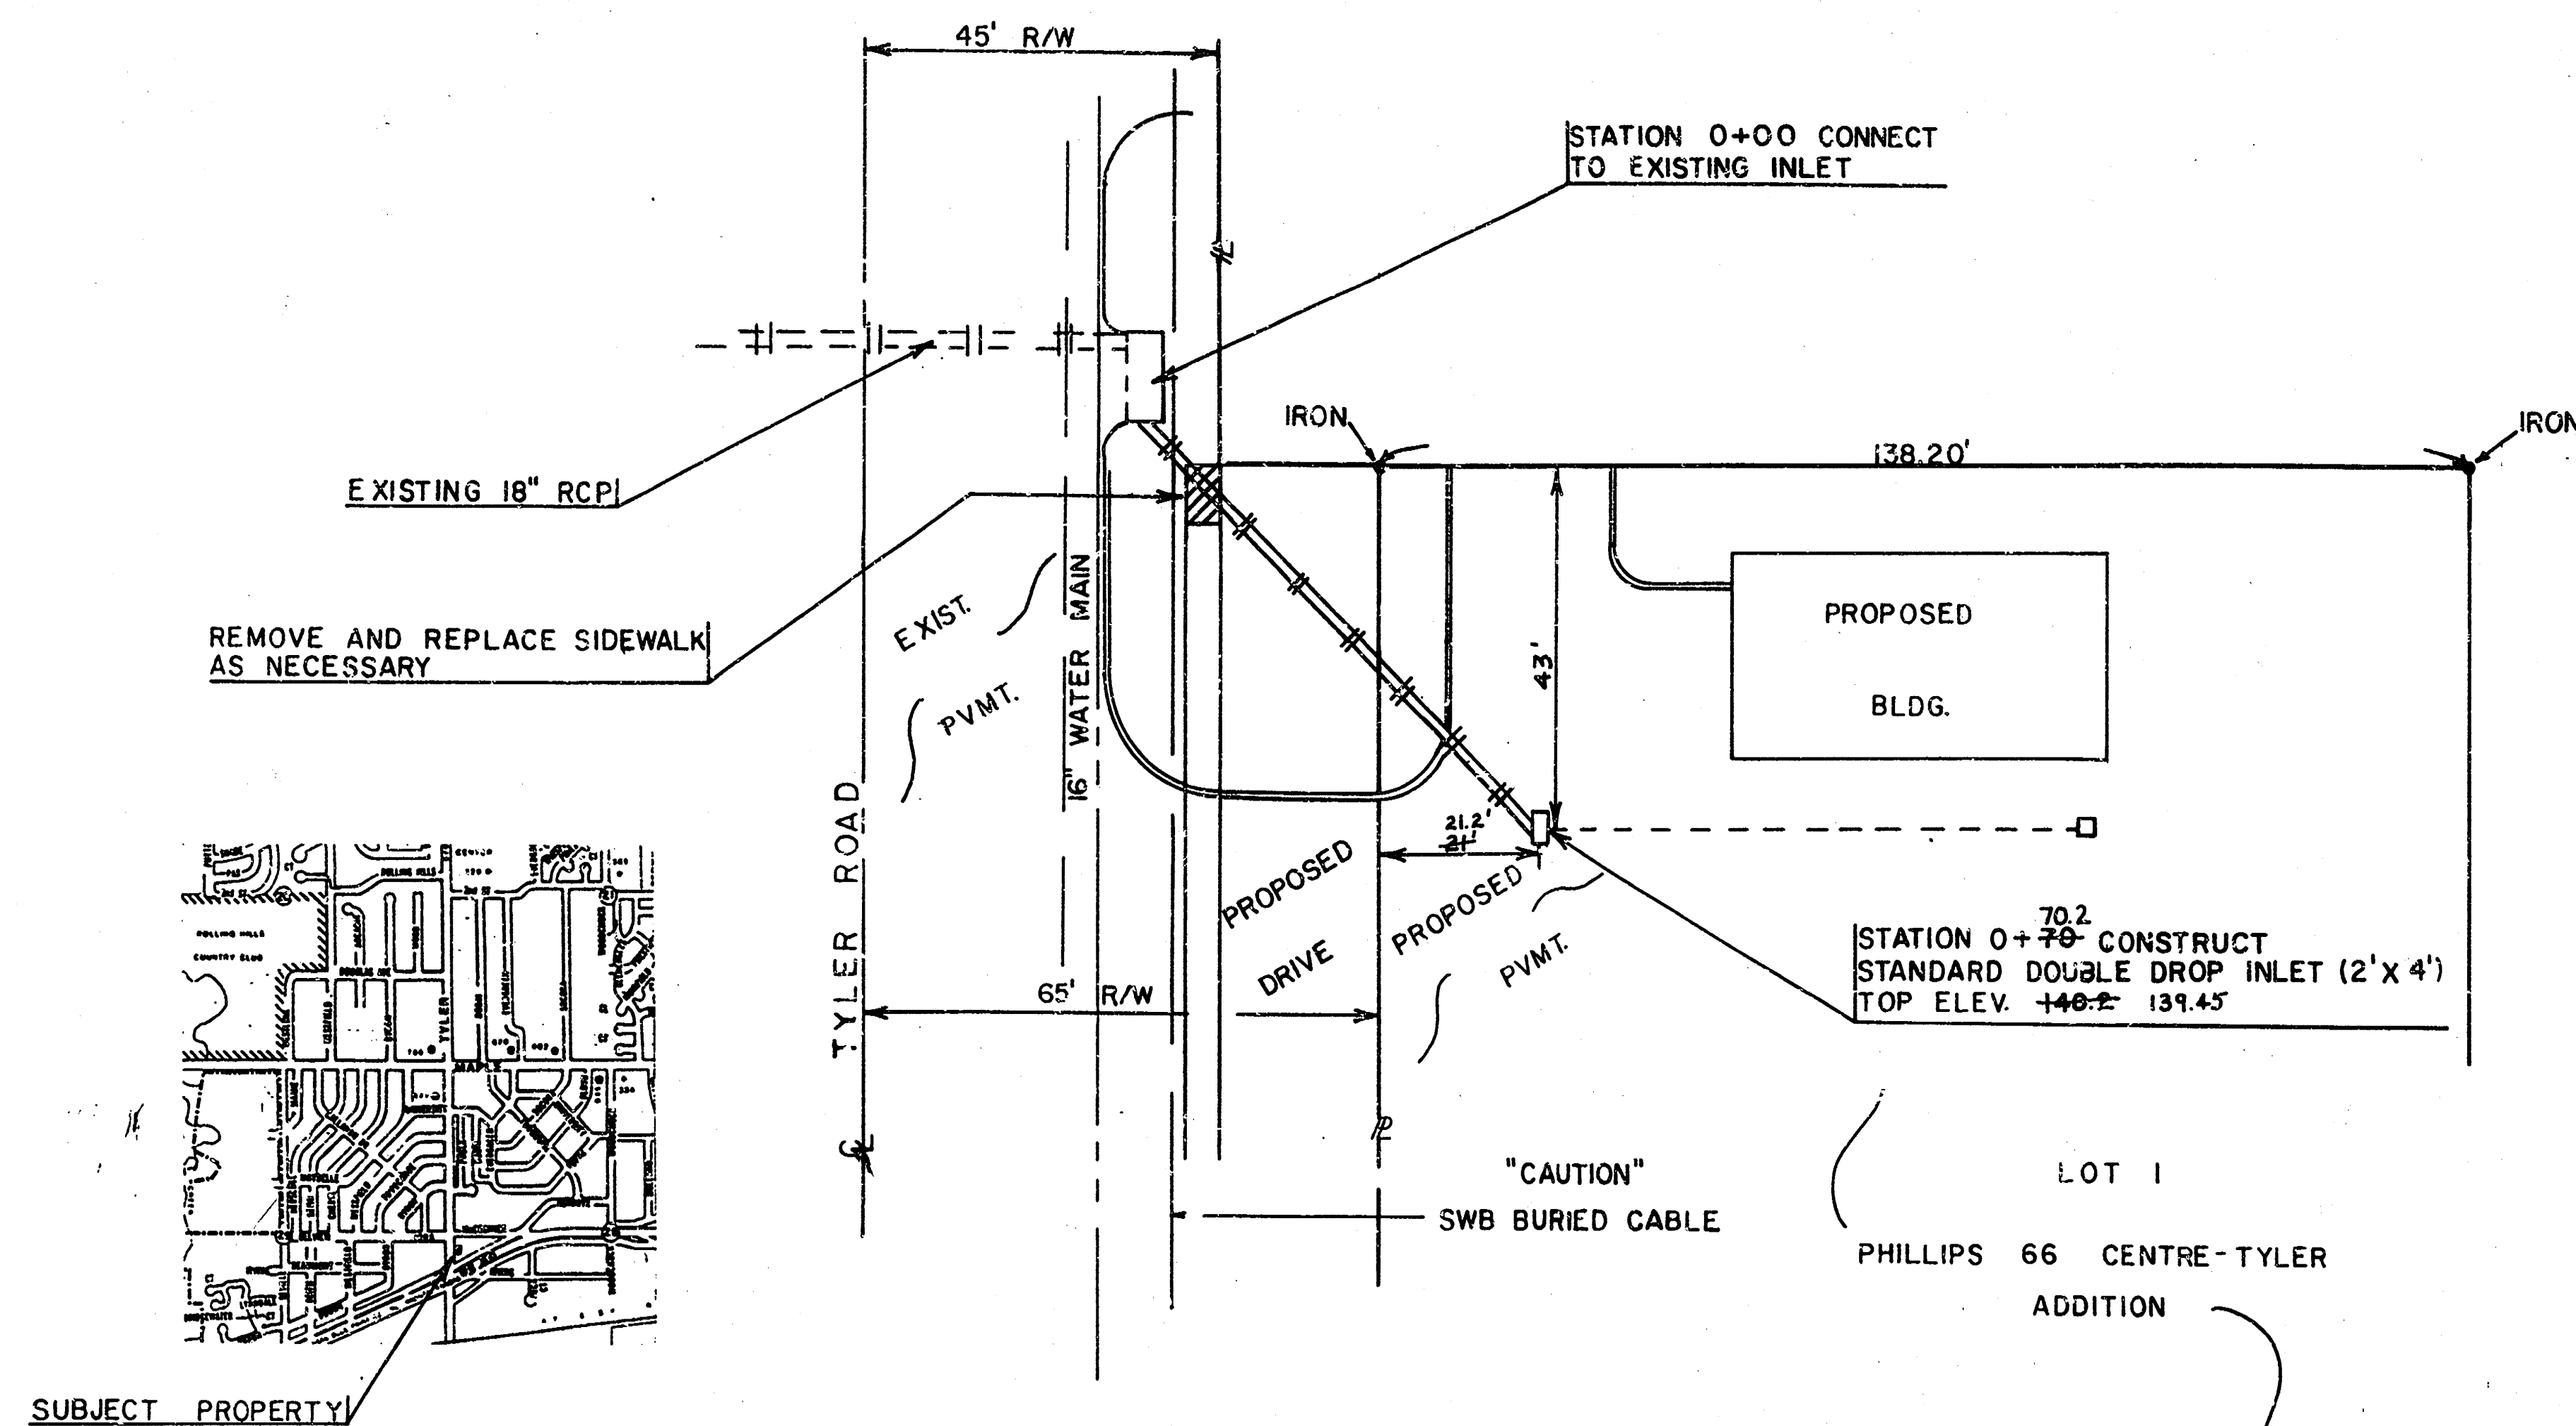

BENCH MARK:
Chiseled square on top of curb
east side inlet, north side of
Kellogg frontage road on south
side of U.S. 54, approx. 330' west
of E. Tyler.
Elev. = 135.35 City Datum

APPROVED AS NOTED
By CITY ENGINEER OF WICHITA

Sanitary Sewers _____

Storm Sewers VRH 3/8/91

Driveway Approaches _____

Water Mains _____



Paving _____

NOTE TO CONTRACTOR

INSPECTION AND TESTING FOR THIS PROJECT IS TO BE PROVIDED BY A LICENSED CONSULTING ENGINEERING FIRM UNDER CONTRACT WITH THE OWNER/DEVELOPER. SAID INSPECTION TO BE IN ACCORDANCE WITH THE CITY OF WICHITA STANDARD CONSTRUCTION ENGINEERING PRACTICES AND CERTIFIED BY A LICENSED PROFESSIONAL ENGINEER. NO WORK SHALL BE PERFORMED IN DEDICATED EASEMENTS OR PUBLIC RIGHT-OF-WAY BY THE CONTRACTOR WITHOUT SUCH INSPECTION NOR SHALL ANY WORK BE COMMENCED WITHOUT WRITTEN AUTHORIZATION BY THE CITY ENGINEER.

Scale: 1" = 20' PLAN
1" = 5' PROFILE
o = IRON

PROFILE	DATE	BY	CHKD
REVISIONS			
NOTED			
ALIGNED			
CHECKED			
NO.			

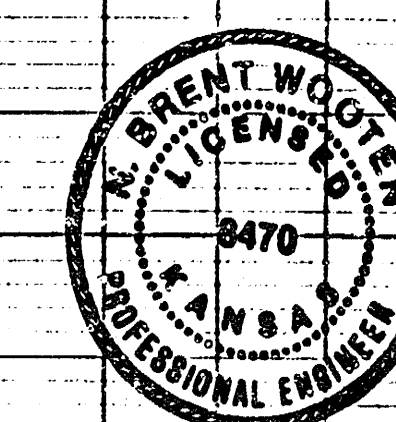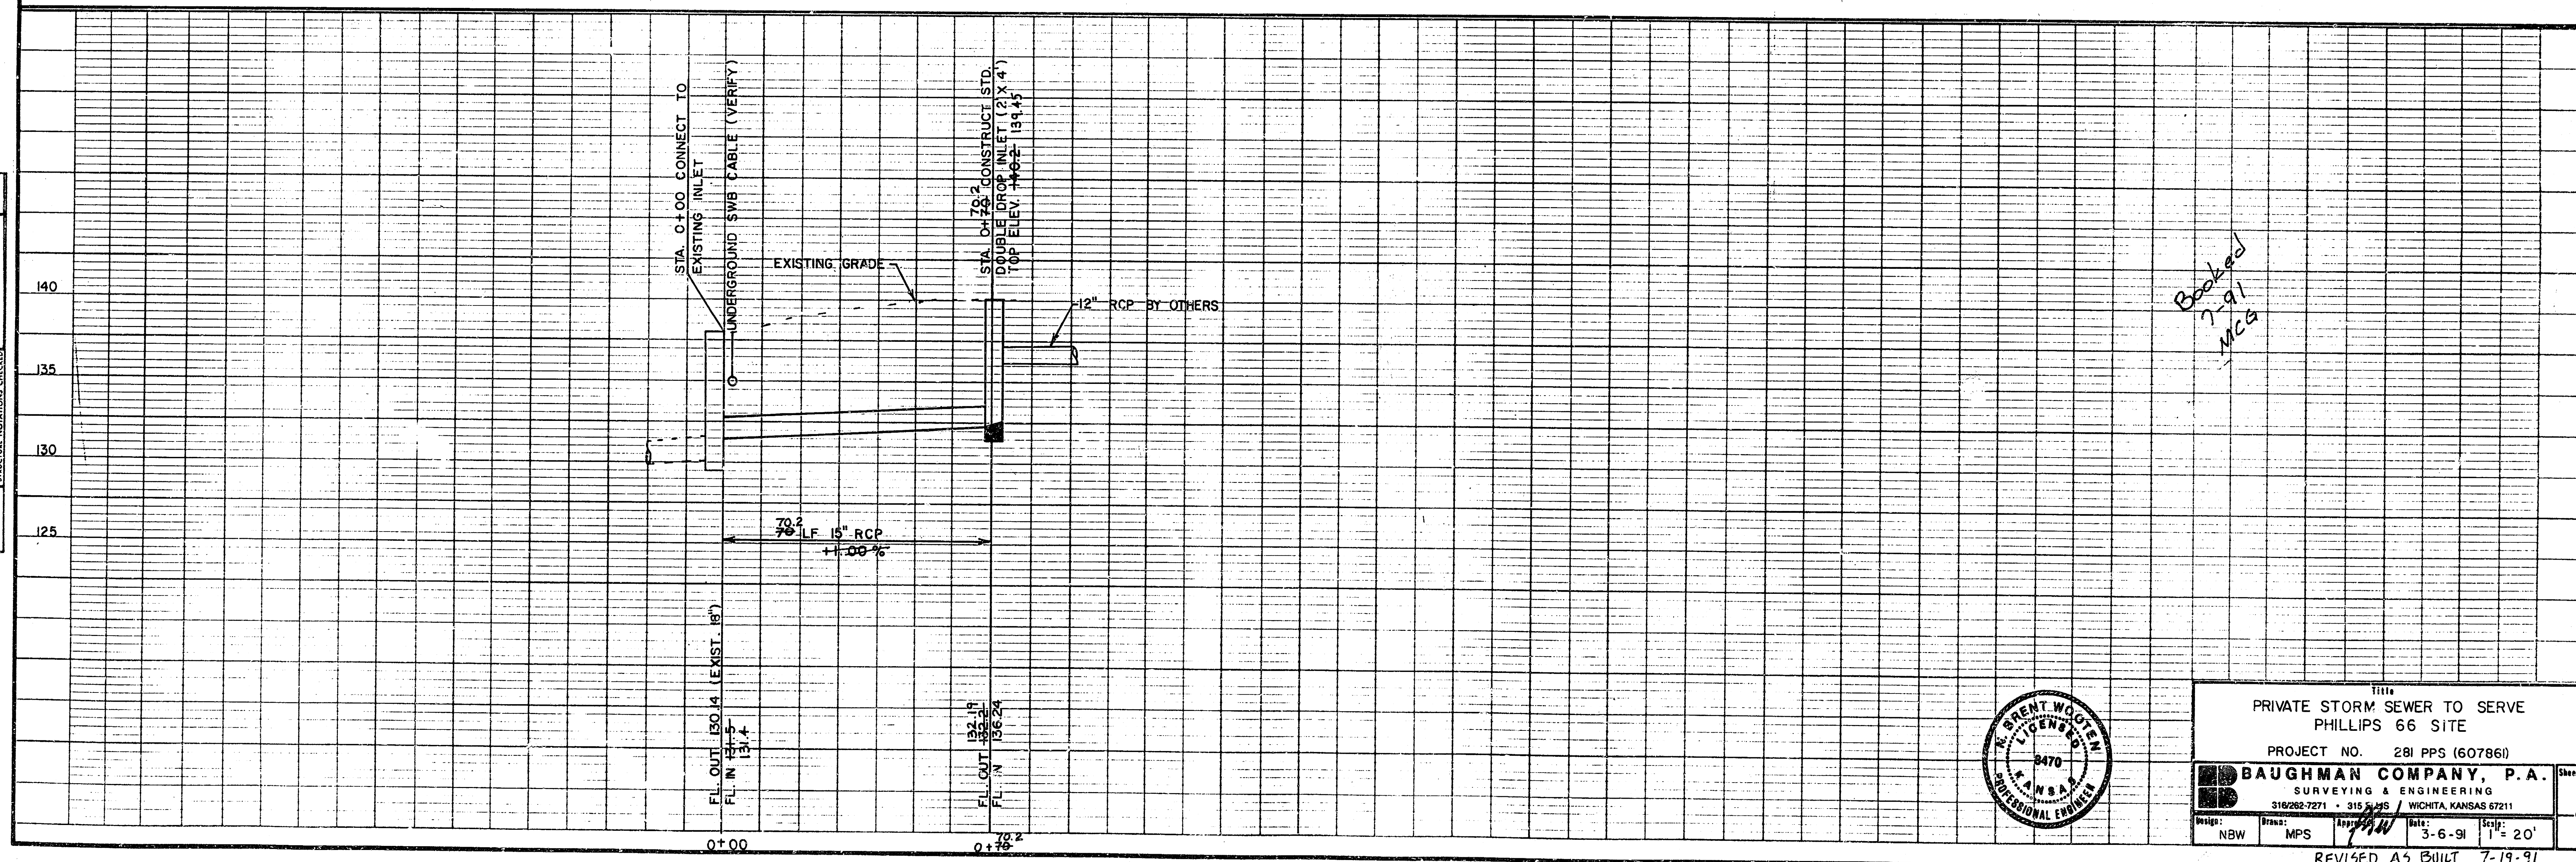

PRIVATE STORM SEWER TO SERVE PHILLIPS 66 SITE			
PROJECT NO. 281 PPS (60786)			
BAUGHMAN COMPANY, P.A. SURVEYING & ENGINEERING 316/262-7271 • 315 S. W. 31st St. • WICHITA, KANSAS 67211			
Design: NBW	Drawn: MPS	Date: 3-6-91	Scale: 1" = 20'
REVISED AS BUILT 7-19-91			

FILMED FROM THE BEST
AVAILABLE COPY