



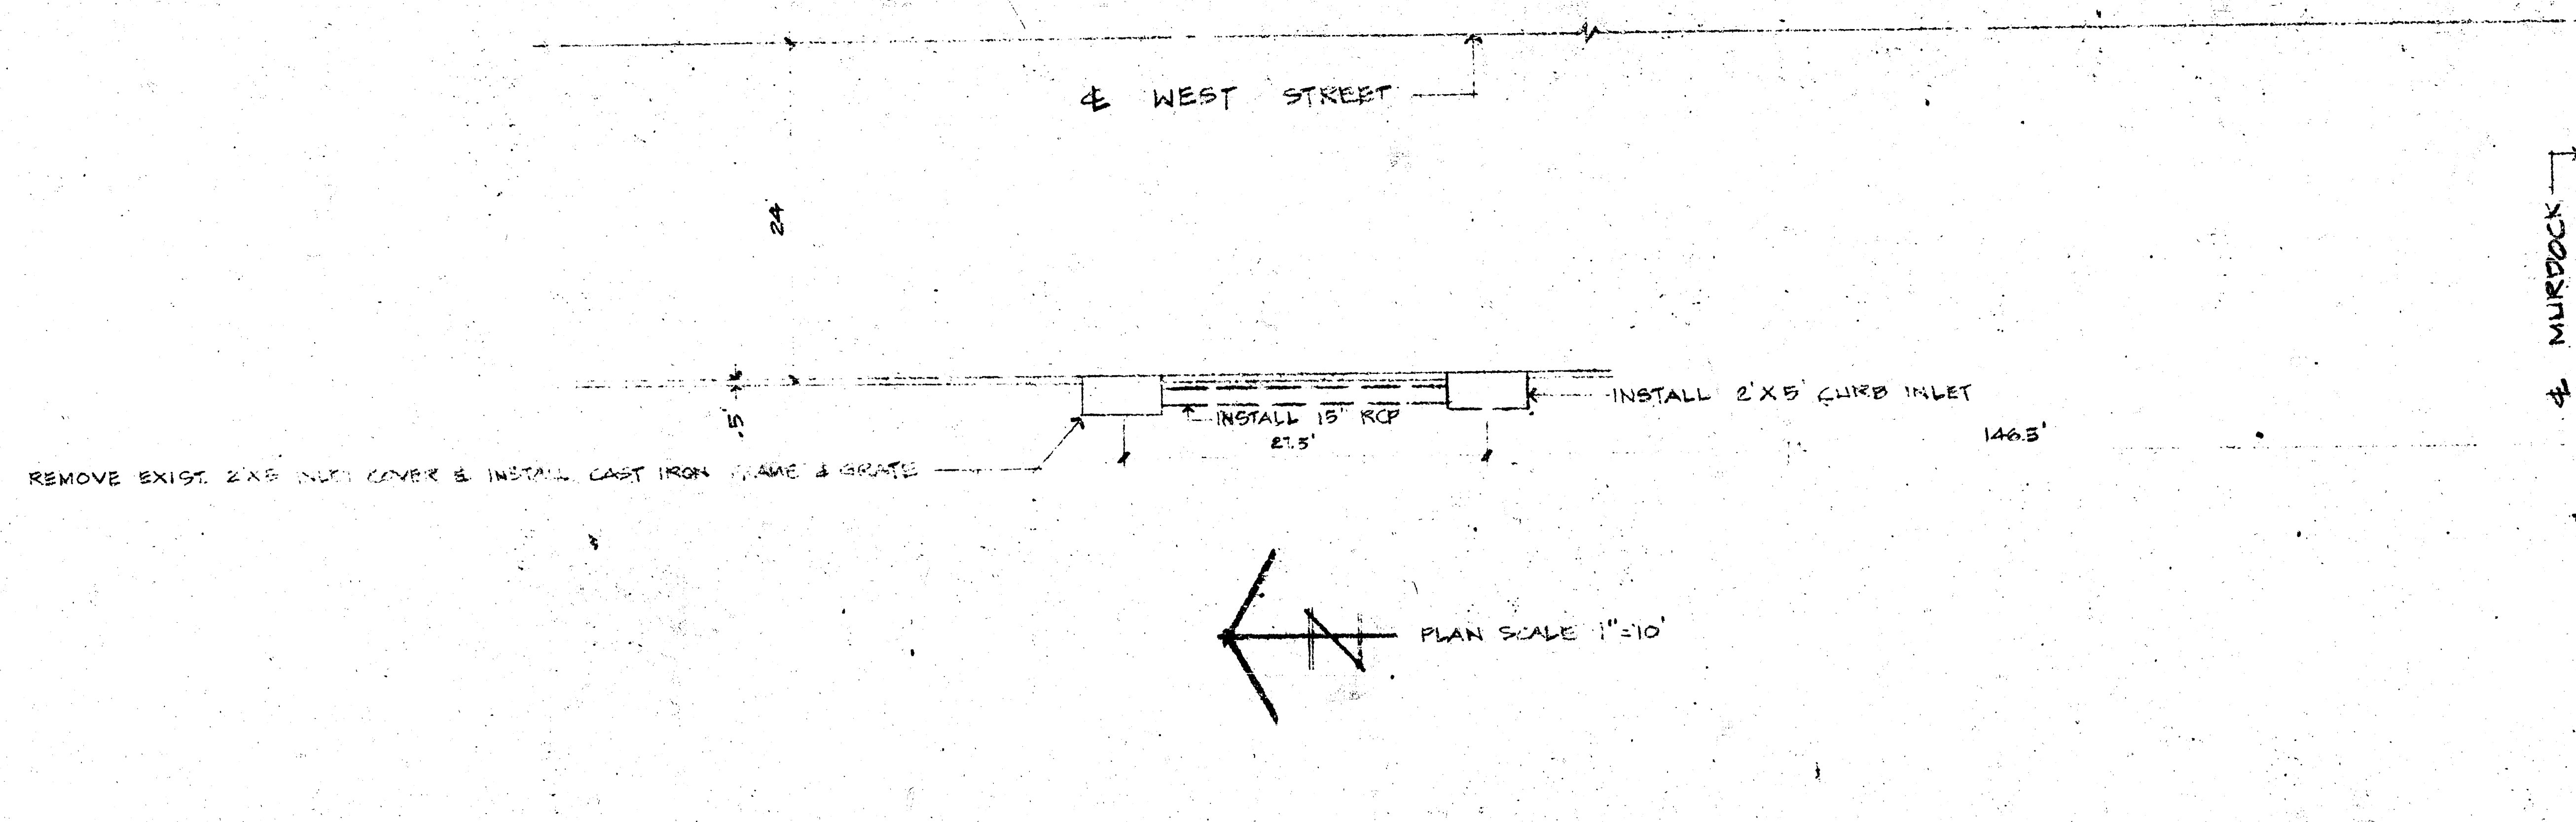

PROFILE SCALE - HORIZ. 1"=10'
VERT. 1"=2'

FRENCH MAN'S VILLAGE
2" N. GLOBE 1" SCALE OF SOUTH END RADIUS. SW. COR. WEST ST. & PNE

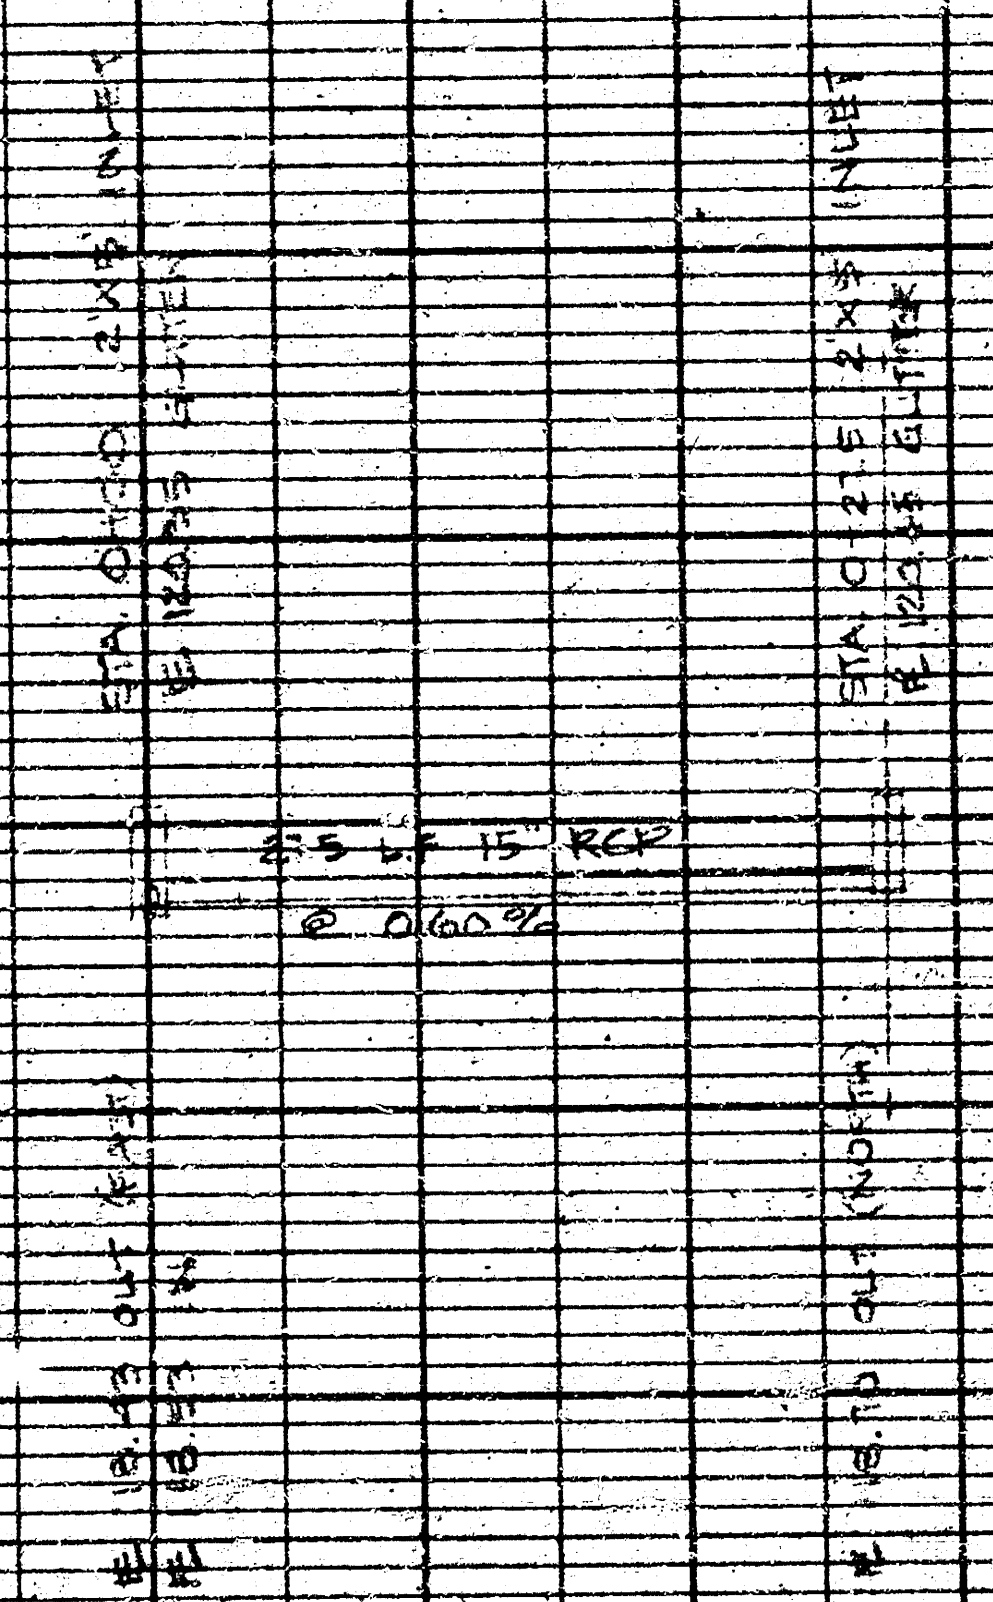

UTILITY CONTRACTORS
AS BUILT STORM SEWER PLAN
217 N. WEST ST.
DATE: JULY 11, 2021