
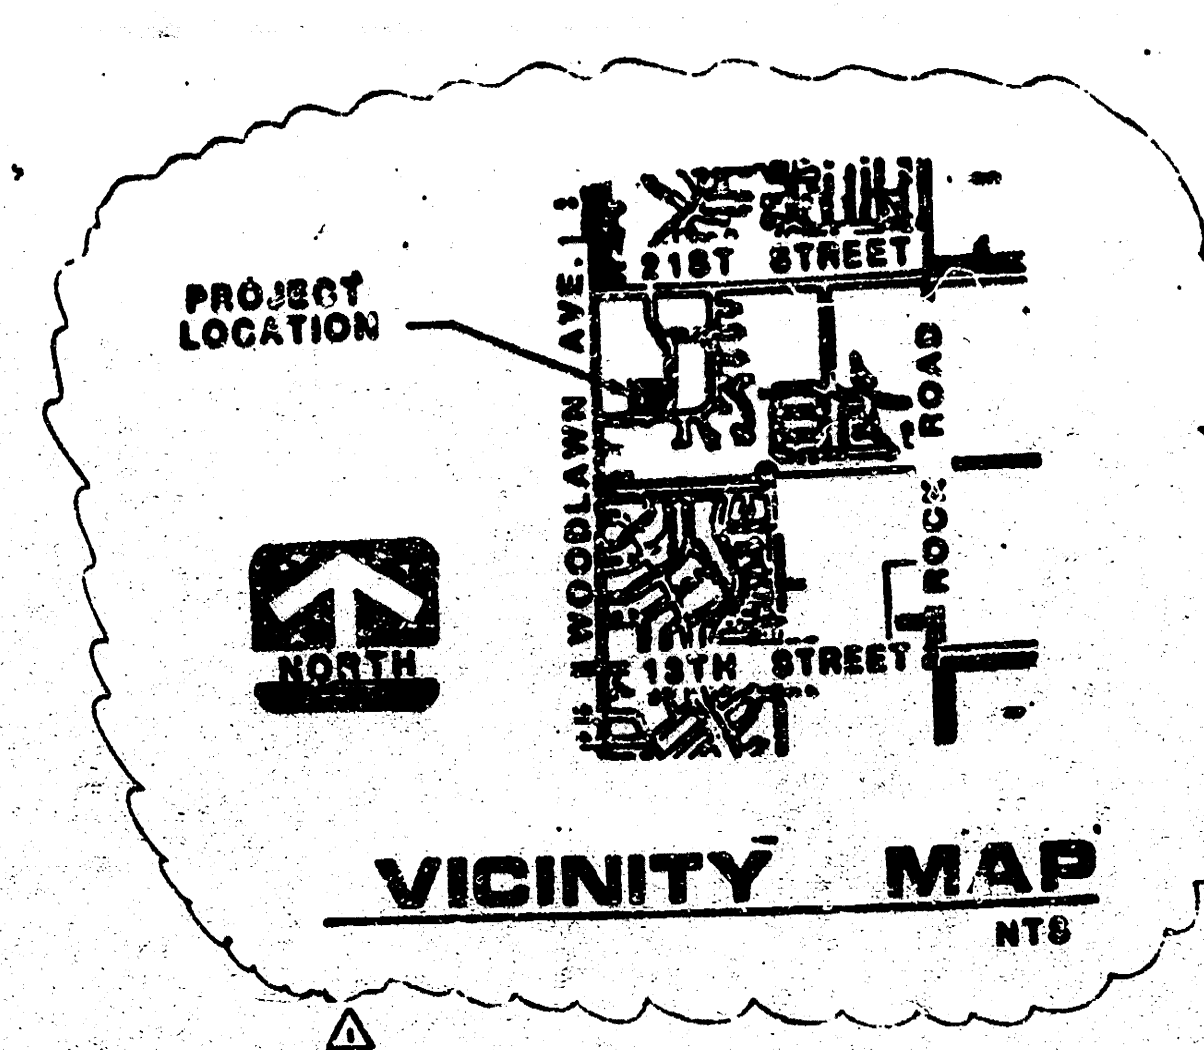
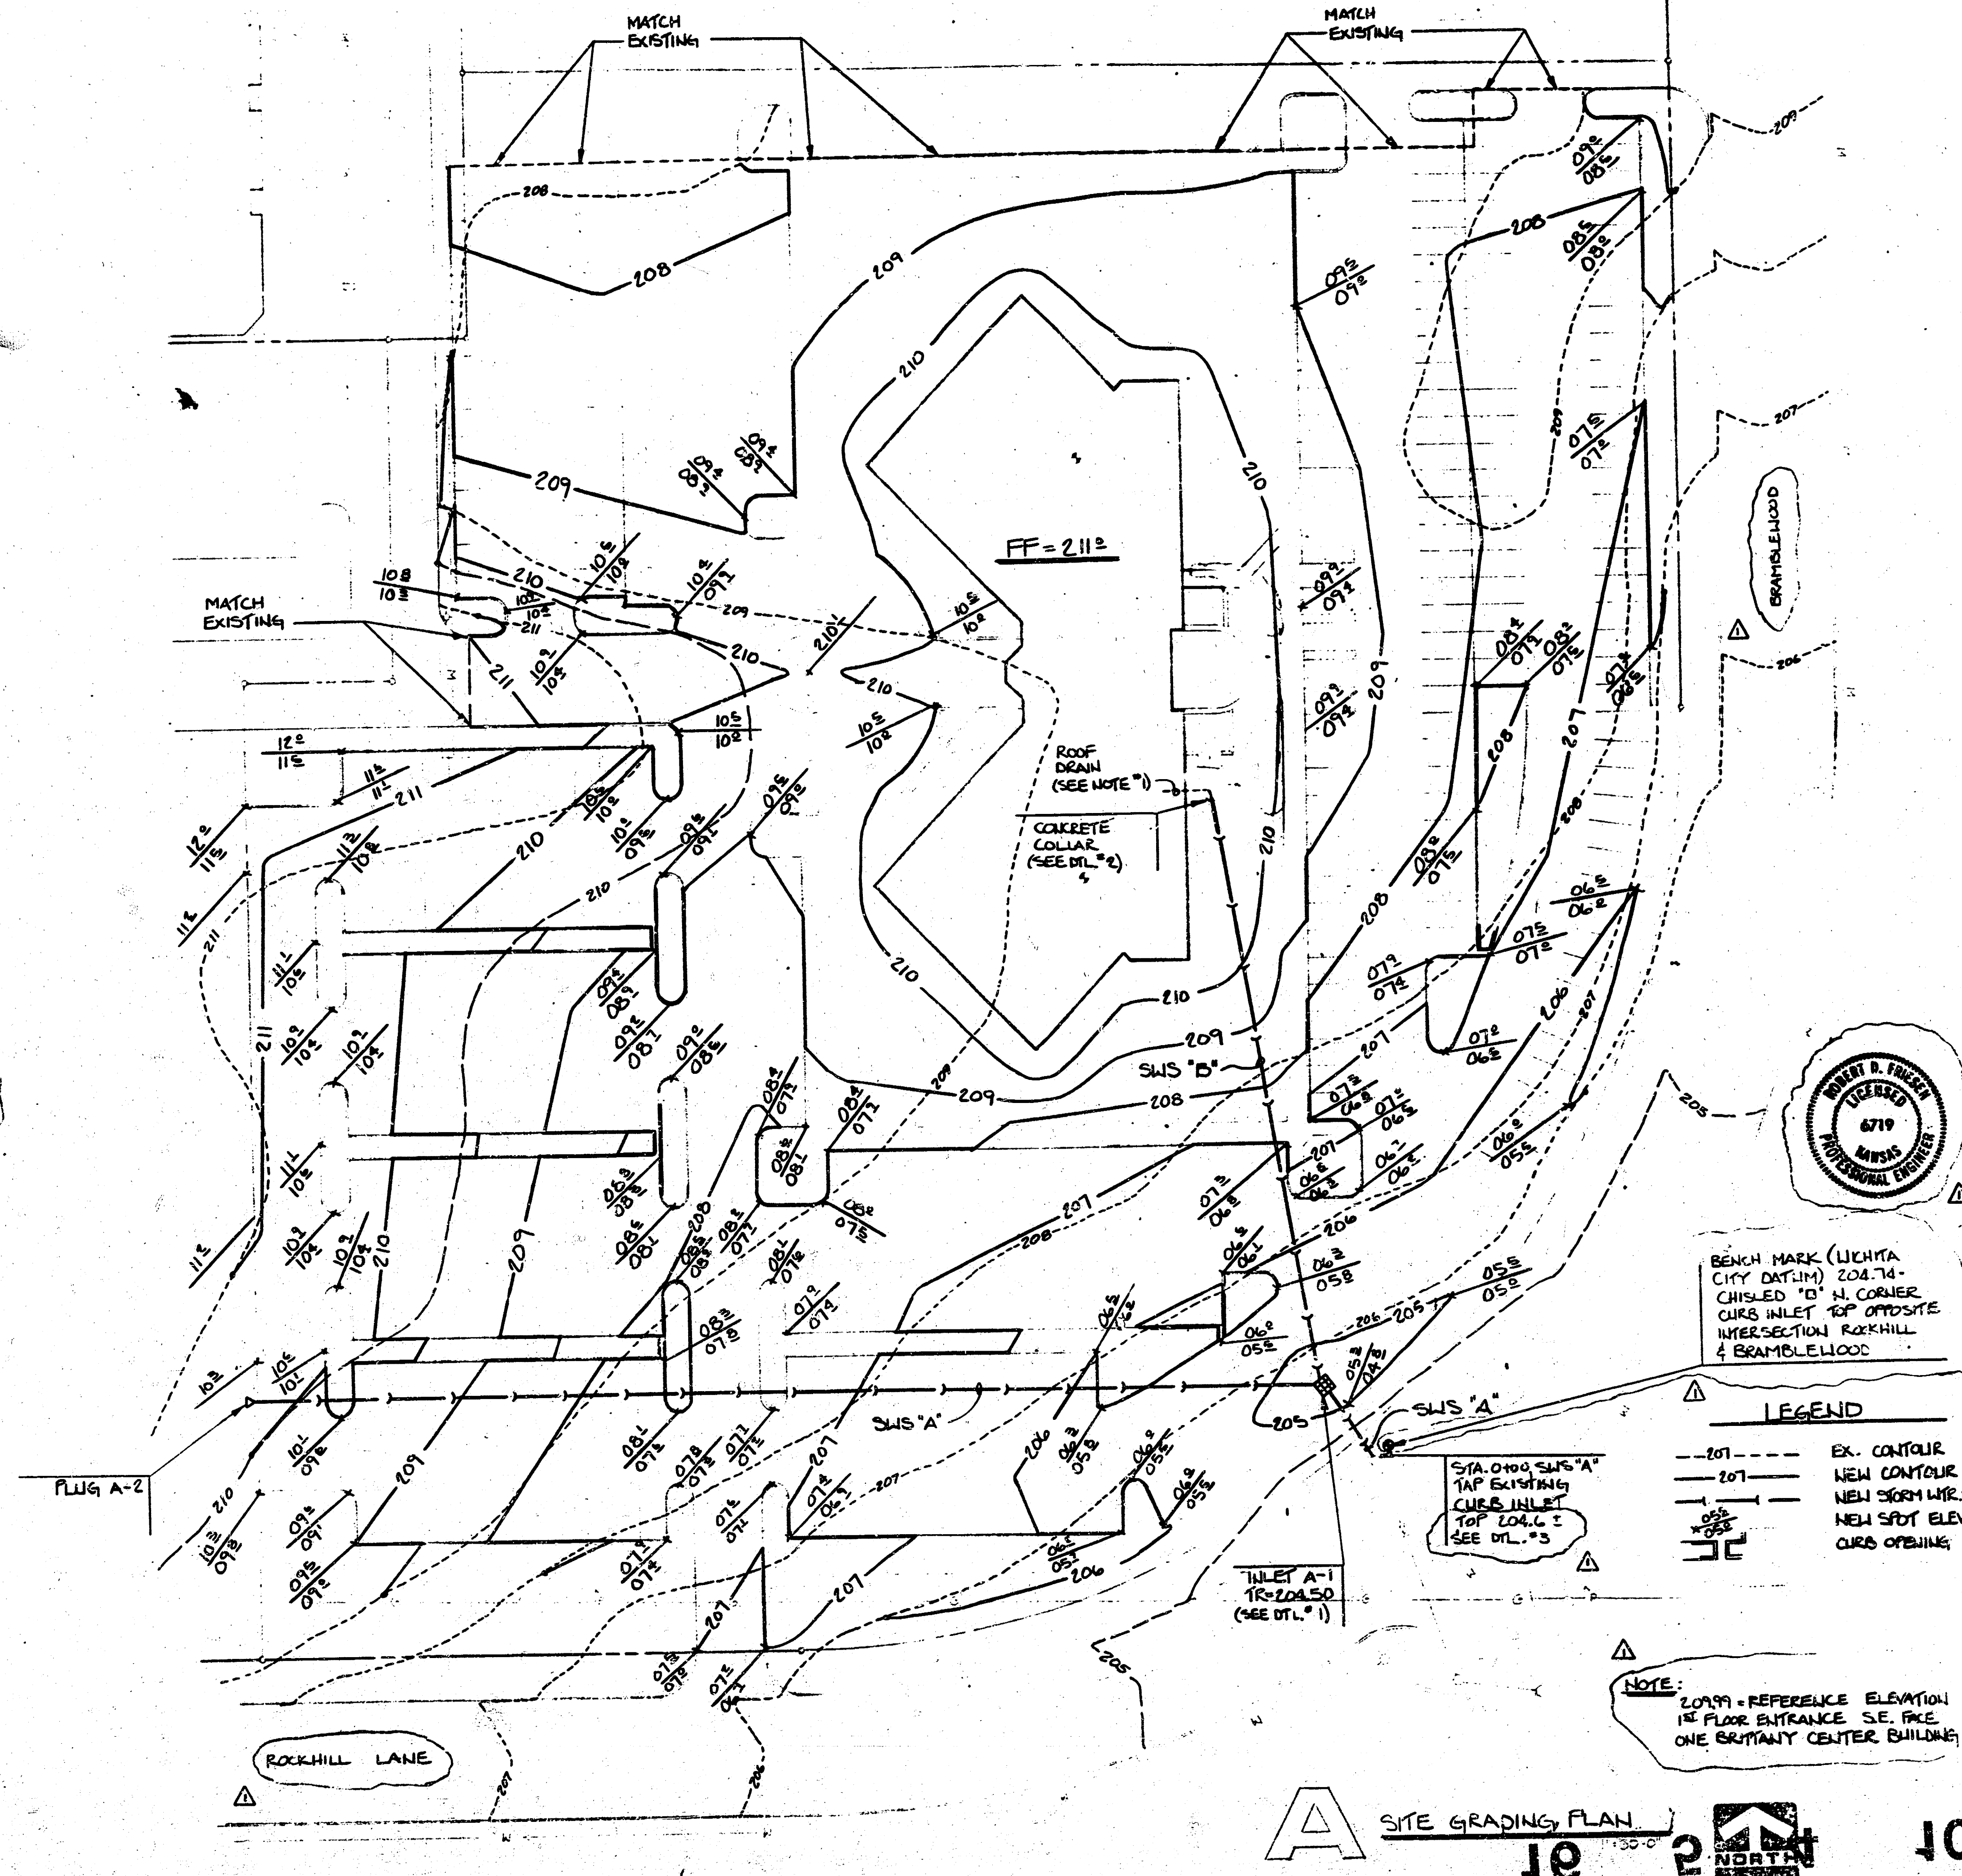


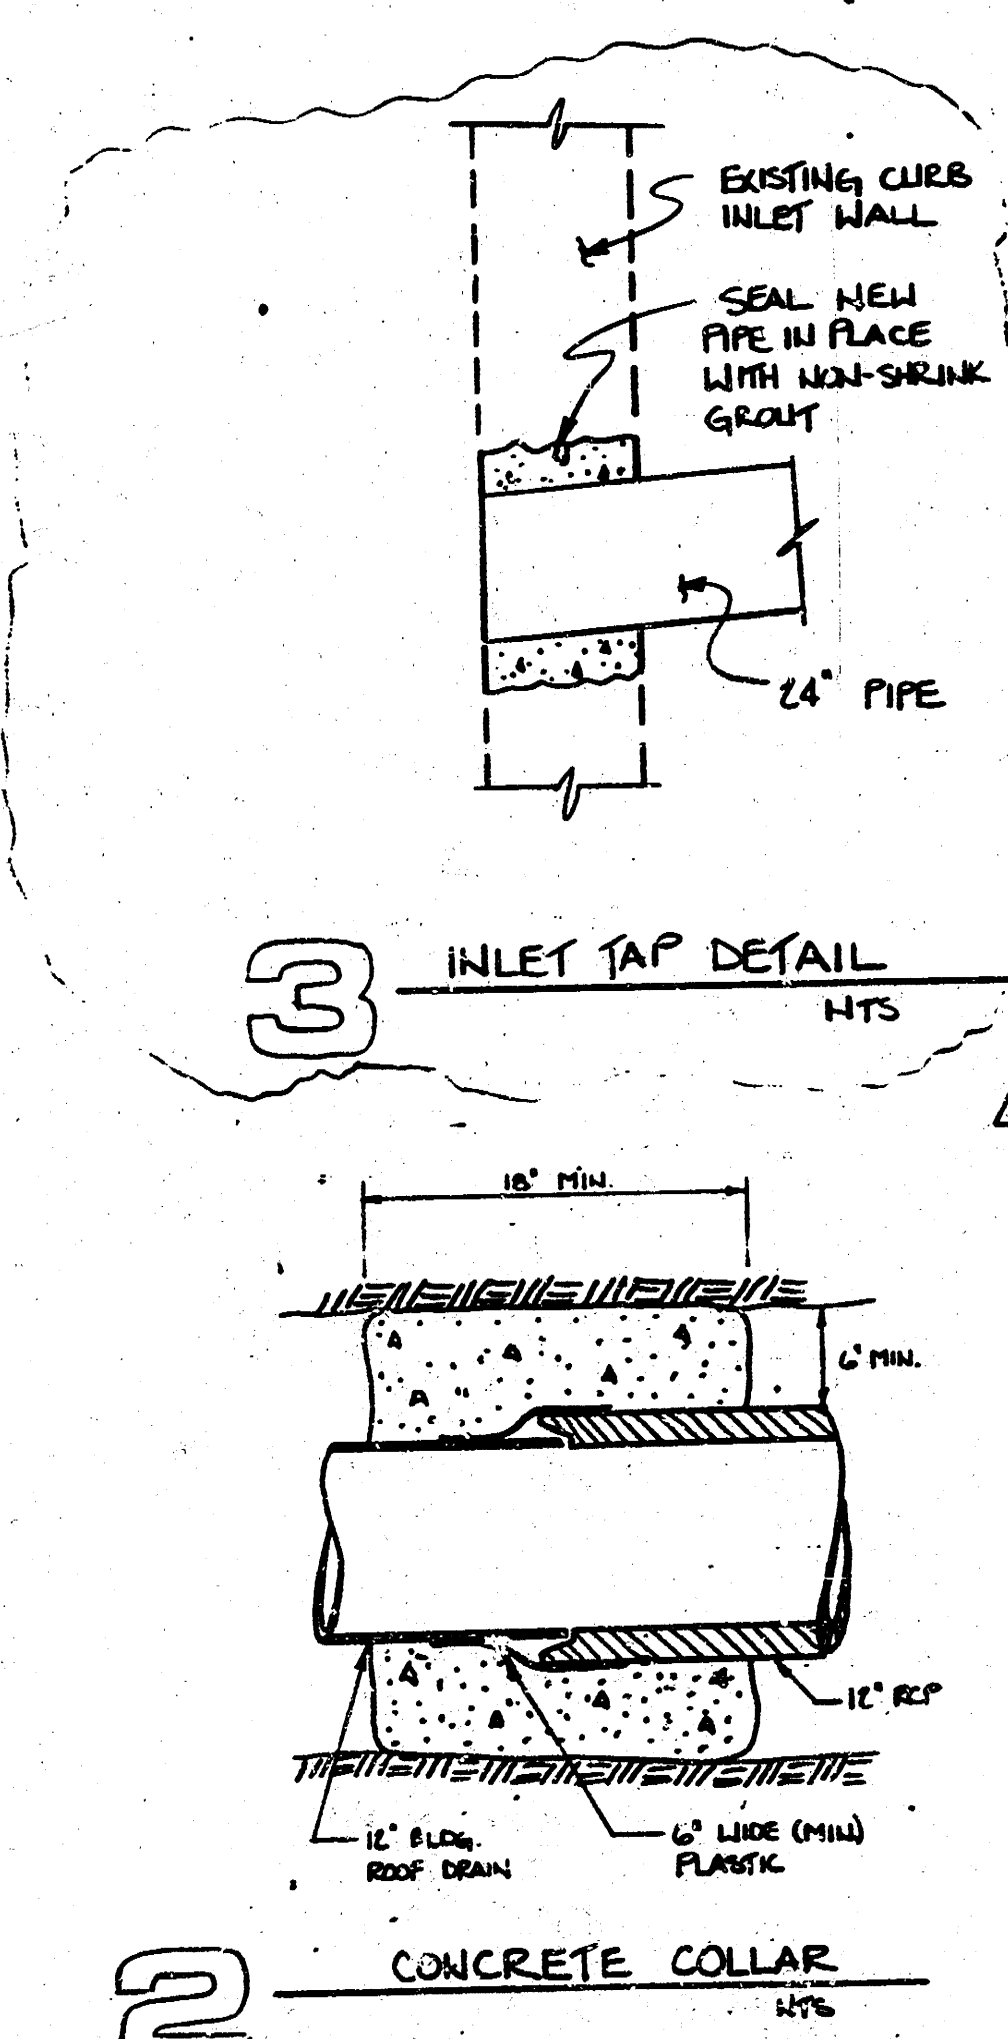


- ### GENERAL NOTES
1. Refer to plumbing drawings for exact location and elevation of roof drains. Site Storm Water Sewer to connect to roof drain system or provide temporary plug.
 2. Refer to Sheet SA-1 for coordinate baseline information.
 3. Refer to Site Survey for Bench Mark and complete existing topographic information.
 4. All Storm Sewers shown on this sheet to be Reinforced Concrete Pipe.
 5. Contractor to contact Continental Pipeline Company prior to any grading work within pipeline easement.

APPROVED AS NOTED
By CITY ENGINEER OF WICHITA

Sanitary Sewers _____
Storm Sewers 206 4/22/8
Driveway Approaches _____

NOTE TO CONTRACTOR

THIS project will be constructed under the supervision of the CITY ENGINEER and conforming to the SPECIFICATIONS of the CITY OF WICHITA. The CONTRACTOR will pay the City of Wichita for all costs of plan review, inspection and traveling per contract.

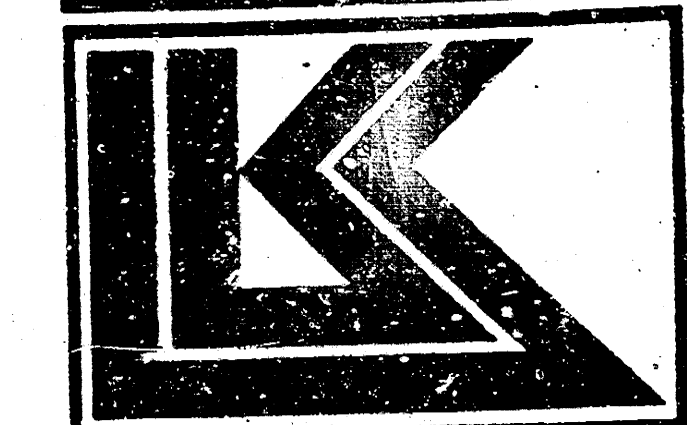[illegible][illegible]

LAW/KINGDON, INC.
ARCHITECTS & ENGINEERS
348 RIVERVIEW, WICHITA, KANSAS 67203
Phone (316) 268-0230 Copyright © 1984




DRAWN		CHECKED	
		BJV	
RELATED DRAWINGS			
SHELL			
DETAILS			
STRUCTURE			
MECHANICAL			
ELECTRICAL			
OTHER			
SEQUENCE NUMBER			
		OF SHEET	

**TWO BRITTANY
PLACE**

WICHITA, KANSAS

PROJECT NUMBER 7515

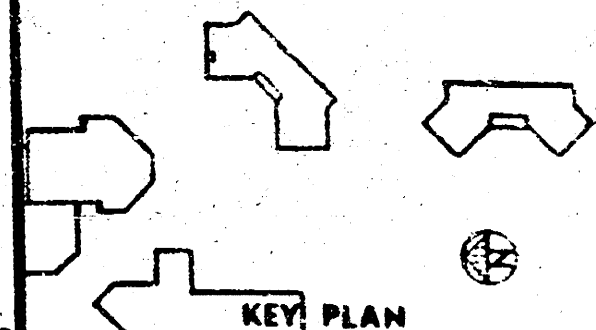

CHY (20) = 4-8-76-245-8204-000-000-011

SITE GRADIENT PLAN

SHEET TITLE	
-------------	--

1/55

1

FILMED FROM THE BEST
AVAILABLE COPY