



BENCHMARK:
 City of Wichita Bench Mark Disk
 56.2' North and 38' West
 of centerline both
 Central Avenue and Tyler Road
 Elev. = 143.90 City Datum

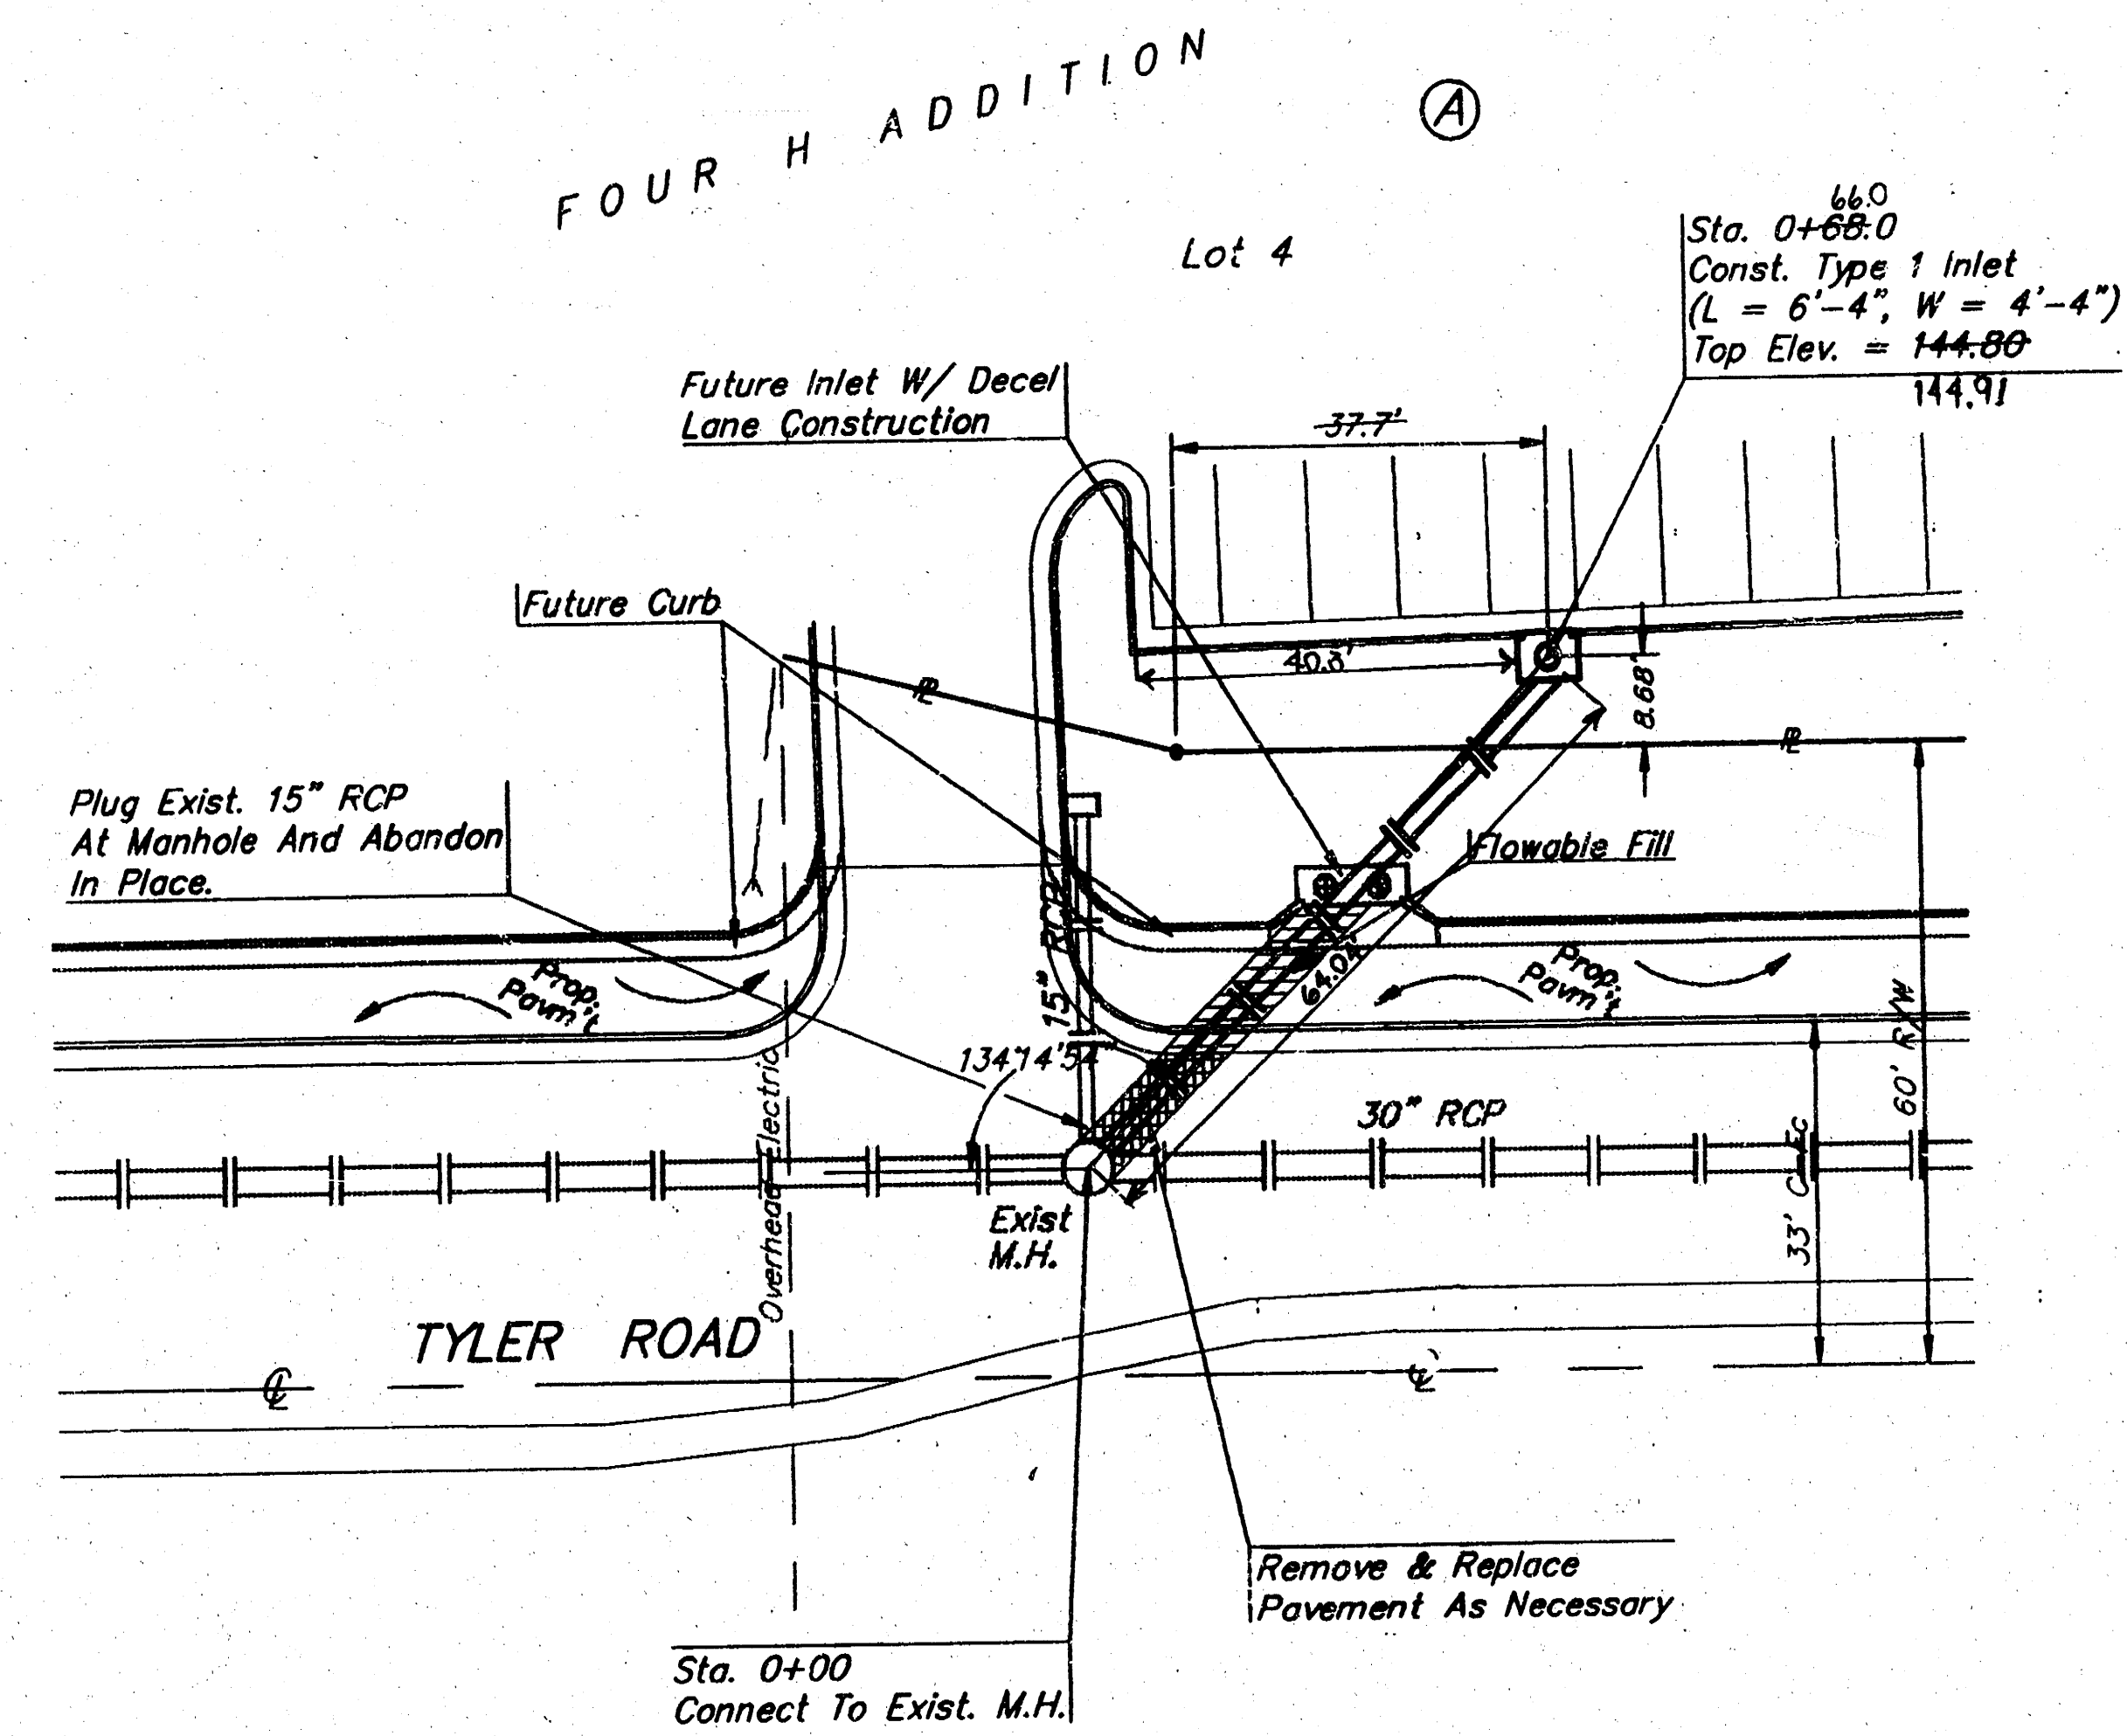

Scale: 1" = 20' Horizontal
 1" = 5' Vertical
 • = Iron

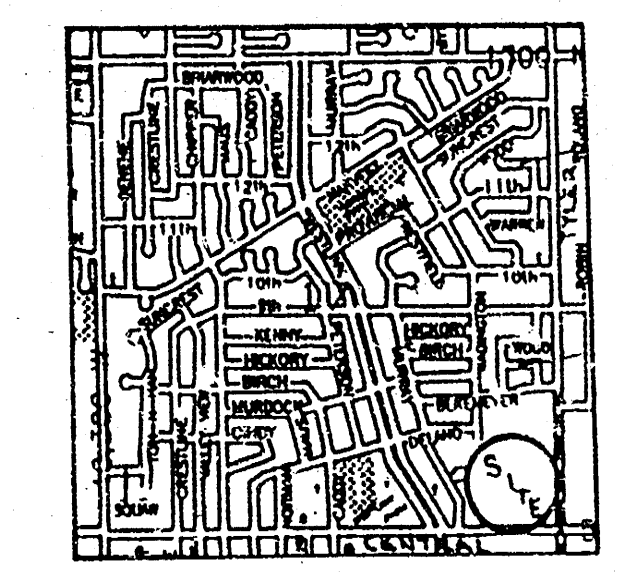


LOCATION MAP

Note: One lane of traffic to be maintained South-bound at all times during construction. Contractor to barricade the street portion of the project adequately during all times of the construction project, per M.U.T.C.D. Requirements.

APPROVED AS NOTED
 BY CITY ENGINEER OF WICHITA

Sanitary Sewers _____
 Storm Sewers VRH 6/2/93
 Driveway Approaches _____
 Water Mains _____
 Paving _____

NOTE TO CONTRACTORS
 Inspection and testing for this project is to be provided by a Licensed Consulting Engineering Firm under contract with the Owner/Developer. Said inspection to be in accordance with the City of Wichita standard construction engineering practices and certified by a Licensed Professional Engineer. No work shall be performed in dedicated easements or public right-of-way by the Contractor without such inspection nor shall any work be commenced without written authorization by the City Engineer.

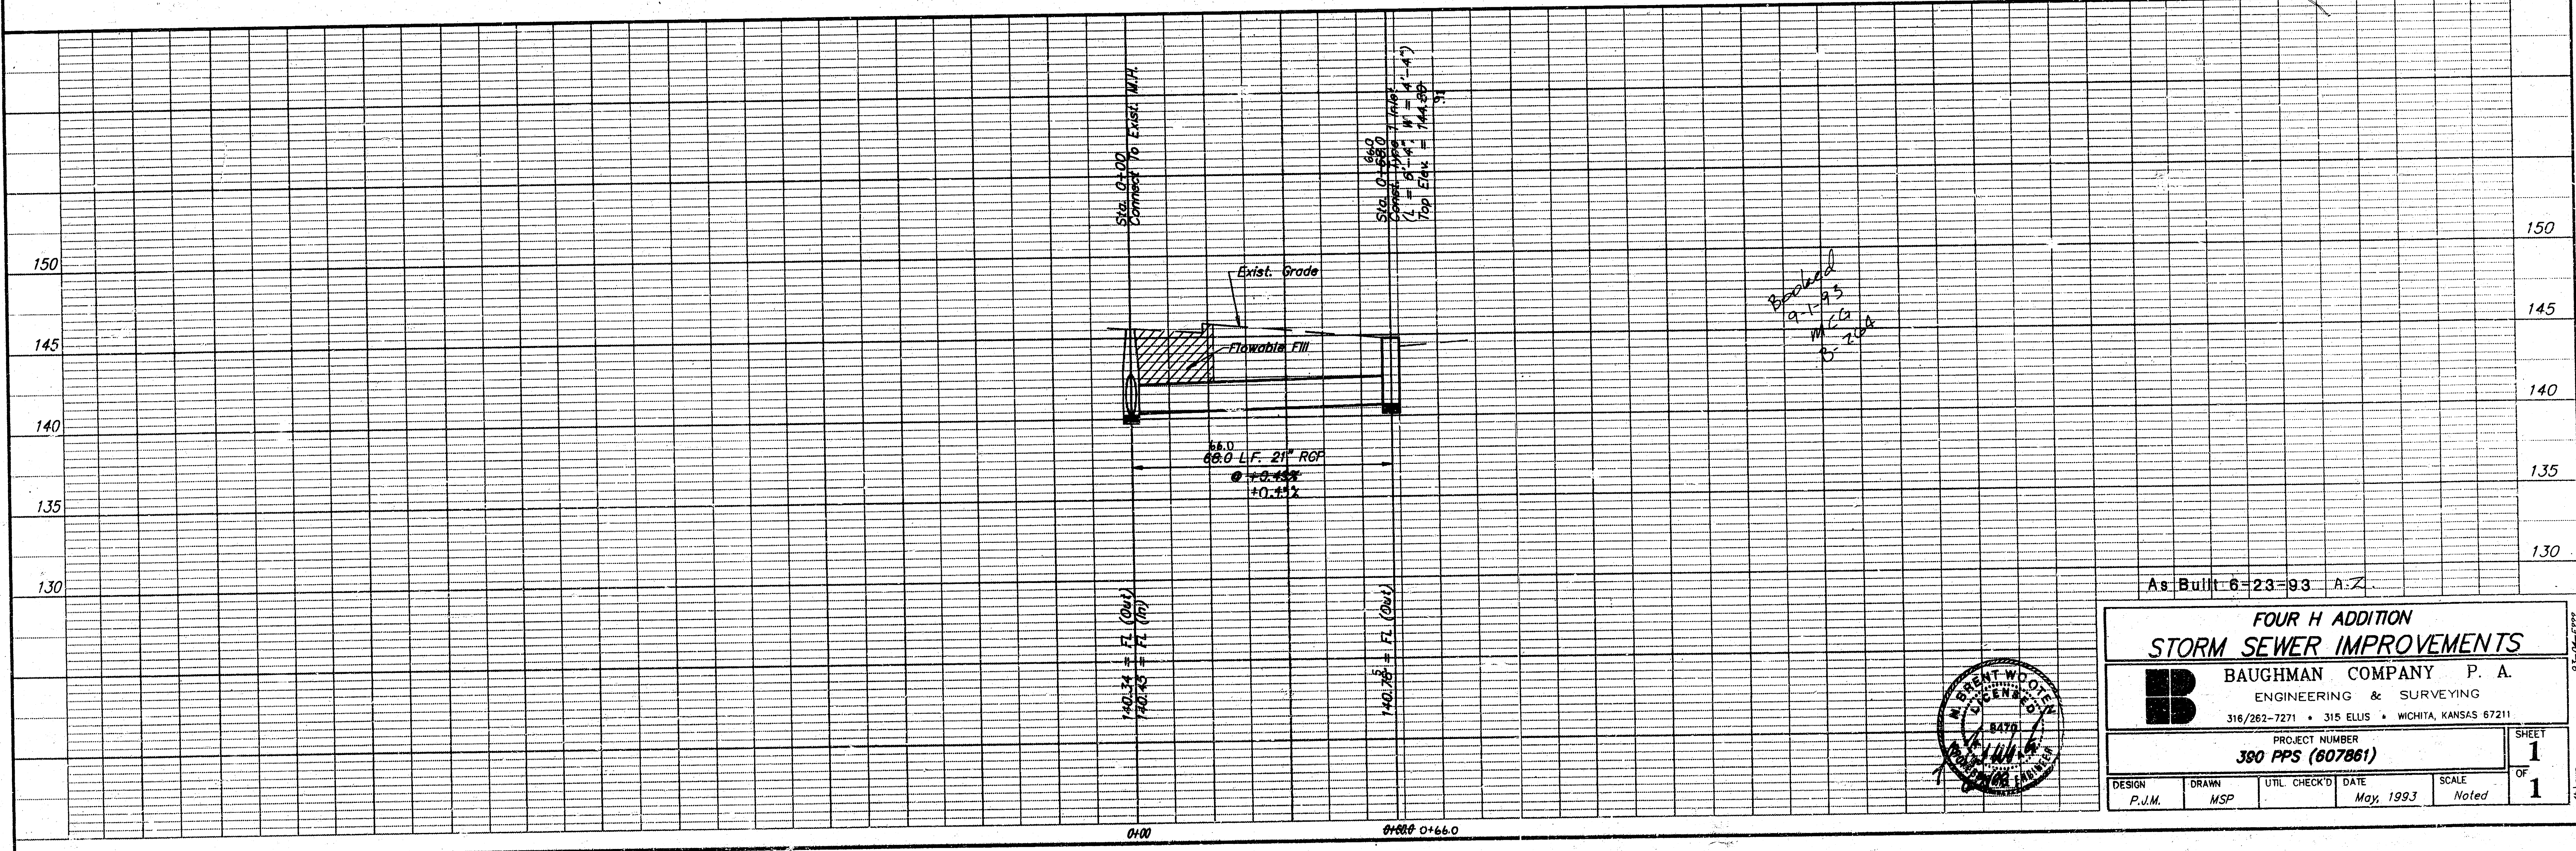

As Built 6-23-93 A-Z

**FOUR H ADDITION
 STORM SEWER IMPROVEMENTS**

B BAUGHMAN COMPANY P. A.
 ENGINEERING & SURVEYING
 316/262-7271 • 315 ELLIS • WICHITA, KANSAS 67211

PROJECT NUMBER
380 PPS (607861)

DESIGN P.J.M. DRAWN MSP UTIL CHECK'D DATE May, 1993 SCALE Noted

SHEET **1** OF **1**