
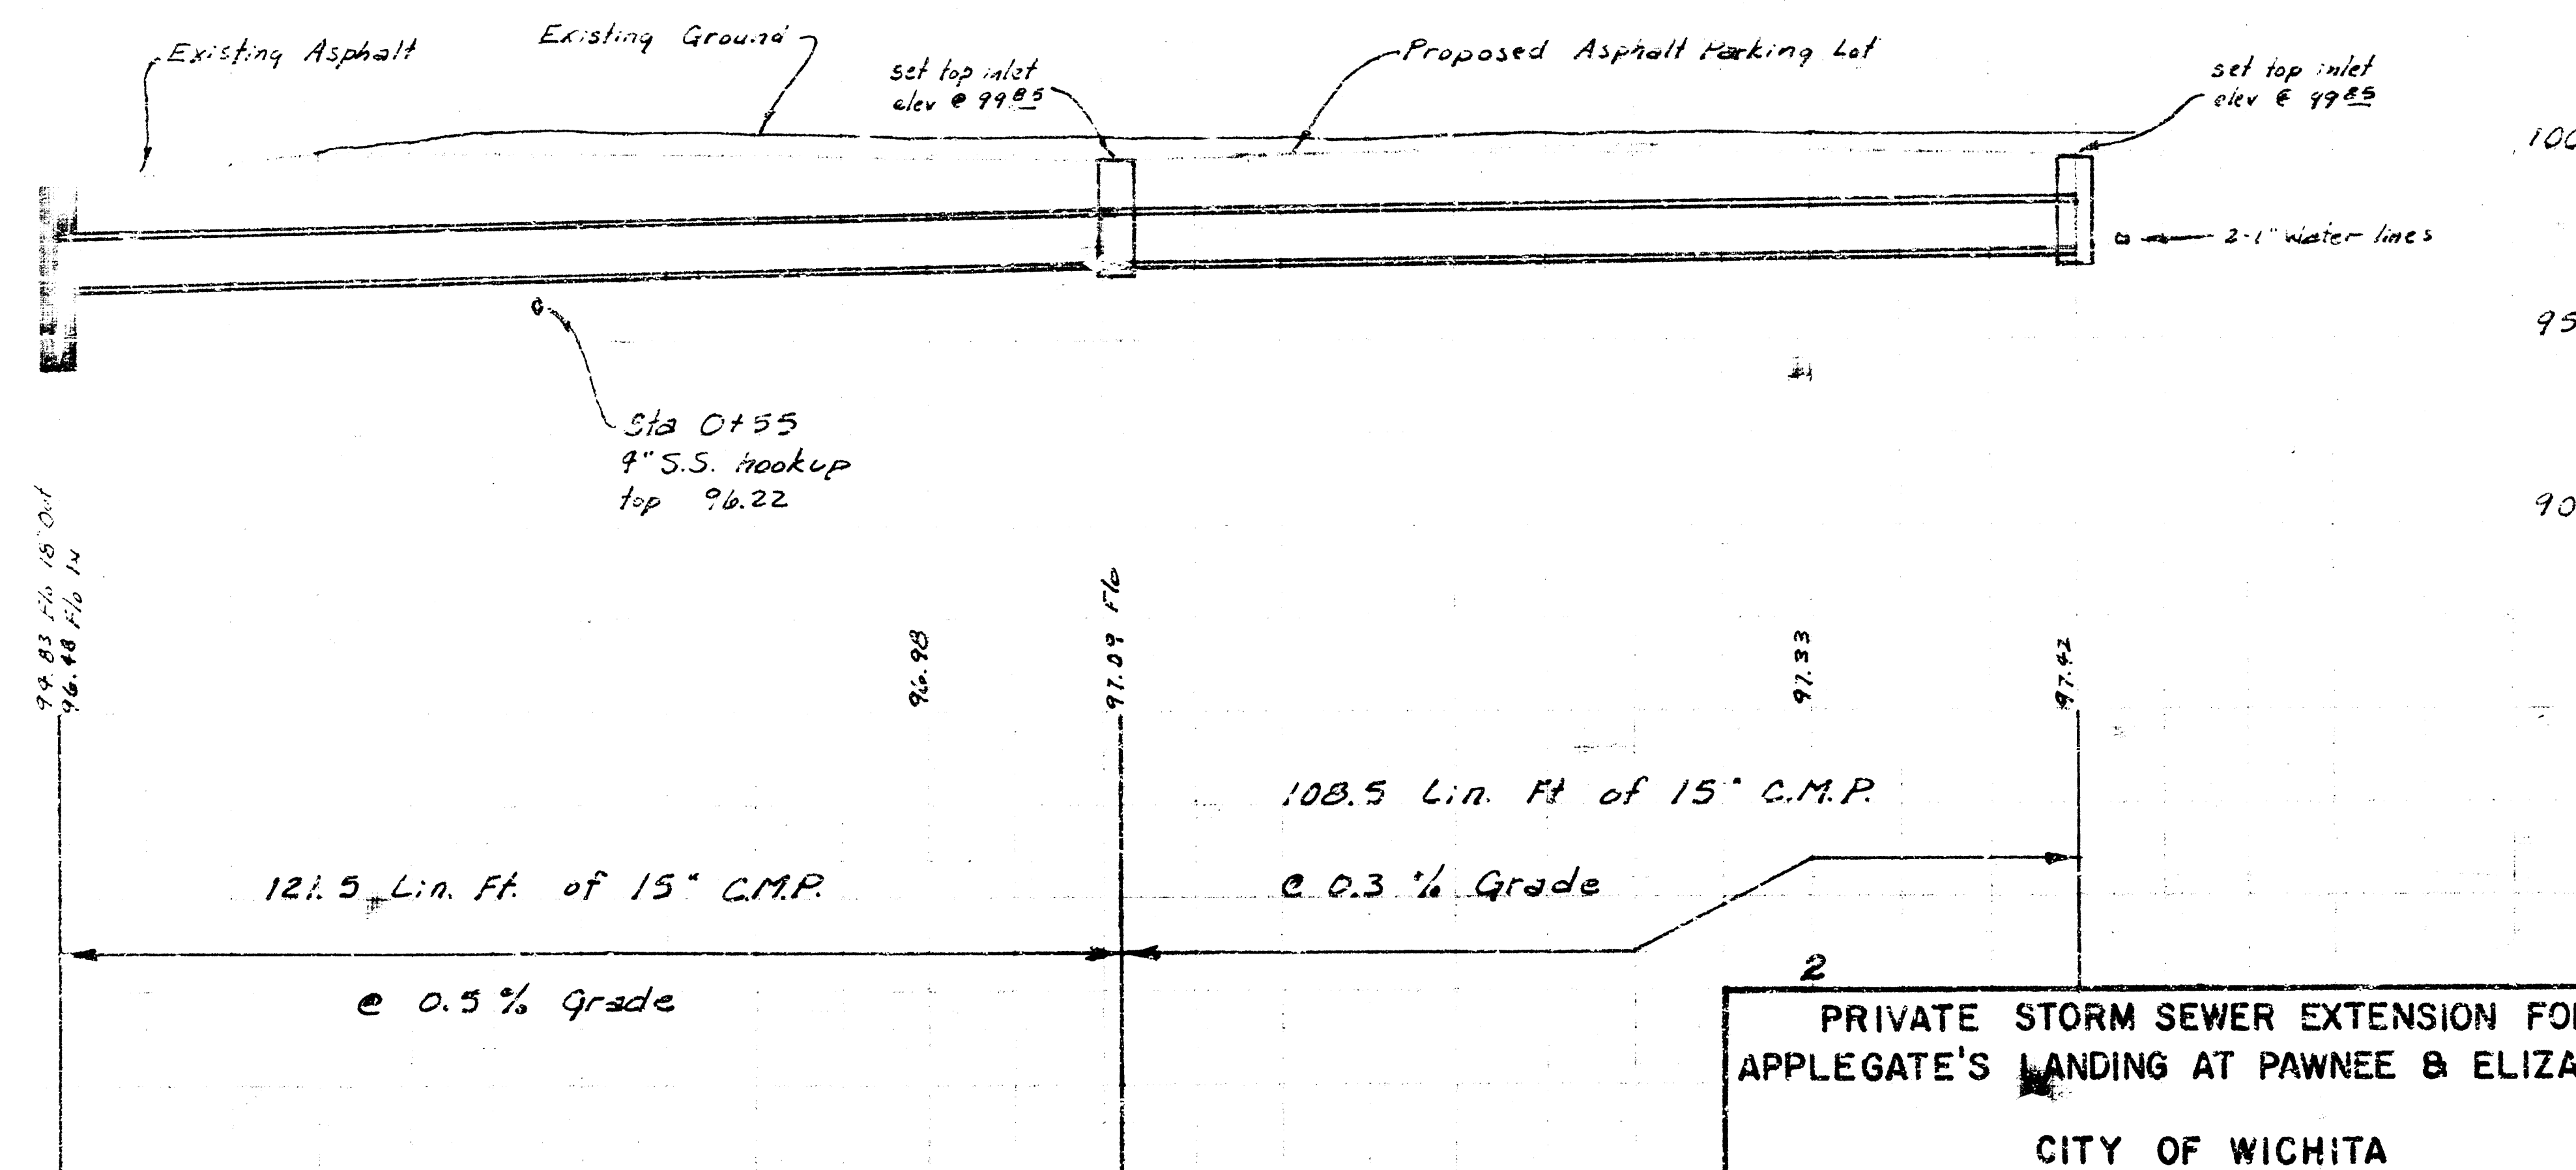


2' x 4' NE corner bottom conc. step
 1503 W Pawnee

Scale 1" = 20'
 Scale 1" = 20' Horiz
 1" = 5' Vert.

Pawnee Ave.

Elizabeth Ave.

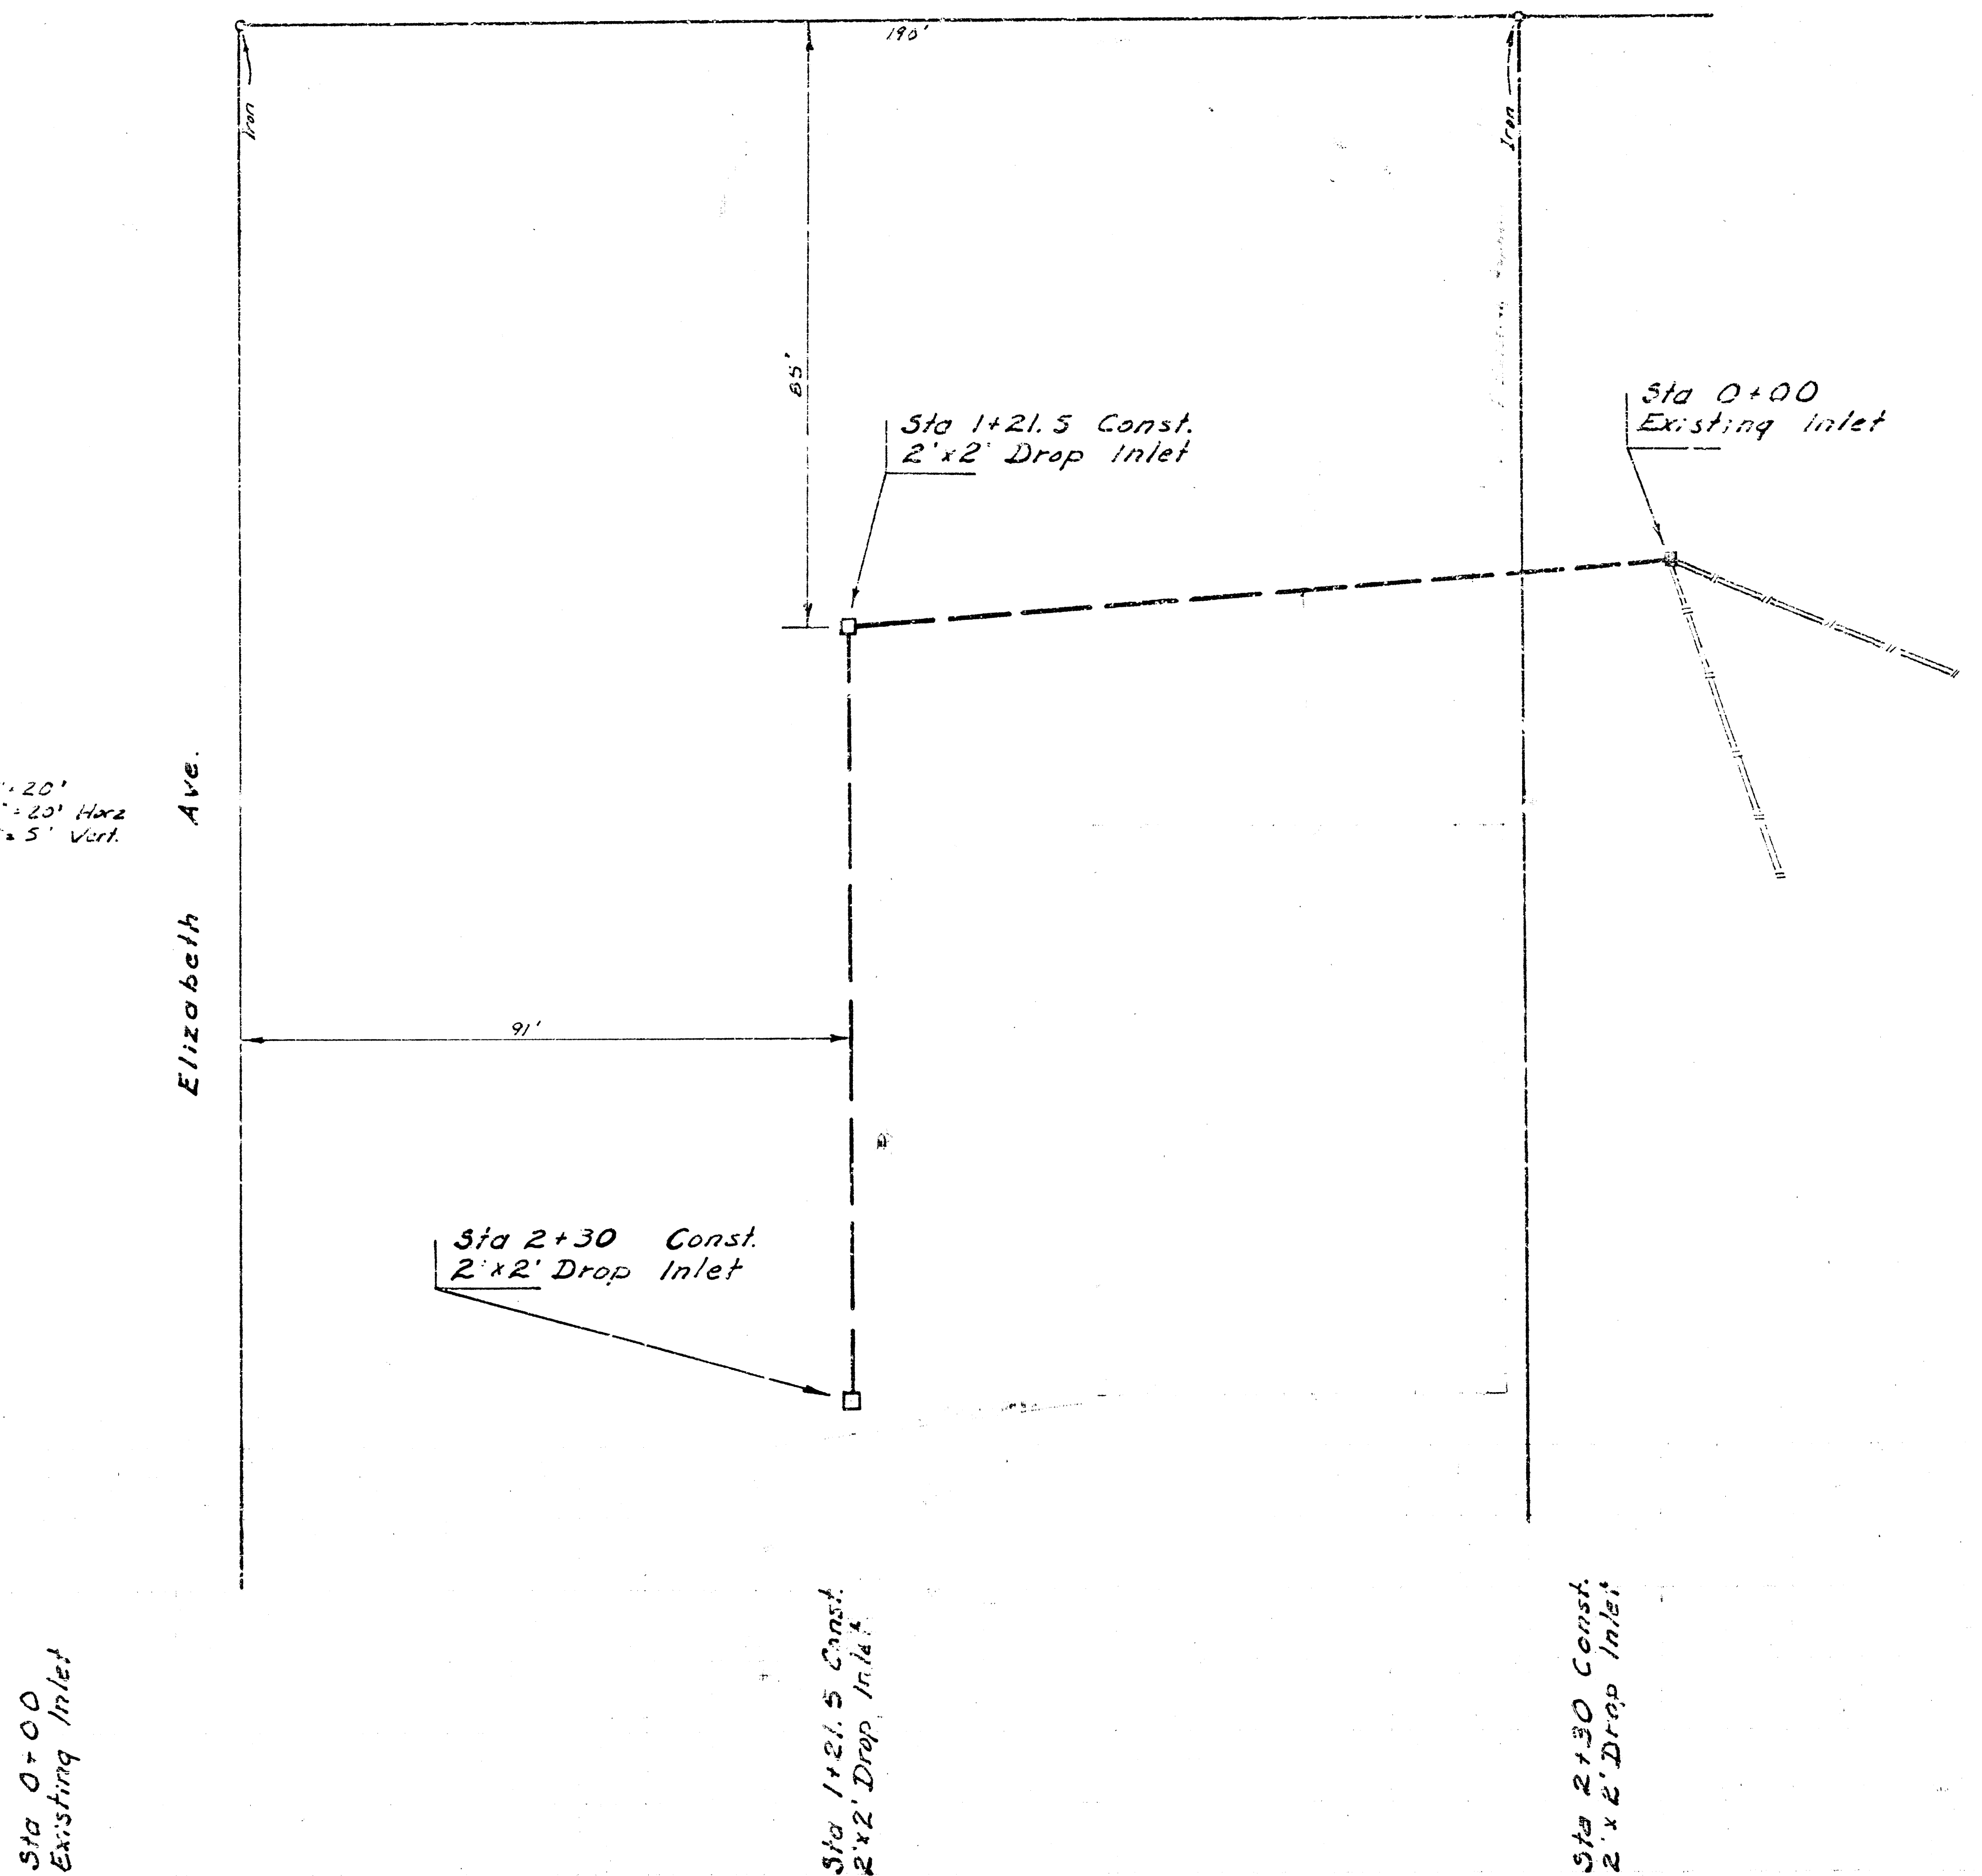

Revised 3-1-77

PRIVATE STORM SEWER EXTENSION FOR
 APPLIGATE'S LANDING AT PAWNEE & ELIZABETH
 CITY OF WICHITA
 R. W. LINN CITY ENGINEER
 PROJECT NO. DBKW707006

NOTE TO THE ENGINEER

THIS PROJECT IS THE PROPERTY OF THE CITY OF WICHITA. IT IS TO BE USED FOR THE PURPOSES FOR WHICH IT WAS DESIGNED. NO PART OF THIS PROJECT IS TO BE REPRODUCED OR TRANSMITTED IN ANY FORM OR BY ANY MEANS, ELECTRONIC OR MECHANICAL, INCLUDING PHOTOCOPYING, RECORDING, OR BY ANY INFORMATION STORAGE AND RETRIEVAL SYSTEM, WITHOUT THE WRITTEN PERMISSION OF THE CITY ENGINEER.

NOTE TO THE ENGINEER

THIS PROJECT IS THE PROPERTY OF THE CITY OF WICHITA. IT IS TO BE USED FOR THE PURPOSES FOR WHICH IT WAS DESIGNED. NO PART OF THIS PROJECT IS TO BE REPRODUCED OR TRANSMITTED IN ANY FORM OR BY ANY MEANS, ELECTRONIC OR MECHANICAL, INCLUDING PHOTOCOPYING, RECORDING, OR BY ANY INFORMATION STORAGE AND RETRIEVAL SYSTEM, WITHOUT THE WRITTEN PERMISSION OF THE CITY ENGINEER.

APPROVED AS NOTED
 BY CITY ENGINEER OF WICHITA
 R. W. LINN
 3/1/77

Note: Replace the 4" Clay Pipe Sanitary Sewer hookup with 9" Ductile Iron Pipe a minimum distance of 2.5 ft. on both sides of the center line Storm Sewer. Concrete Collars must be installed on the joints between the Iron & Clay pipe.