


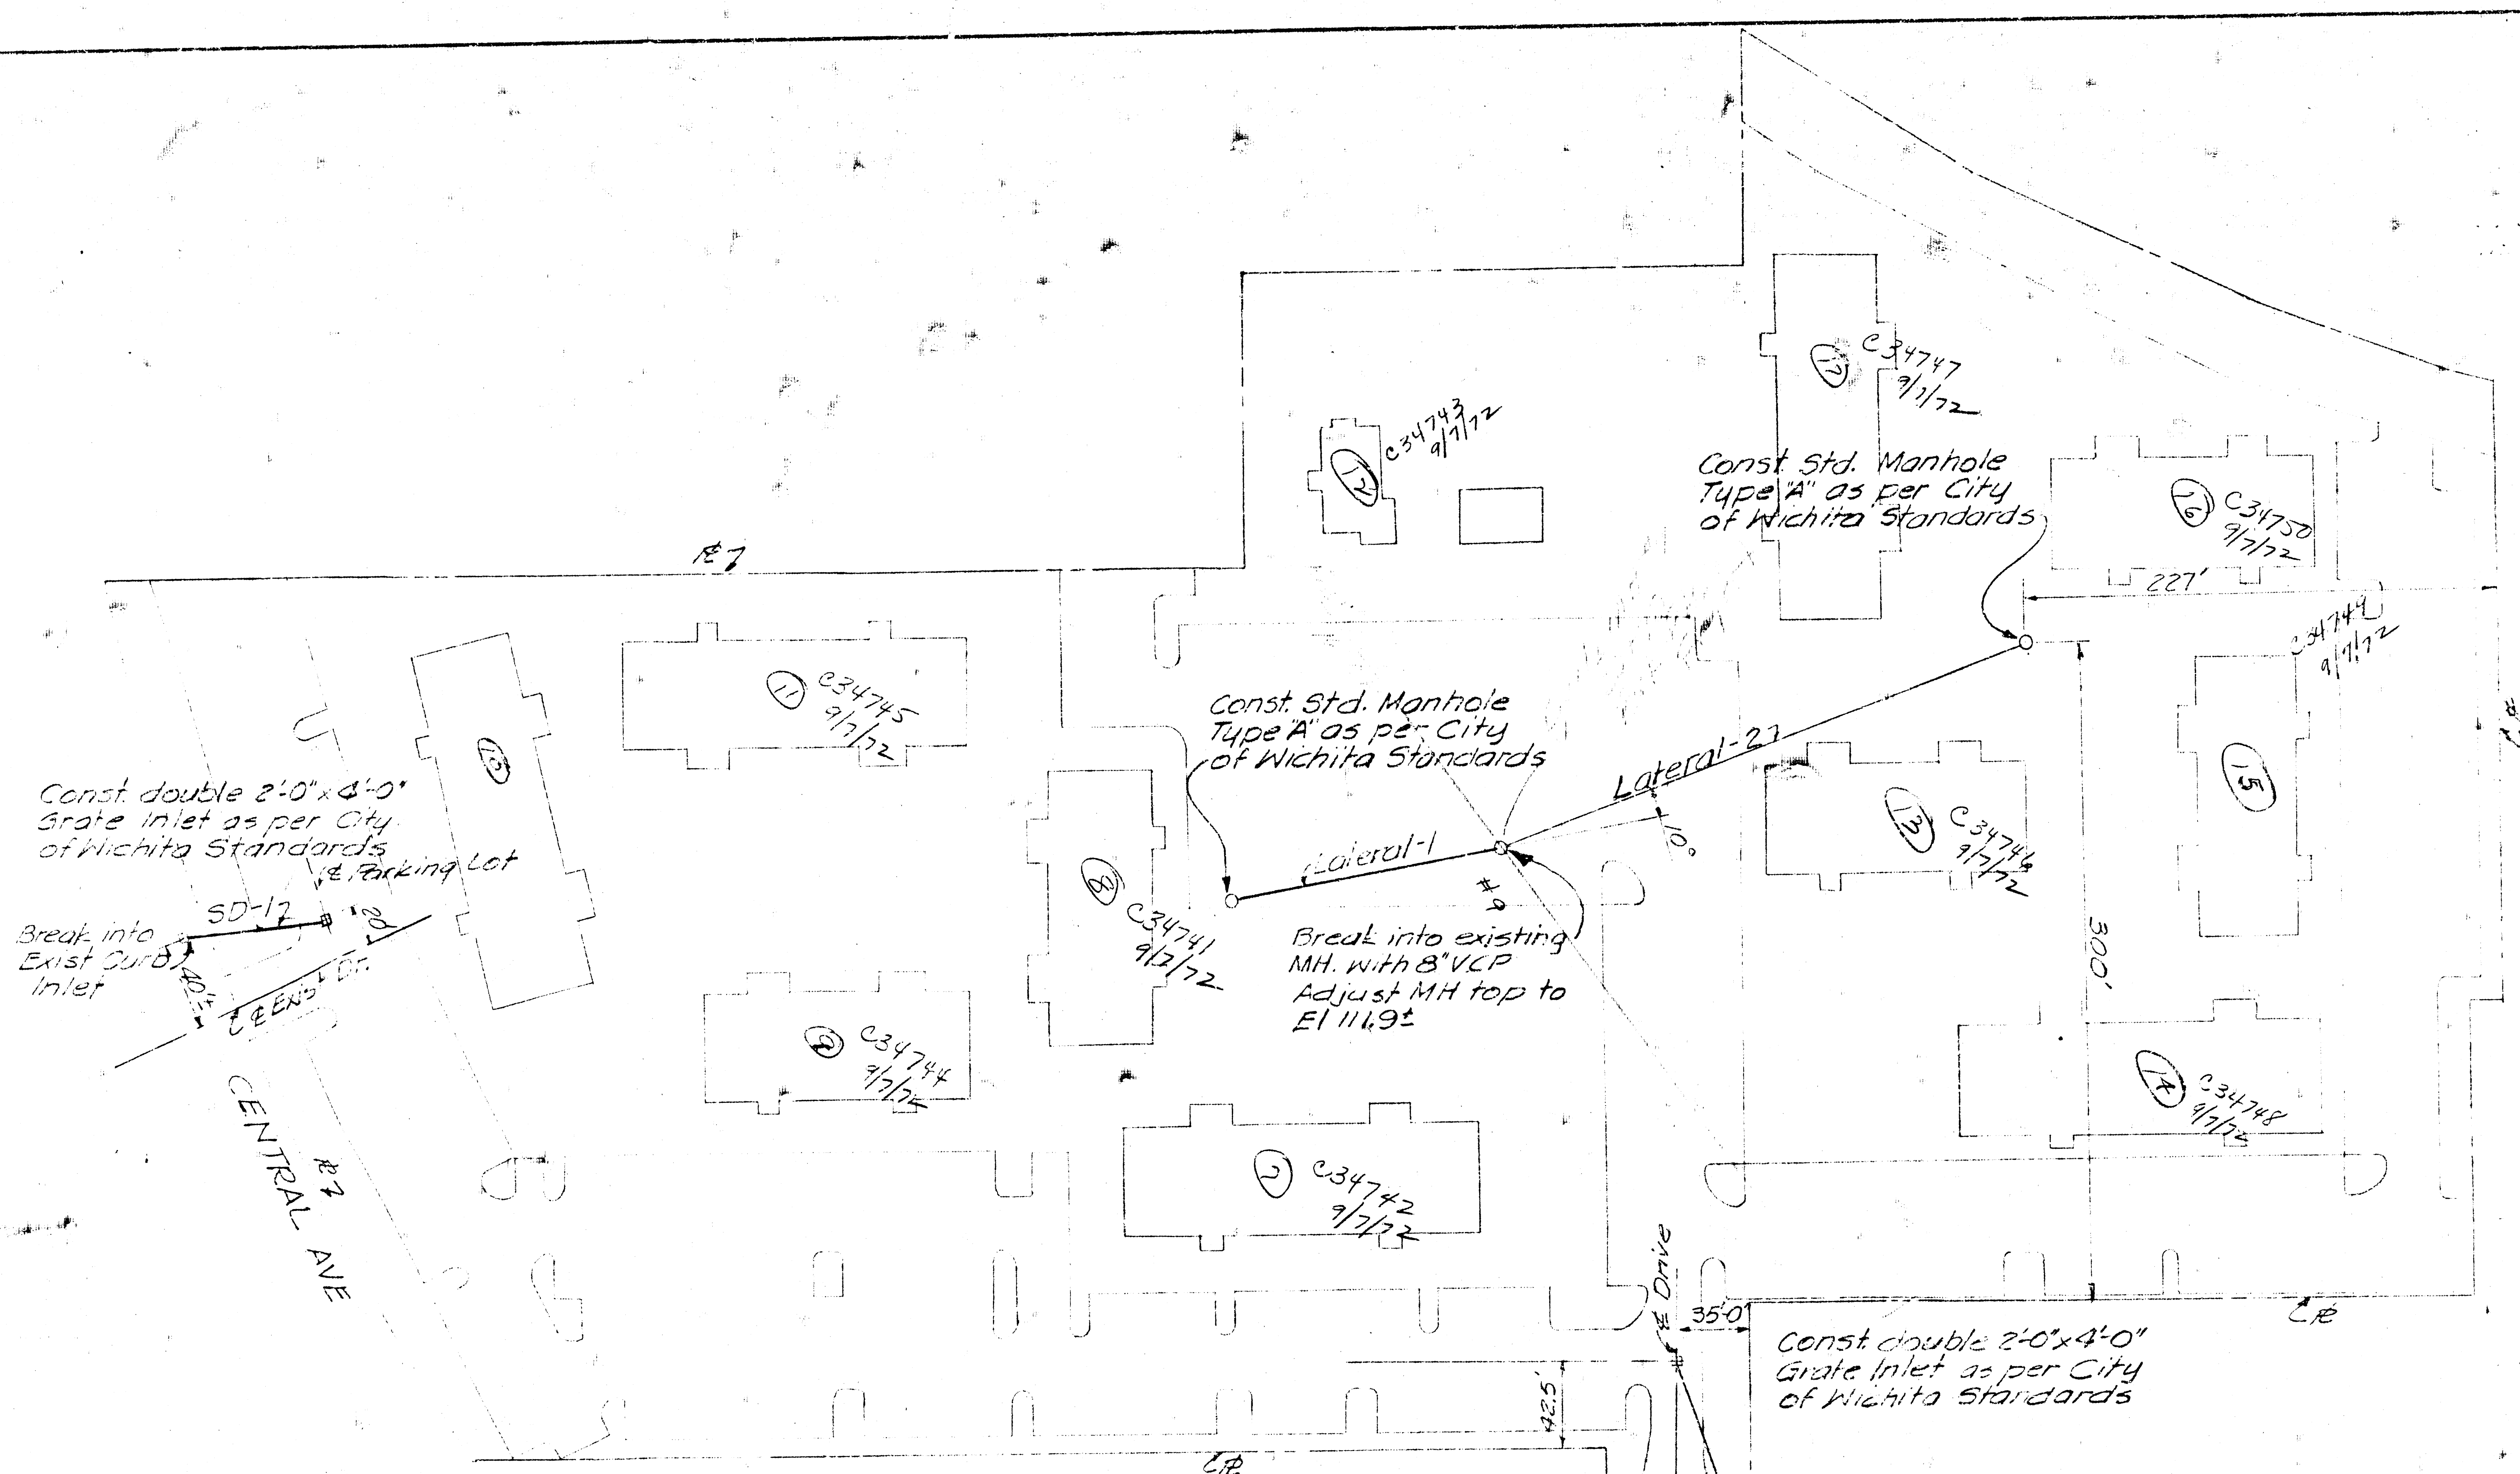


Scale 1"=50'


AAKB50L034

NOTE TO CONTRACTOR
This project shall be constructed under the supervision of the CITY ENGINEER and conform to the SPECIFICATIONS of the CITY OF WICHITA. The CONTRACTOR shall secure the City of Wichita's approval of engineering plans and specifications.

APPROVED AS NOTED
by CITY ENGINEER OF WICHITA
Sanitary Sewer 5-16-12
Storm Sewer 5-16-12
Driveway Approaches

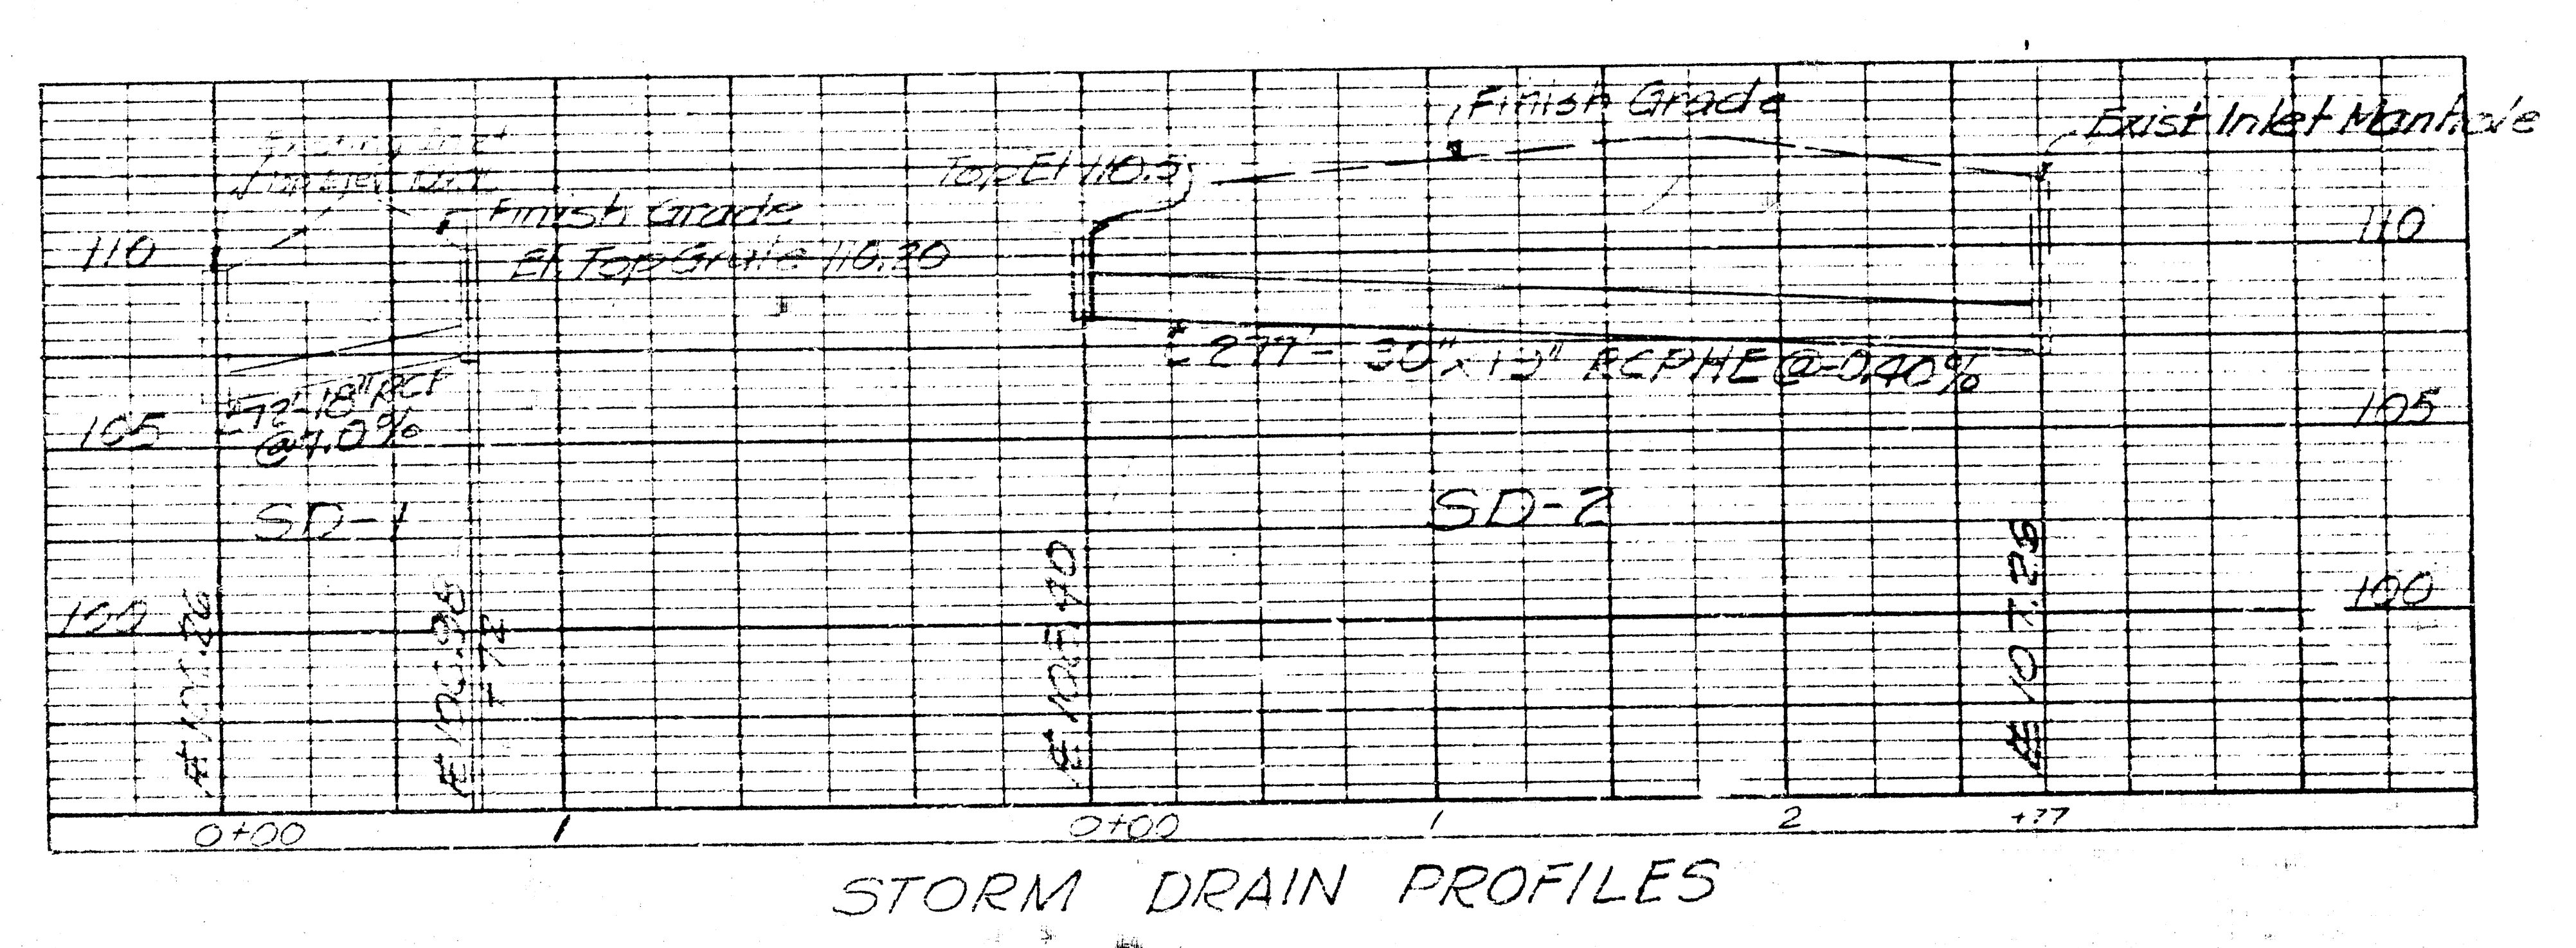

CENTRAL AVE.
Break into
Exist Curb Inlet
Reshape bot.
inlet with grout

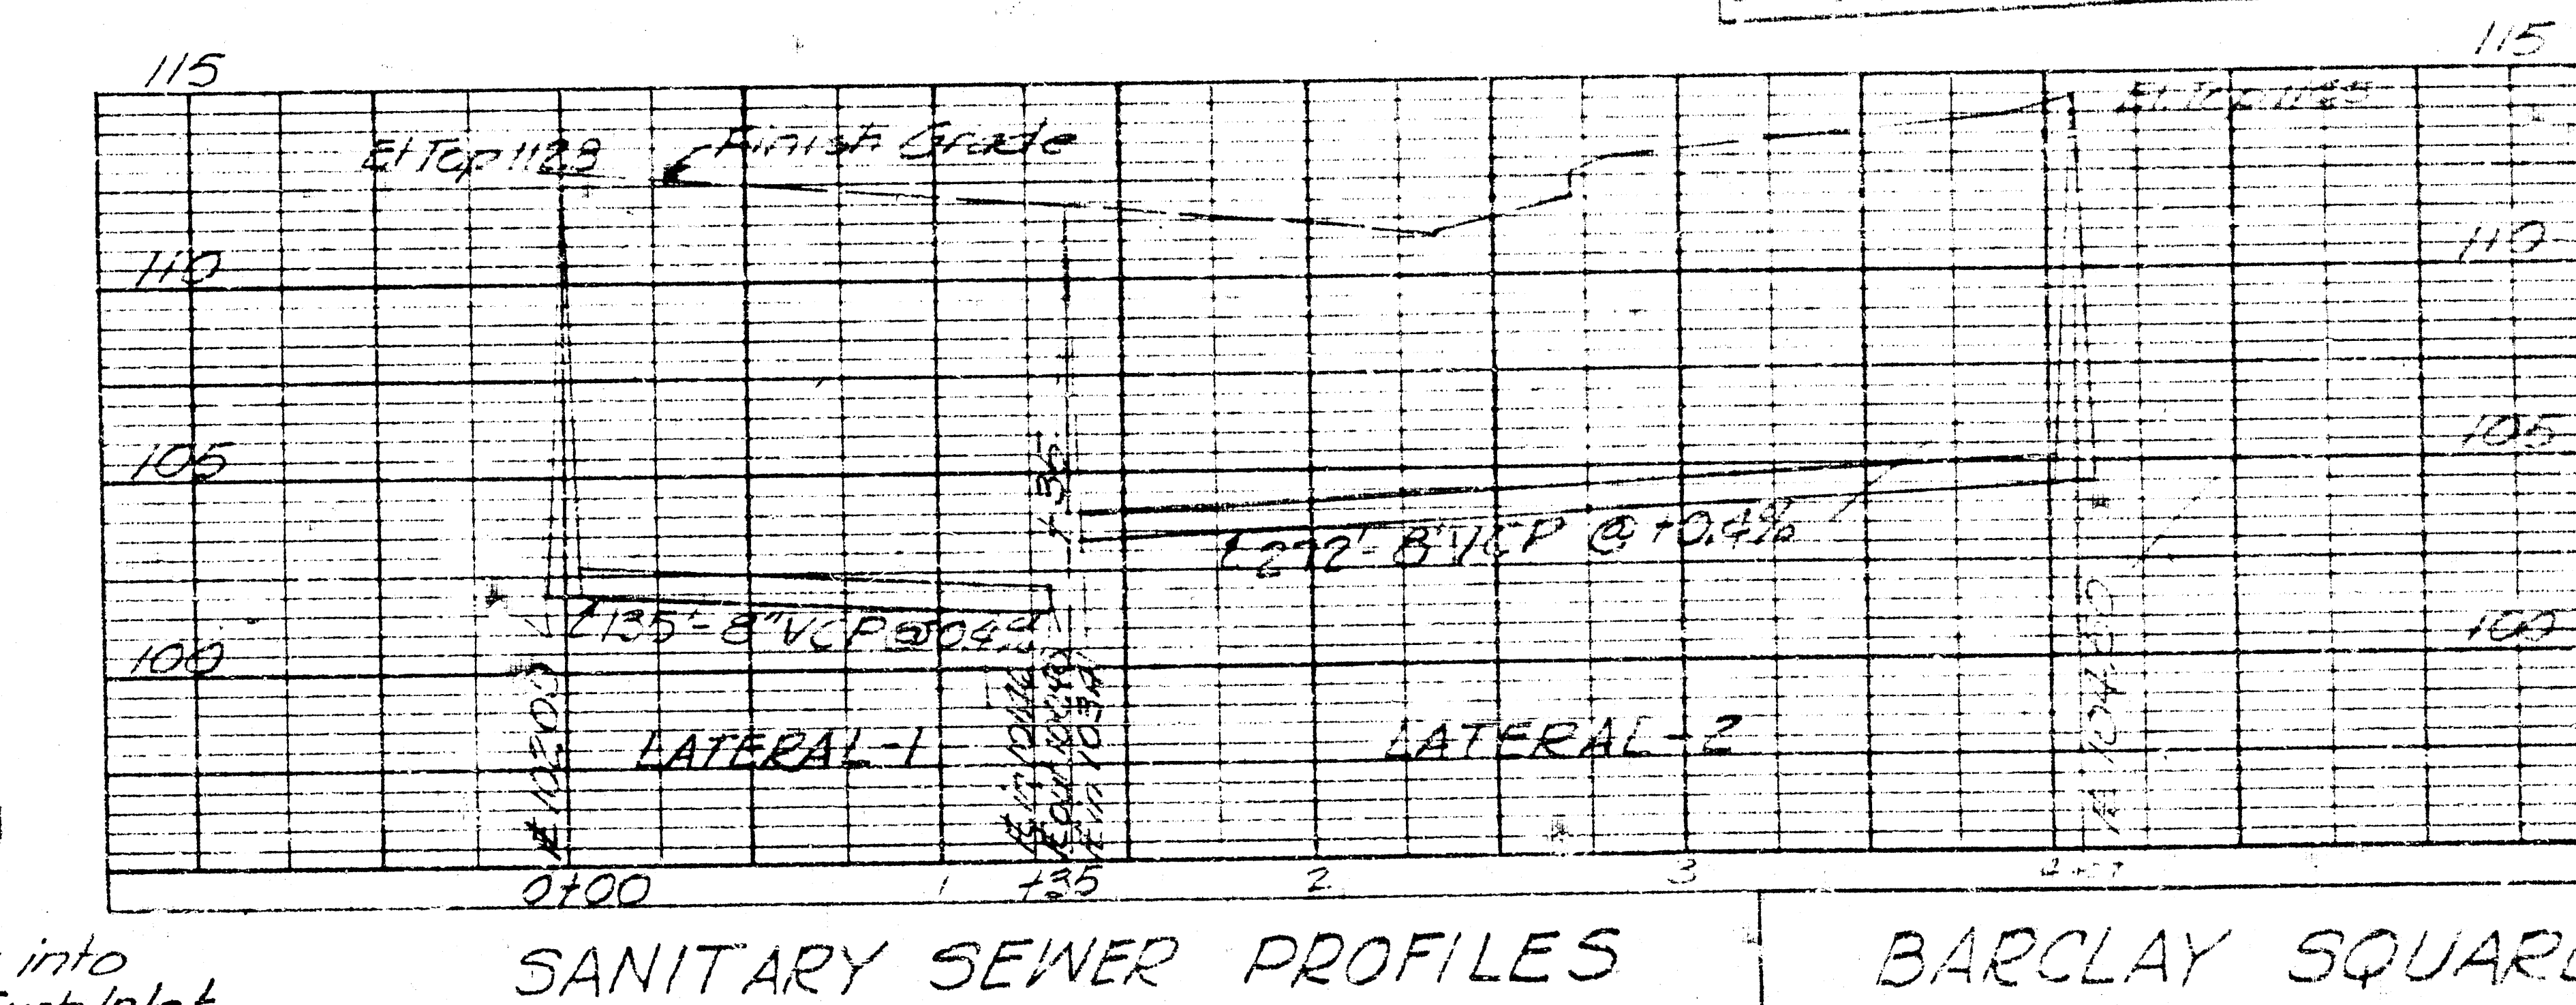

BARCLAY SQUARE
STORM SEWERS
SANITARY SEWERS
PROFESSIONAL ENGINEERING CONSULTANT
WICHITA, KANSAS
Drawn by: C. Brown
Checked by: C. Brown
Date: 5-11-12