




BENCHMARKS:

City Disc Located in Island at
Northeast Corner of Maize Road
and Central.



Elevation = 146.00 (City Datum)

□ Cut in Top of Curb on West
Side of Maize Road Between Lots
2 & 3, Block 1, 1st-N-Hah
Village.

Elevation = 151.29 (City Datum)

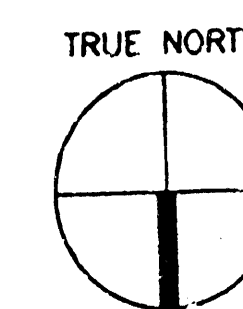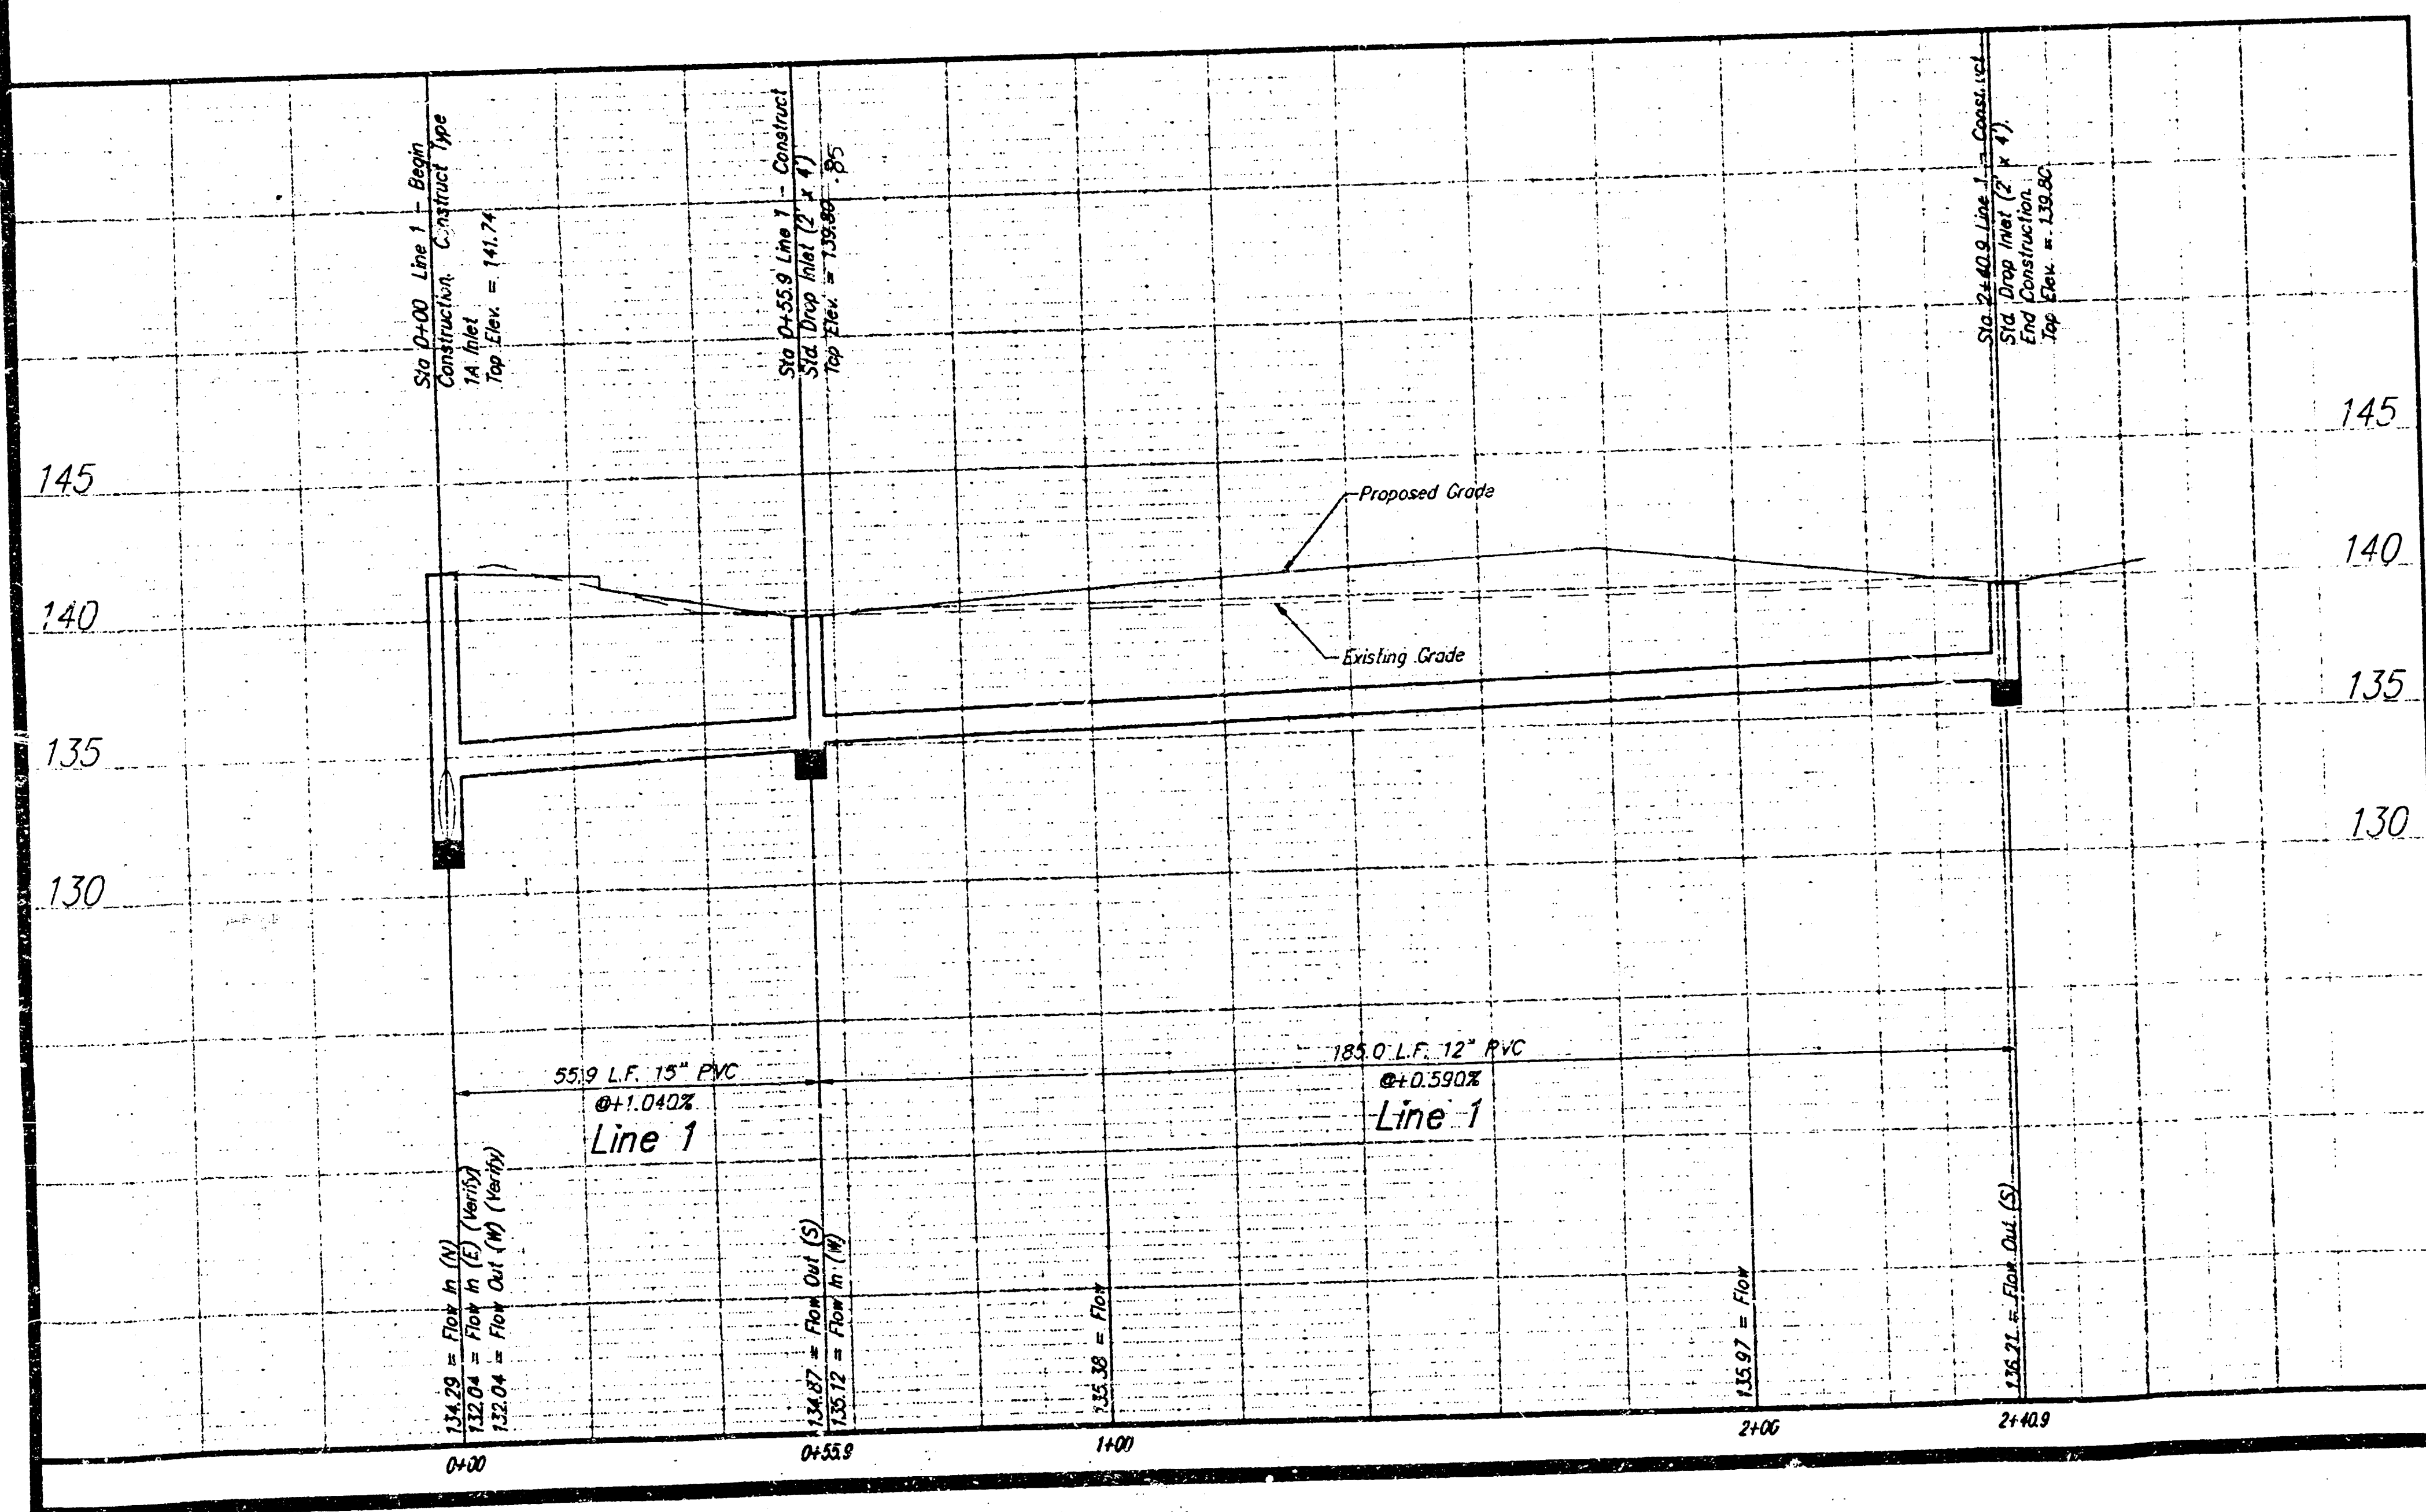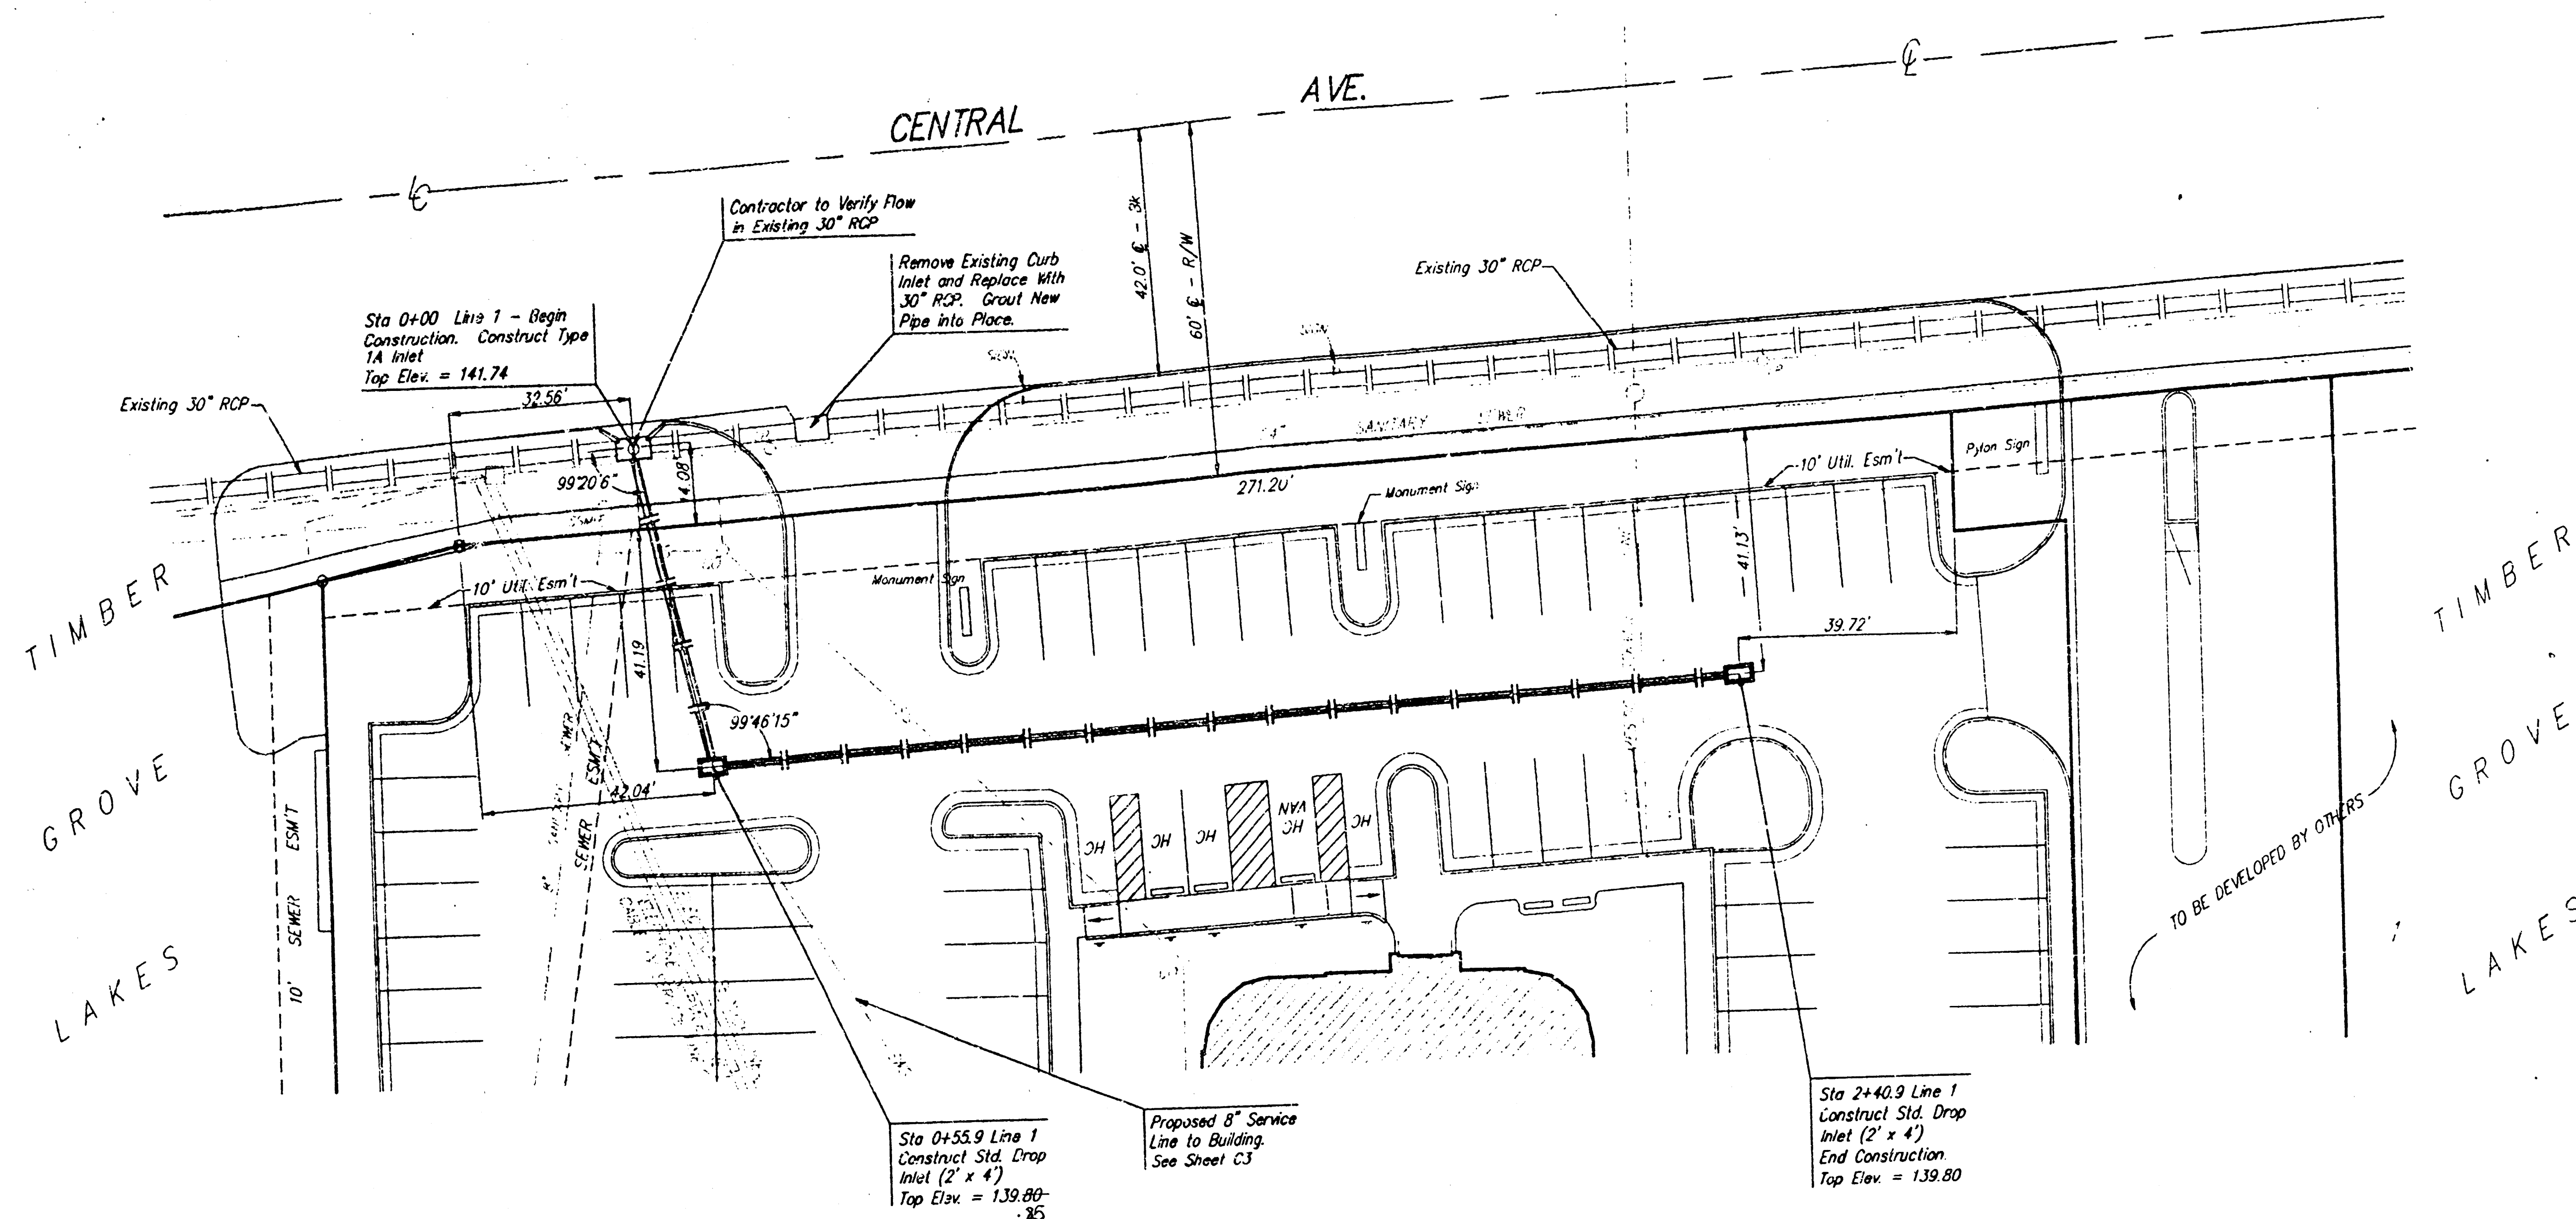

C4 STORM SEWER IMPROVEMENTS
HORIZONTAL: 1" = 20'-0"
VERTICAL: 1" = 5'-0"

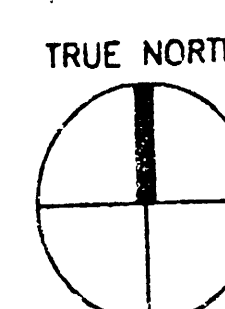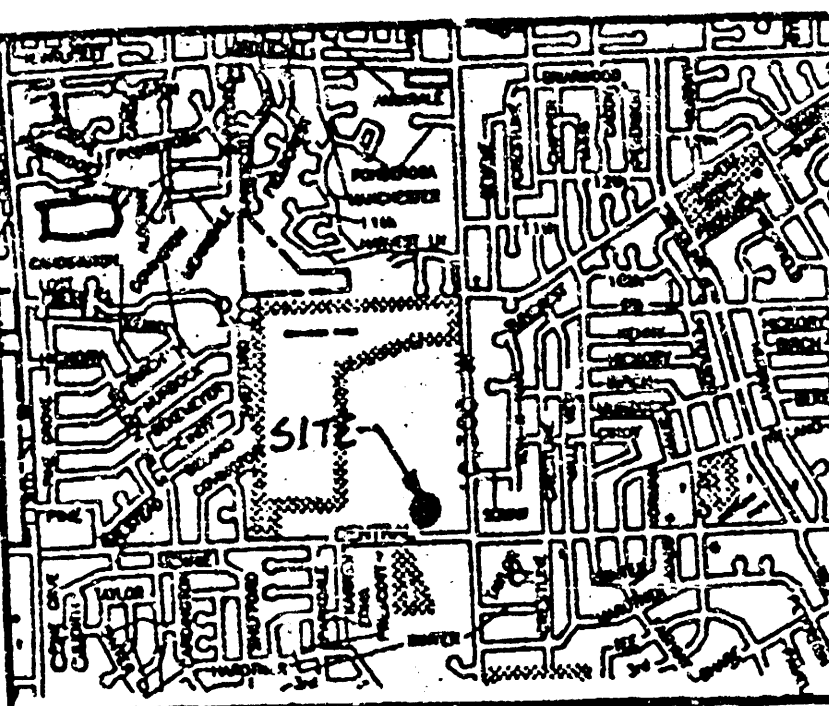

LOCATION MAP

CITY OF WICHITA, KANSAS
PRIVATE PROJECT NO. - 471 PPS (607861)
CITY ENGINEER - MICHAEL LINDEBAK

As Built 10-28-94

APPROVED AS NOTED
BY CITY ENGINEER OF WICHITA


Sanitary Sewers _____
Storm Sewers VRH 6/22/94
Driveway Approaches _____
Water Mains _____
Paving _____

NOTE TO CONTRACTORS
Inspection and testing for this project is to be provided by a Licensed Consulting Engineering Firm under contract with the Owner/Developer. Said inspection to be in accordance with the City of Wichita standard construction engineering practices and certified by a Licensed Professional Engineer. No work shall be performed in dedicated easements or public right-of-way by the Contractor without such inspection nor shall any work be commenced without written authorization by the City Engineer. All Construction and Materials shall comply with the City of Wichita Specifications and Standards (on file and available in the City Engineer's Office).

NO. DATE REVISIONS BY
DATE OF THIS PRINTING

DAVID SCOTT WINDLE, AIA
ARCHITECTURE
INTERIORS
FOOD SERVICE DESIGN

CONTRACTOR SHALL VERIFY ALL CONDITIONS AND DIMENSIONS AT THE JOB SITE AND NOTIFY THE ARCHITECTS OF ANY DIMENSIONAL ERRORS, OMISSIONS OR DISCREPANCIES BEFORE BEGINNING OR FABRICATING ANY WORK. DO NOT SCALE DRAWINGS.

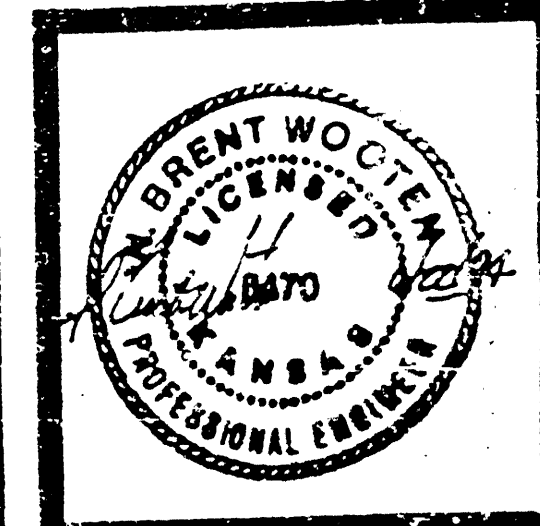

10015 Technology Blvd West
Suite 201
Bellevue, WA 98004-4039
TEL: 206/341-5965

WEST WICHITA, KS
(CHANGELIST #3 INCLUDED)

chili's
(GRILL & BAR)

JOB NUMBER
94034.00

SHEET NUMBER
C4
OF SHEETS

DATE OF ORIGINAL ISSUE
22 JUNE 1994