


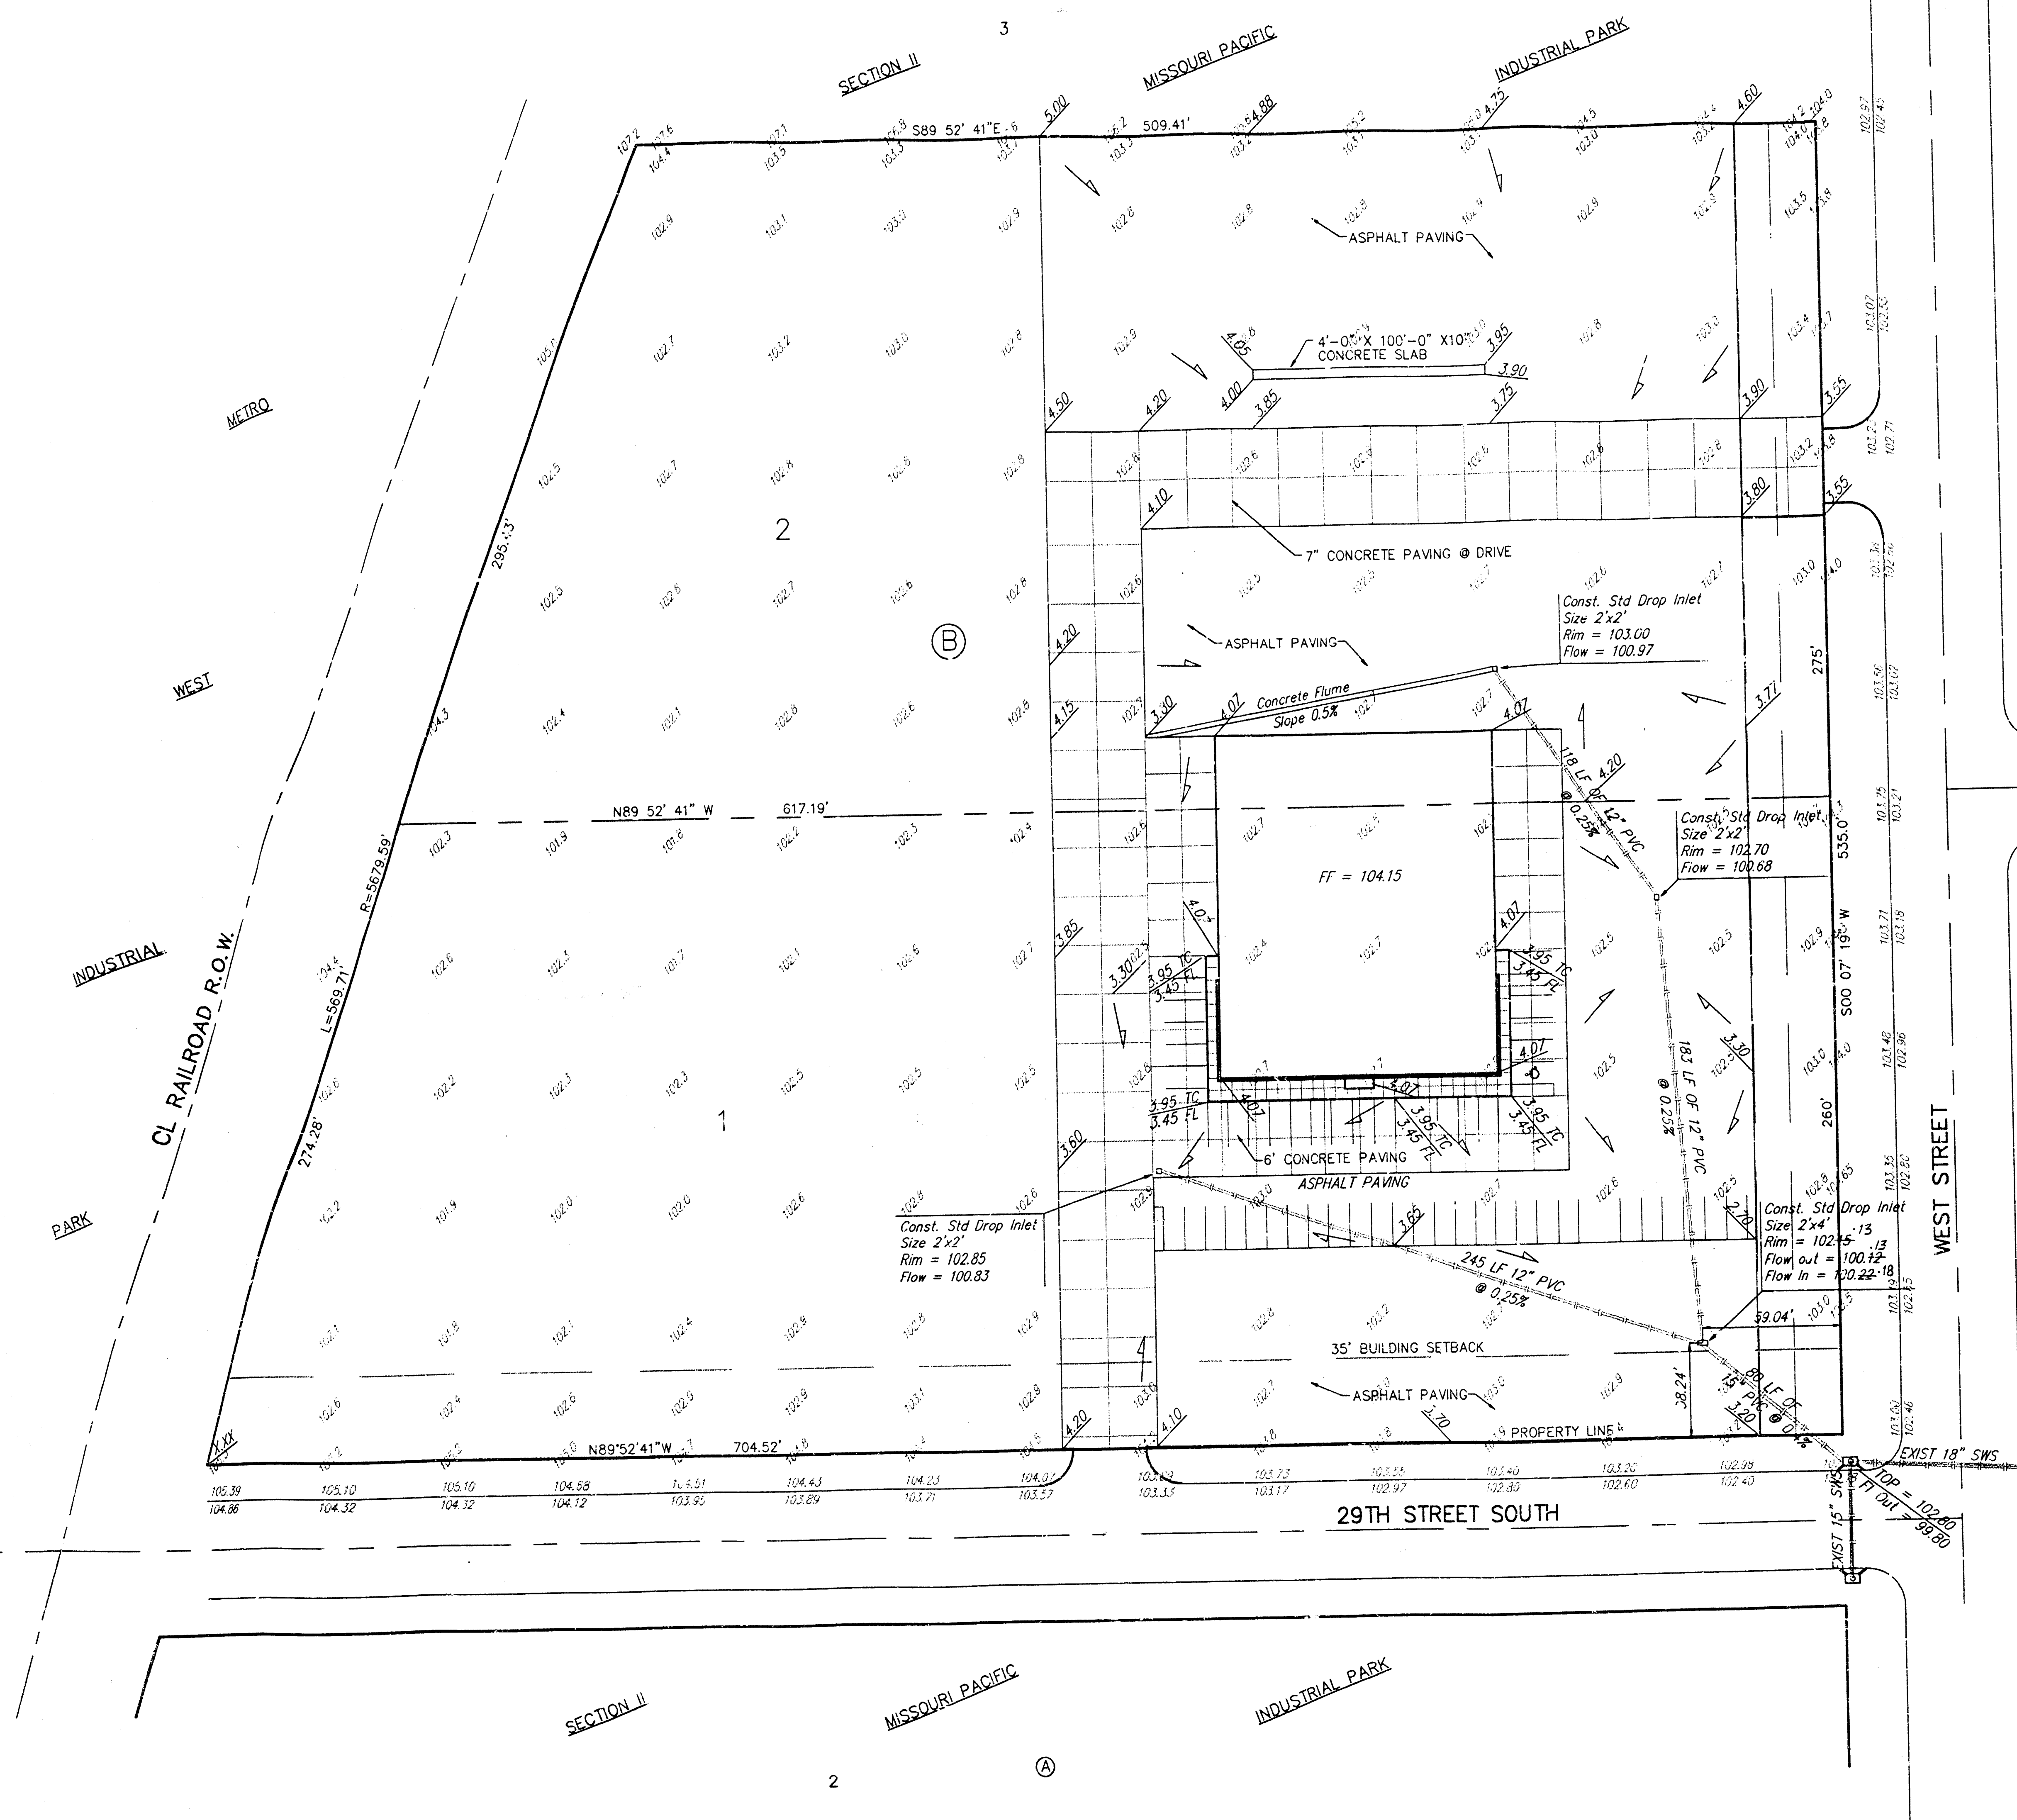

APPROVED AS NOTED
BY CITY ENGINEER OF WICHITA

Sanitary Sewer VRH 5/28/94
Storm Sewer _____
Drainage Approaches _____
Water Mains _____
Paving _____

NOTE TO CONTRACTORS
Inspection and testing for this project is to be provided by a Licensed Consulting Engineering Firm under contract with the Owner/Developer. Said inspection is to be in accordance with the City of Wichita standard construction engineering practices and certified by a Licensed Professional Engineer. No work shall be performed in dedicated easements or public right-of-way by the Contractor without such inspection nor shall any work be commenced without written authorization by the City Engineer. All Construction and Materials shall comply with the City of Wichita Specifications and Standards (on file and available in the City Engineer's Office).

City of Wichita - Private Project #
463 PPS (607861)

KESSLER - KOCH
ADDITION

29TH STREET SOUTH

KESSLER - KOCH
ADDITION

WEST STREET

Scale 1" = 40'



BOOKED
3-23-95
MCG

C-137
C-136

As Built 6-21-94

prints issued

revisions

date drawn
5-11-94

JEFF KREHBIEL ASSOCIATES, Ltd.
architecture - planning

1300 east lewis wichita, kansas 67201
(316) 267-8233

JEFF KREHBIEL
PROFESSIONAL ENGINEER

KANSAS TRUCK CENTER
29TH STREET SOUTH & WEST STREET
WICHITA, KANSAS

sheet title
SITE GRADING
PLAN

sheet
SG-1
of 1 sheets

18-5-51