



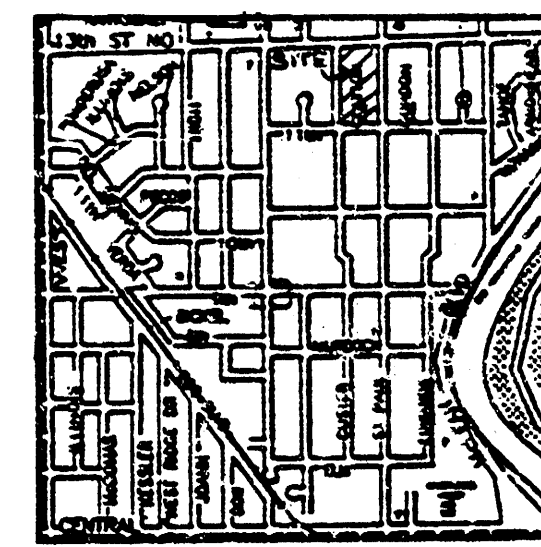

LOCATION MAP

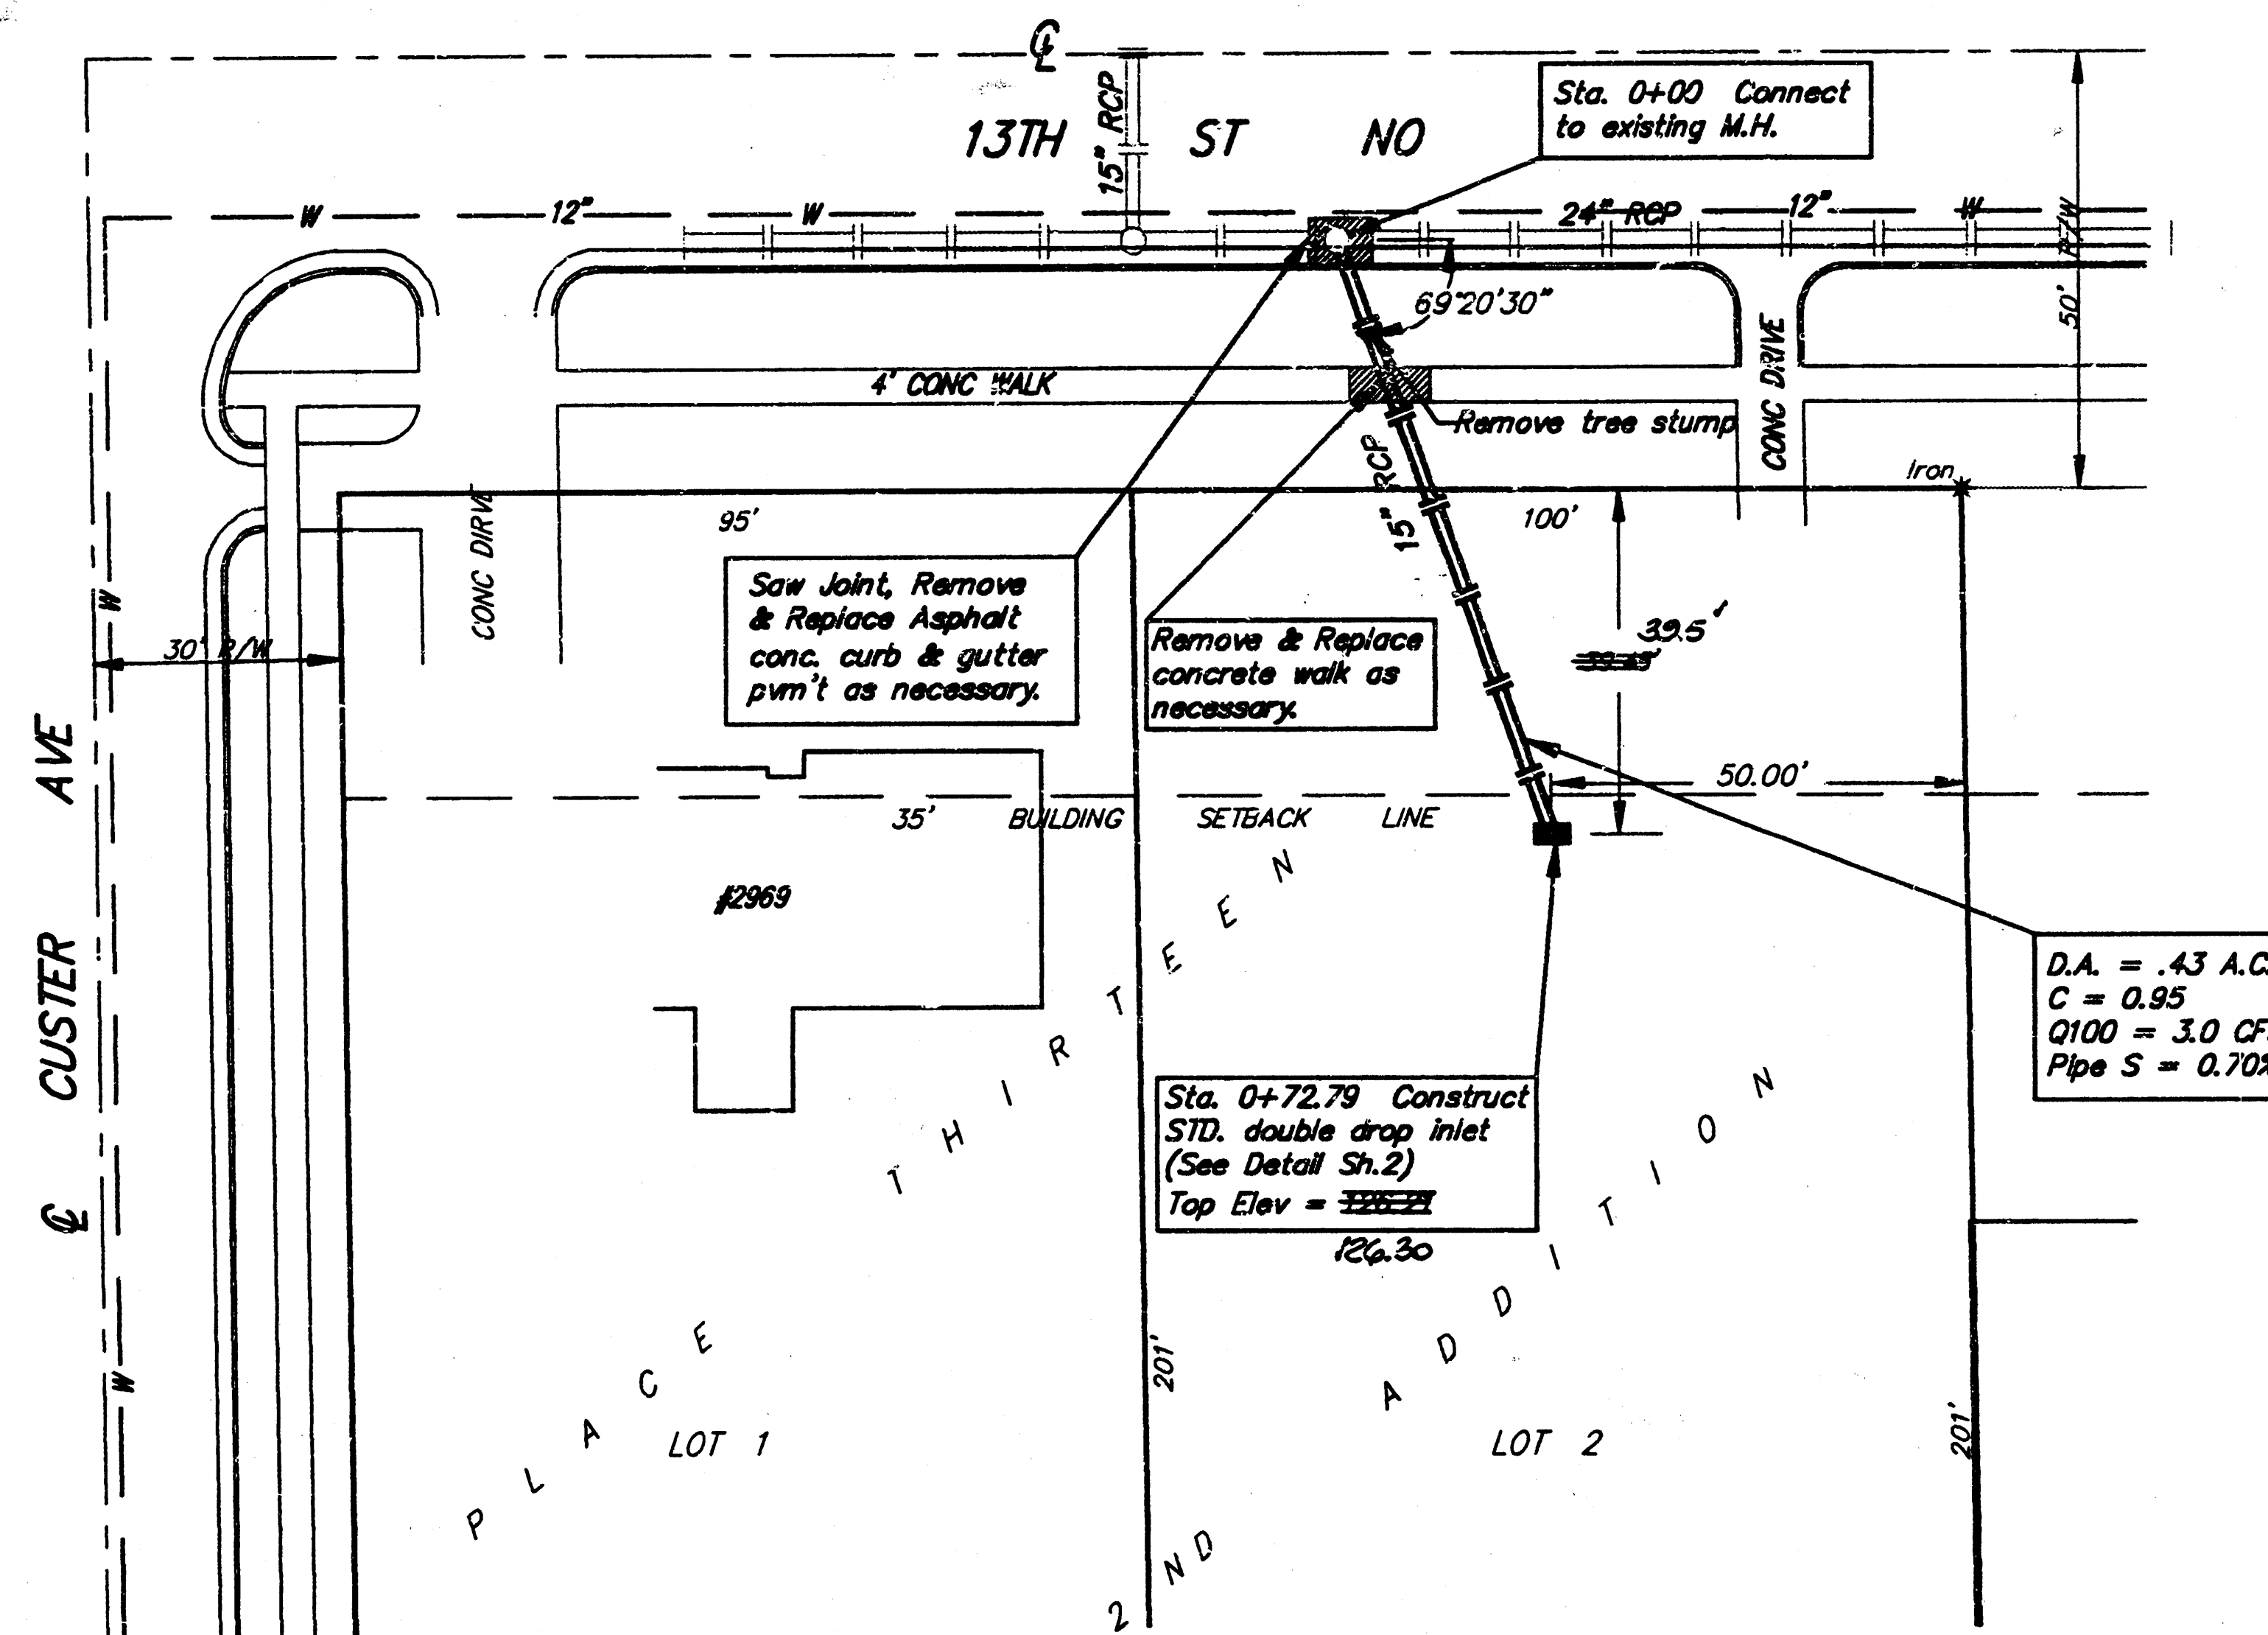

APPROVED AS NOTED
BY CITY ENGINEER OF MOHAWA



Sanitary Sewers _____
Storm Sewers VRH 9/8/92
Driveway Approaches _____
Water Mains _____
Paving _____

NOTE TO CONTRACTORS
Inspection and testing for this project is to be provided by a Licensed Consulting Engineering Firm under contract with the Owner/Developer. Said inspection is to be in accordance with the City of Wichita standard construction engineering practices and certified by a Licensed Professional Engineer. No work shall be performed in dedicated easements or public right-of-way by the Contractor without such inspection nor shall any work be commenced without written authorization by the City Engineer.

Booked As Built
2-22-93, LEP
D-200

SCALE: 1" = 20' HORIZ.
1" = 5' VERT.

BENCH MARK:
CITY STANDARD DISC, 29.5' E AND 35.9' N OF CENTER OF
SHERIDAN & 13TH STREET NO. ELEV = 125.72 CITY DATUM
SQUARE CUT ON TOP OF CURB AT WEST END OF CURB
RETURN AT S.W. CORNER OF CUSTER & 13TH ST. NO.
ELEV = 127.93 CITY DATUM

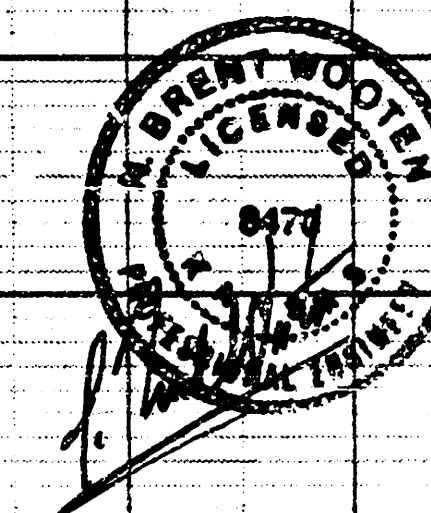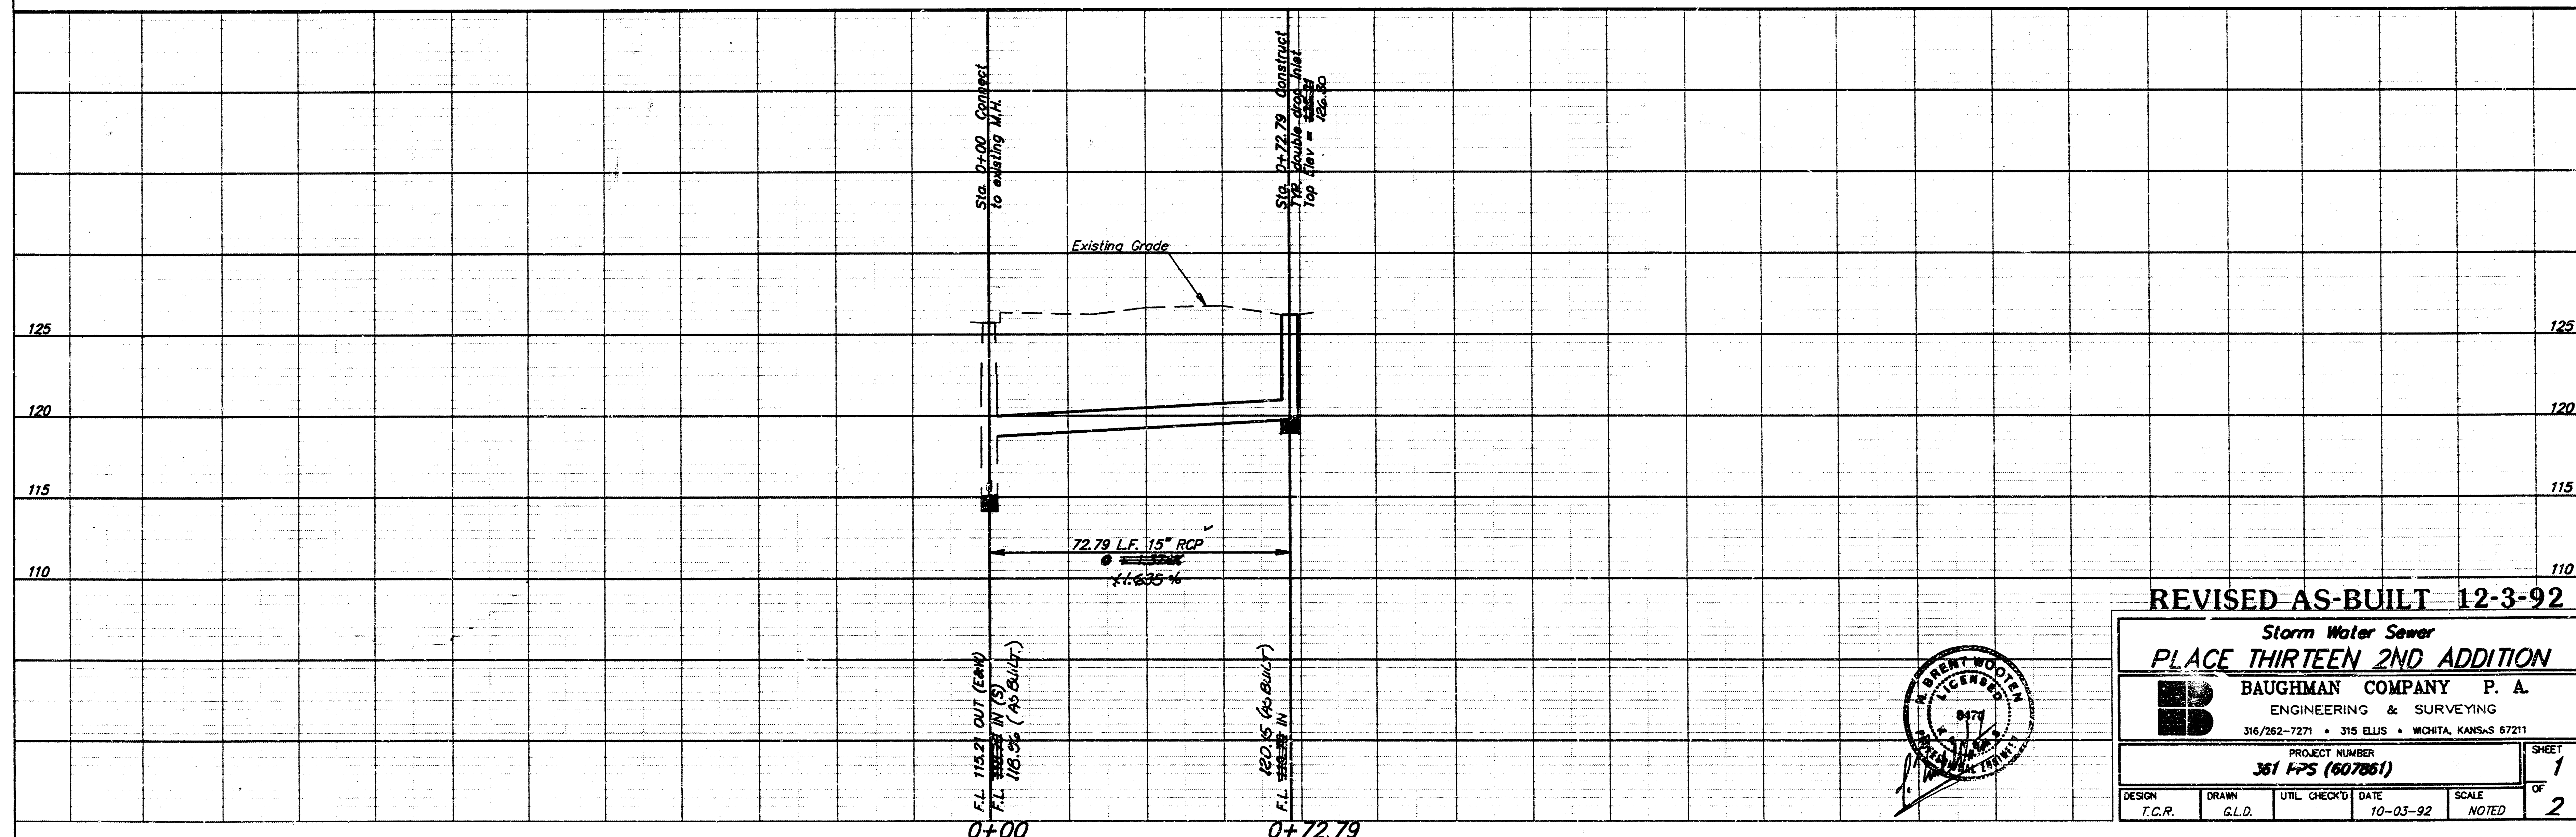



REVISED AS-BUILT 12-3-92

Storm Water Sewer
PLACE THIRTEEN 2ND ADDITION

BAUGHMAN COMPANY P. A.
ENGINEERING & SURVEYING
316/282-7271 • 315 ELLIS • WICHITA, KANSAS 67211


PROJECT NUMBER
361 FPS (607861)

DESIGN T.C.R.	DRAWN G.L.D.	UTIL. CHECK'D DATE 10-03-92	SCALE NOTED	SHEET 1 OF 2
------------------	-----------------	-----------------------------------	----------------	-----------------

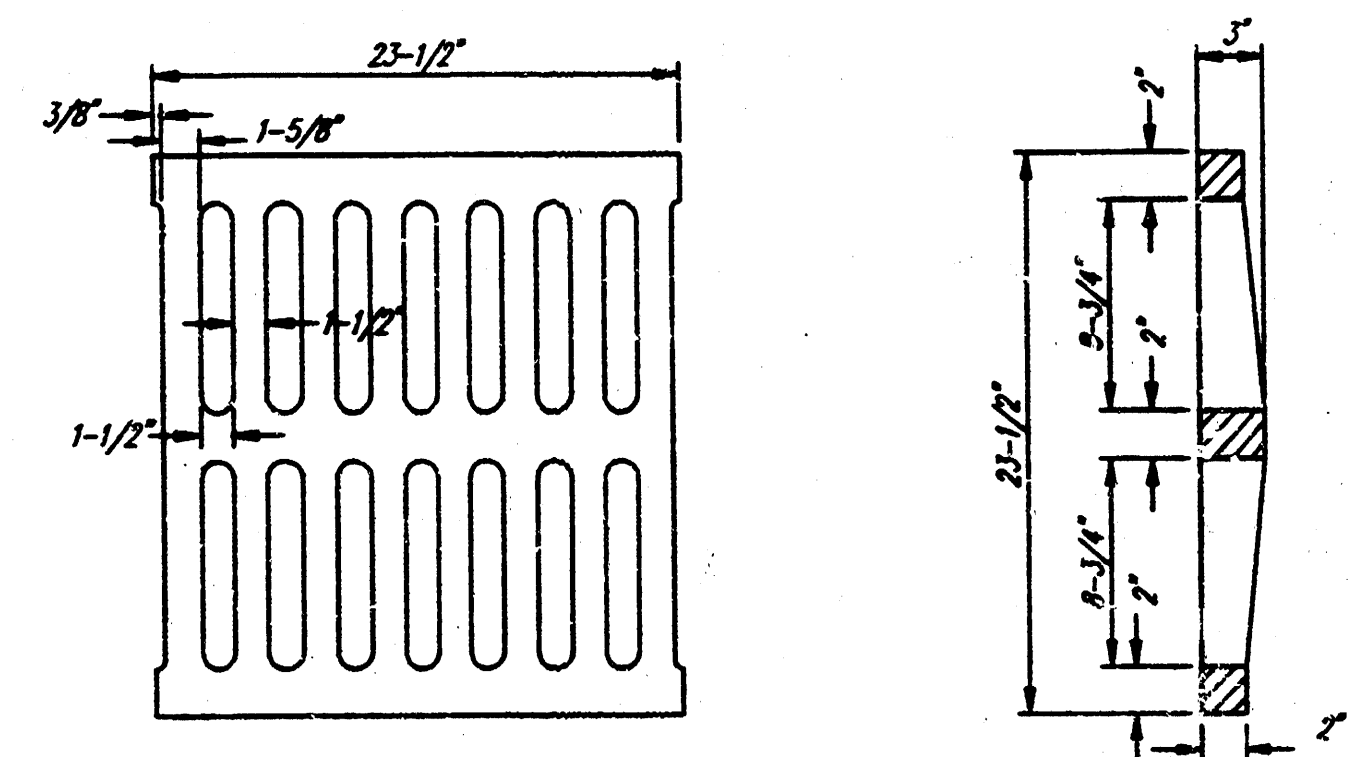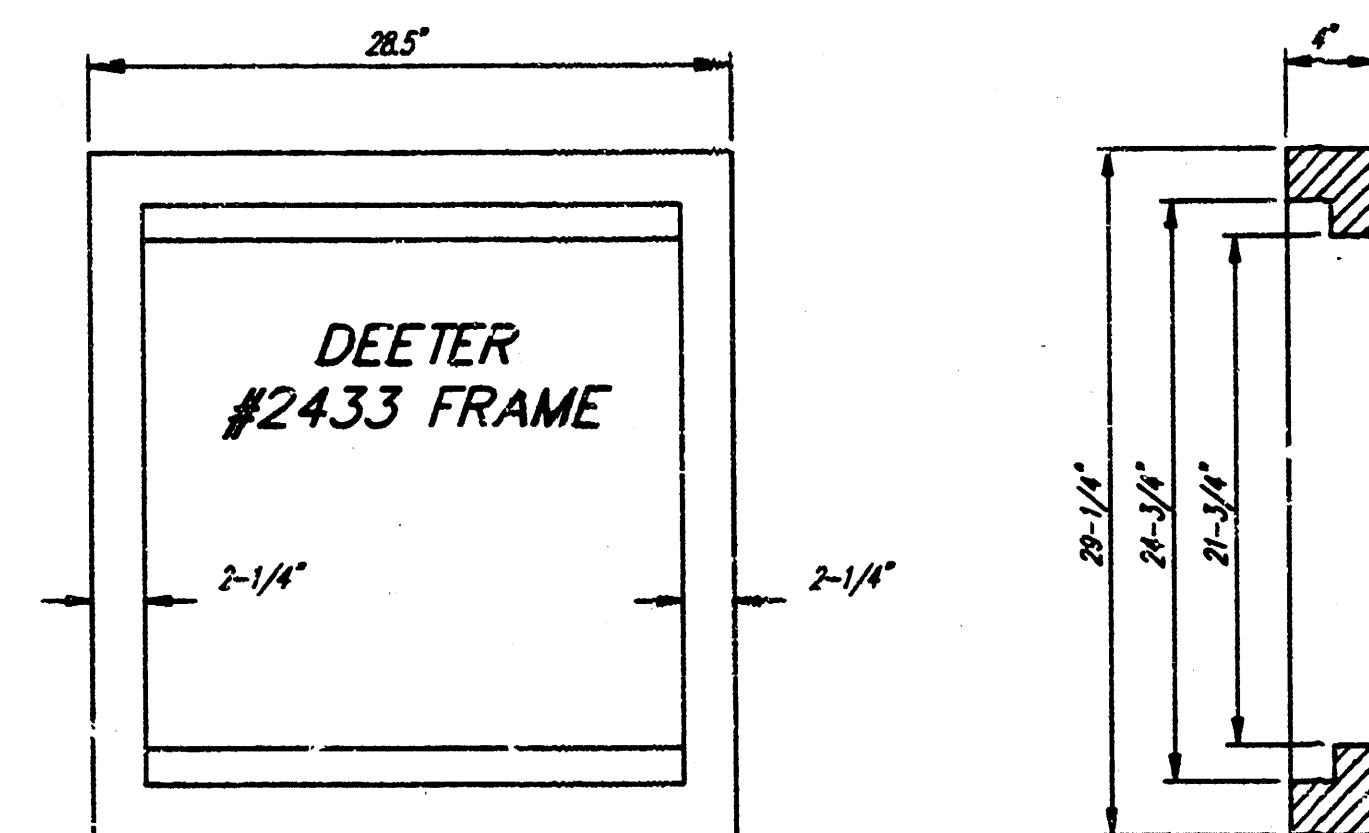



DEETER #2433 GRATE

24" x 24" Frame and Grate Detail

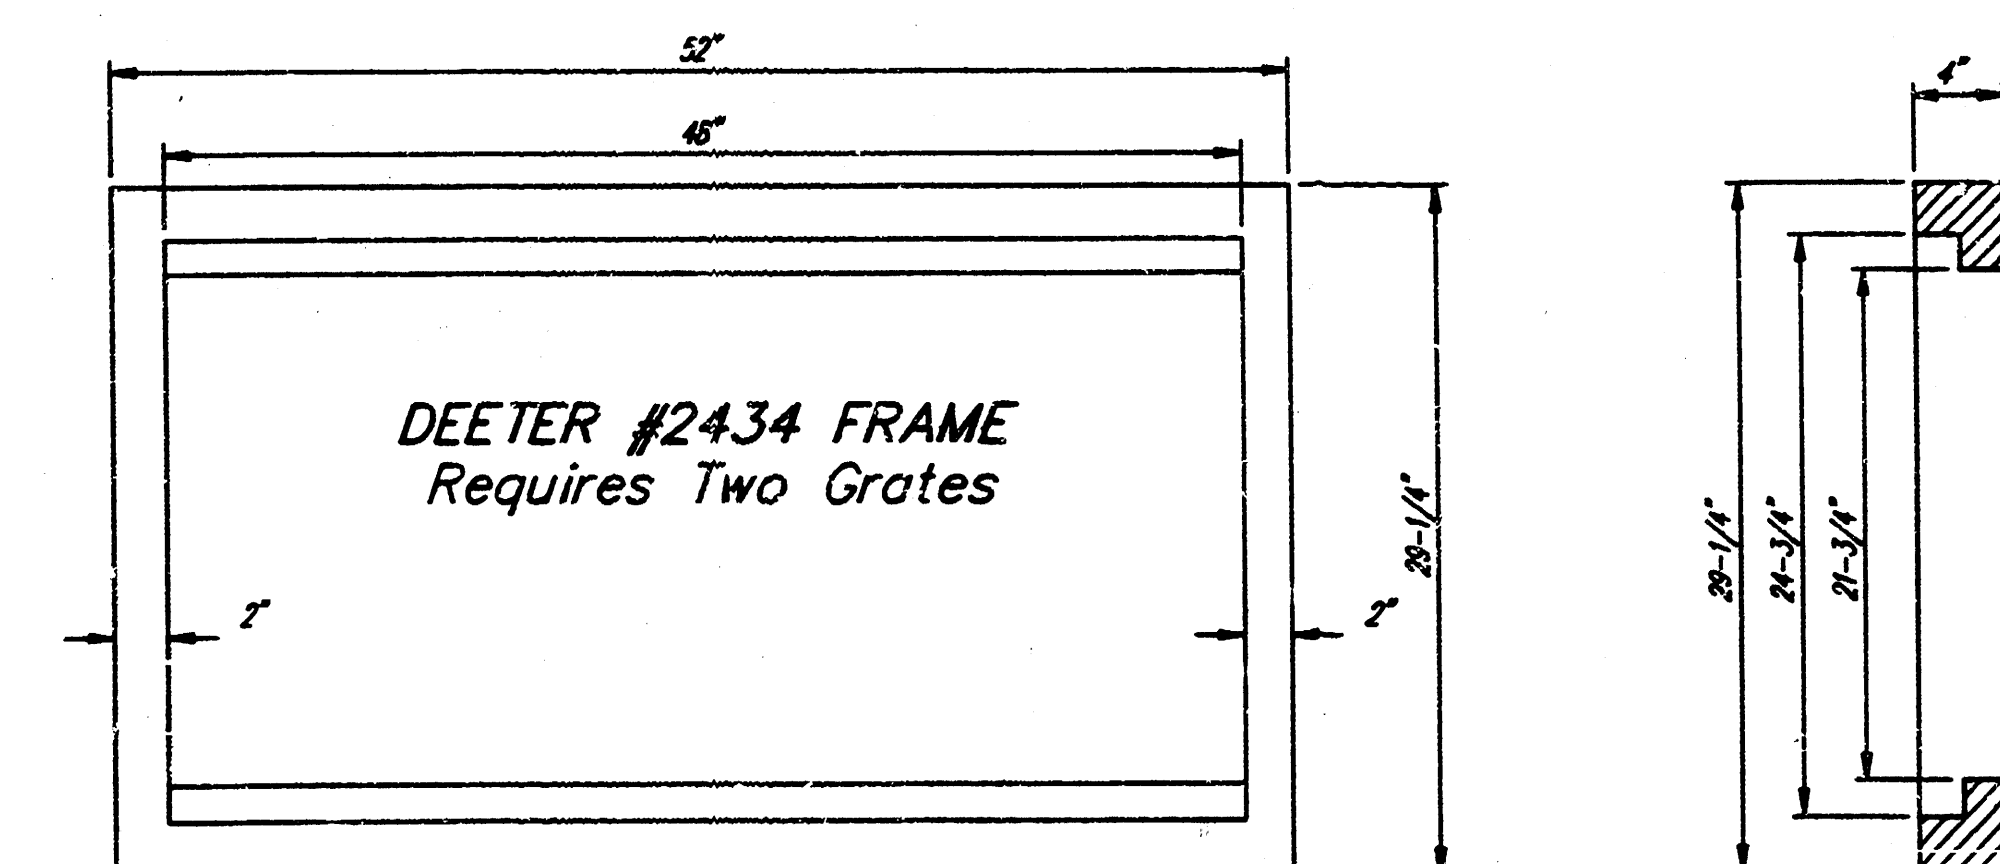


Double 24" x 24" Frame Detail

NOTE: Grates shall be imprinted on the top surface with "CITY OF WICHITA" using letters at least 1" in height. Other marking methods may be approved by the engineer.

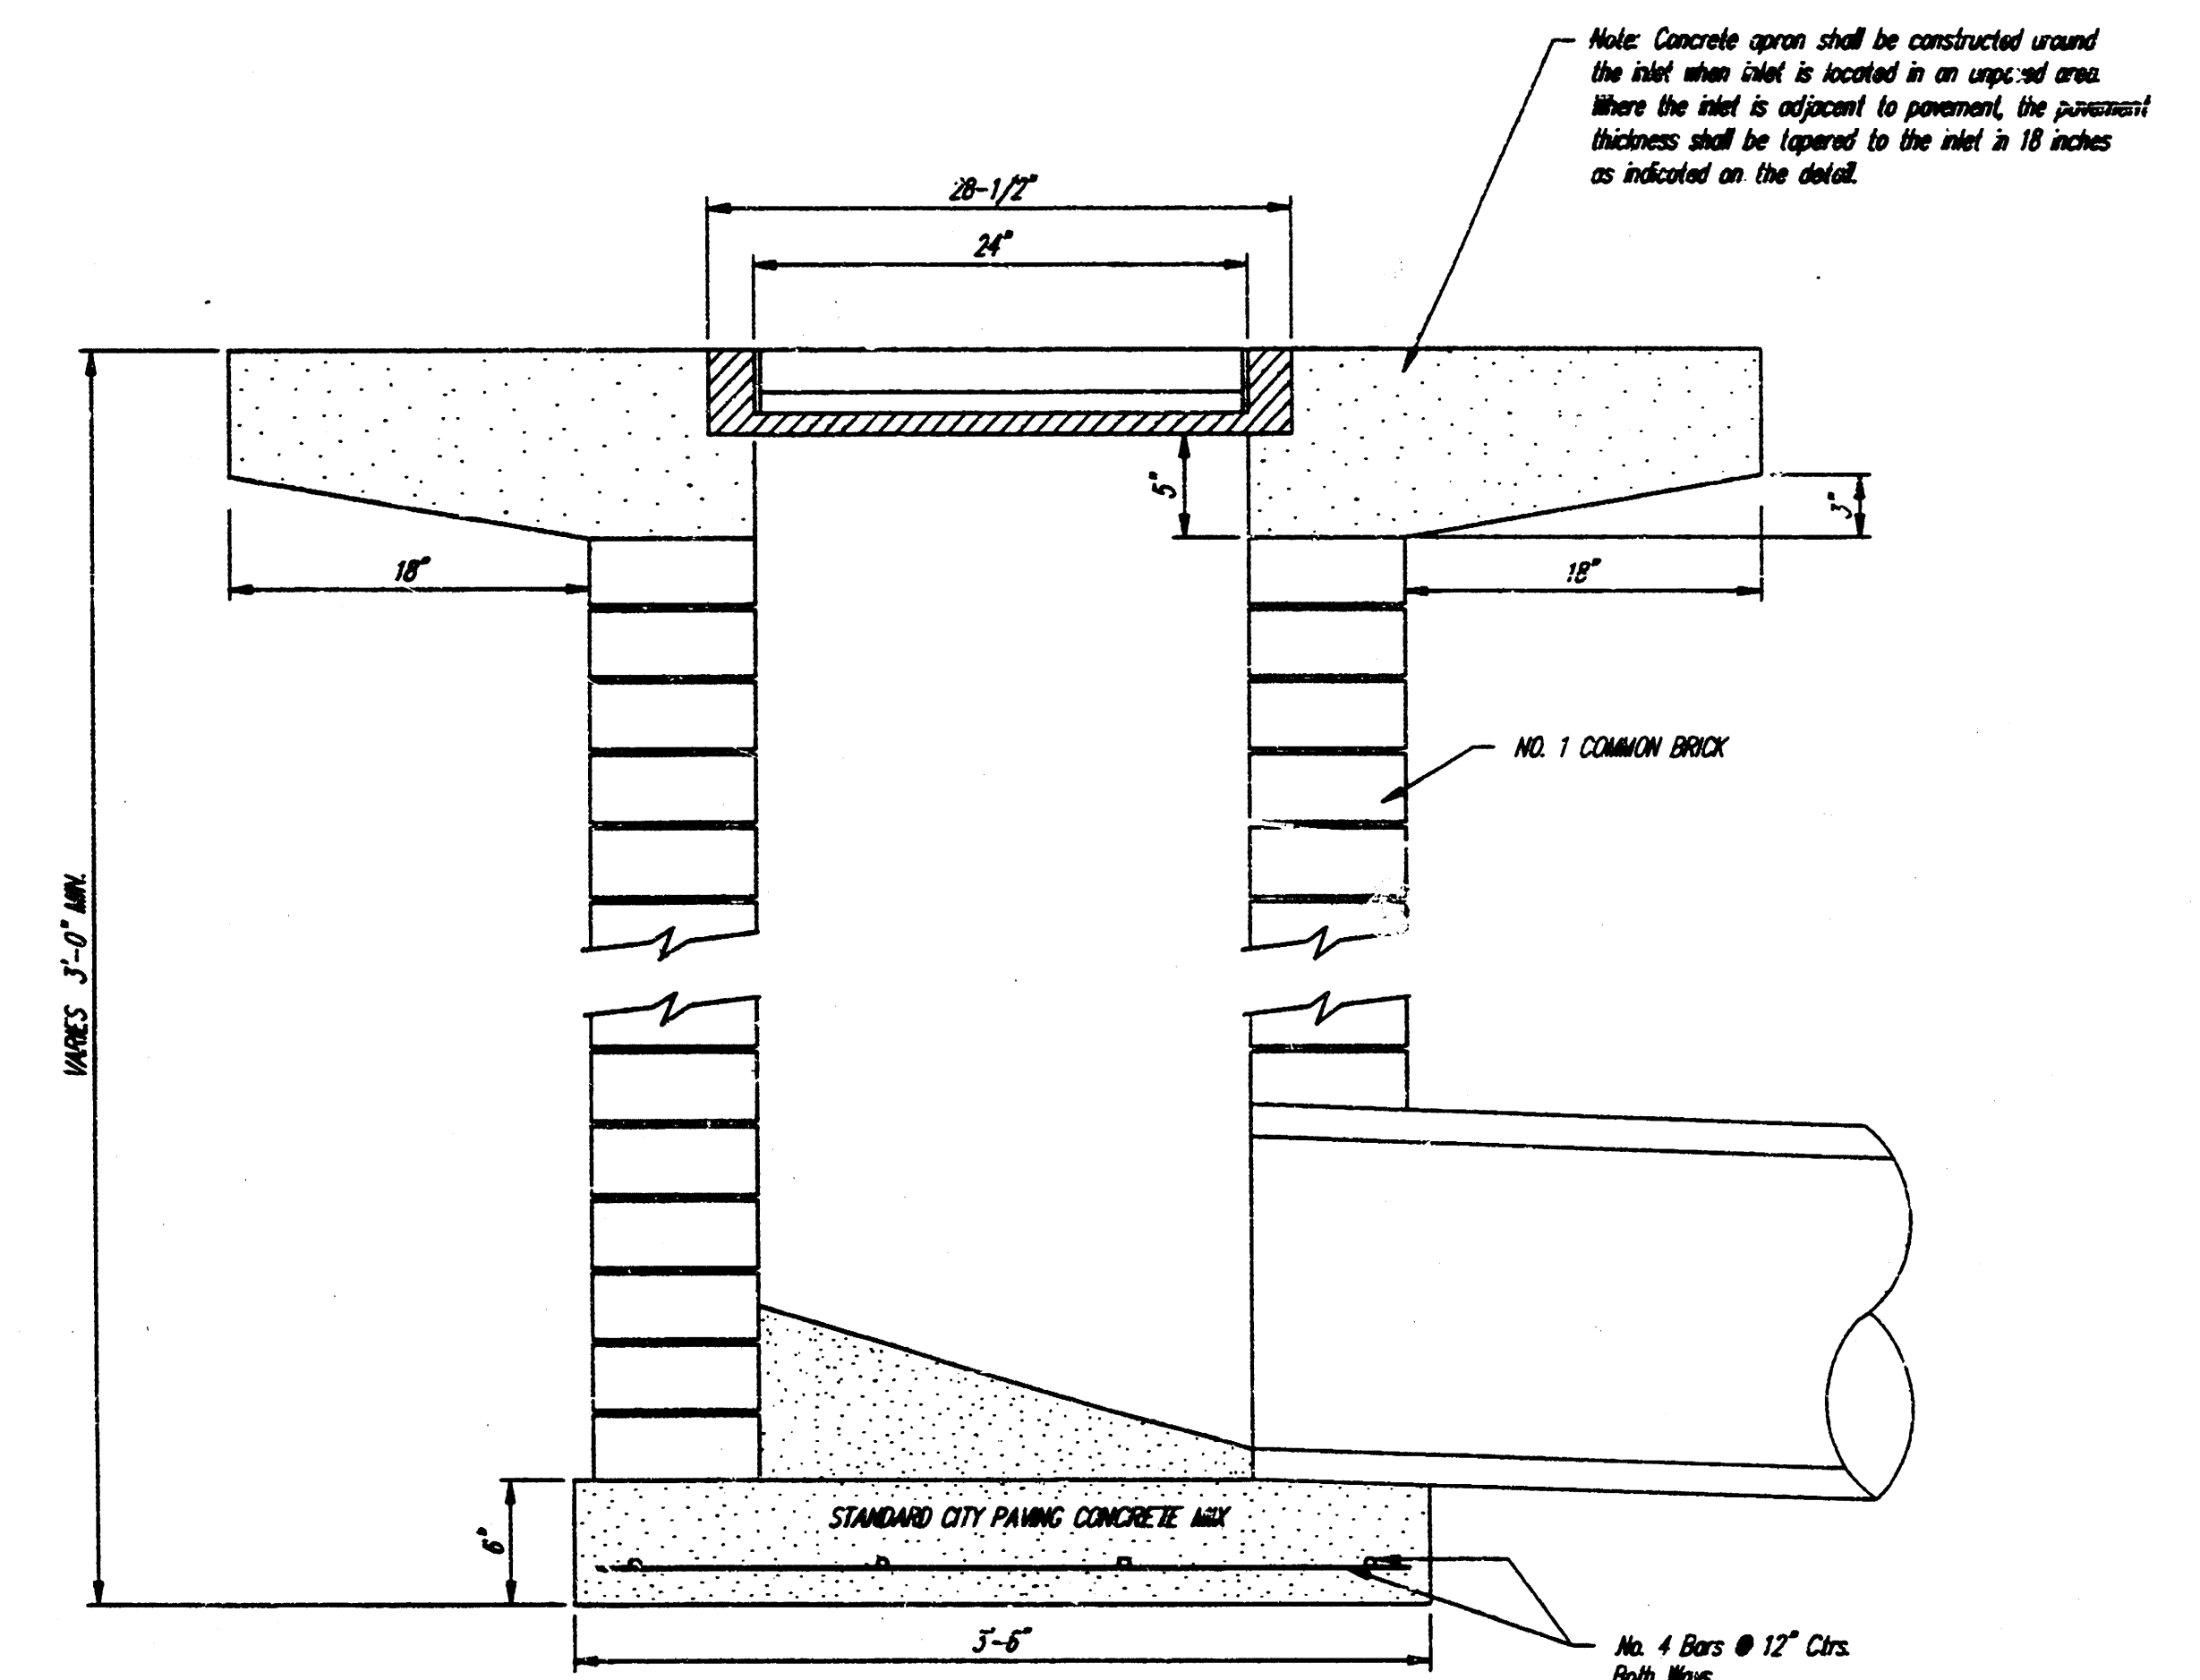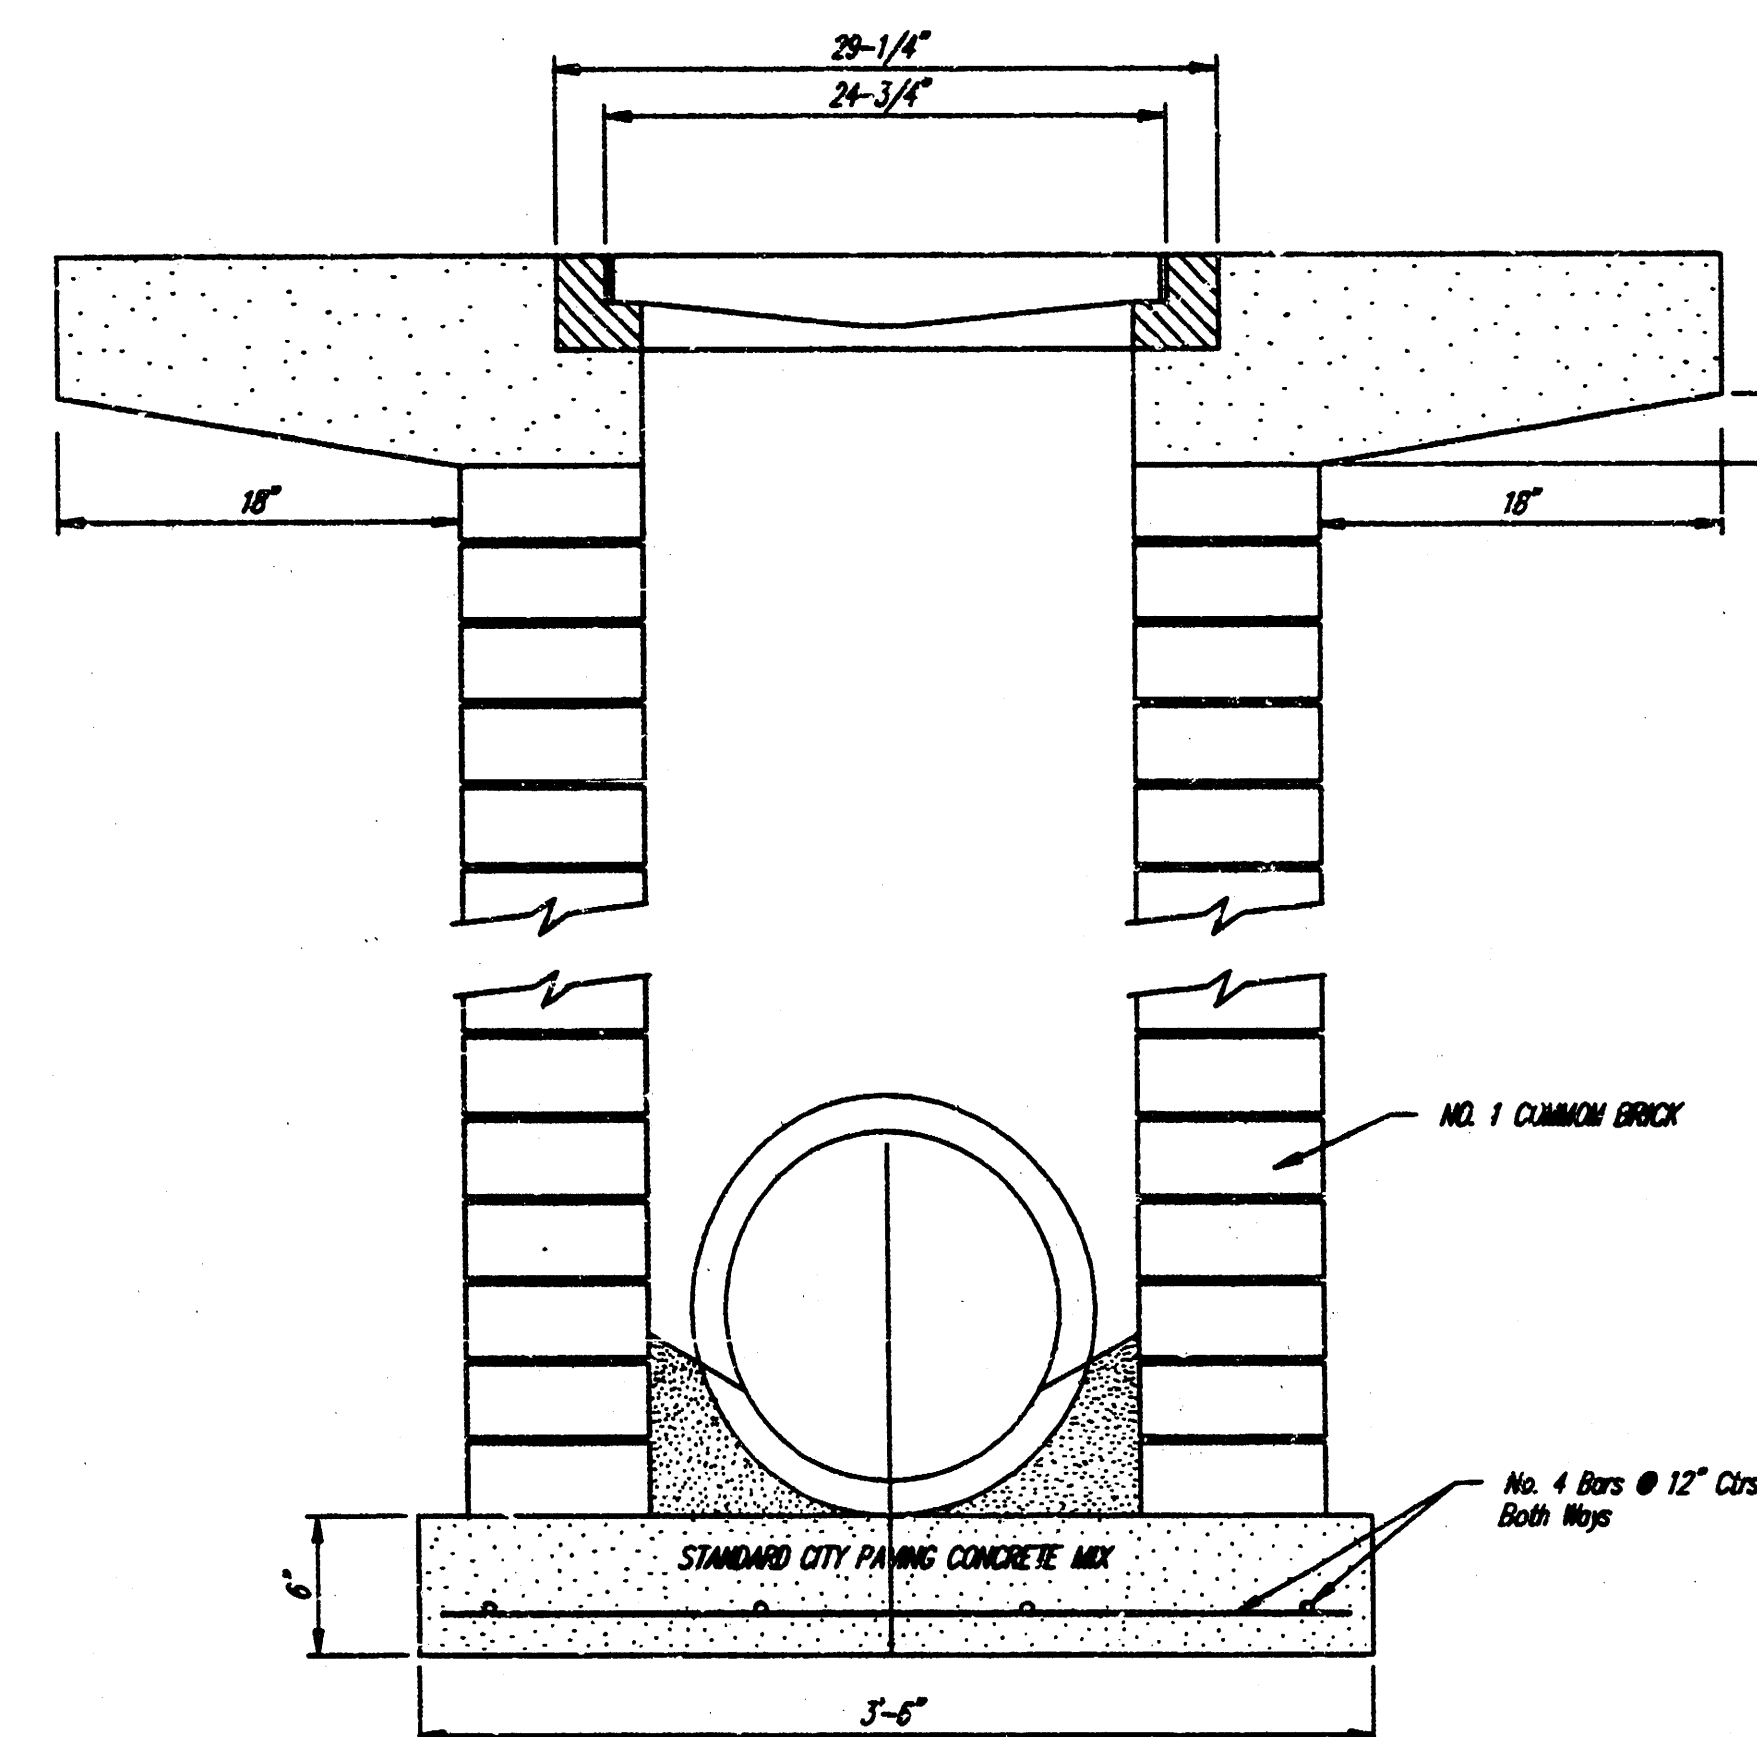

Note: Concrete apron shall be constructed around the inlet when inlet is located in an exposed area. Where the inlet is adjacent to pavement, the pavement thickness shall be tapered to the inlet a 18 inches as indicated on the detail.

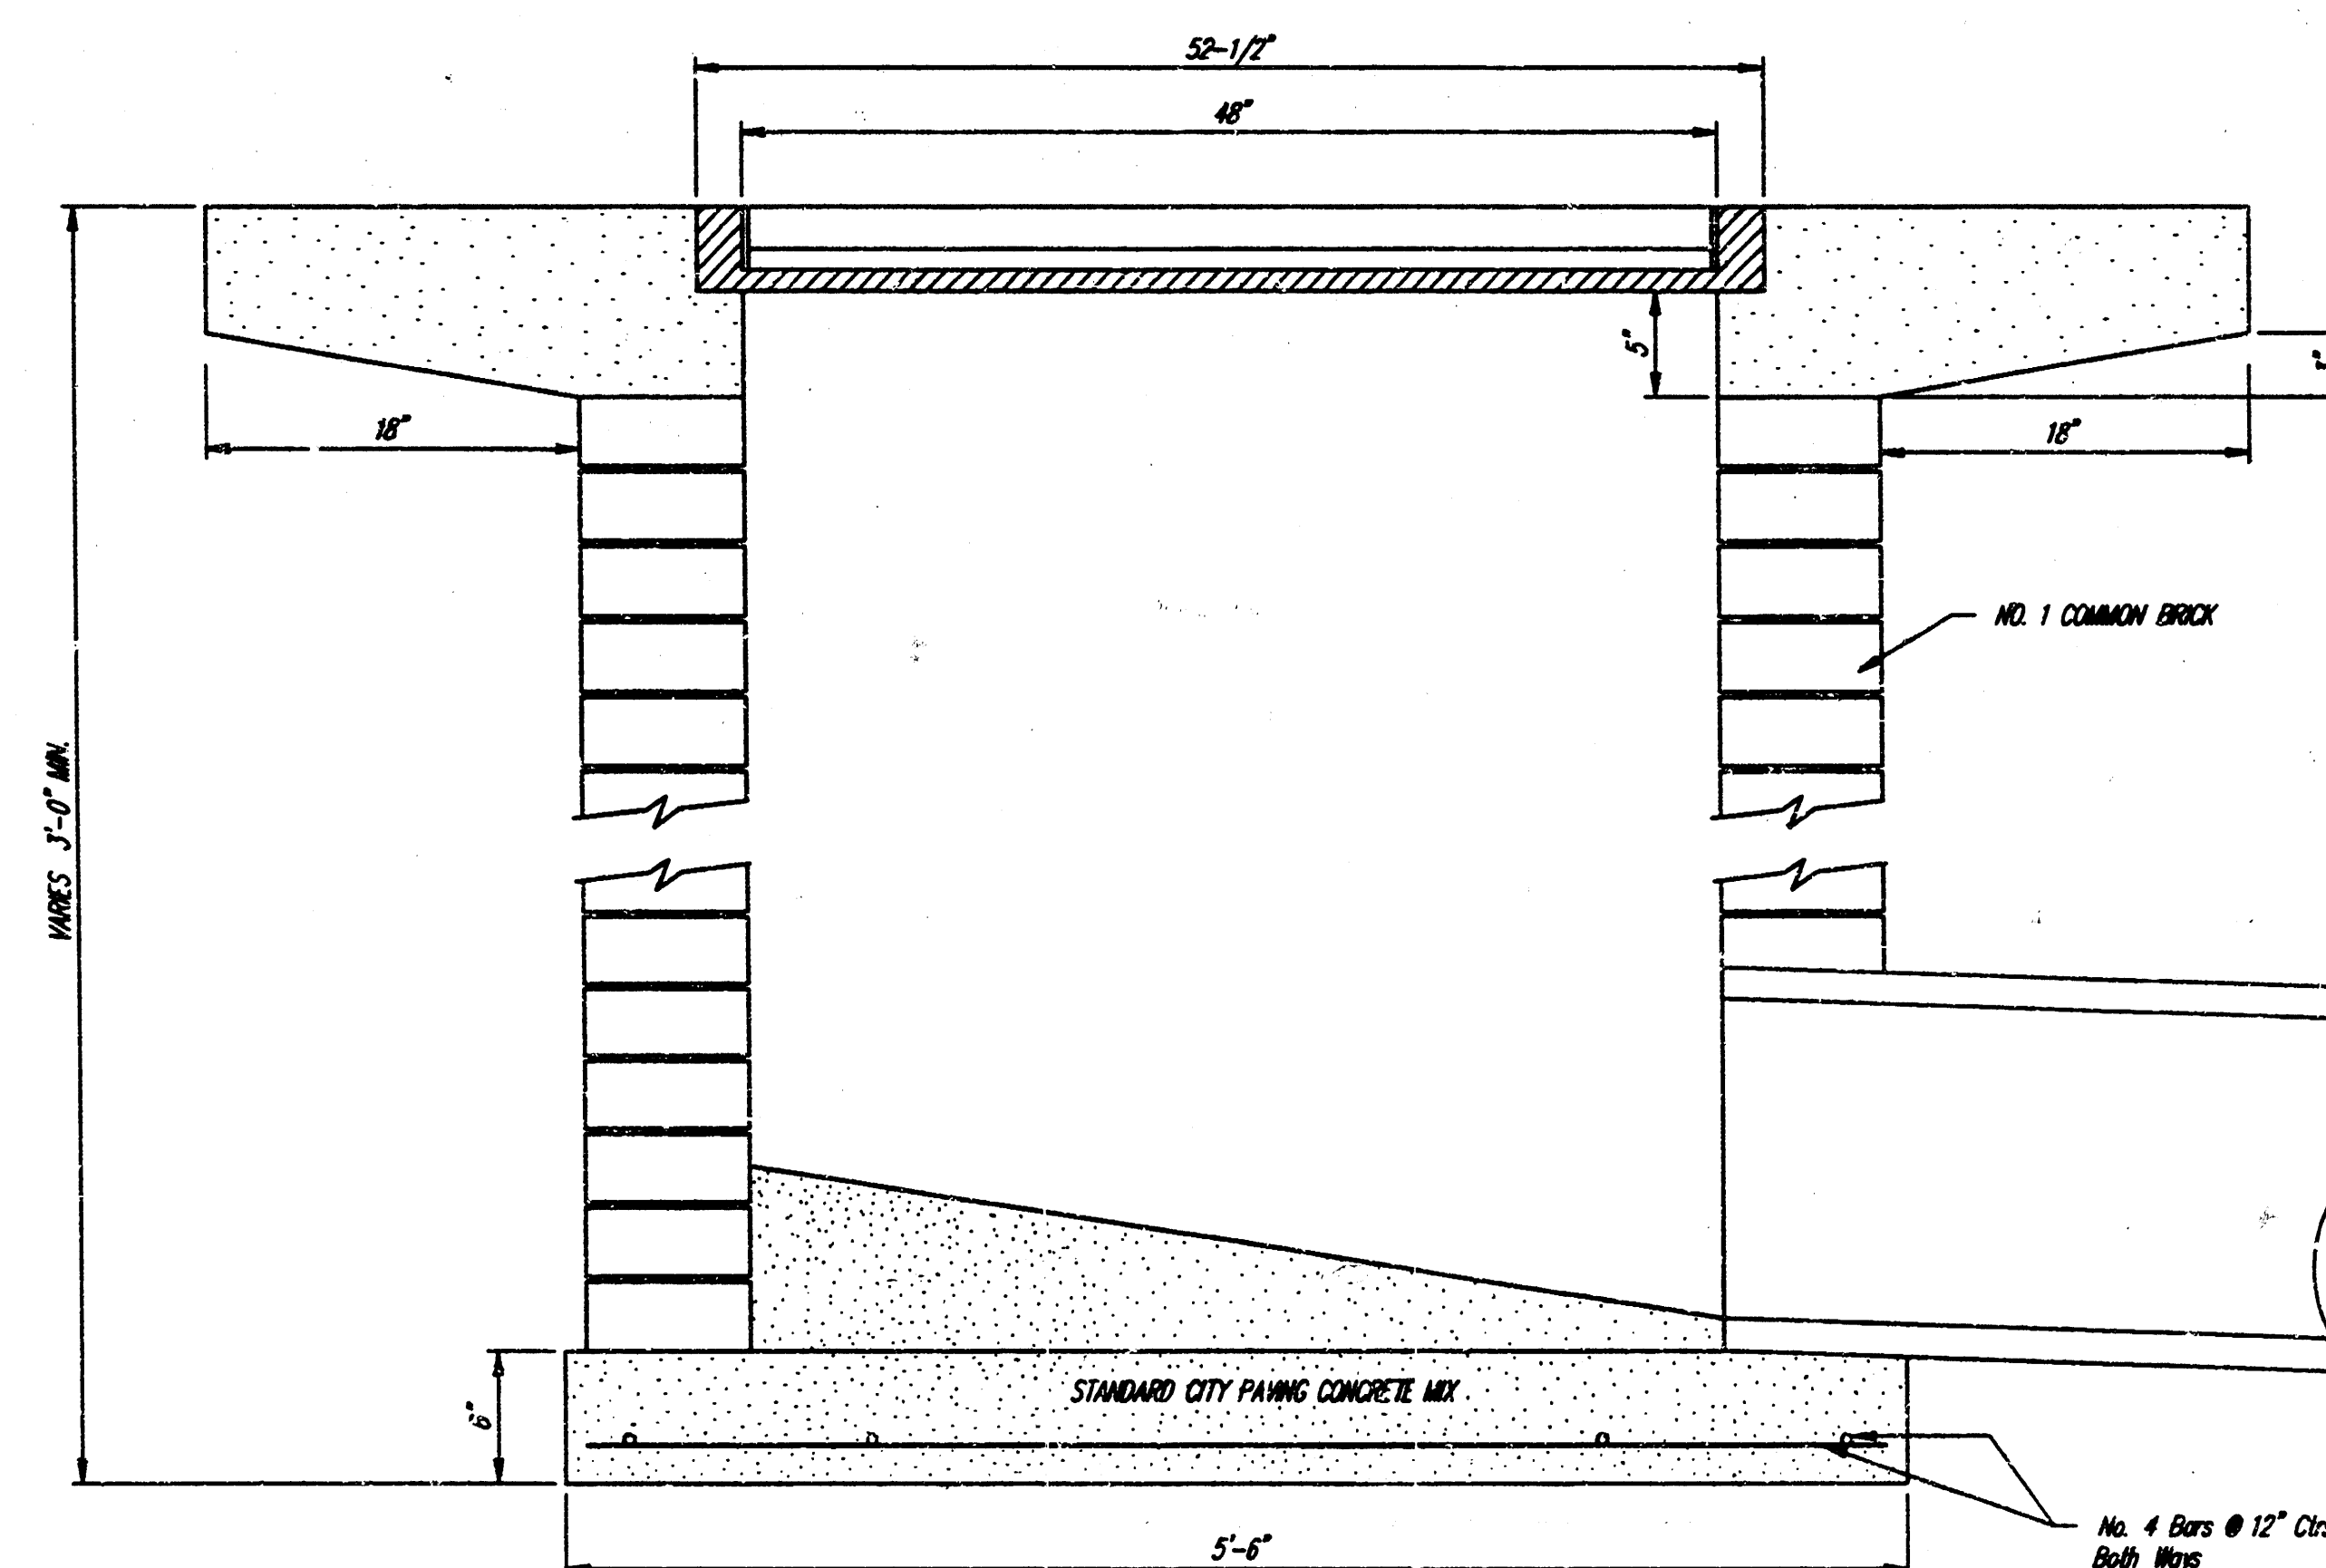

DROP INLET DETAILS
M.E. Lindebak, City Engineer
City of Wichita, Kansas

Project Number

361 PPS(607861)

2

2