


STORM WATER SEWER NO. 252

PROJECT NO.
468 76 245 81276 000 000 001



AS BUILT PLAN
9/84
M.C. GREENE

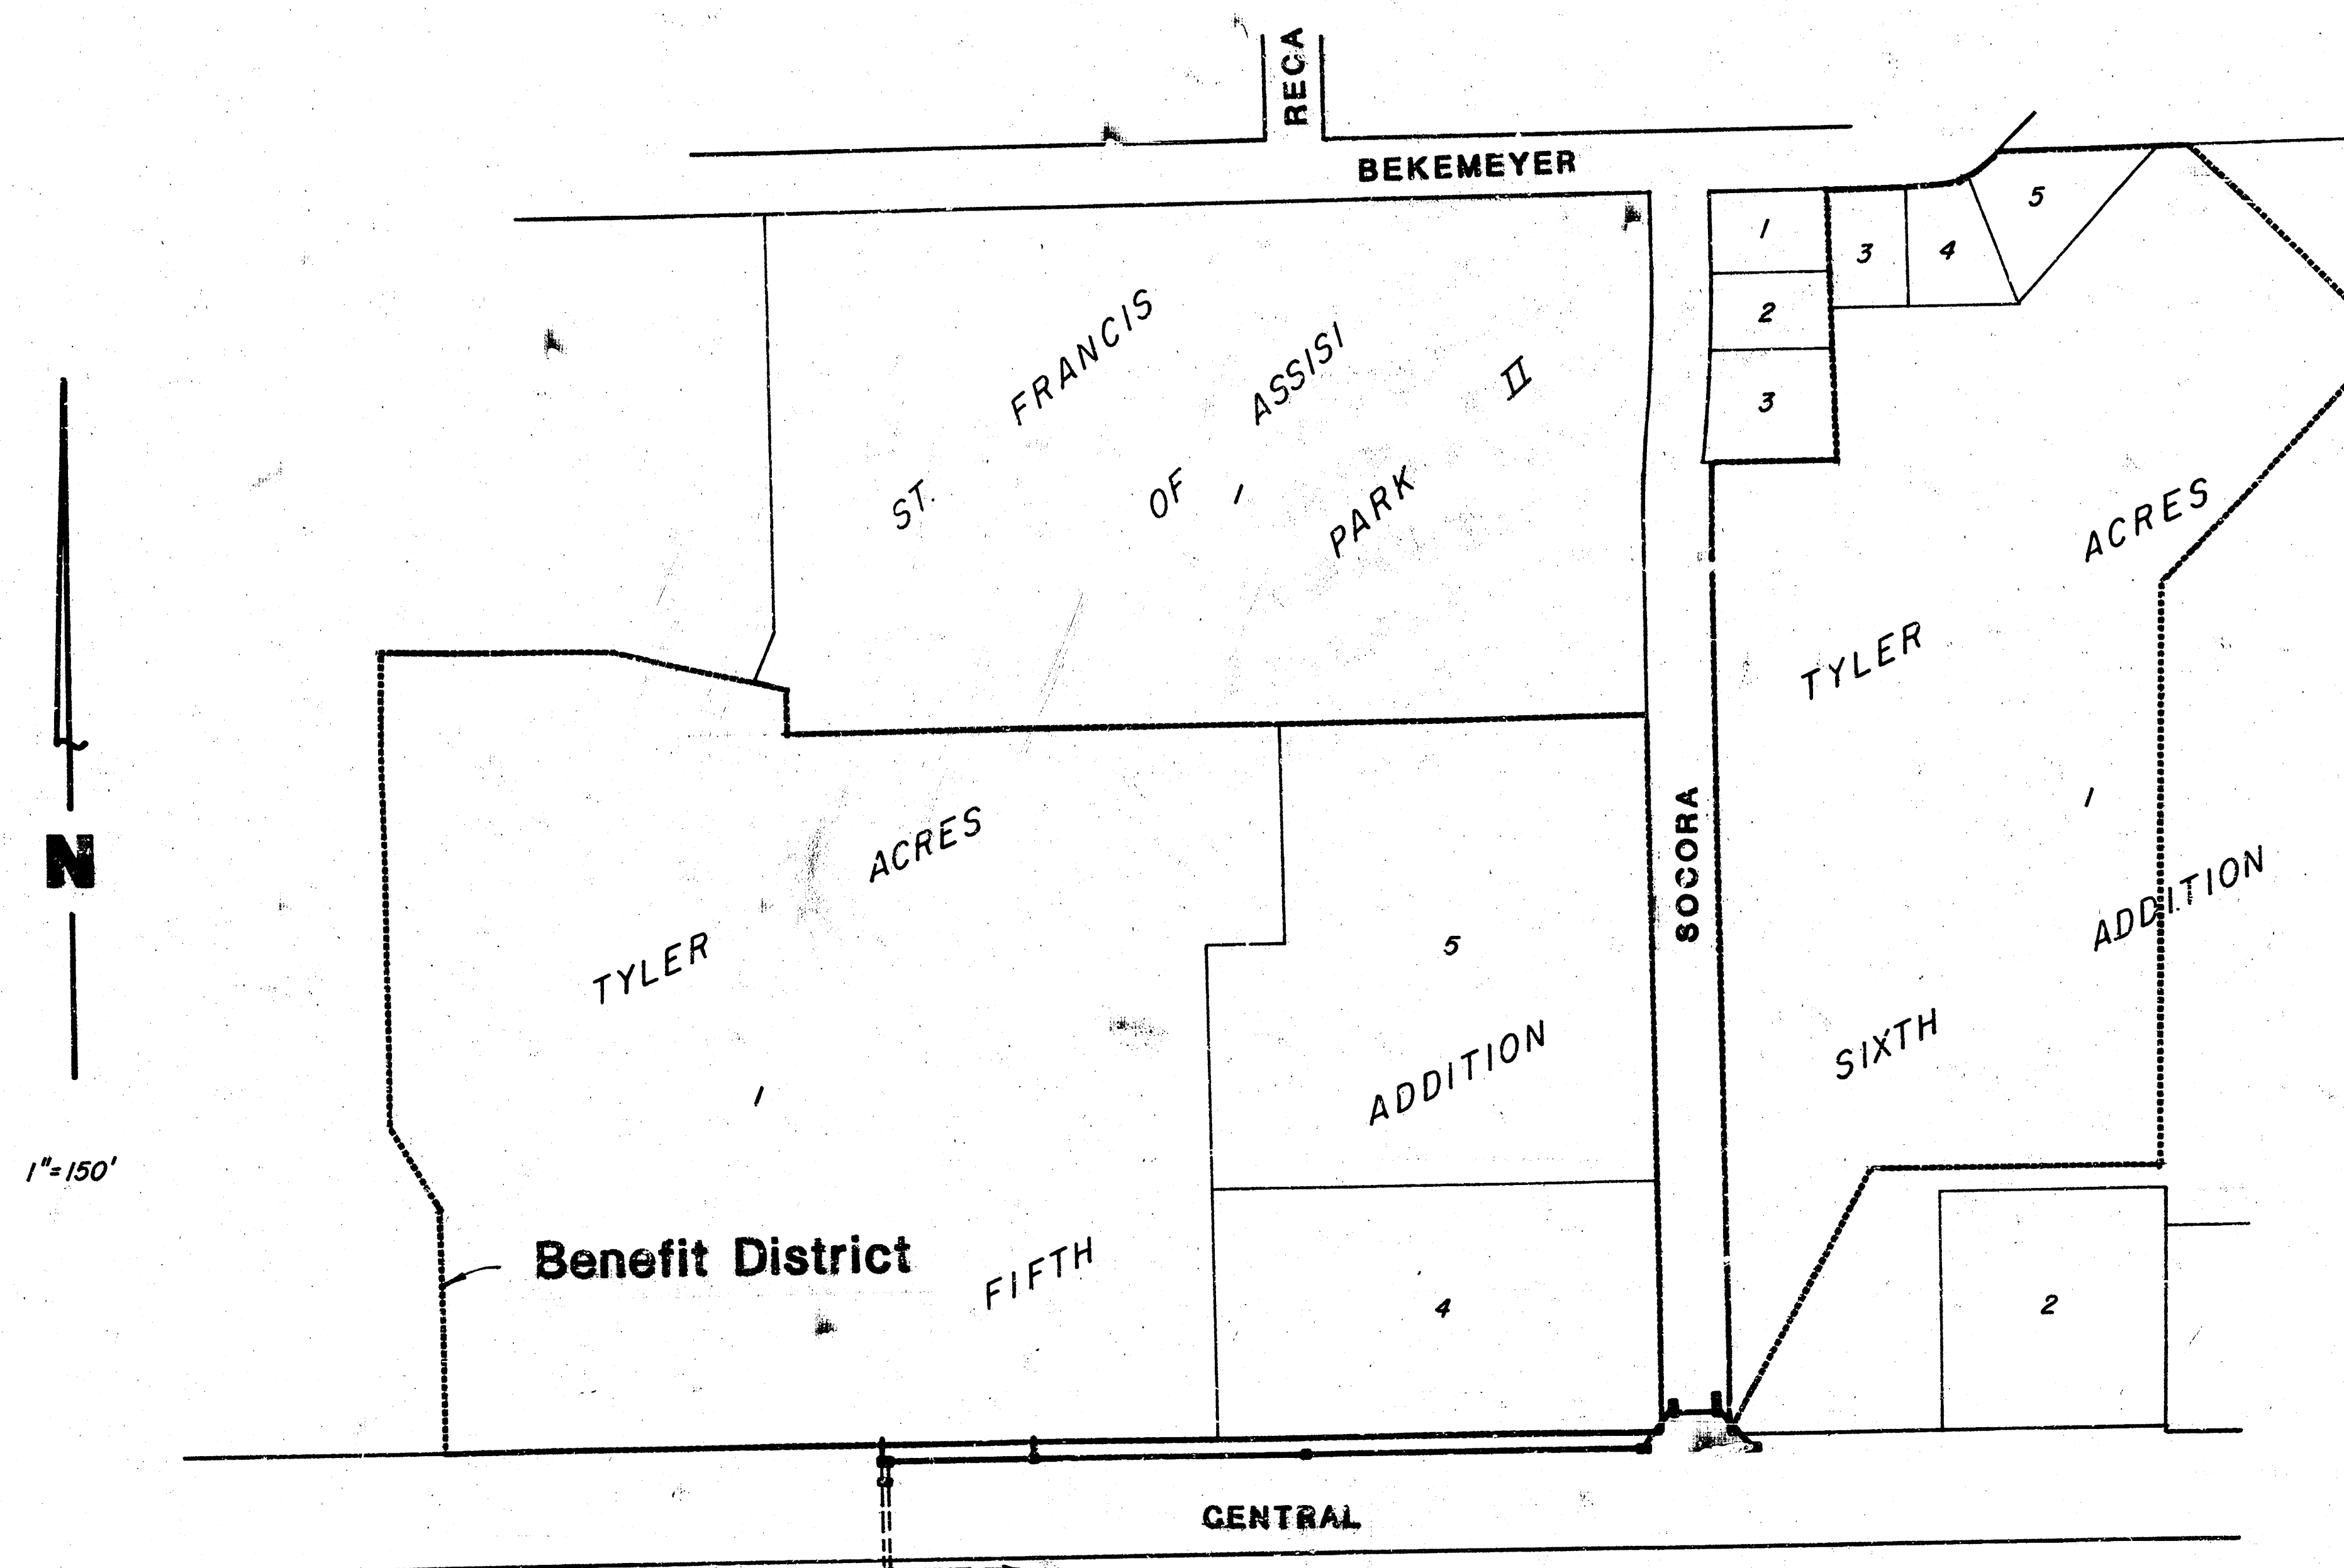


CITY OF WICHITA , KS.
MIKE E. LINDEBAK CITY ENGINEER

General Notes, Sheet 4

MAY 84

BAUGHMAN COMPANY, P.A.
SURVEYING & ENGINEERING
316/262-7271 • 339 LAURA • WICHITA, KANSAS 6721


 $\frac{1}{6}$

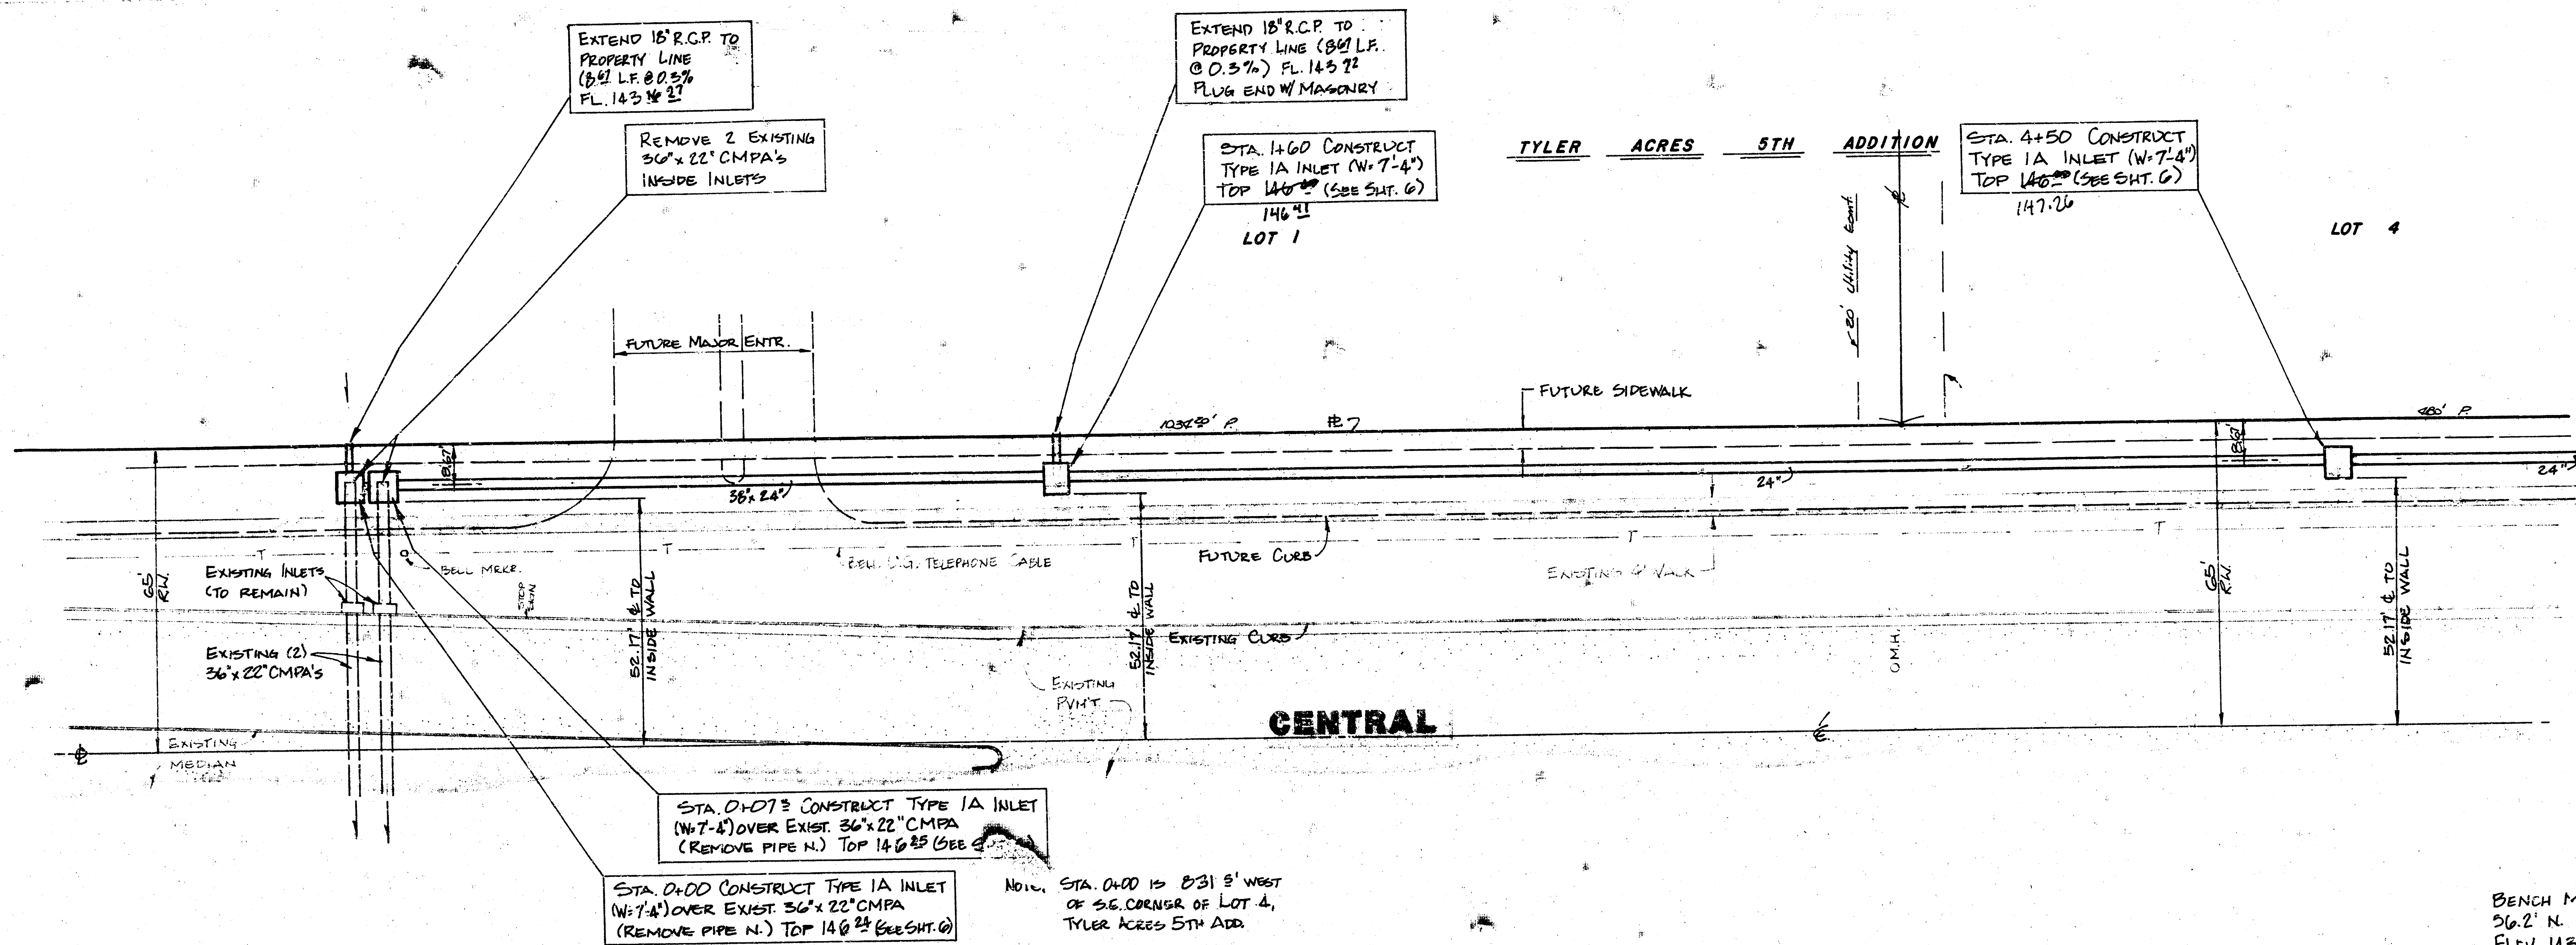

As Built Plans
9/84
McGraw-Hill

BENCH MARK: CITY OF WICHITA DISC.
26.2' N. & 38' W. OF E. CENTRAL & TYLER,
ELEV. 143.90

PROFILE SCALE
1"=20' HORIZ.
1"=5' VERT.

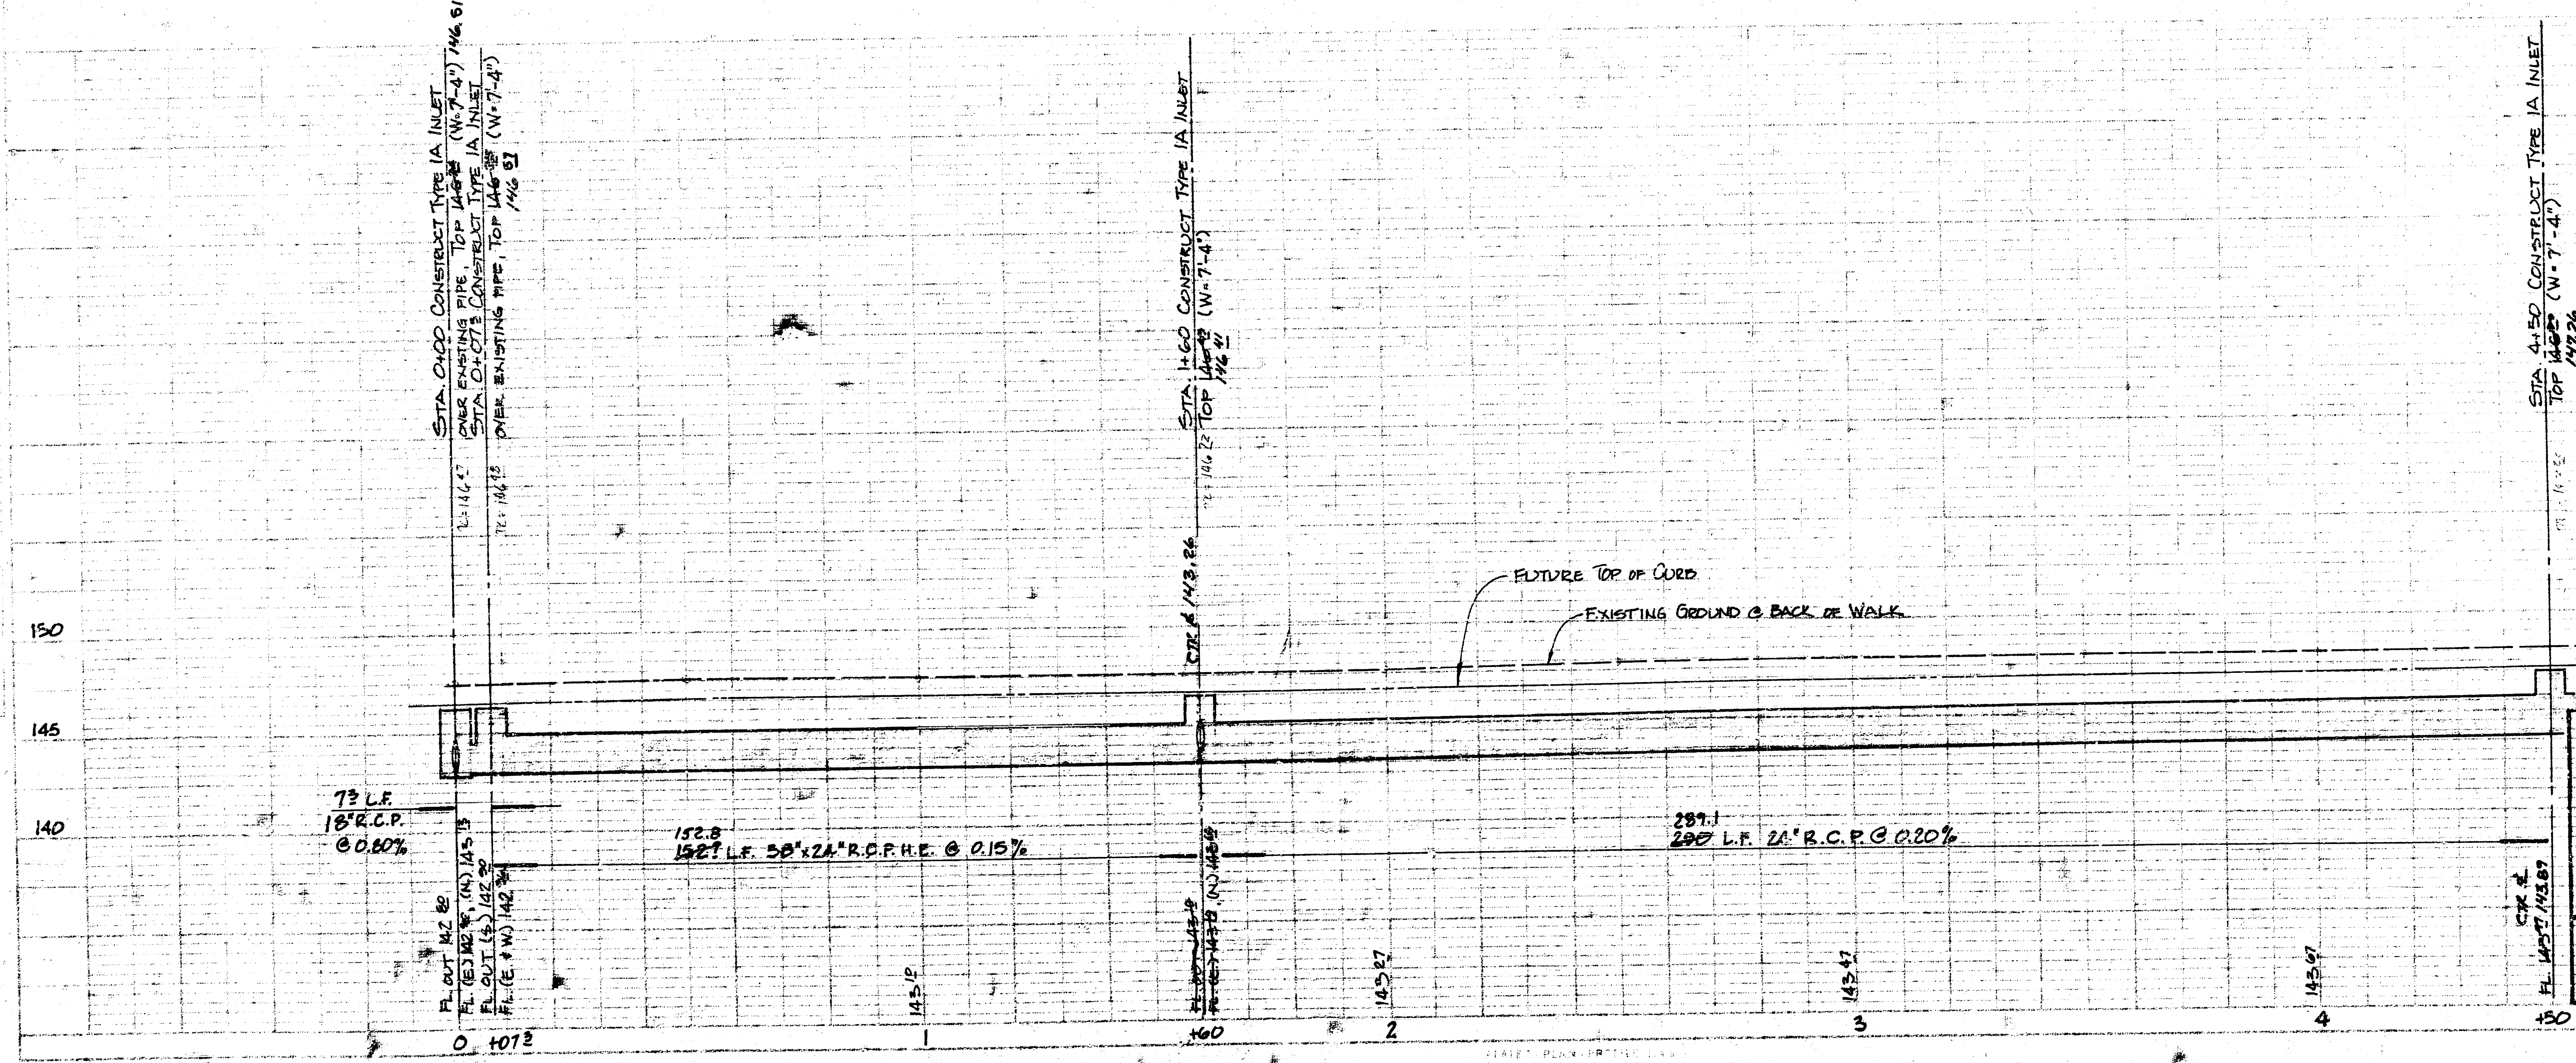


STORM WATER SEWER #252

PLAN and PROFILE

Project no. 468-76-245-81276-000-000-001

BAUGHMAN COMPANY, P.A.
SURVEYING & ENGINEERING
316/262-7271 • 330 LAURA • WICHITA, KANSAS 67211

2/6

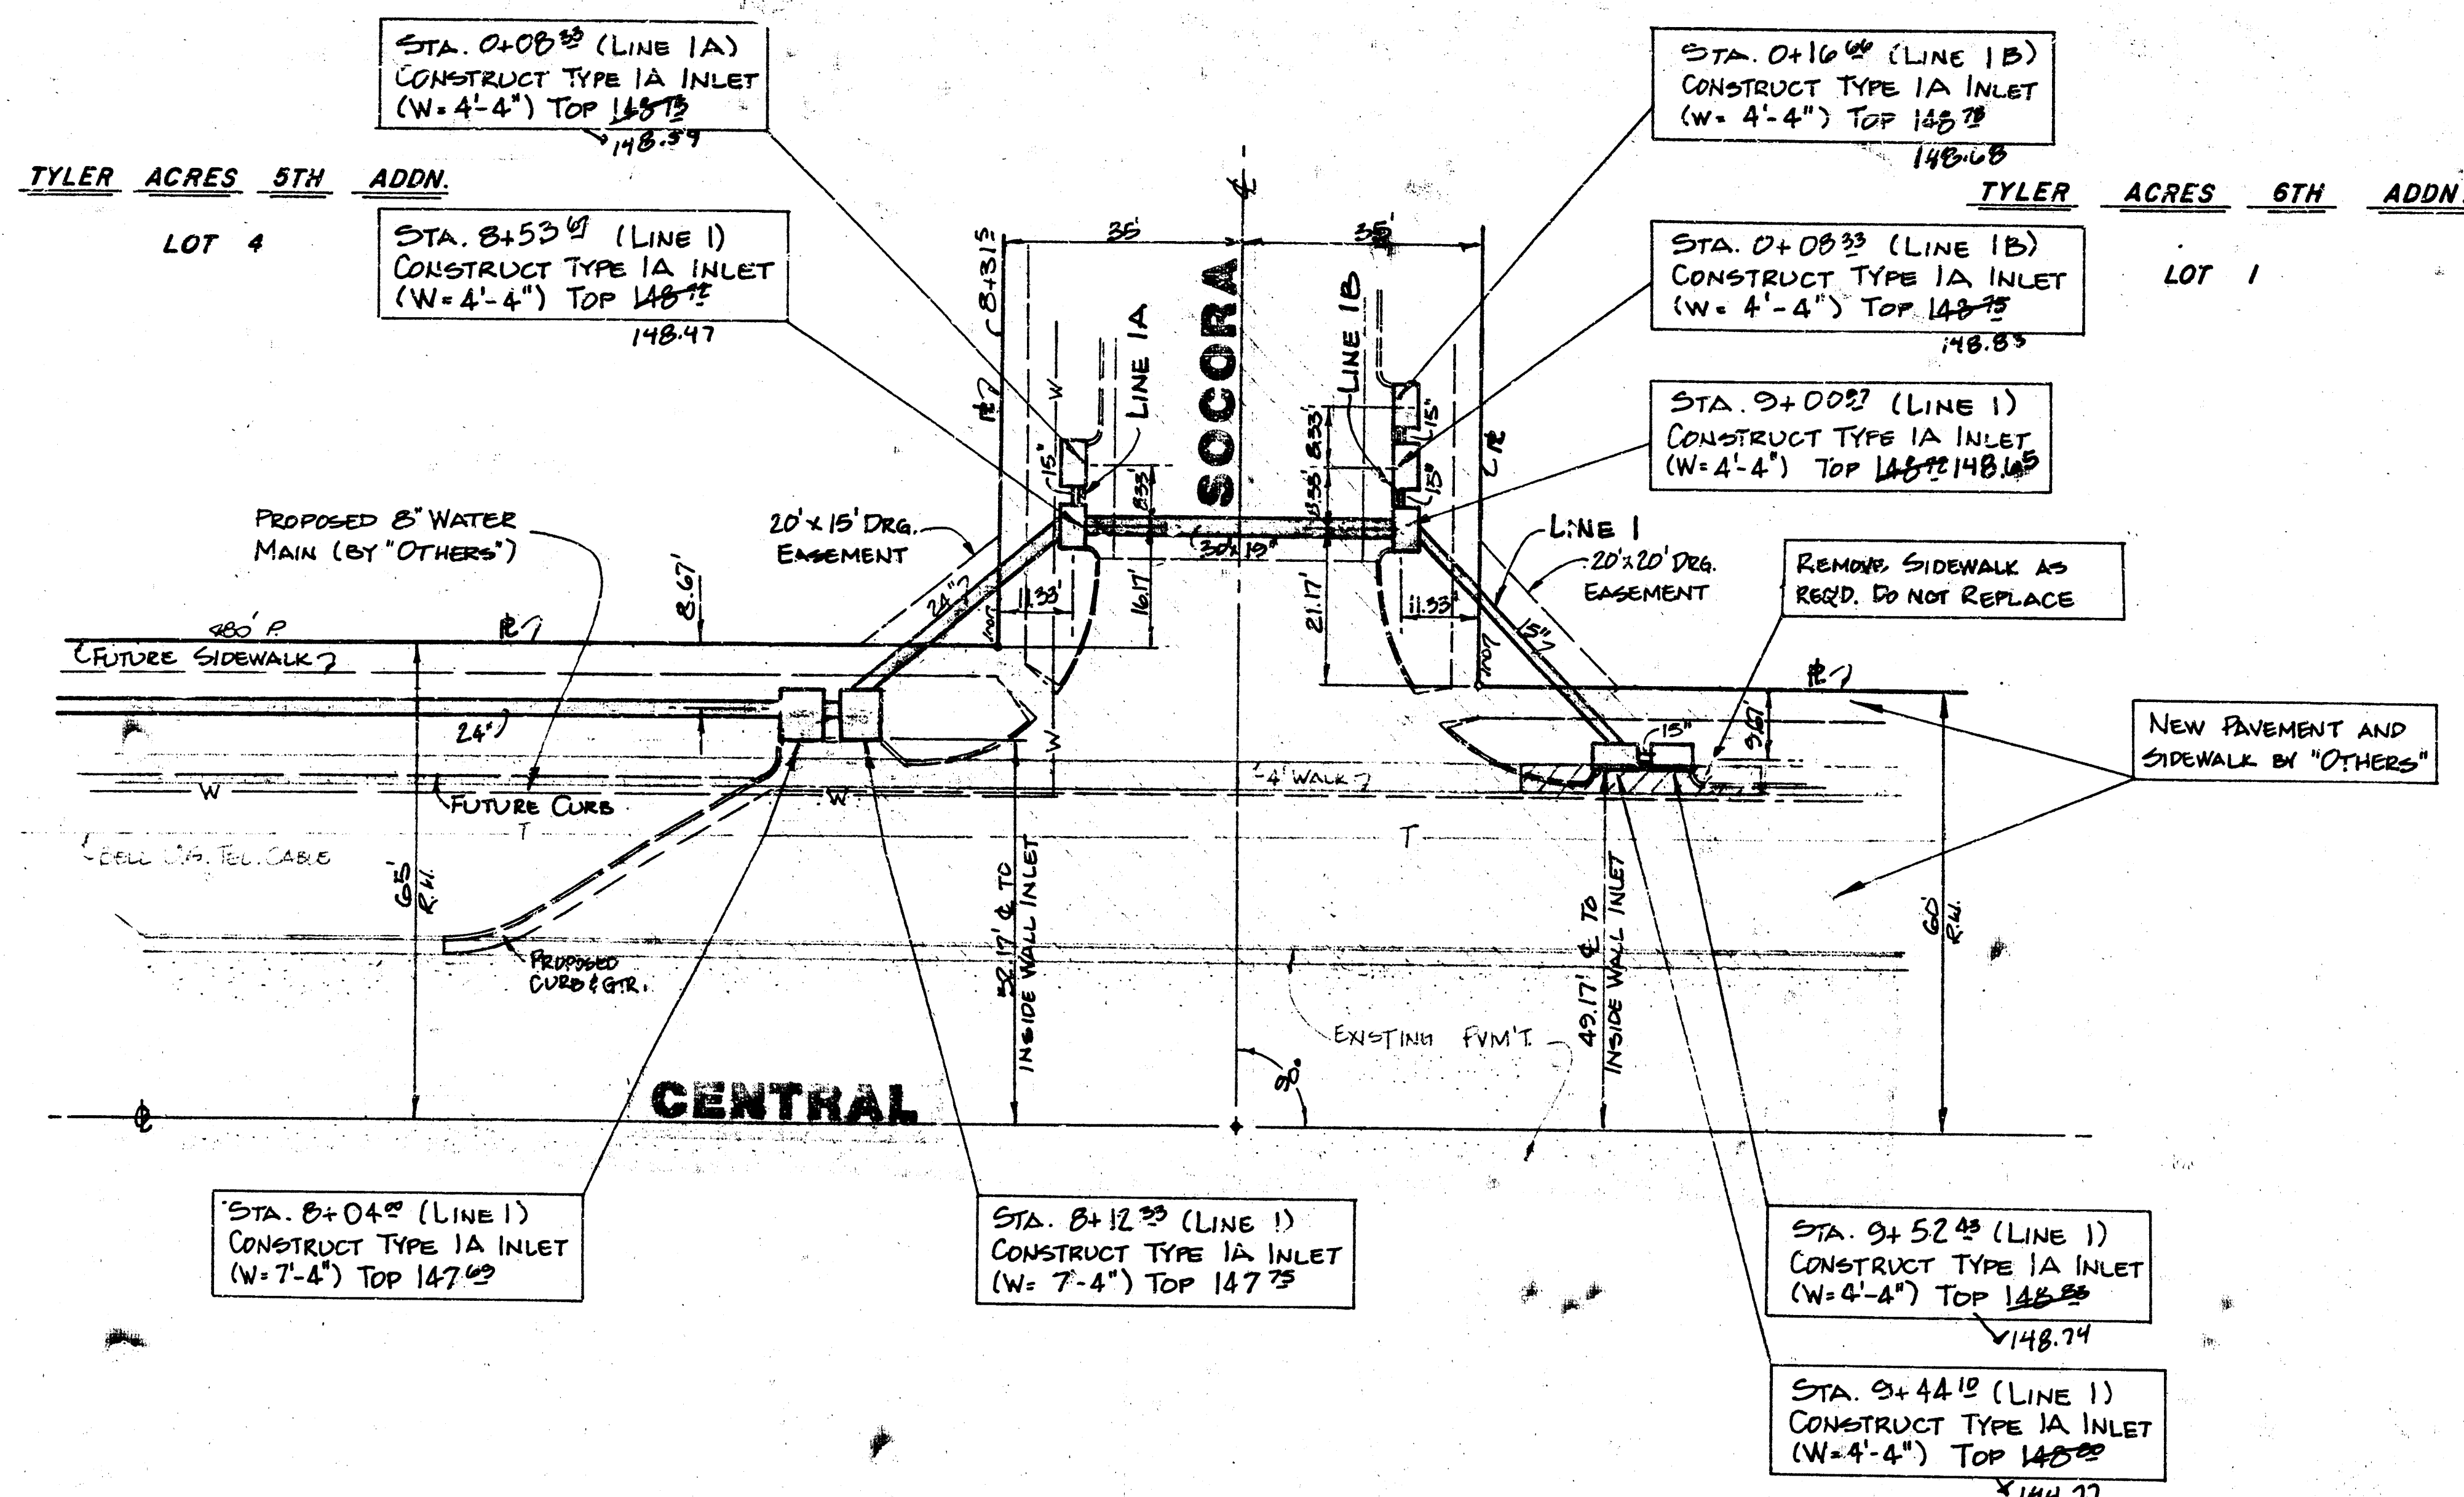


GENERAL NOTES

1. The Contractor shall be responsible for preserving property irons. The Contractor shall be required to re-establish any property irons which are destroyed by his construction operations. Such irons shall be re-established by a licensed land surveyor or a professional engineer, according to state laws.
2. The Contractor shall co-ordinate construction with the water main contractor in order to avoid construction conflicts.
3. The Contractor shall preserve sidewalk along the north side of Central west of Socora during construction. Any such walk damaged or removed shall be replaced at the Contractor's expense. Sidewalk east of Socora may be removed only as required for inlet construction.
4. All inlets in this project along Central shall be backfilled to match existing grade. Inlet openings shall be sealed with brick masonry to prevent entry of dirt or debris.
5. Inlets from Sta. 0+00 to and including Sta. 8+12.33 shall be constructed according to Modified Details, sheet 6. All other inlets in this project shall be constructed according to Standard Details, sheet 5.

AS BUILT PLAN
9/84
MCGEE

PROFILE SCALE
1"=20' HORIZ.
1"=5' VERT.

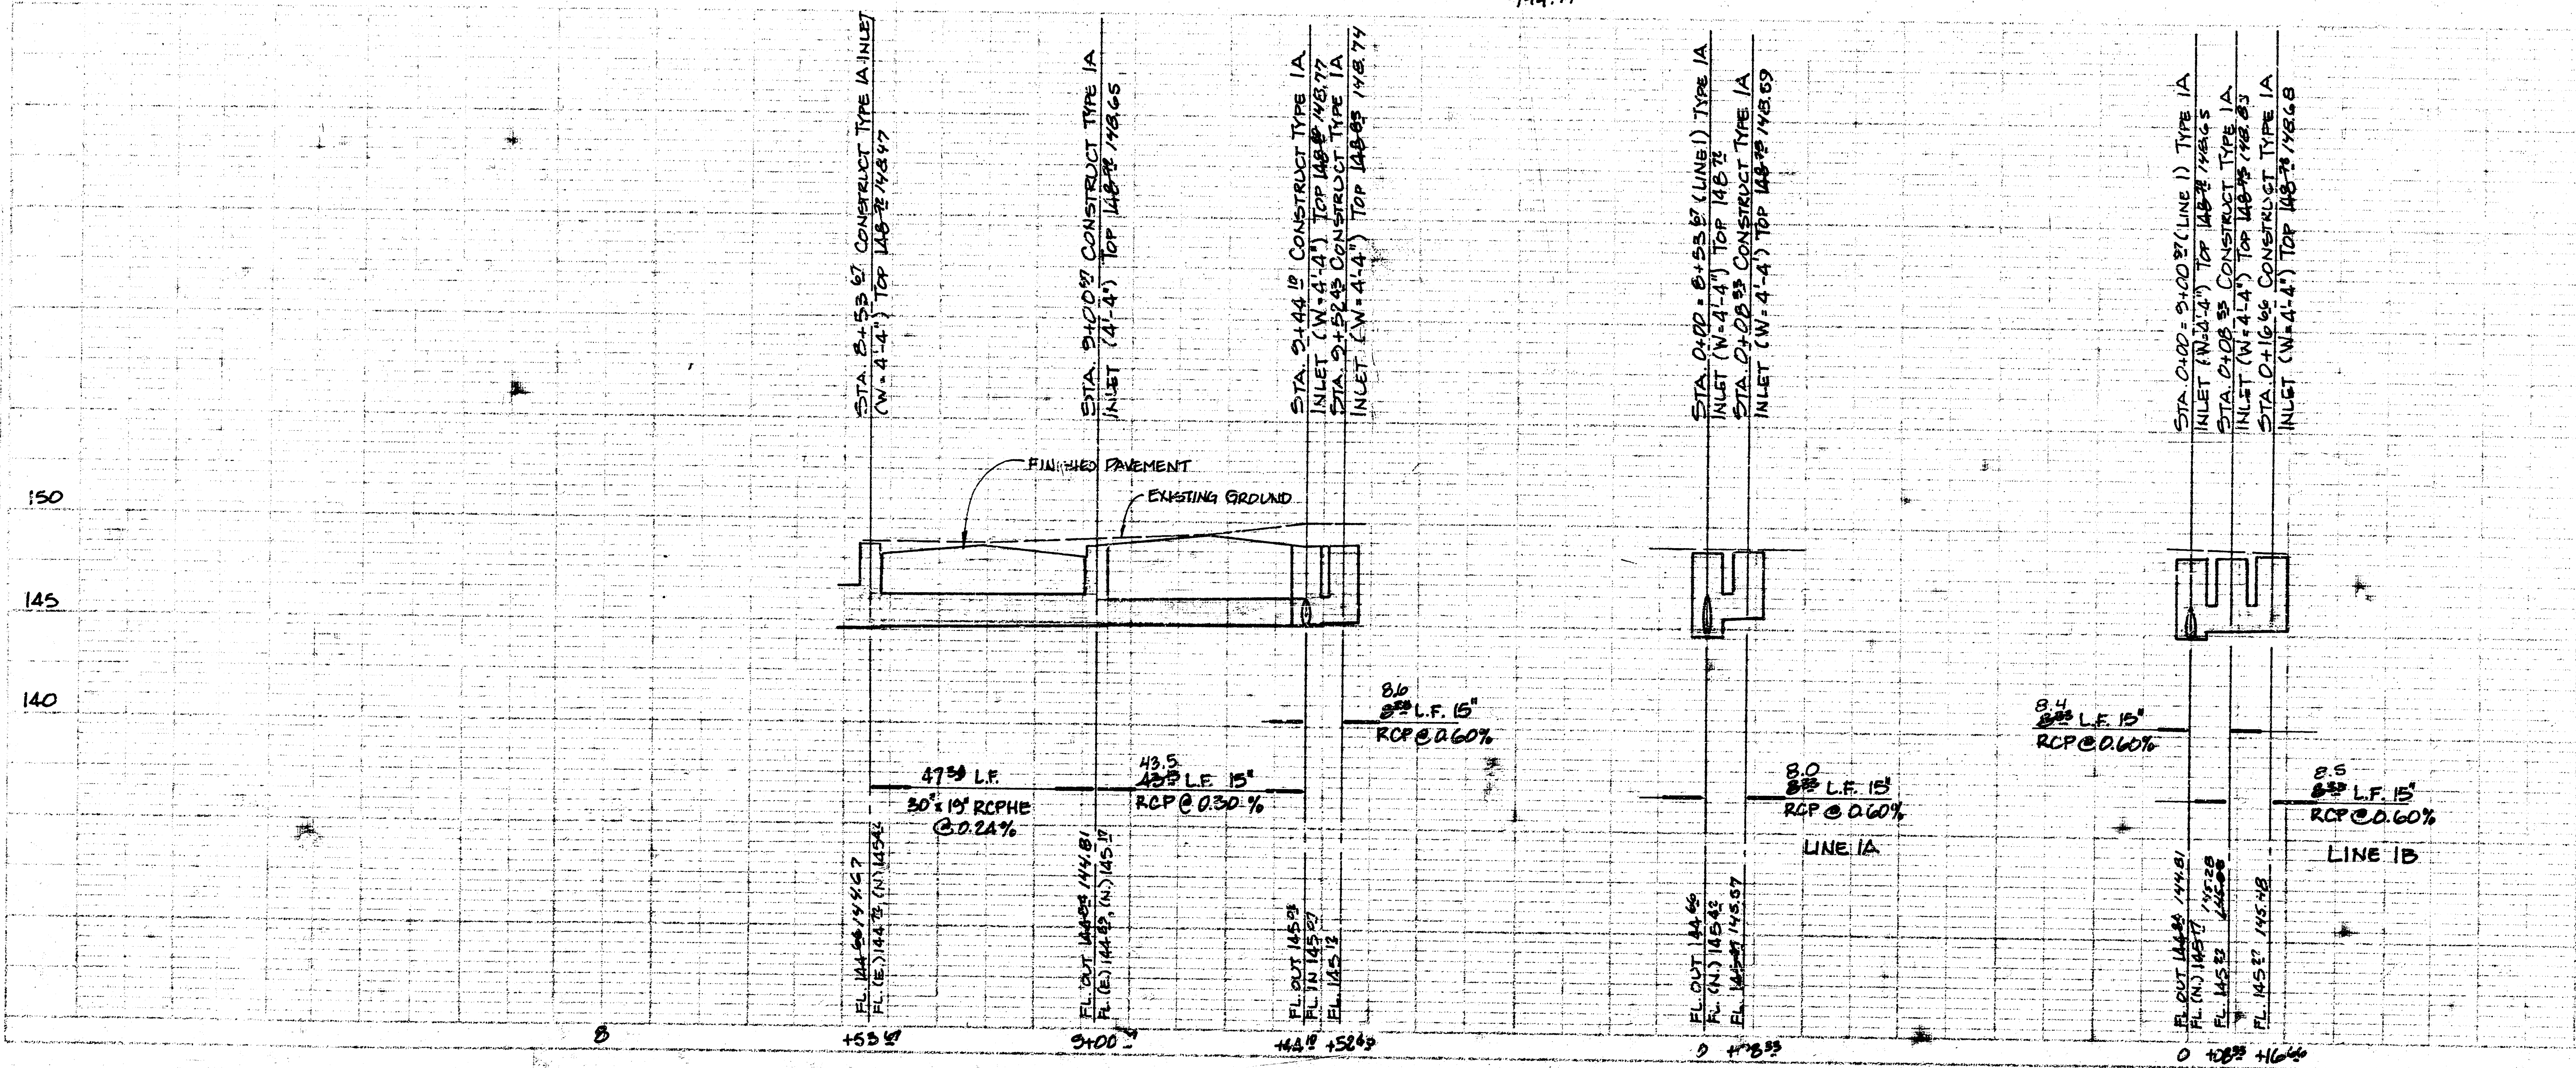

STORM WATER SEWER #252

PLAN and PROFILE



Project no. 488-76-245-81276-000-000-001

BAUGHMAN COMPANY, P.A.


SURVEYING & ENGINEERING

314/262-7271 • 350 LAURA • WICHITA, KANSAS 67211

Project no. 468-78-242-81576-000-001

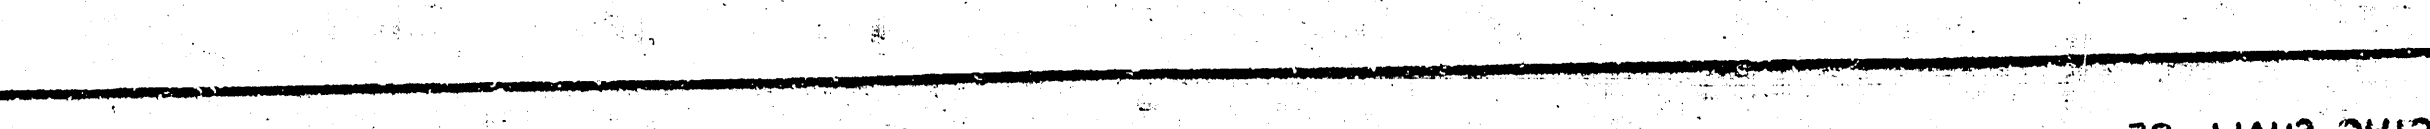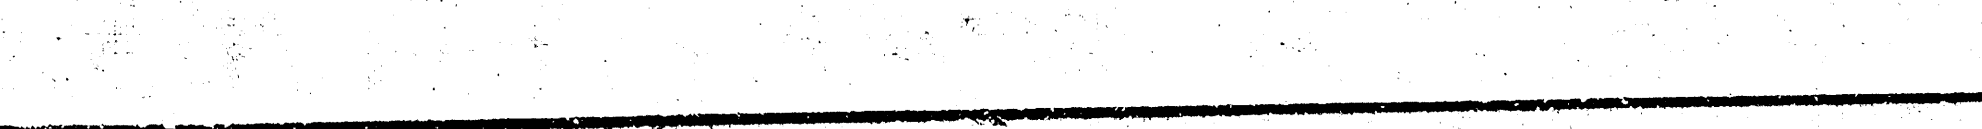

W	PRE-CAST TOP SIZE	PIPE SIZE	CASTING CONC
STANDARD CURB INLET PRECAST TOPS			

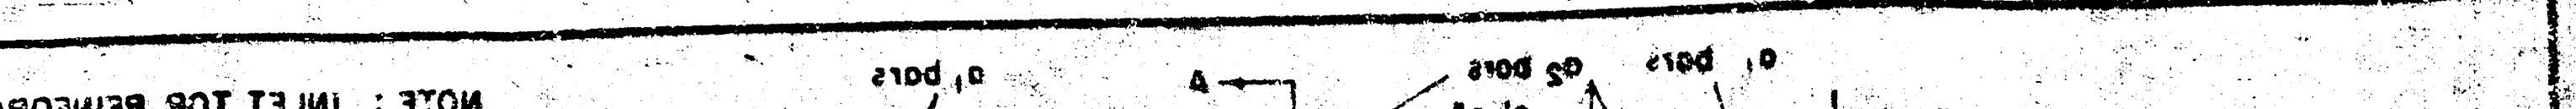

TW	281	282	283	1000
----	-----	-----	------

