

STORM SEWER PLANS FOR

S.W.S. NO. 318

GOLF PARK WEST

PROJECT NO.

468-76-245-81612-000-000-001



INDEX TO DRAWINGS

SHEET NO.	DESCRIPTION
1	Title Sheet
2	Plan and Profile

CITY OF WICHITA
MICHAEL E. LINDEBAK, CITY ENGINEER
MARCH, 1988


GENERAL NOTES




THE CONTRACTOR SHALL BE RESPONSIBLE FOR PRESERVING PROPERTY IRONS.
THE CONTRACTOR SHALL BE REQUIRED TO RE-ESTABLISH ANY PROPERTY IRONS
WHICH ARE DAMAGED OR DESTROYED BY HIS CONSTRUCTION OPERATIONS. SUCH
IRONS SHALL BE RE-ESTABLISHED BY A LICENSED LAND SURVEYOR OR A
LICENSED PROFESSIONAL ENGINEER IN ACCORDANCE WITH STATE LAWS.

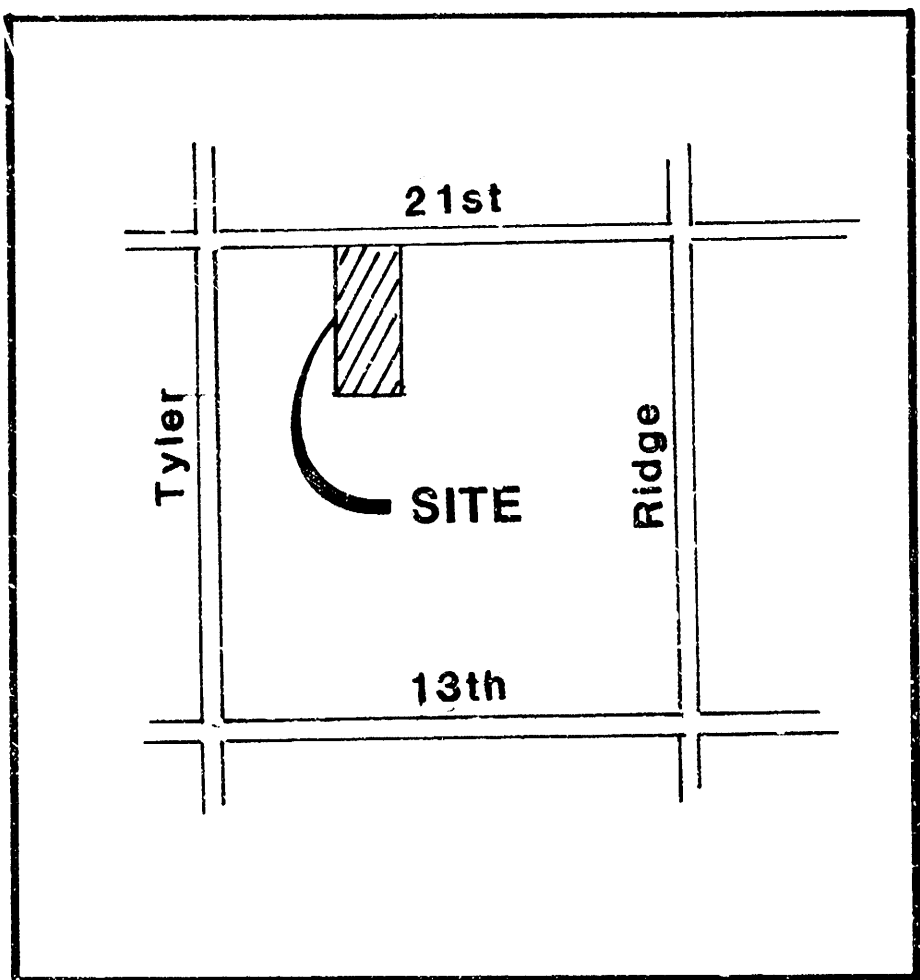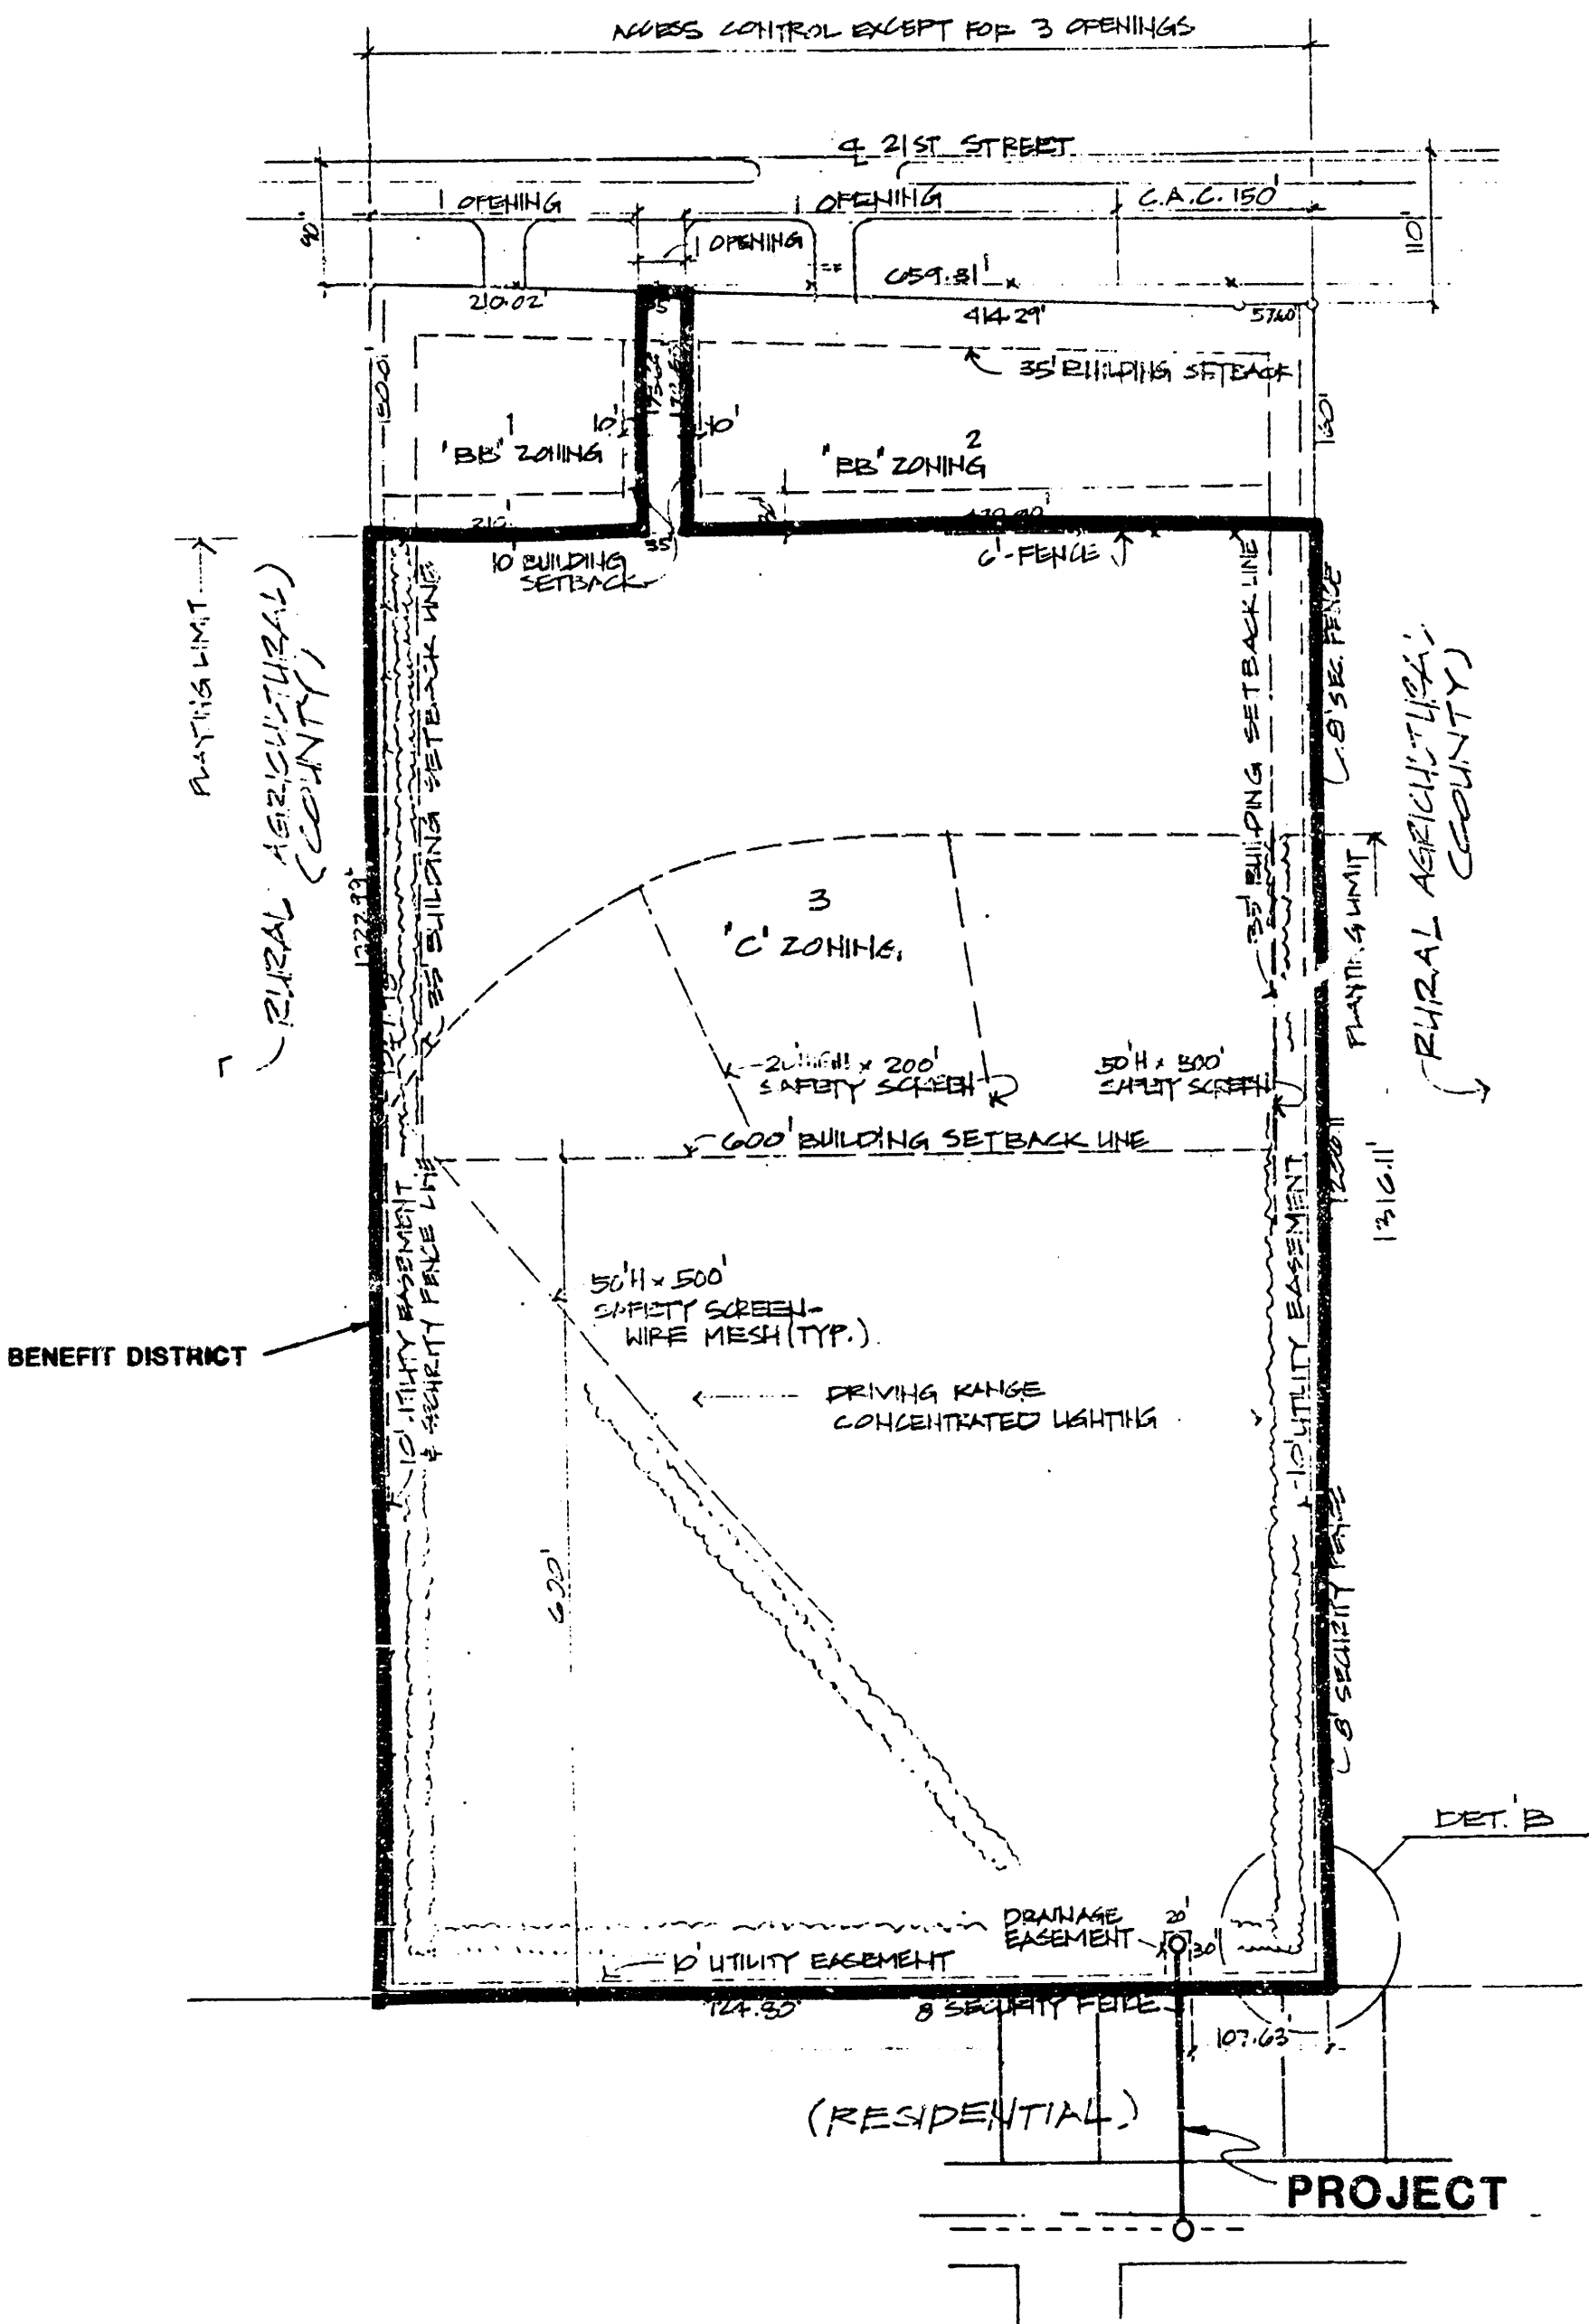

LOCATION MAP

BOOKED: FURNISHED
AS BUILT
6/88
MCC
D-101

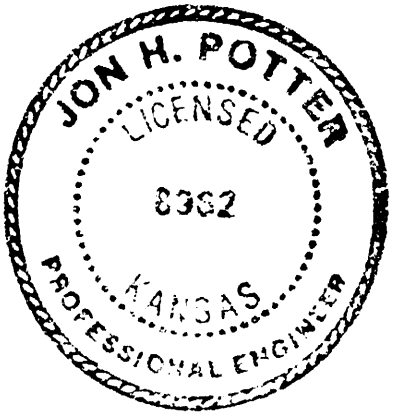

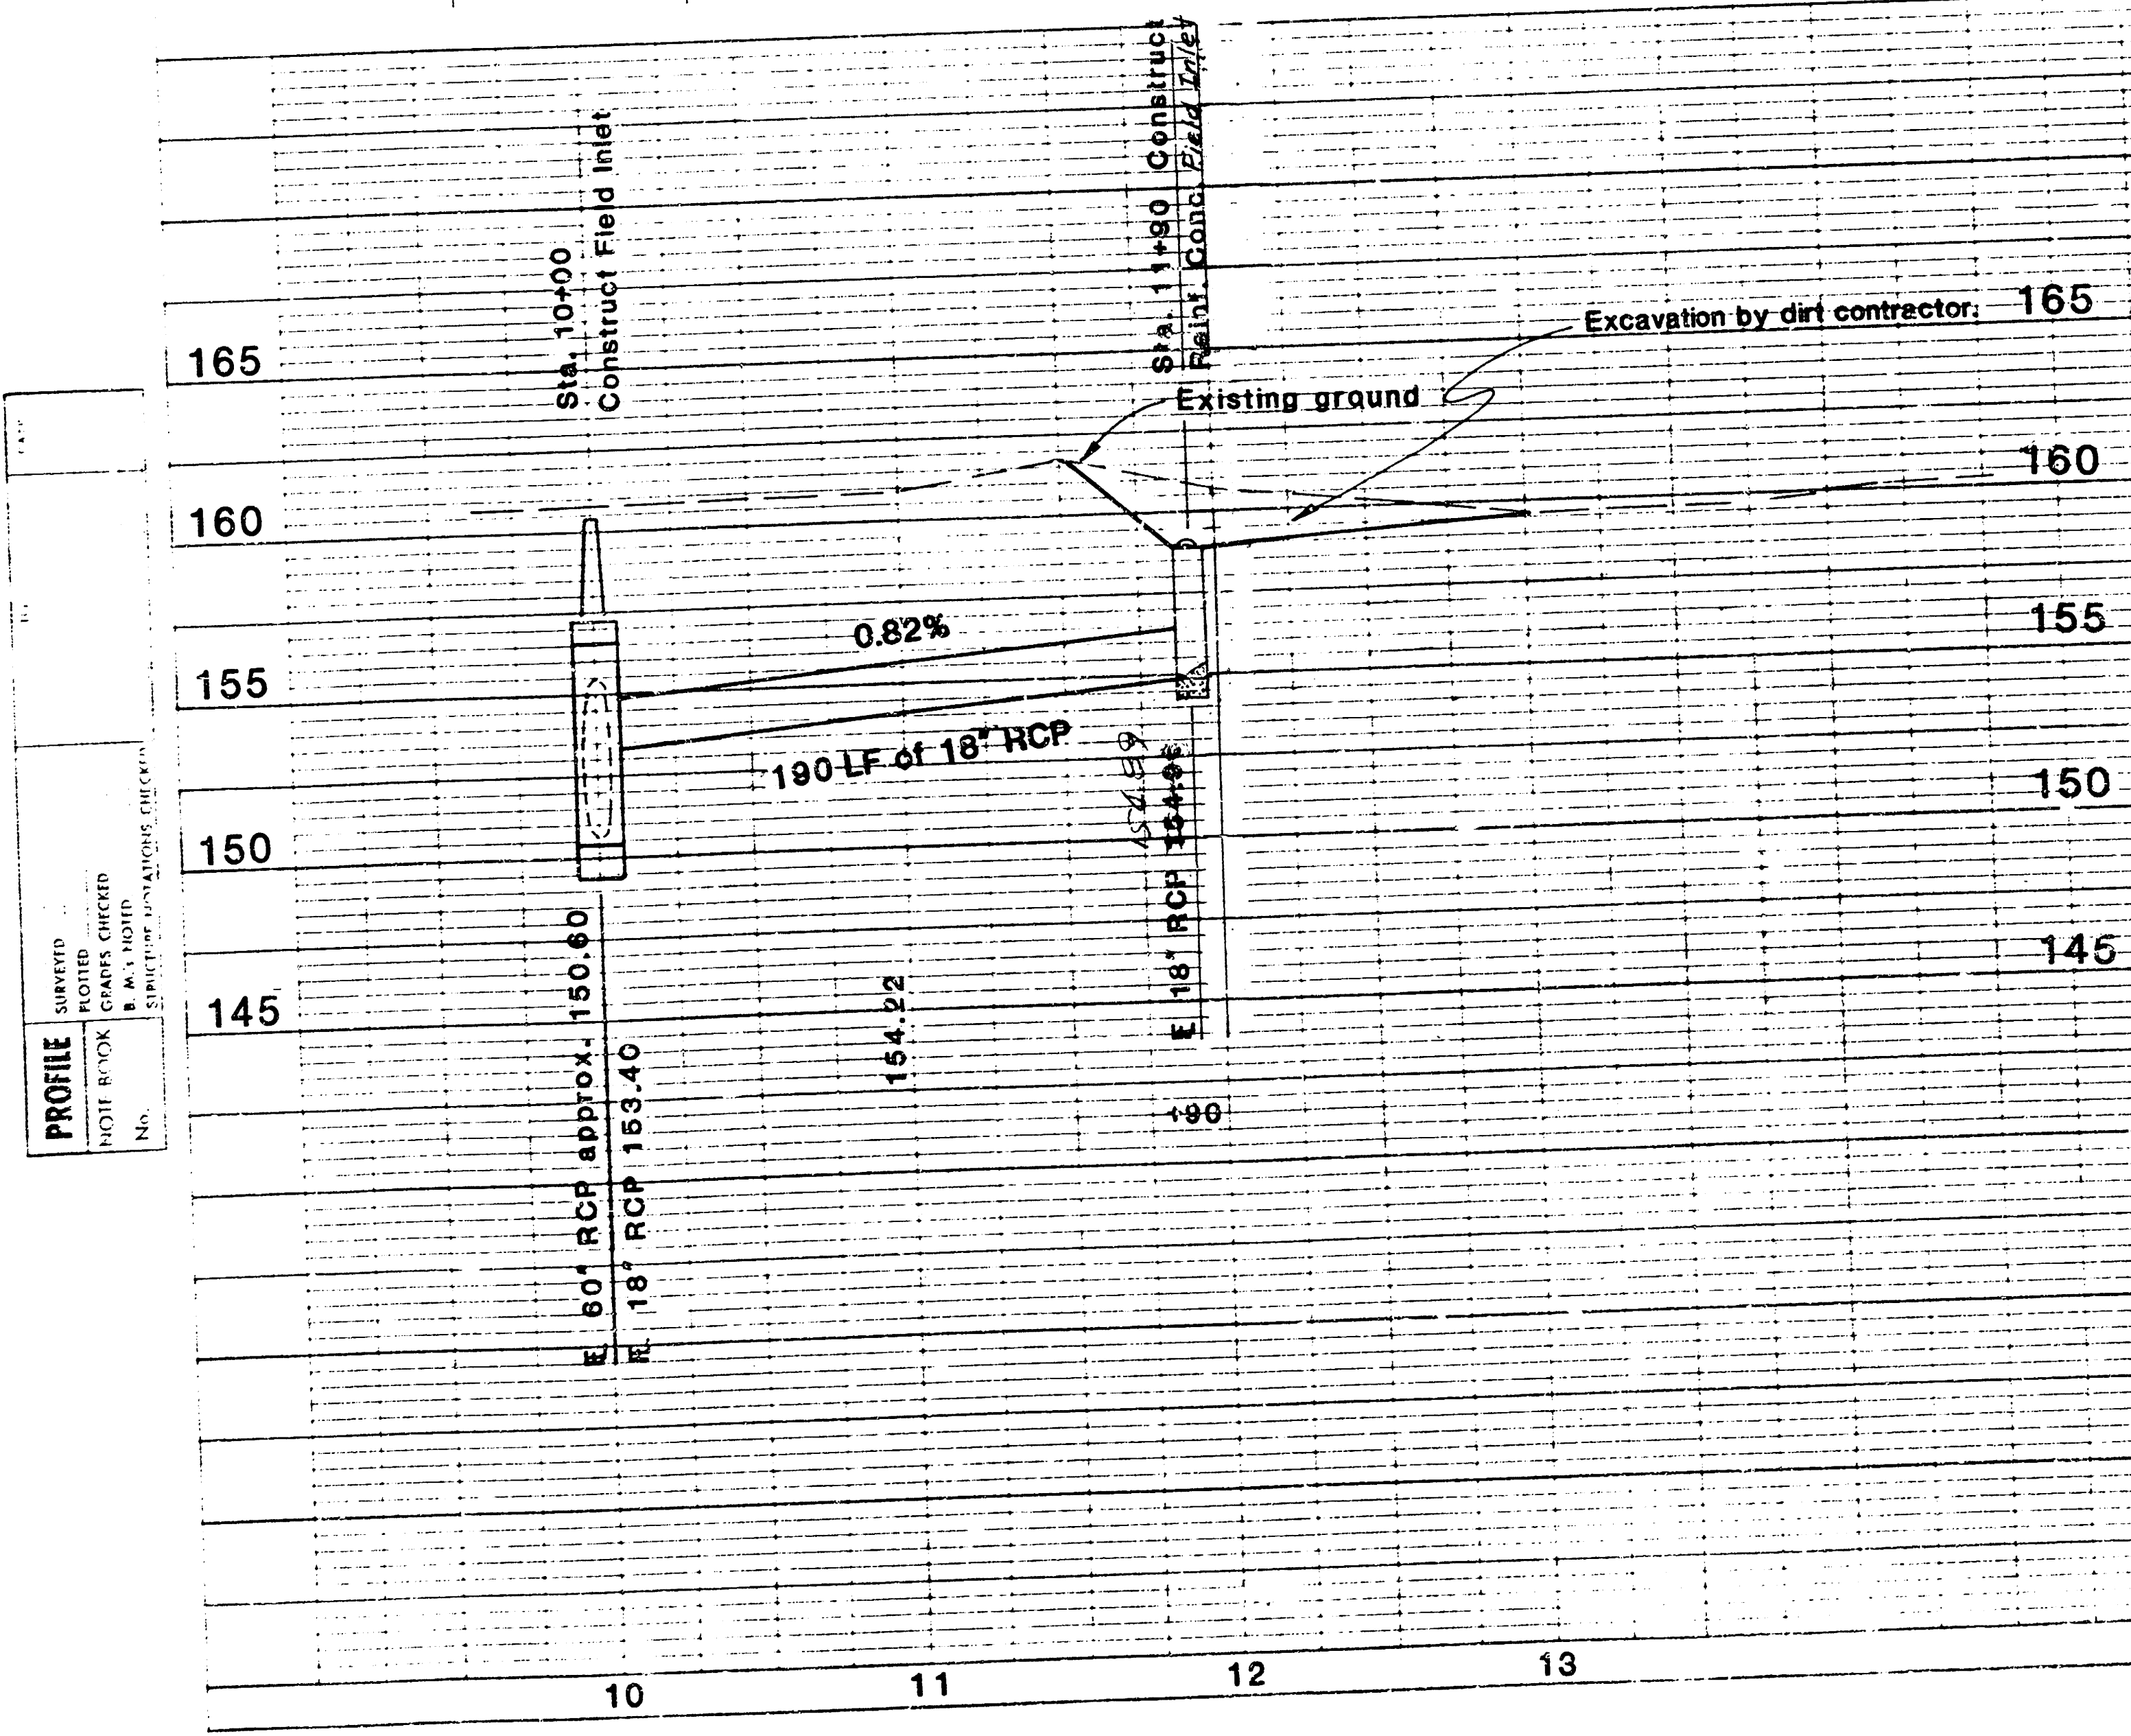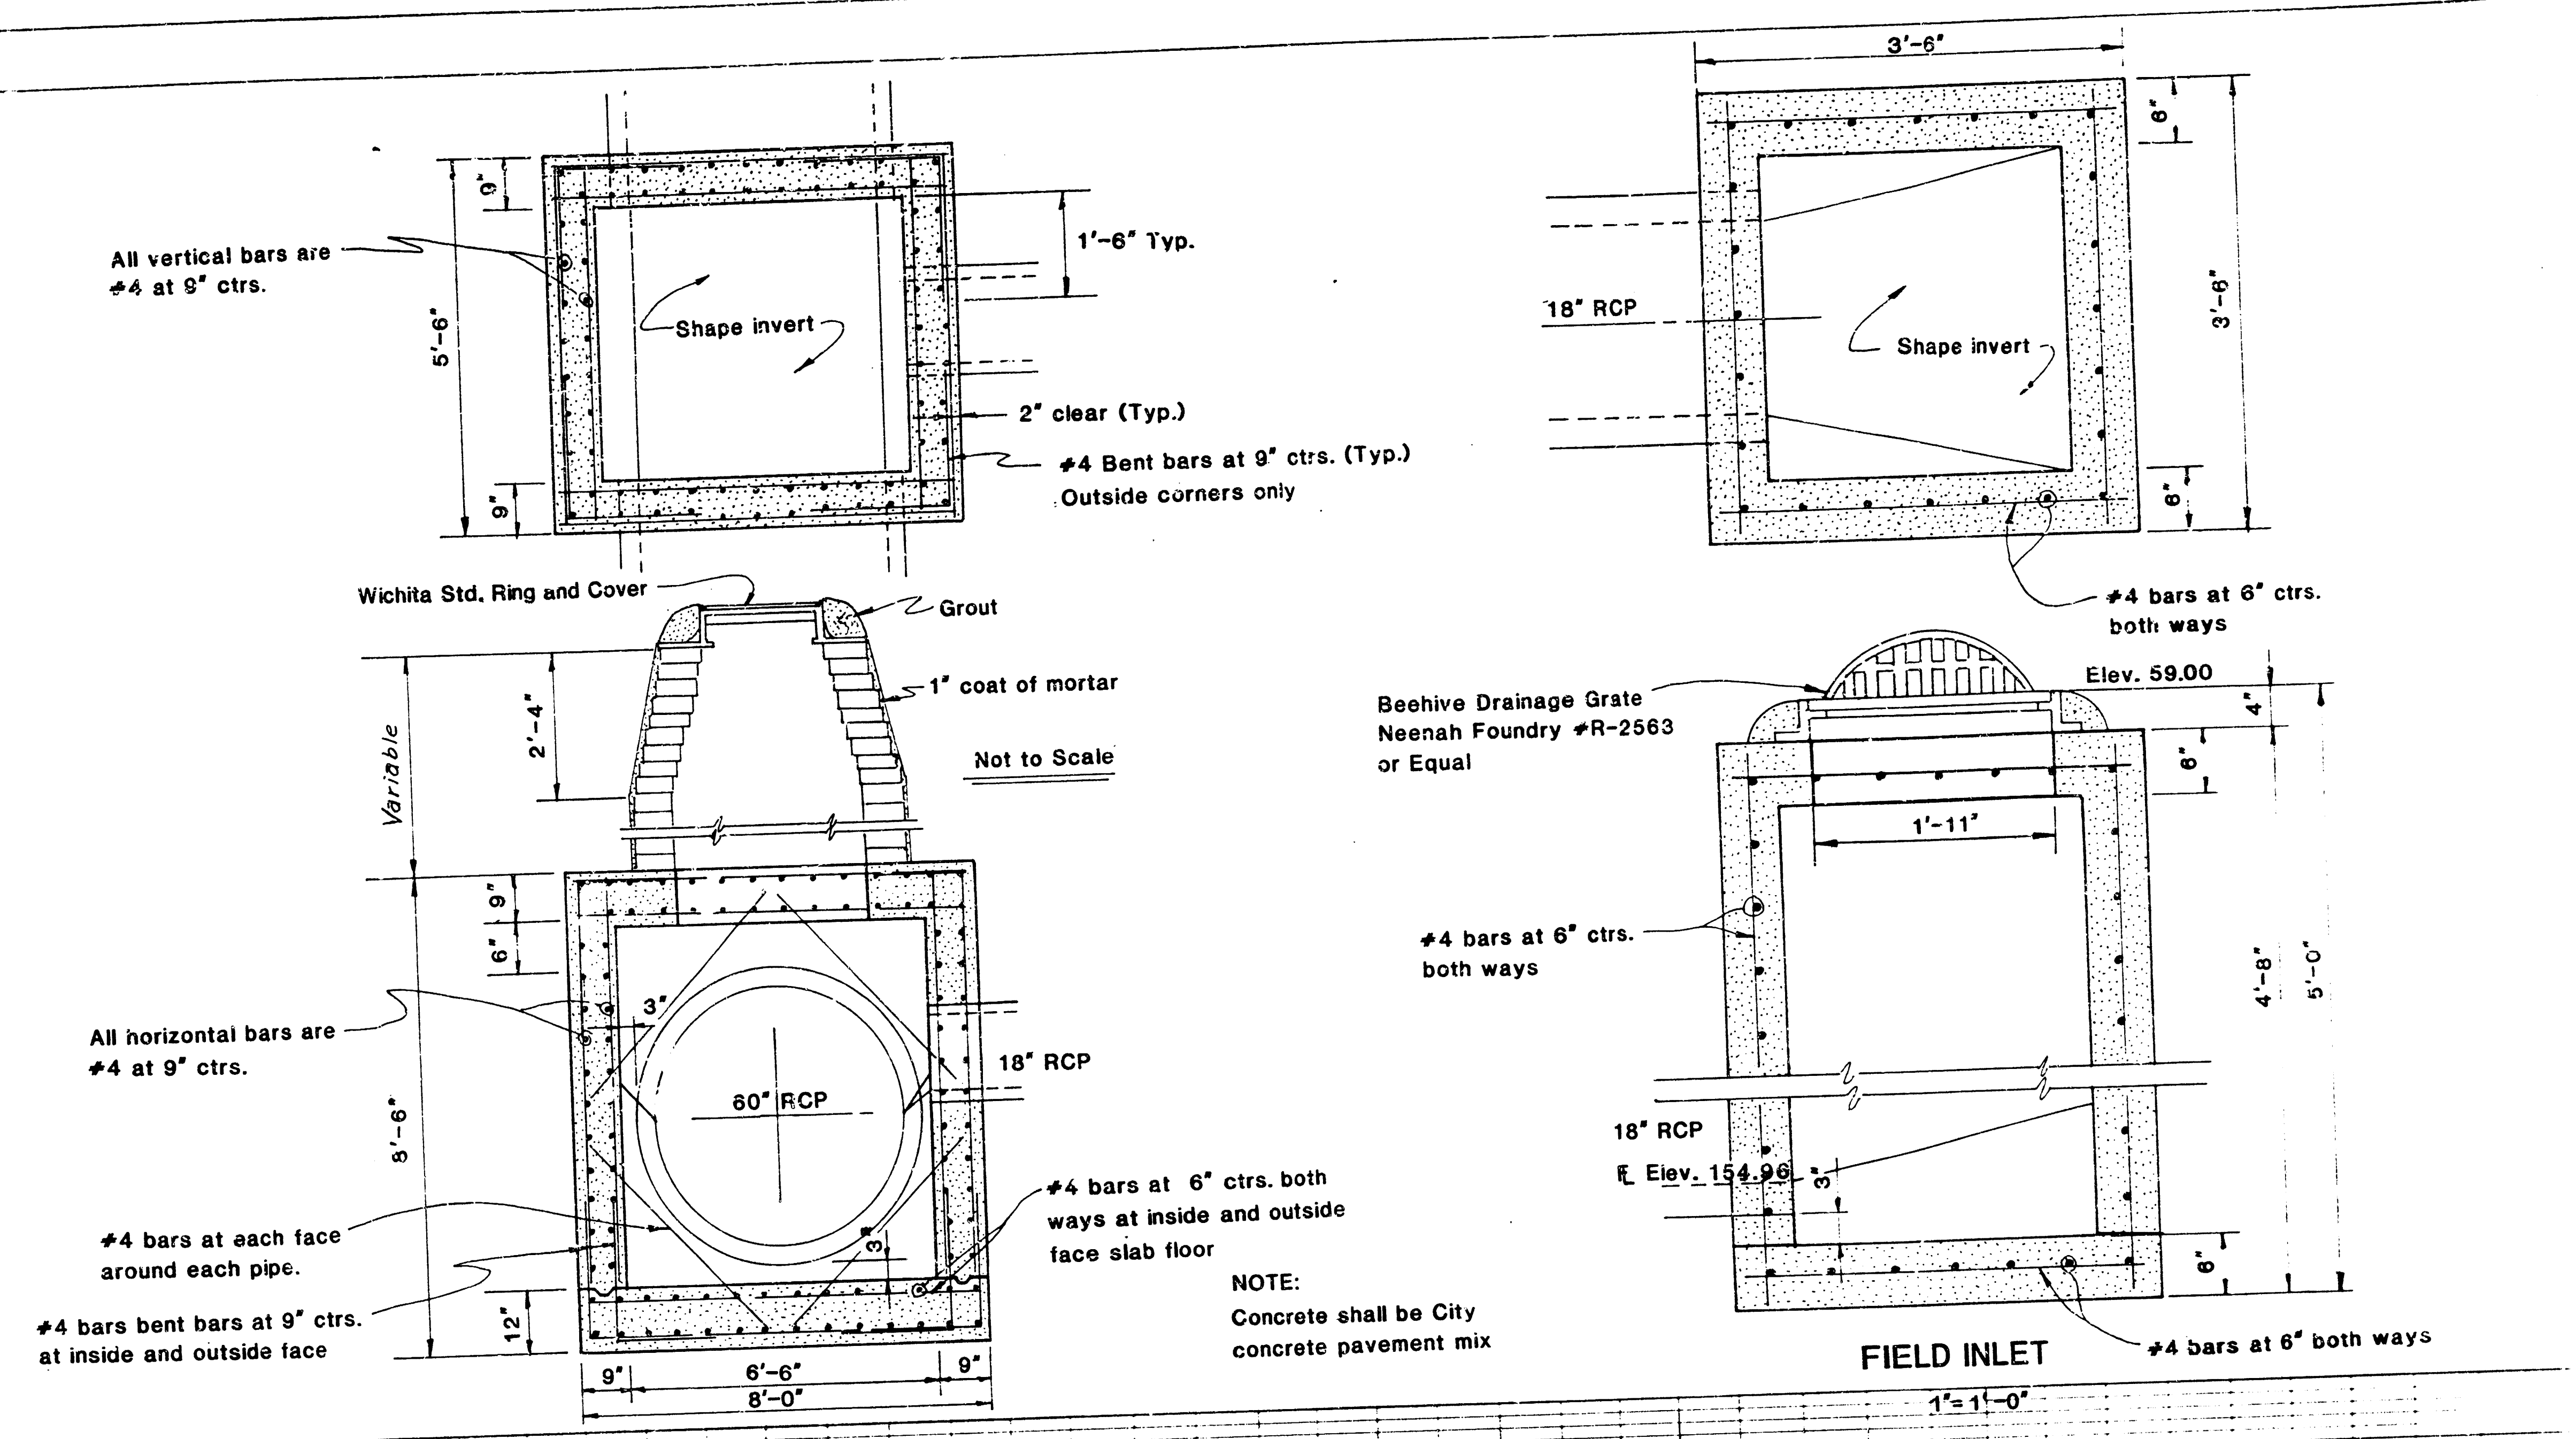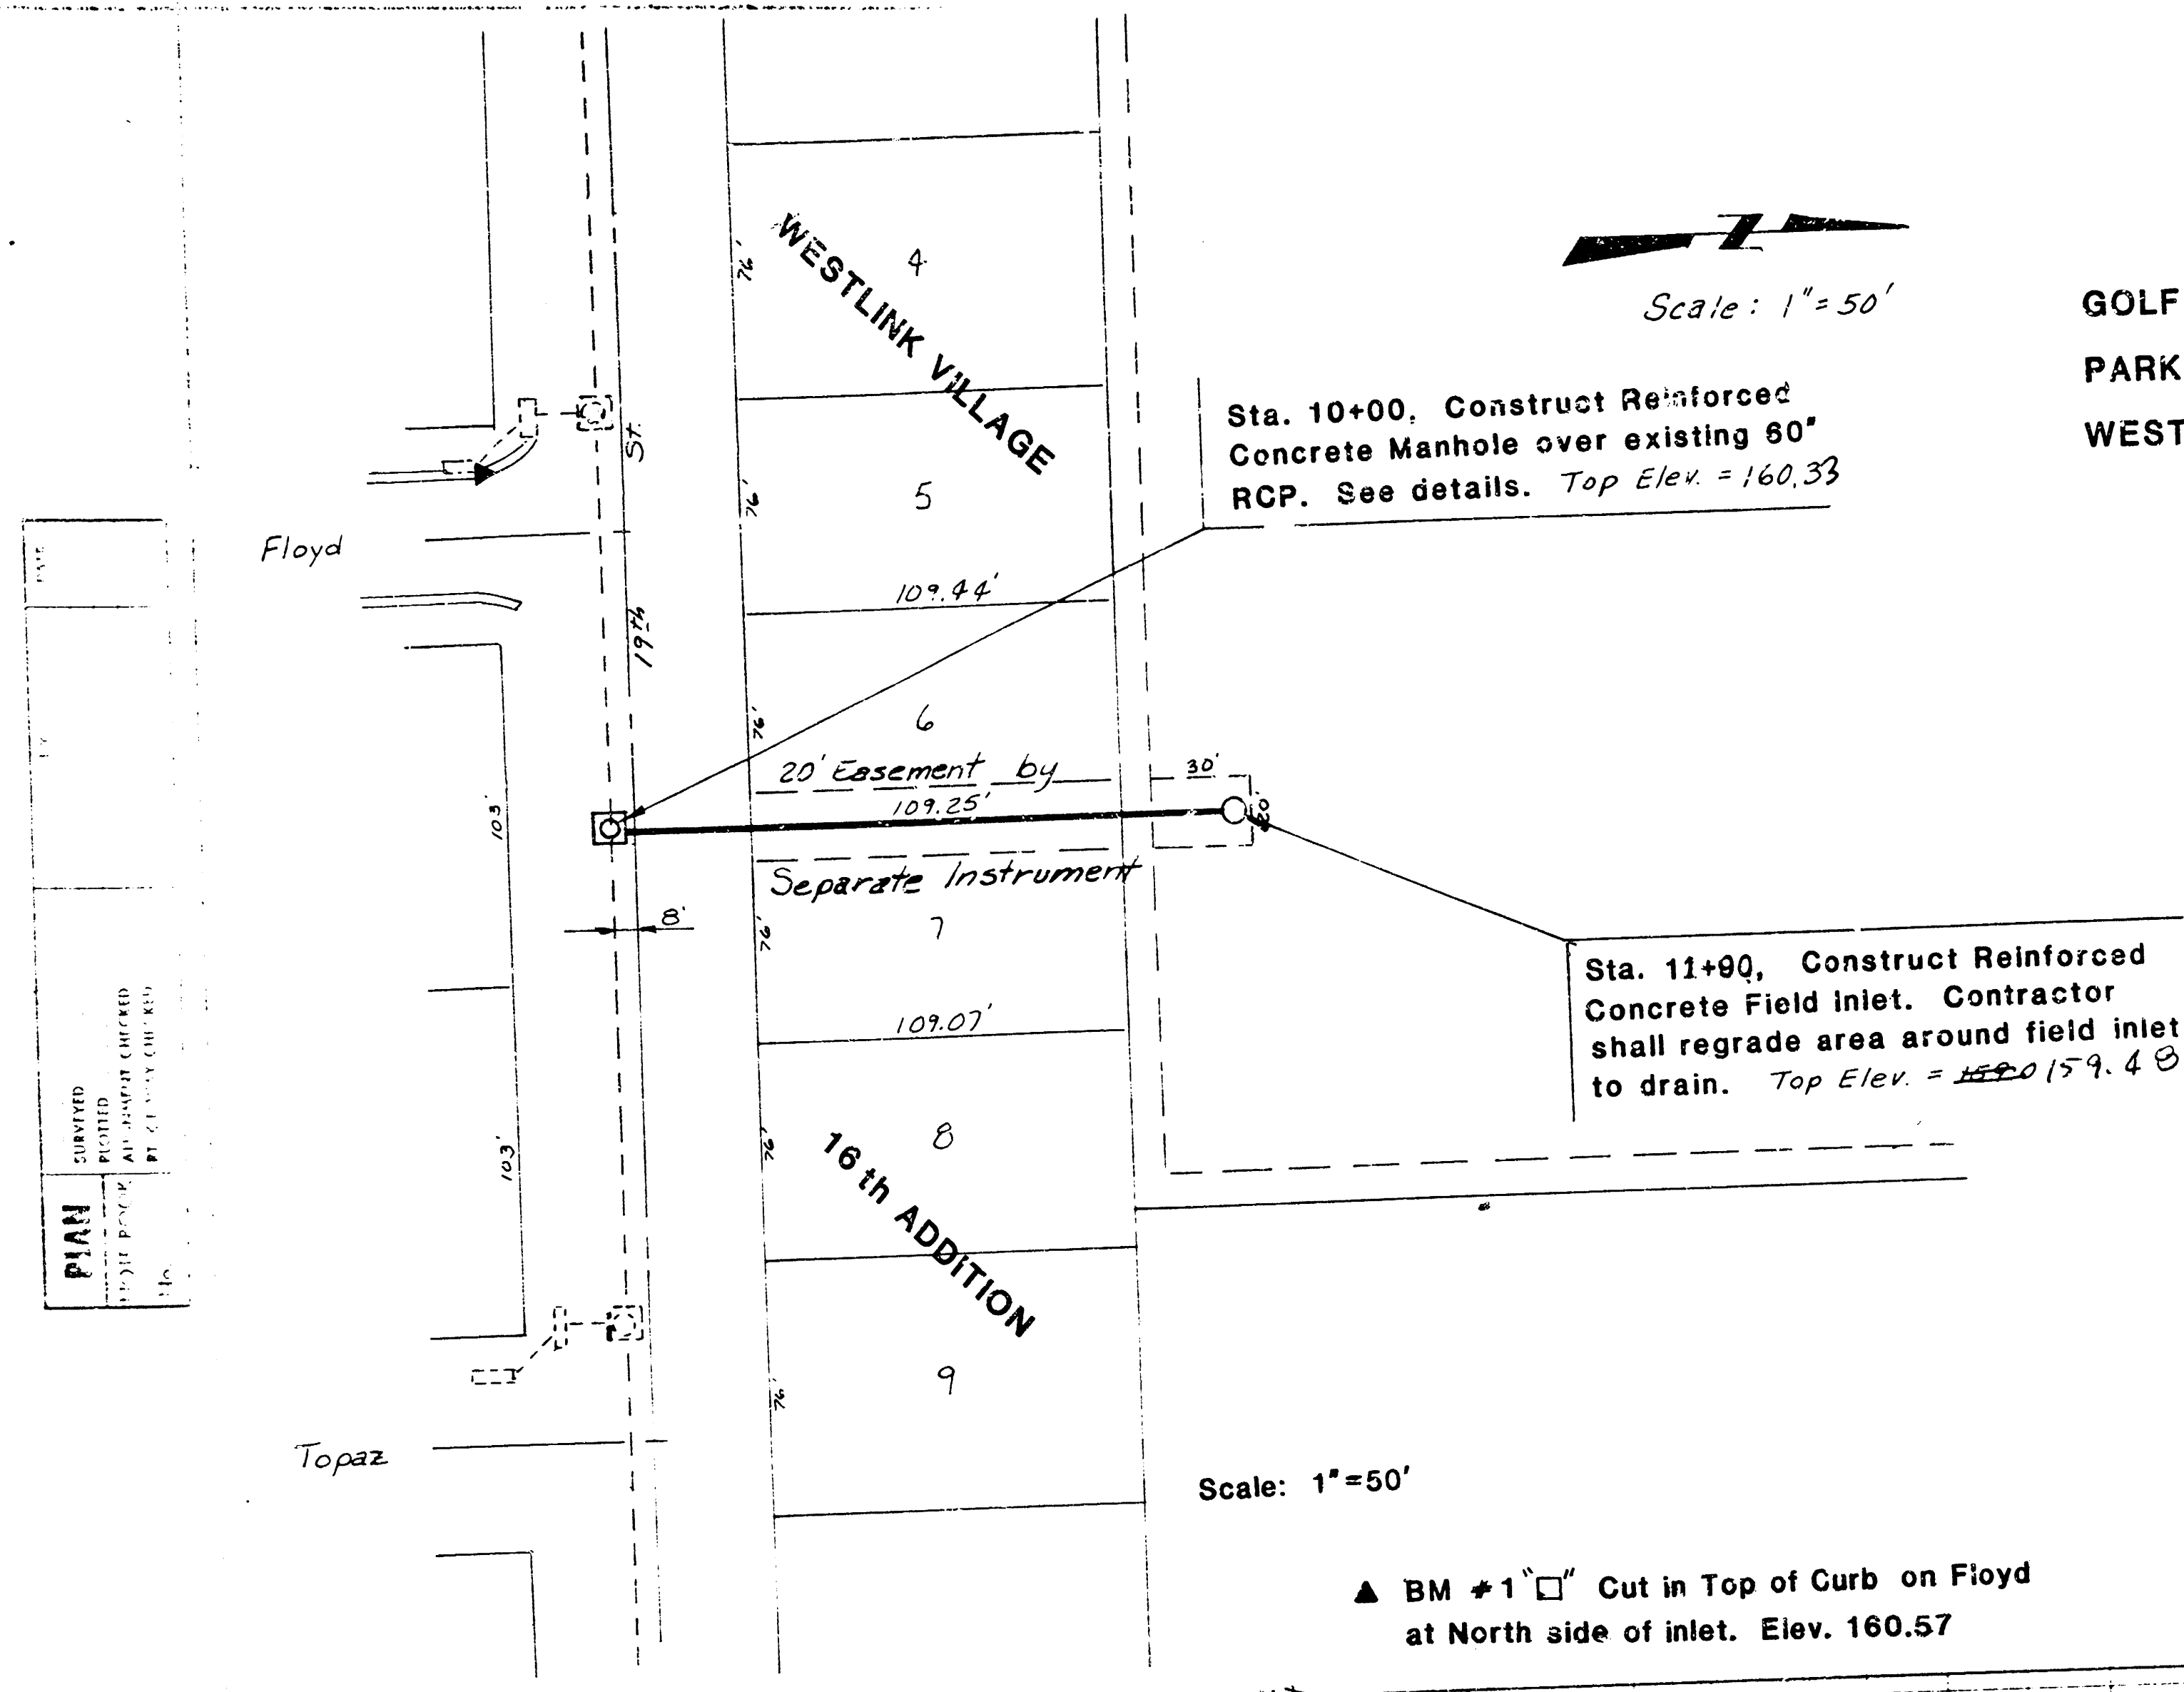

City of Wichita
Storm Water Sewer 318
Project No. 468-76-245-81612-000-001

Jon H. Potter PE
118 Westview Rd. Wichita Ks. 67230

GOLF PARK WEST
18" RCP STORM SEWER

SHEET 2 of 2

FILMED FROM THE BEST AVAILABLE COPY