




Surveyed by JAK 33
Plan of URENA
Checked by JAK 33

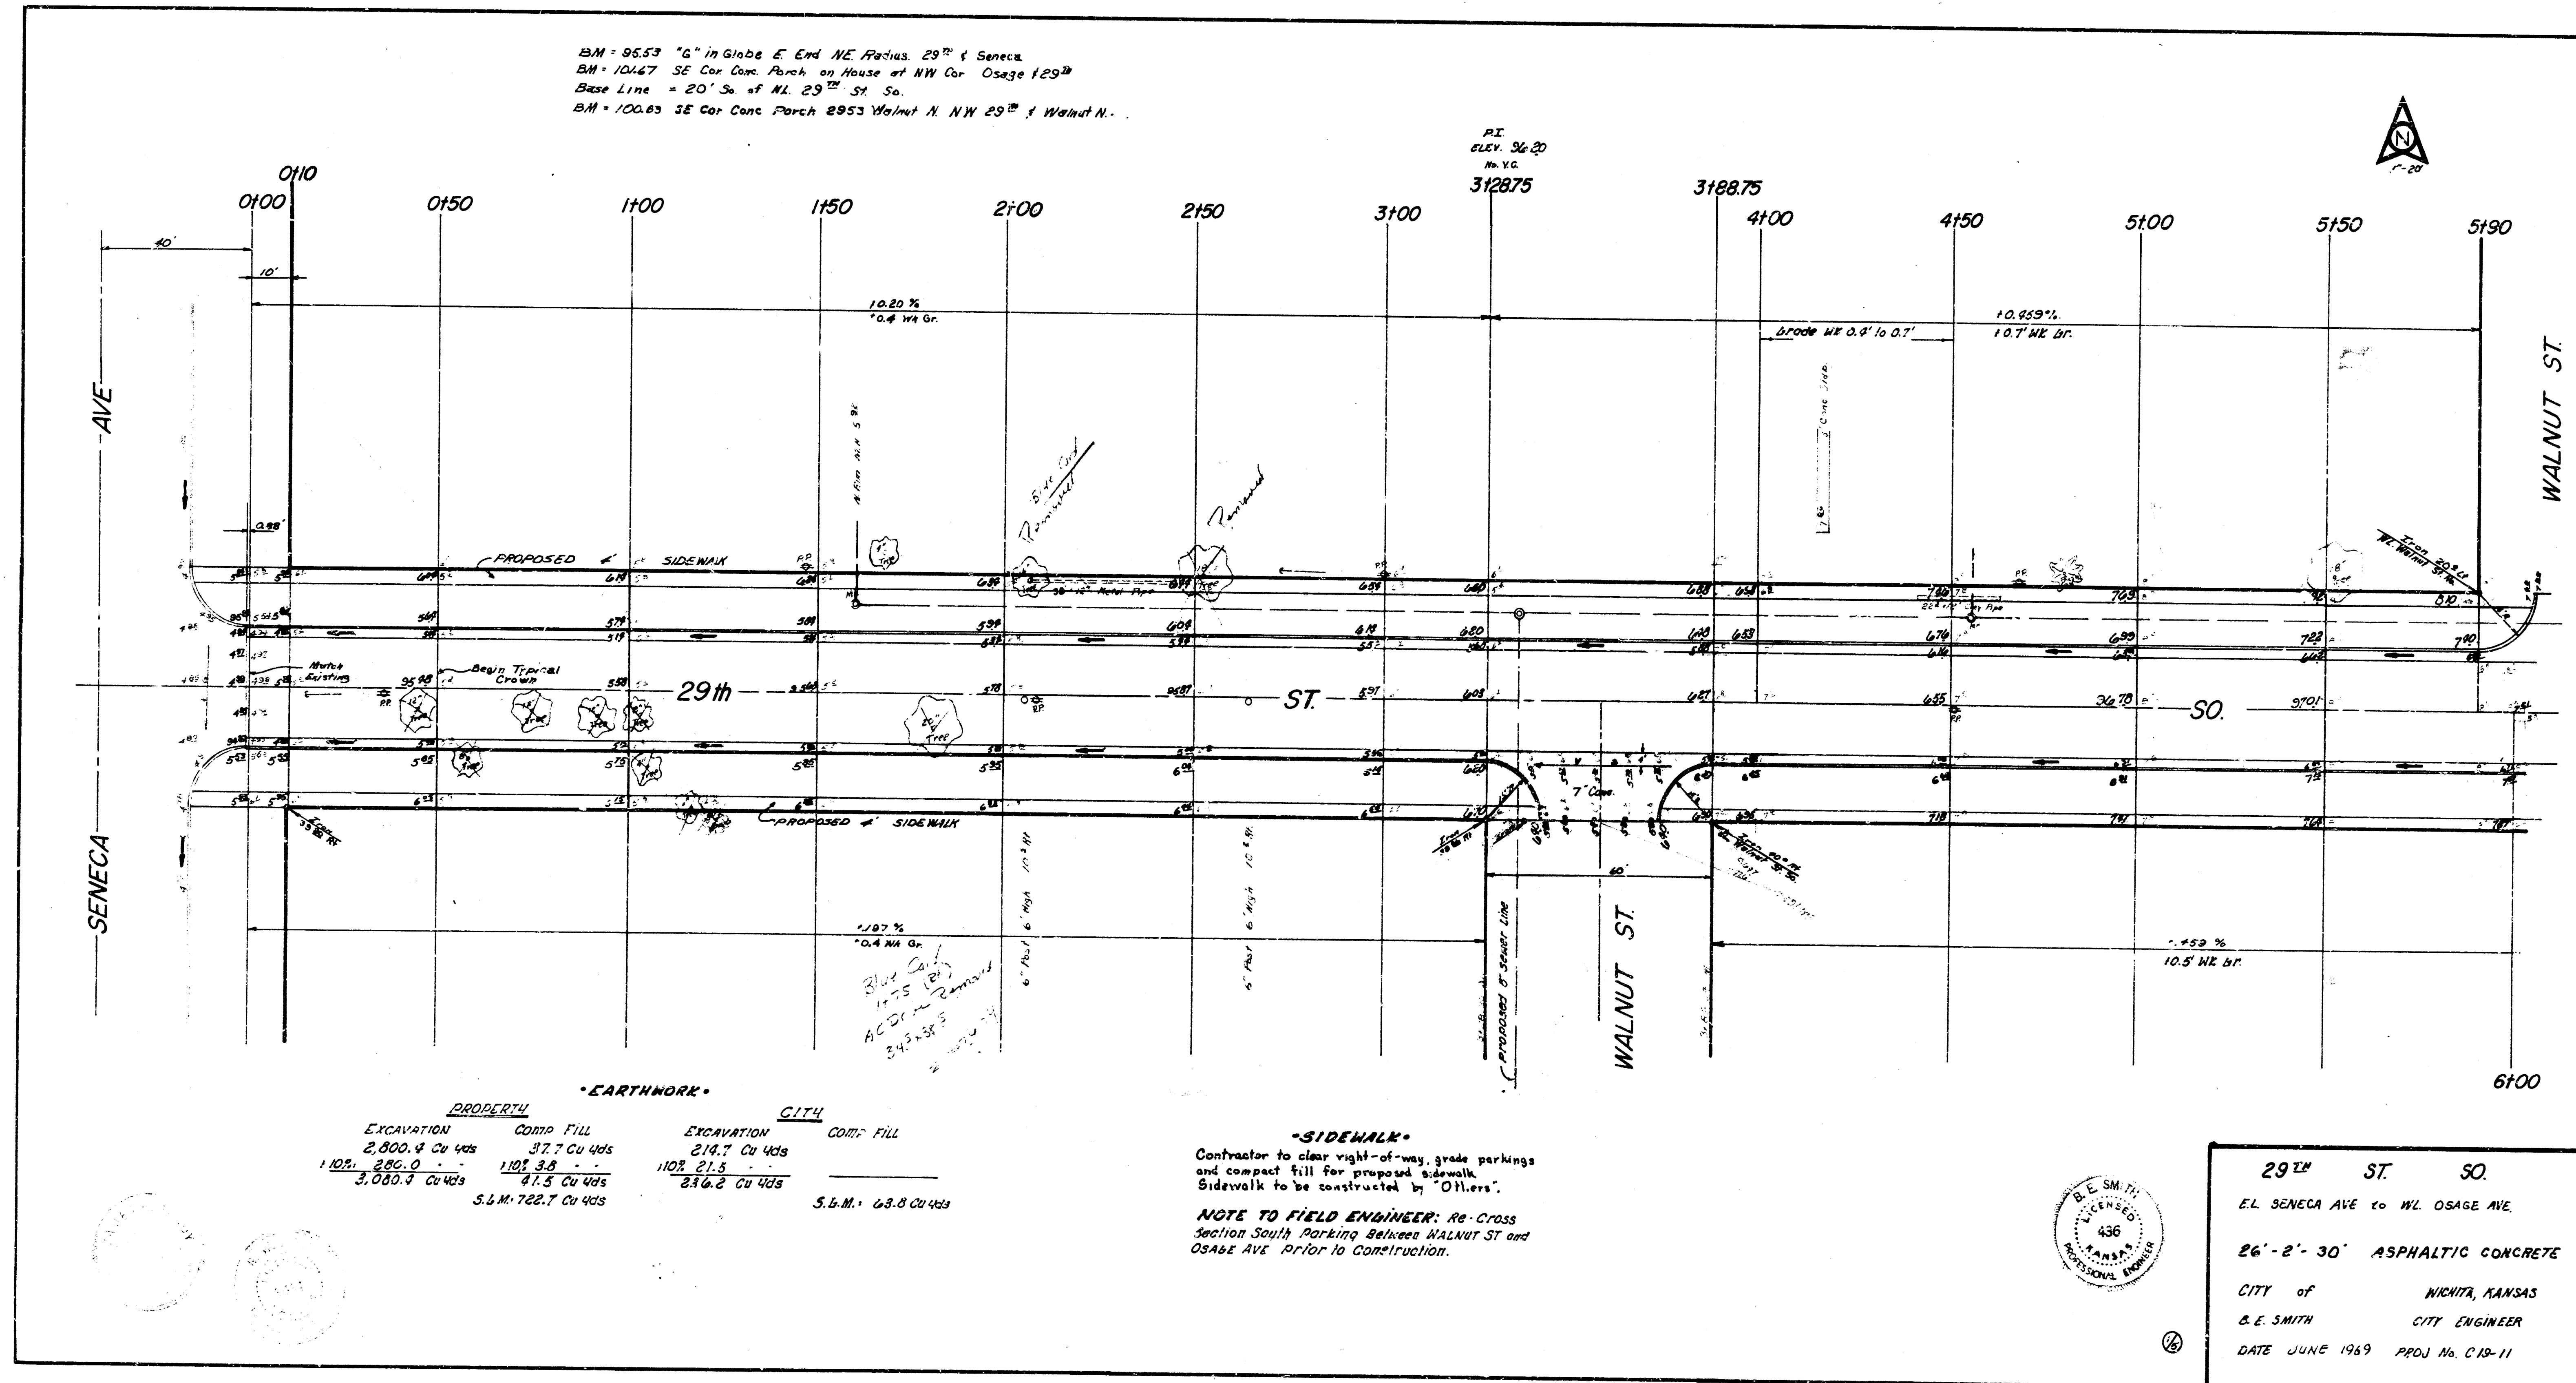