


CONSTRUCTION PLANS FOR WATERLINE IMPROVEMENTS FOR HAYSVILLE EMERGENCY WATERLINE THE CITY OF HAYSVILLE PEC PROJECT NO. 34-95676-1263

PUBLIC OFFICIALS

MAYOR
CITY COUNCIL
CITY CLERK

TOM LINDSAY
SANDRA BRADSHAW
DOROTHY BOOHER
MICHAEL MORRISON, SR.
BRUCE ARMSTRONG
PHIL HARRIS
WENDELL CORBETT
LARRY EMERSON
TIM NORTON
CAROL McBEATH

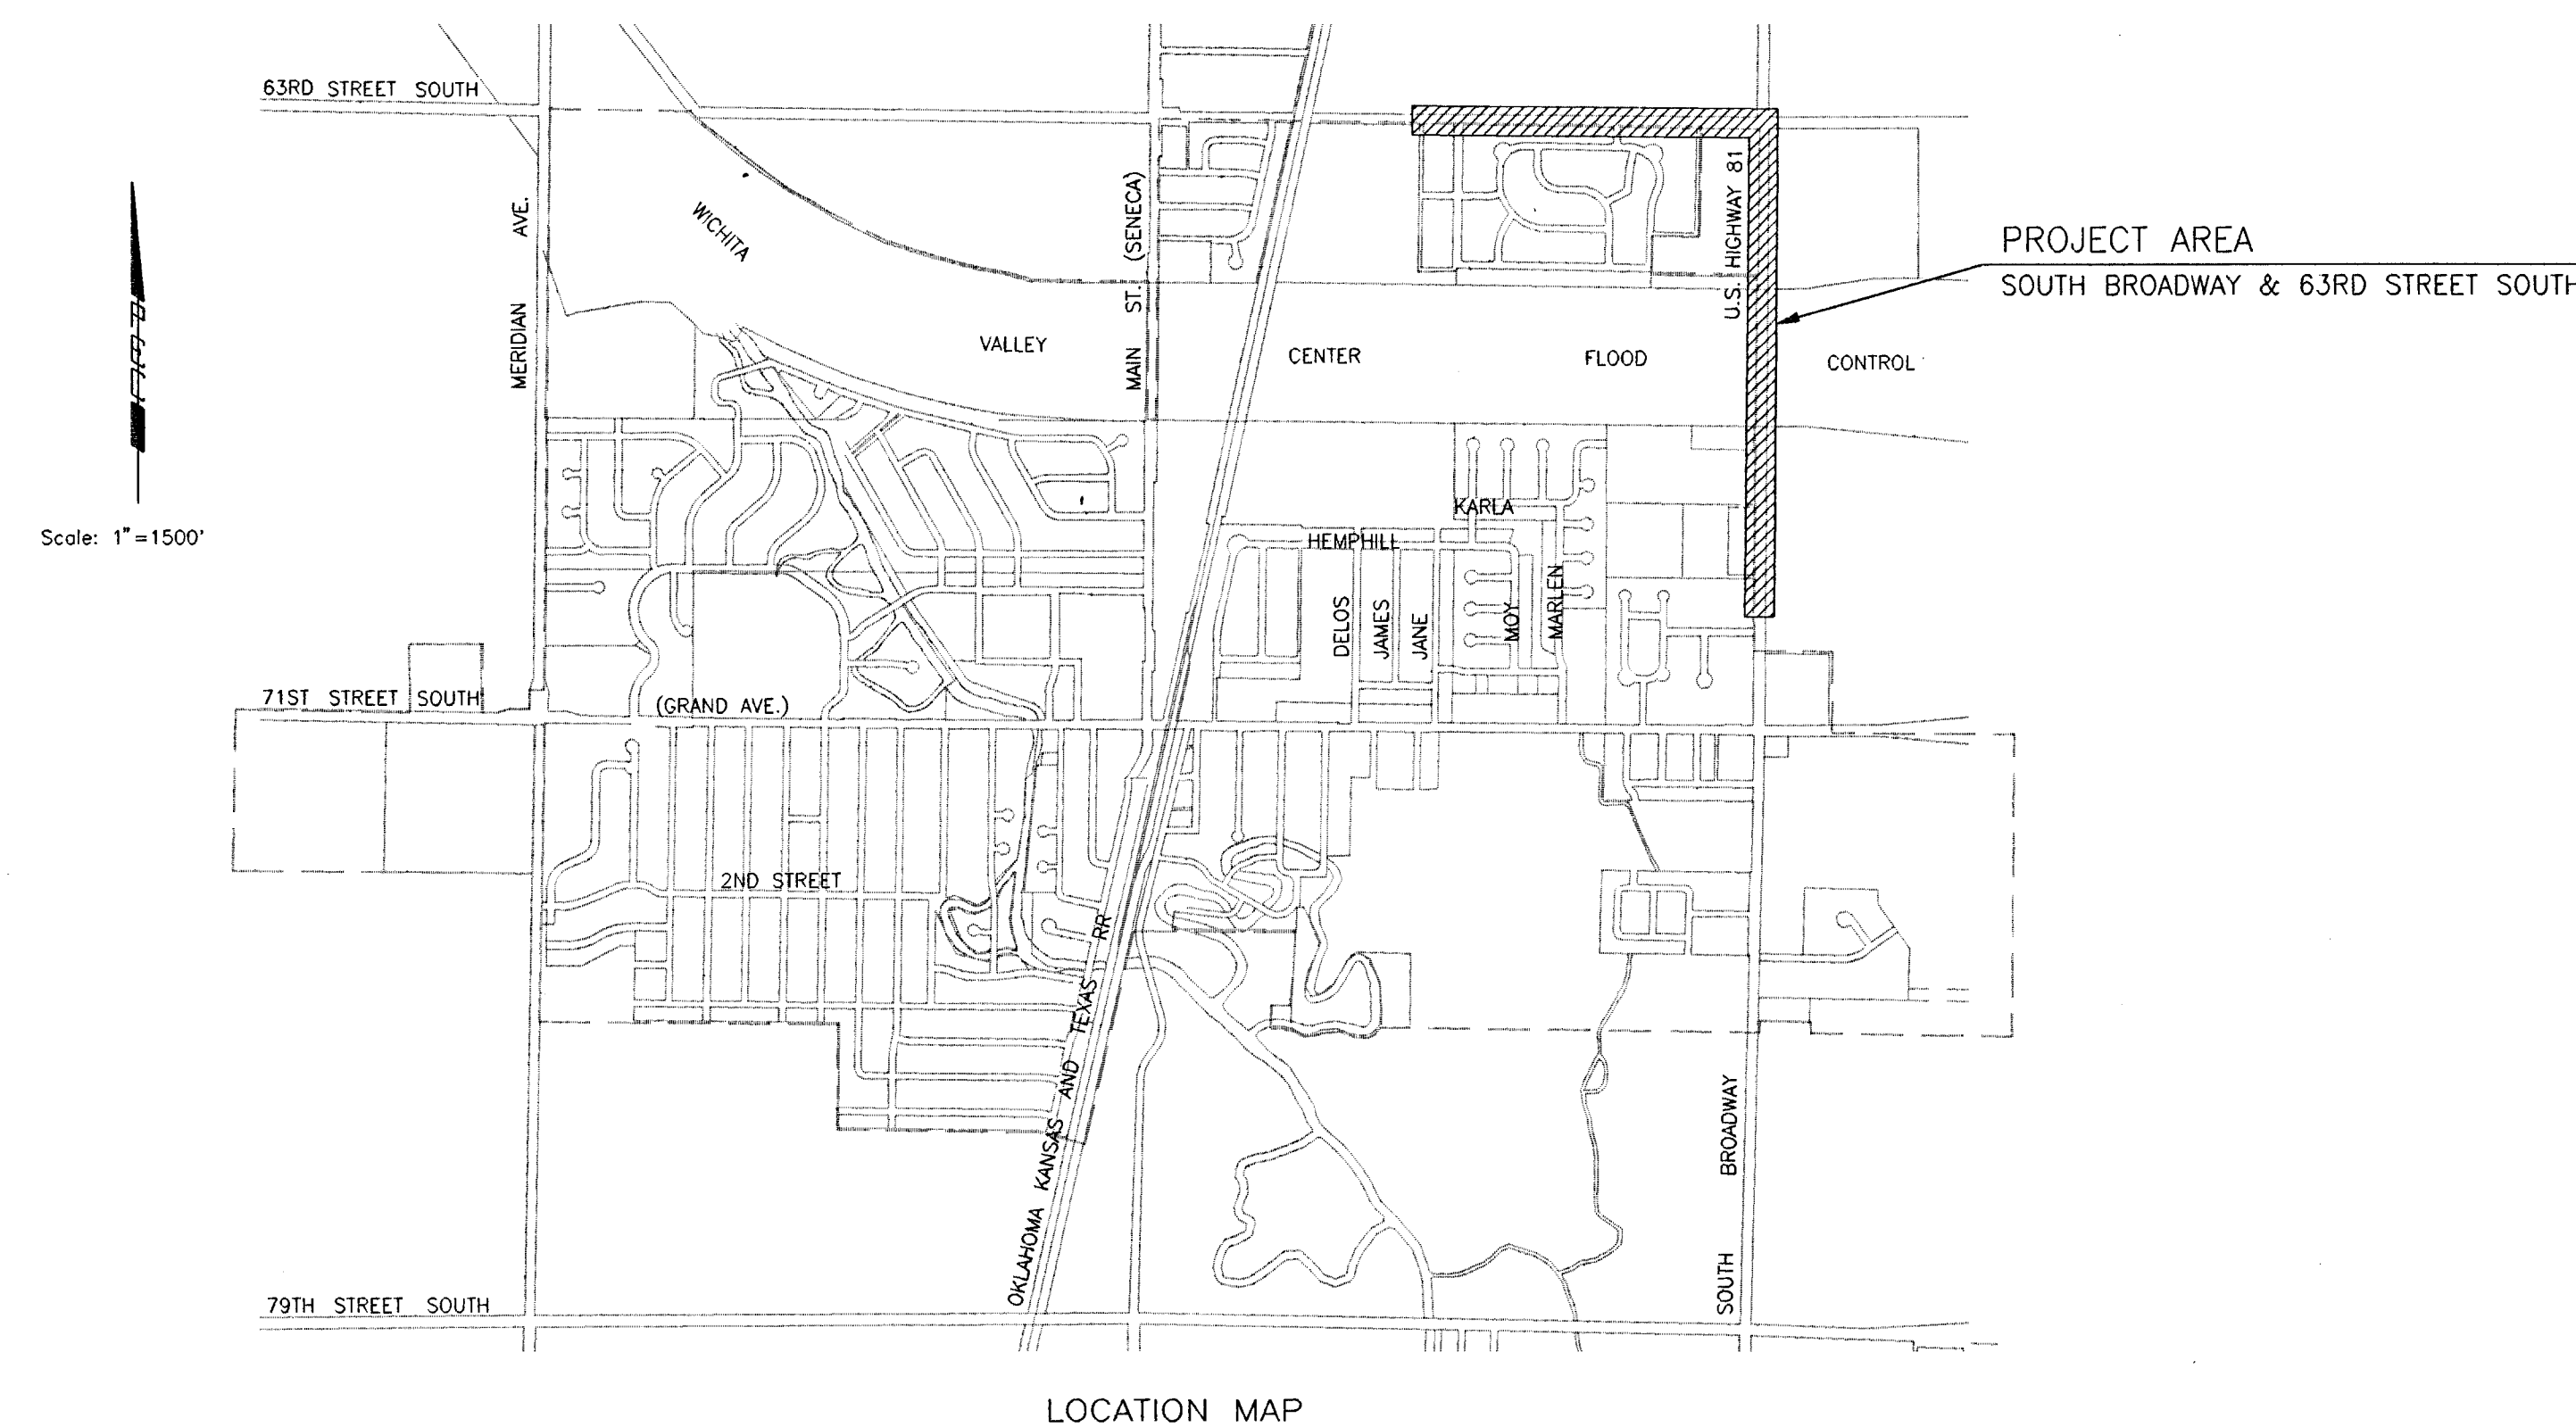


INDEX OF SHEETS

SHEET NO. 1	TITLE SHEET
SHEET NO. 2	KEY MAP
SHEET NO. 3	MISCELLANEOUS DETAILS
SHEET NO. 4-13	WATERLINE PLAN/PROFILE
SHEET NO. 14-15	BRIDGE ATTACHMENT DETAILS

OCTOBER 1995

PLANS PREPARED BY
PROFESSIONAL ENGINEERING CONSULTANTS, P.A.
ENGINEERS
WICHITA, KANSAS

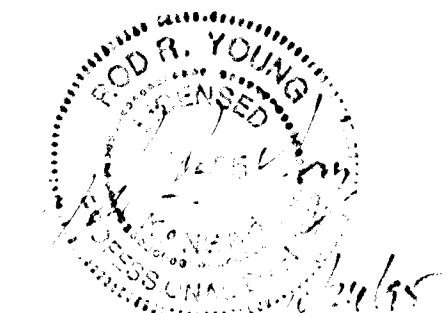

RECORD DRAWING
DATE 10/1/95
DATE 10/1/95