



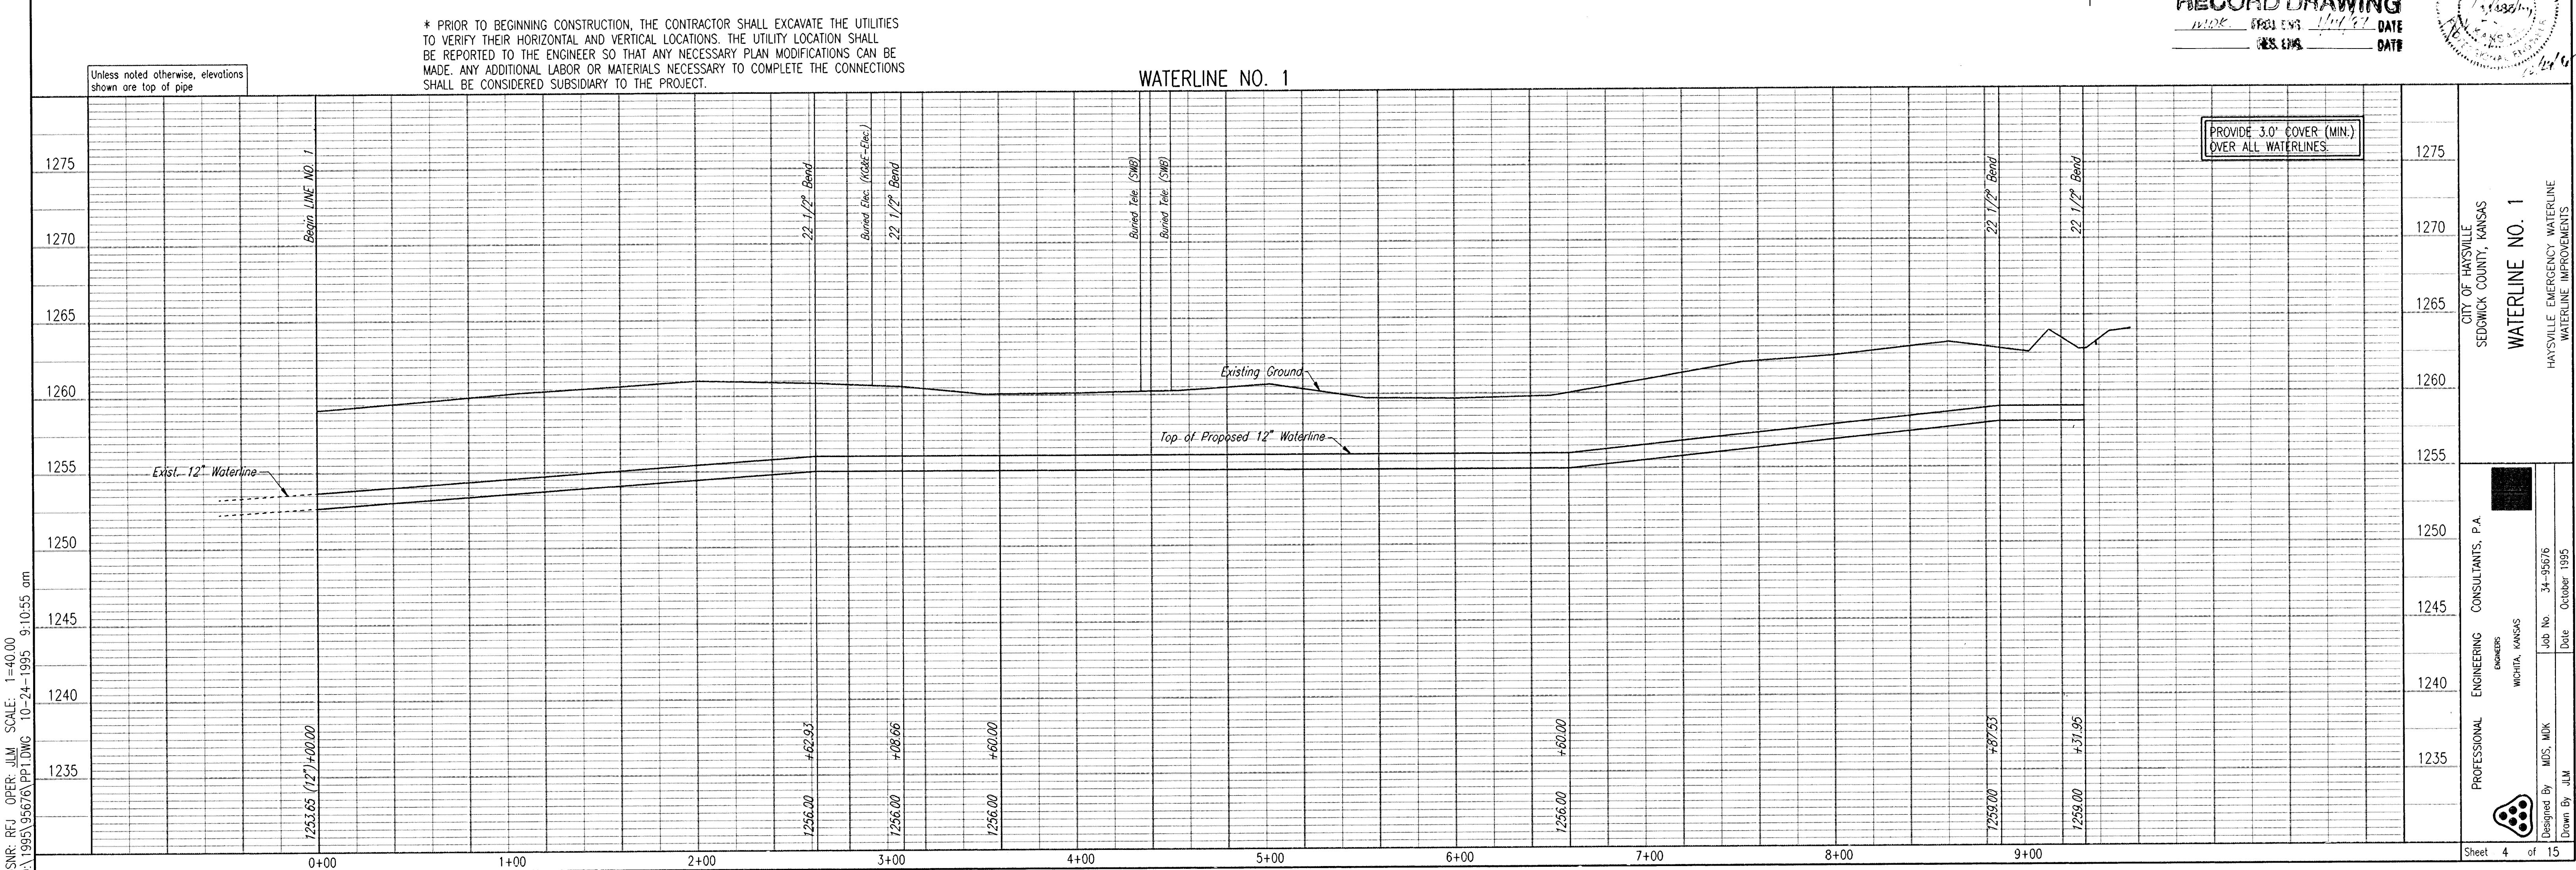

DSNR REF. OPER. JLM SCALE: 1"=40.00
Q:\1995\95676\PP1.DWG 10-24-1995 9:10:55 am

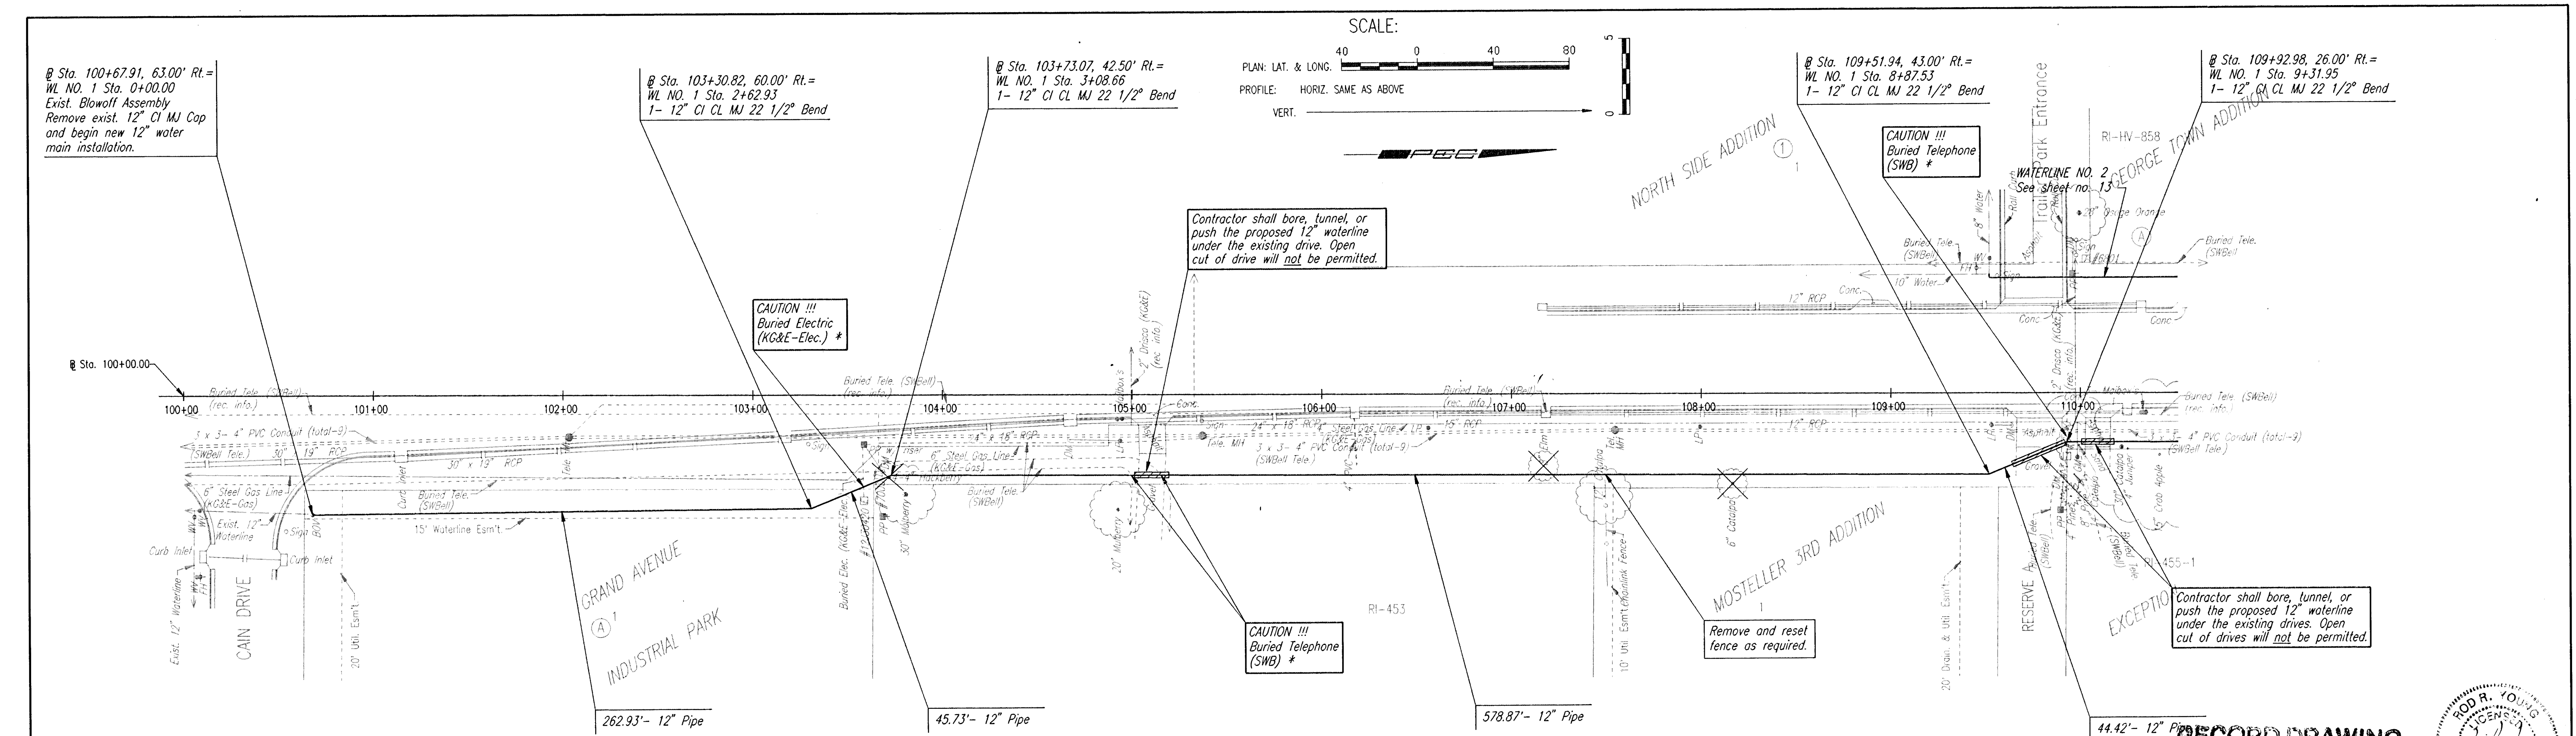

RECORD DRAWING
DATE 10/1/95
DESIGNED BY JLM
CHECKED BY JLM

CITY OF HAYSVILLE
SEDGWICK COUNTY, KANSAS
WATERLINE NO. 1
HAYSVILLE EMERGENCY WATERLINE
WATERLINE IMPROVEMENTS

PROFESSIONAL ENGINEERING CONSULTANTS, P.A.
ENGINEERS
WICHITA, KANSAS

Designed By: MDS, MJK
Drawn By: JLM

Job No. 34-95676
Date October 1995

Sheet 4 of 15