

@ Sta. 126+36.24, 70.00' Rt. =
WL NO. 1 Sta. 26+20.18

@ Sta. 128+70.78, 70.00' Rt. =
WL NO. 1 Sta. 28+54.72
1- 12" CI CL MJ 45° Bend

@ Sta. 128+87.69, 53.09' Rt. =
WL NO. 1 Sta. 28+78.63
1- 12" CI CL MJ 45° Bend
1- 12" Valve Assembly (N)
(MJ Gate Valve)
Top Valve Box El. = Match Existing

@ Sta. 133+74.52, 53.09' Rt. =
WL NO. 1 Sta. 33+65.46
1- 12" CI CL MJ 11 1/4° Bend

@ Sta. 134+83.10, 31.00' Rt. =
WL NO. 1 Sta. 34+76.26
1- 12" CI CL MJ 11 1/4° Bend


CAUTION!!!
12" Steel Gasline *
(Celly Gas Gathering)
Coordinate construction
operations w/ Celly Gas Gathering,
Larry Chancey @ 775-6091
(Provide at least 2 weeks notice)

CAUTION!!!
Guy Pole with Guy Wire.
KG&E to remove pole and Guy Wire.
At least 2 weeks prior to
start of construction, coordinate
work with KG&E-Electric,
Mr. Russ Chitwood at 261-6251.


* PRIOR TO BEGINNING CONSTRUCTION, THE CONTRACTOR SHALL EXCAVATE THE UTILITIES
TO VERIFY THEIR HORIZONTAL AND VERTICAL LOCATIONS. THE UTILITY LOCATION SHALL
BE REPORTED TO THE ENGINEER SO THAT ANY NECESSARY PLAN MODIFICATIONS CAN BE
MADE. ANY ADDITIONAL LABOR OR MATERIALS NECESSARY TO COMPLETE THE CONNECTIONS
SHALL BE CONSIDERED SUBSIDIARY TO THE PROJECT.

ALL PIPE AND FITTINGS SHALL BE D.I.R.J. FROM
WL STA. 17+41.72 TO WL STA. 27+68.32
PER THE SPECIFICATIONS.

RECORD DRAWING
10/1/95
11/1/97
12/1/97

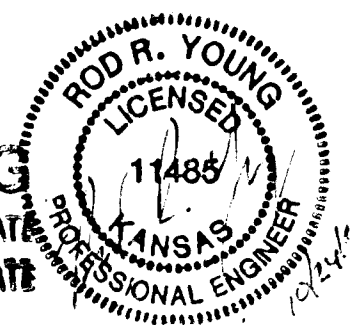

DSNR, REF. OPER. JLM SCALE: 1"=40.00'
Q. 1995/956/6 PP4.DWG 10-24-1995 9:16:56 am

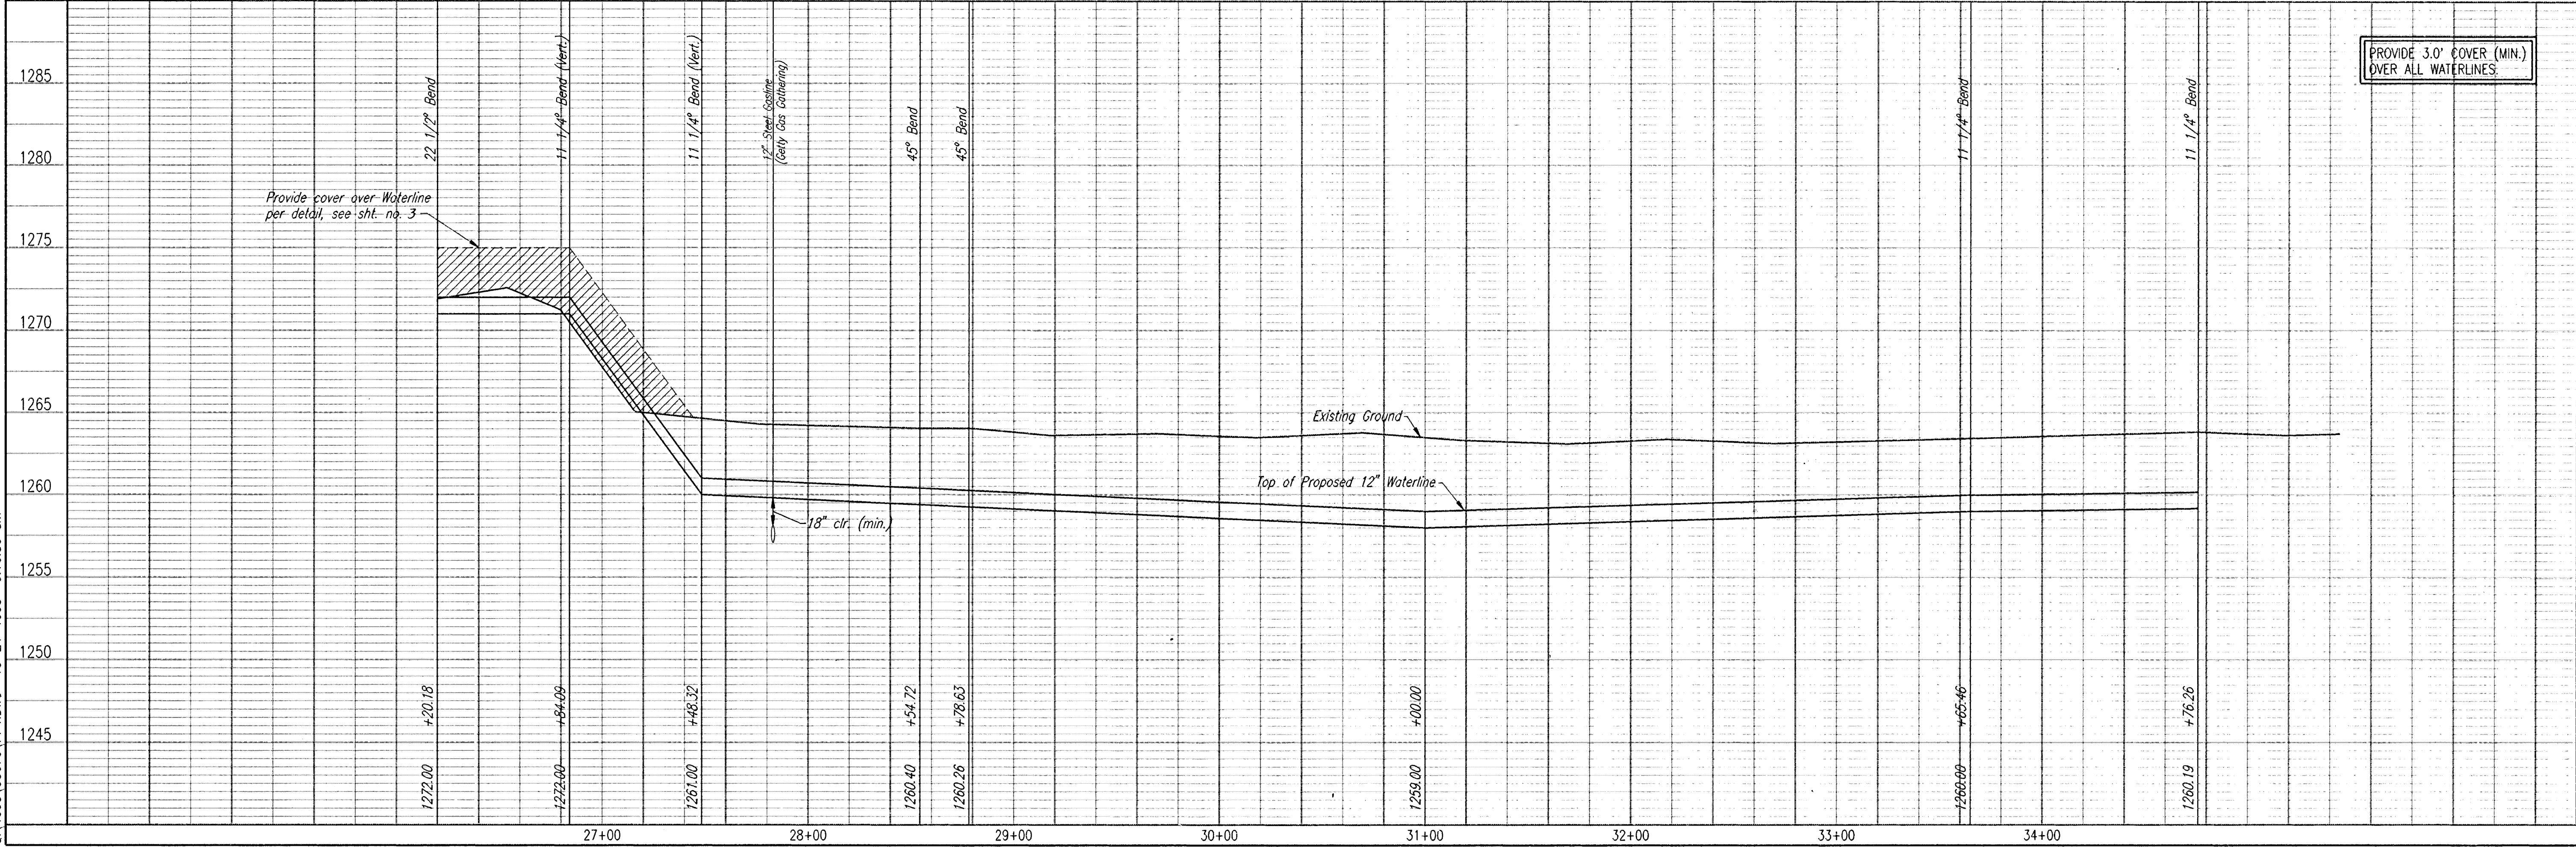

CITY OF HAYSVILLE
SEDGWICK COUNTY, KANSAS
WATERLINE NO. 1
HAYSVILLE EMERGENCY WATERLINE
WATERLINE IMPROVEMENTS

PROFESSIONAL ENGINEERING CONSULTANTS, P.A.
ENGINEERS
WICHITA, KANSAS
Job No. 34-956/6
Date October 1995
Designed By MDS, MDK
Drawn By JLM
Sheet 7 of 15