

@ Sta. 143+81.48 (ext.), 56.00' Rt. =
WL NO. 1 Sta. 43+77.75 (Back) =
WL NO. 1 Sta. 43+59.49 (Ahead)

@ Sta. 144+05.62, 50.49' Rt. =
WL NO. 1 Sta. 43+79.27
Defl. = 00°01'56"
Connect to exist. 12" DI Pipe


@ Sta. 144+05.62, 50.49' Rt. =
WL NO. 1 Sta. 44+89.26
1- 12"x12" CI CL MJ Tee
1- 12" Anchored MJ Gate Valve (N)
Top Valve Box El. = Match Existing
1- 12" CI CL MJ 22 1/2" Bend
Connect to exist. 12" DI Pipe

@ Sta. 144+61.87, 27.52' Rt. =
WL NO. 1 Sta. 45+50.02
1- 12" CI CL MJ 22 1/2" Bend
Top Valve Box El. = Match Existing

@ Sta. 149+00.00, 27.59' Rt. =
WL No. 1 Sta. 49+88.21
1- 12"x8" CI CL MJ Tee
1- 12" Anchored Valve Assembly
(MJ Gate Valve)
Top Valve Box El. = Match Existing

@ Sta. 149+00.00,
WL No. 1 Sta. 49+88.21
1- 8"x4" CI CL MJ Reducer
1- 4"x4" Tapping Sleeve
1- 4" Tapping Valve

@ Sta. 150+61.85, 27.61' Rt. =
WL NO. 1 Sta. 51+50.00
Match Point
See next sheet for continuation

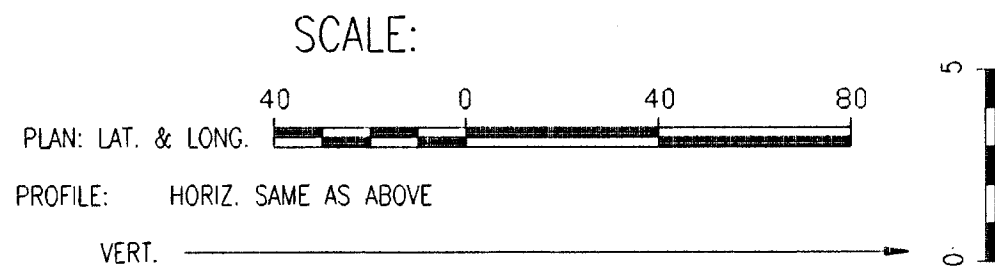

PART OF RI-391

CAUTION !!!
Buried Electric
(KG&E-Elec.) *


CAUTION !!!
4" Steel Gasline (KG&E-Gas)
Gas Service Line (KG&E-Gas) *

CAUTION !!!
Gas Service Line
(KG&E-Gas) *

* PRIOR TO BEGINNING CONSTRUCTION, THE CONTRACTOR SHALL EXCAVATE THE UTILITIES TO VERIFY THEIR HORIZONTAL AND VERTICAL LOCATIONS. THE UTILITY LOCATION SHALL BE REPORTED TO THE ENGINEER SO THAT ANY NECESSARY PLAN MODIFICATIONS CAN BE MADE. ANY ADDITIONAL LABOR OR MATERIALS NECESSARY TO COMPLETE THE CONNECTIONS SHALL BE CONSIDERED SUBSIDIARY TO THE PROJECT.


RECORD DRAWING

DATE 11/1/95
DESIGNED BY MCK
CHECKED BY RES
DATE 11/1/95

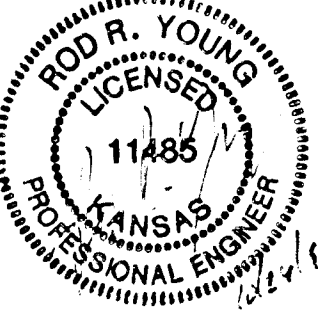

WATERLINE NO. 1

Unless noted otherwise, elevations shown are top of pipe

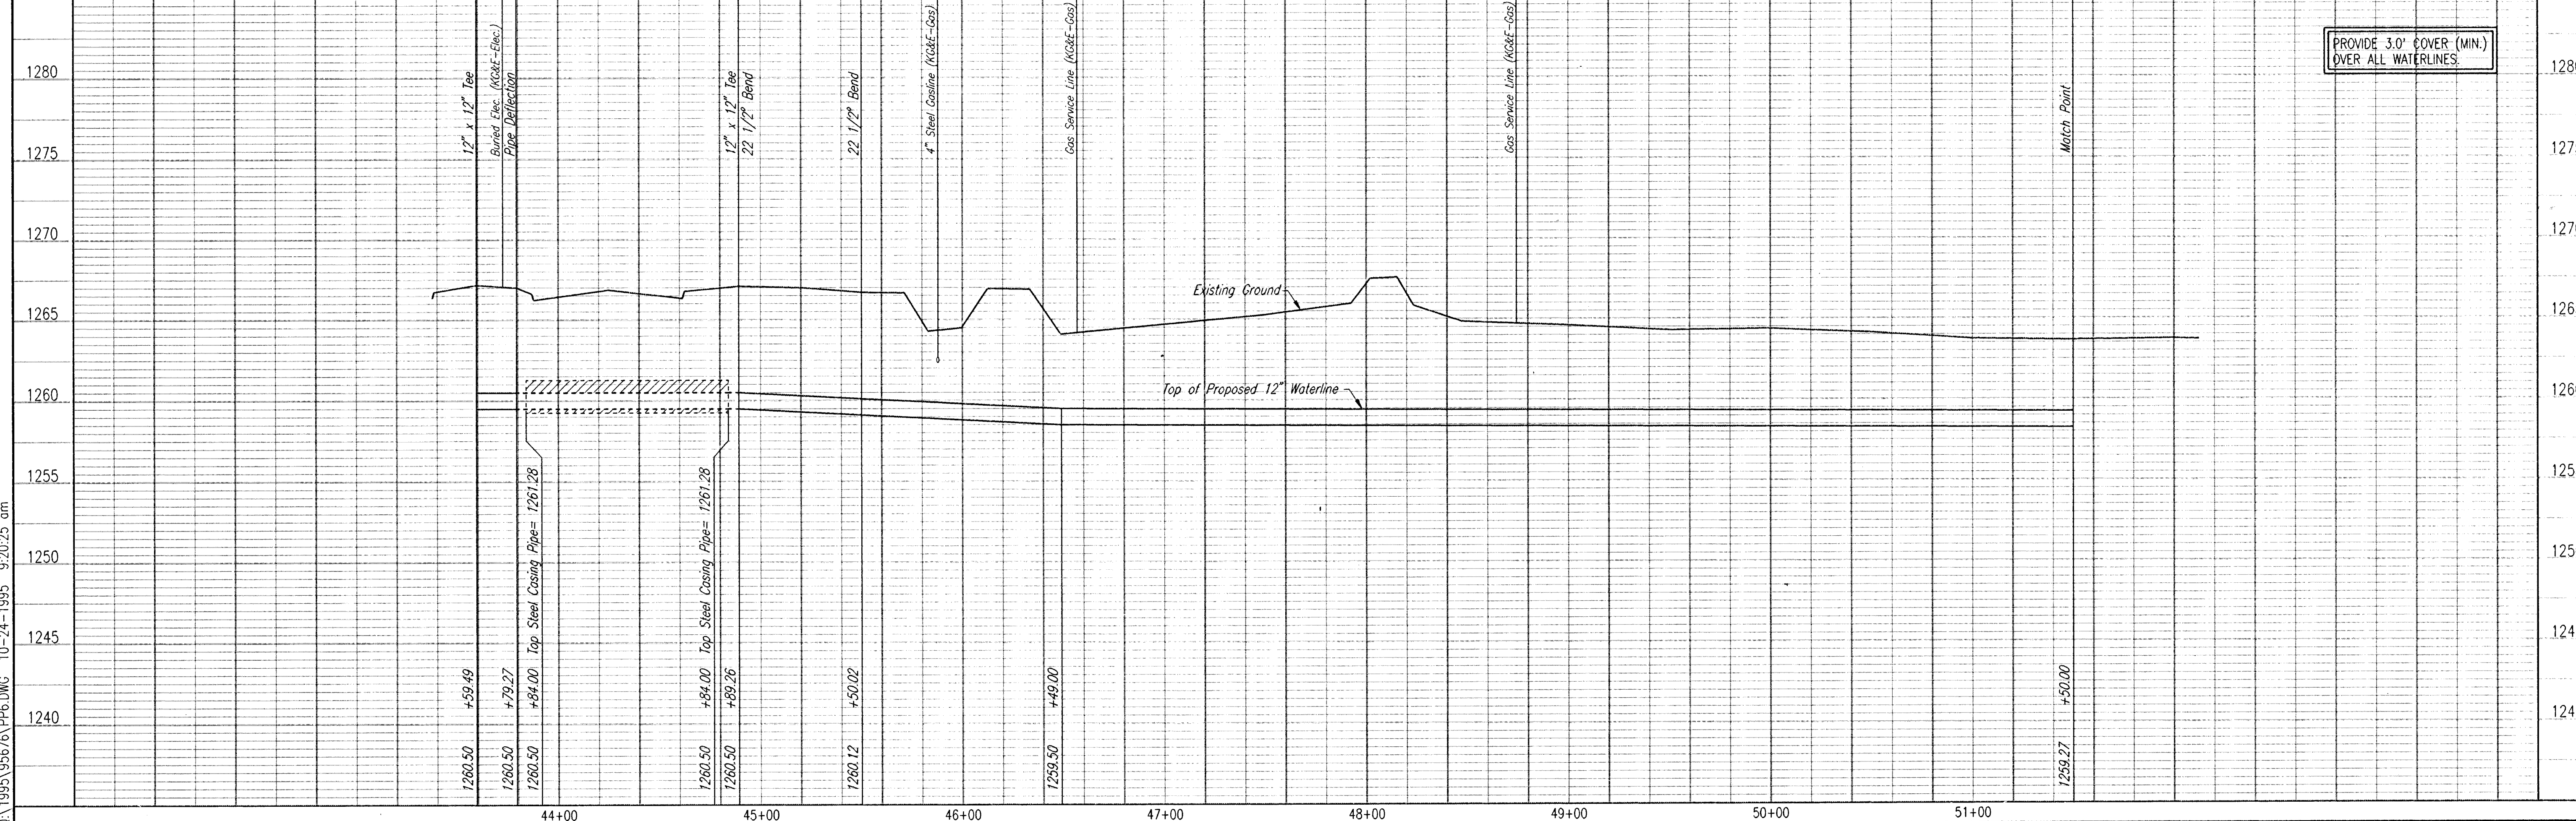

CITY OF HAYSVILLE
SEDGWICK COUNTY, KANSAS
WATERLINE NO. 1
HAYSVILLE EMERGENCY WATERLINE
WATERLINE IMPROVEMENTS

PROFESSIONAL ENGINEERING CONSULTANTS, P.A.
ENGINEERS
WICHITA, KANSAS

Designed By MCK
Drawn By JLM

Job No. 34-95876
Date October 1995

Sheet 9 of 15