
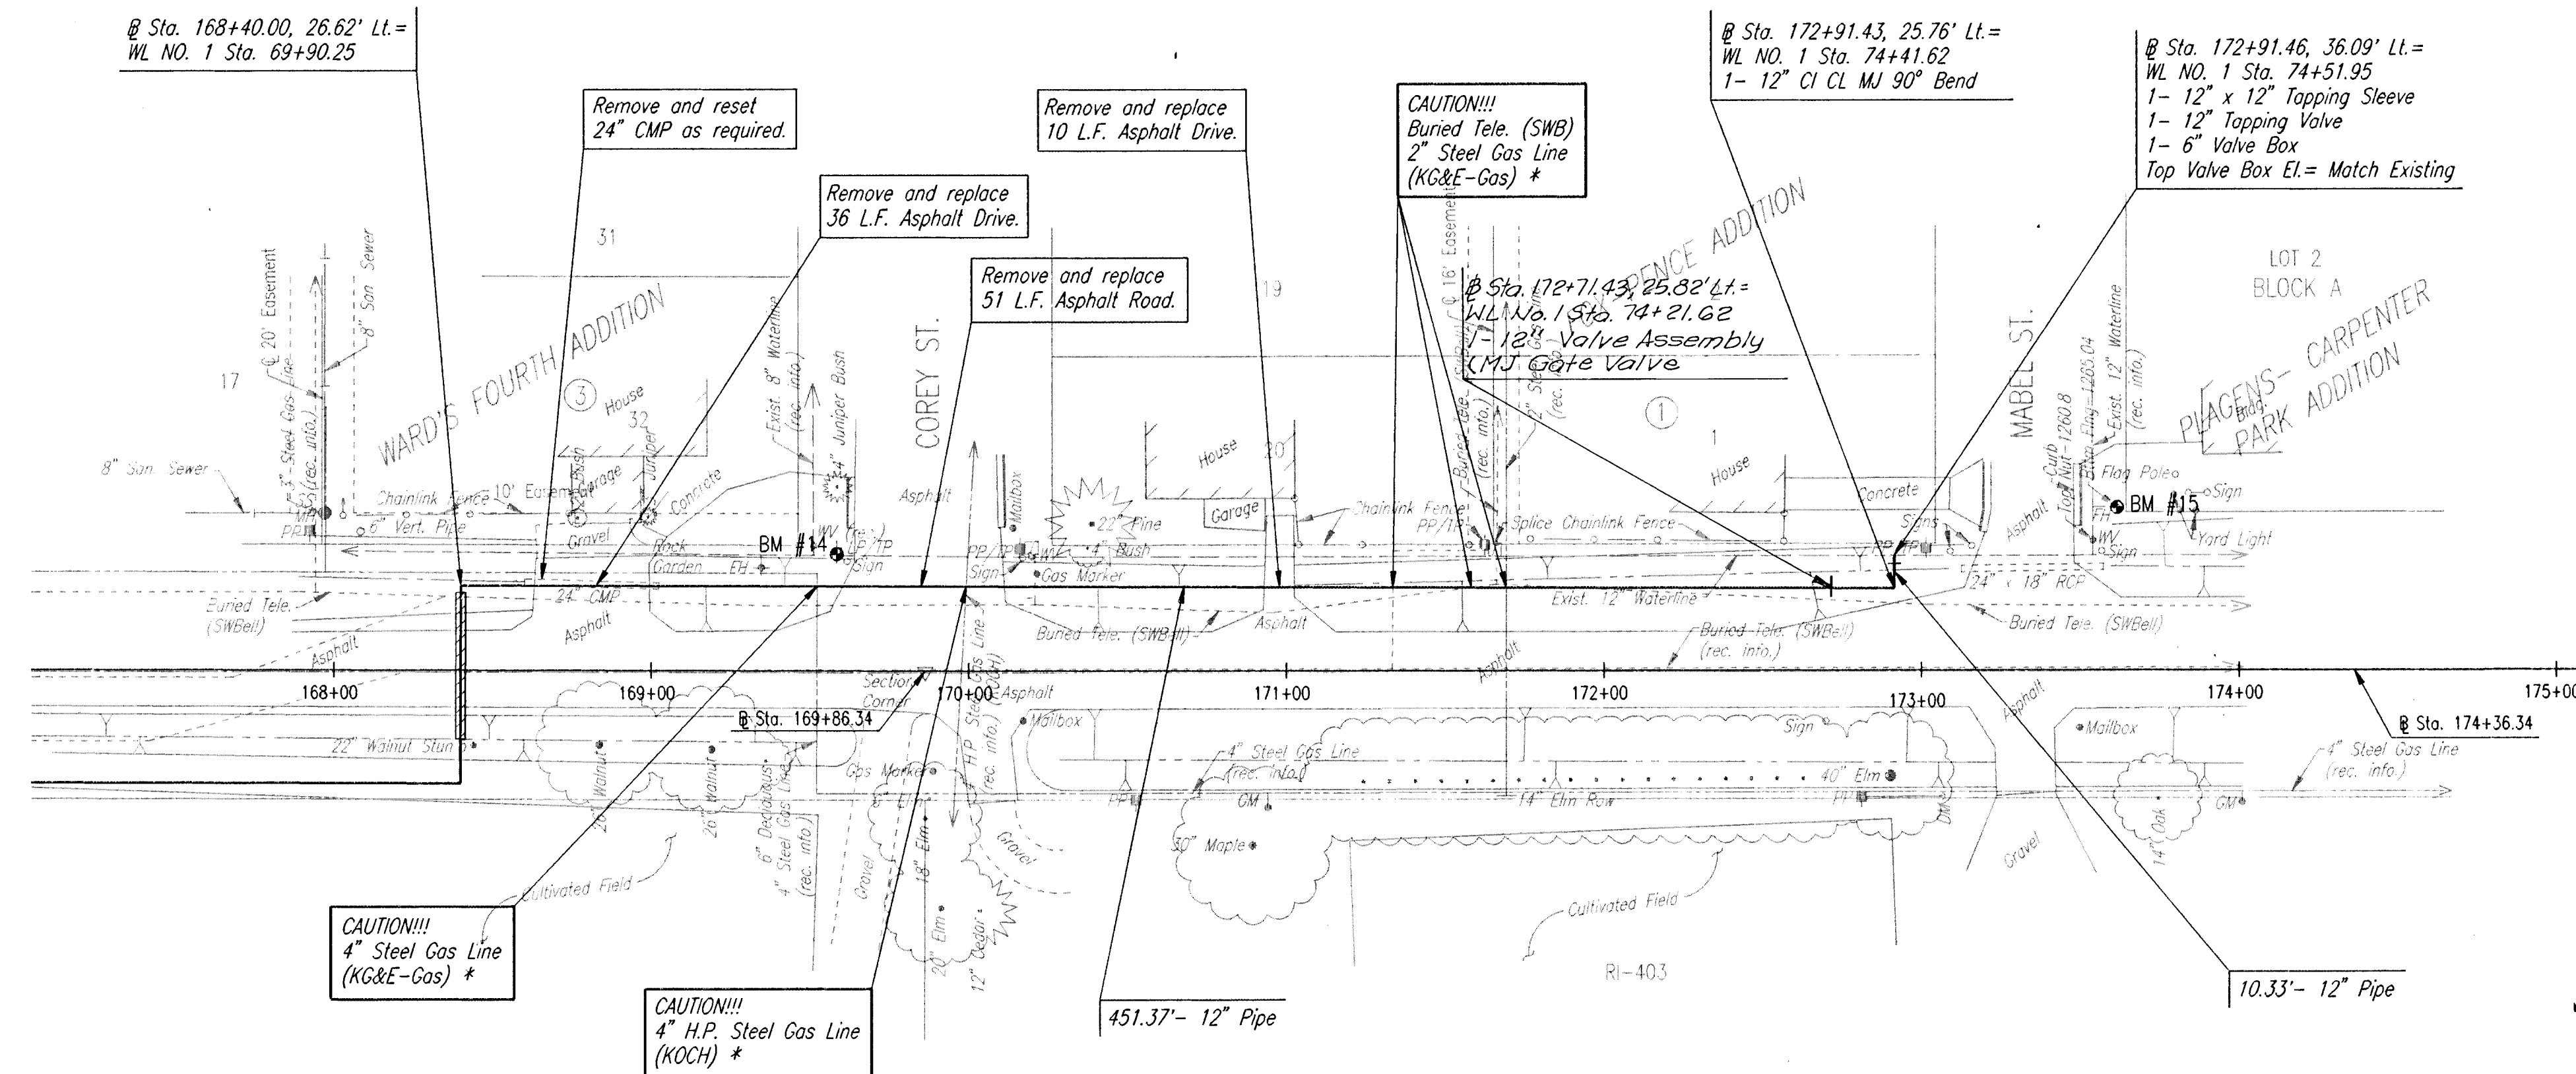



* PRIOR TO BEGINNING CONSTRUCTION, THE CONTRACTOR SHALL EXCAVATE THE UTILITIES TO VERIFY THEIR HORIZONTAL AND VERTICAL LOCATIONS. THE UTILITY LOCATION SHALL BE REPORTED TO THE ENGINEER SO THAT ANY NECESSARY PLAN MODIFICATIONS CAN BE MADE. ANY ADDITIONAL LABOR OR MATERIALS NECESSARY TO COMPLETE THE CONNECTIONS SHALL BE CONSIDERED SUBSIDIARY TO THE PROJECT.

RECORD DRAWING
DATE 10/19/95
DATE 10/19/95

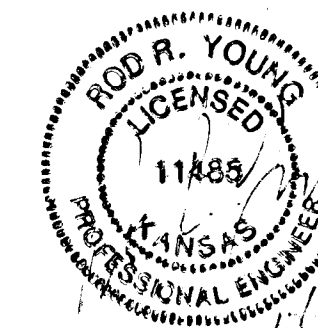

Unless noted otherwise, elevations shown are top of pipe

WATERLINE NO. 1

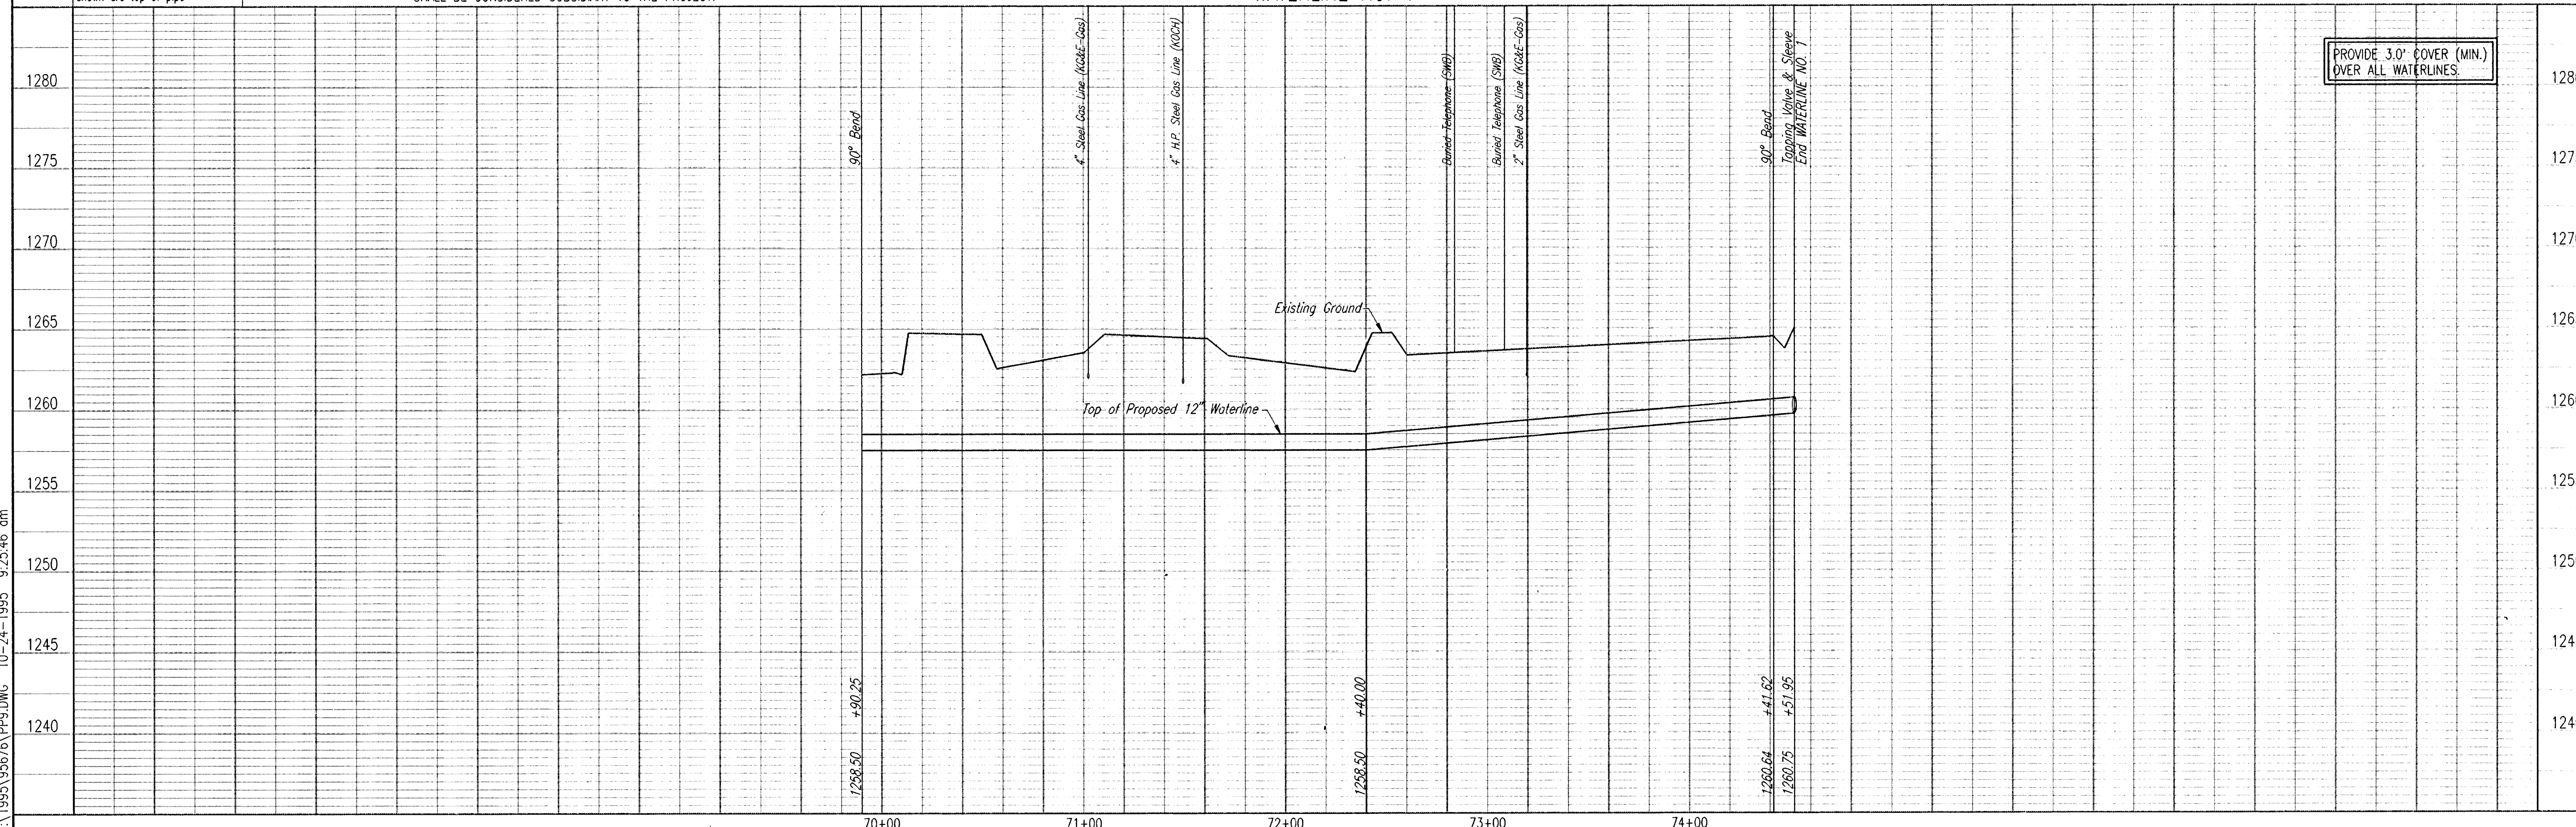

PROVIDE 3.0' COVER (MIN.) OVER ALL WATERLINES.

DSNR: REF. OPER. JLM SCALE: 1\"/>

CITY OF HAYSVILLE SEDGWICK COUNTY, KANSAS WATERLINE NO. 1 HAYSVILLE EMERGENCY WATERLINE WATERLINE IMPROVEMENTS	
PROFESSIONAL ENGINEERING CONSULTANTS, P.A. ENGINEERS WICHITA, KANSAS	Job No. 34-55676 Date October 1995
Designed By MDS, MDK Drawn By JLM	