
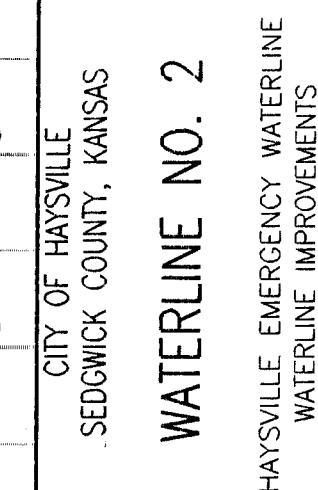


RECORD DRAWING
WORK. POOLING 11/1/97 DATE
DES. ENG. DATE

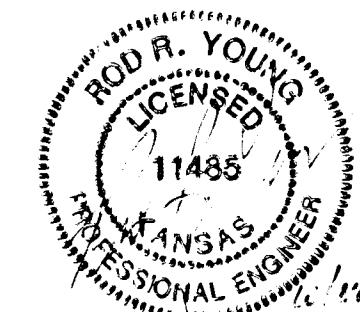

PROFESSIONAL ENGINEERING CONSULTANTS, P.A.
ENGINEERS
WICHITA, KANSAS

Y MDS, MDK	Job No. 34-95676
JLM	Date October 1995

of 15	Designed By	Drawn By
-------	-------------	----------