



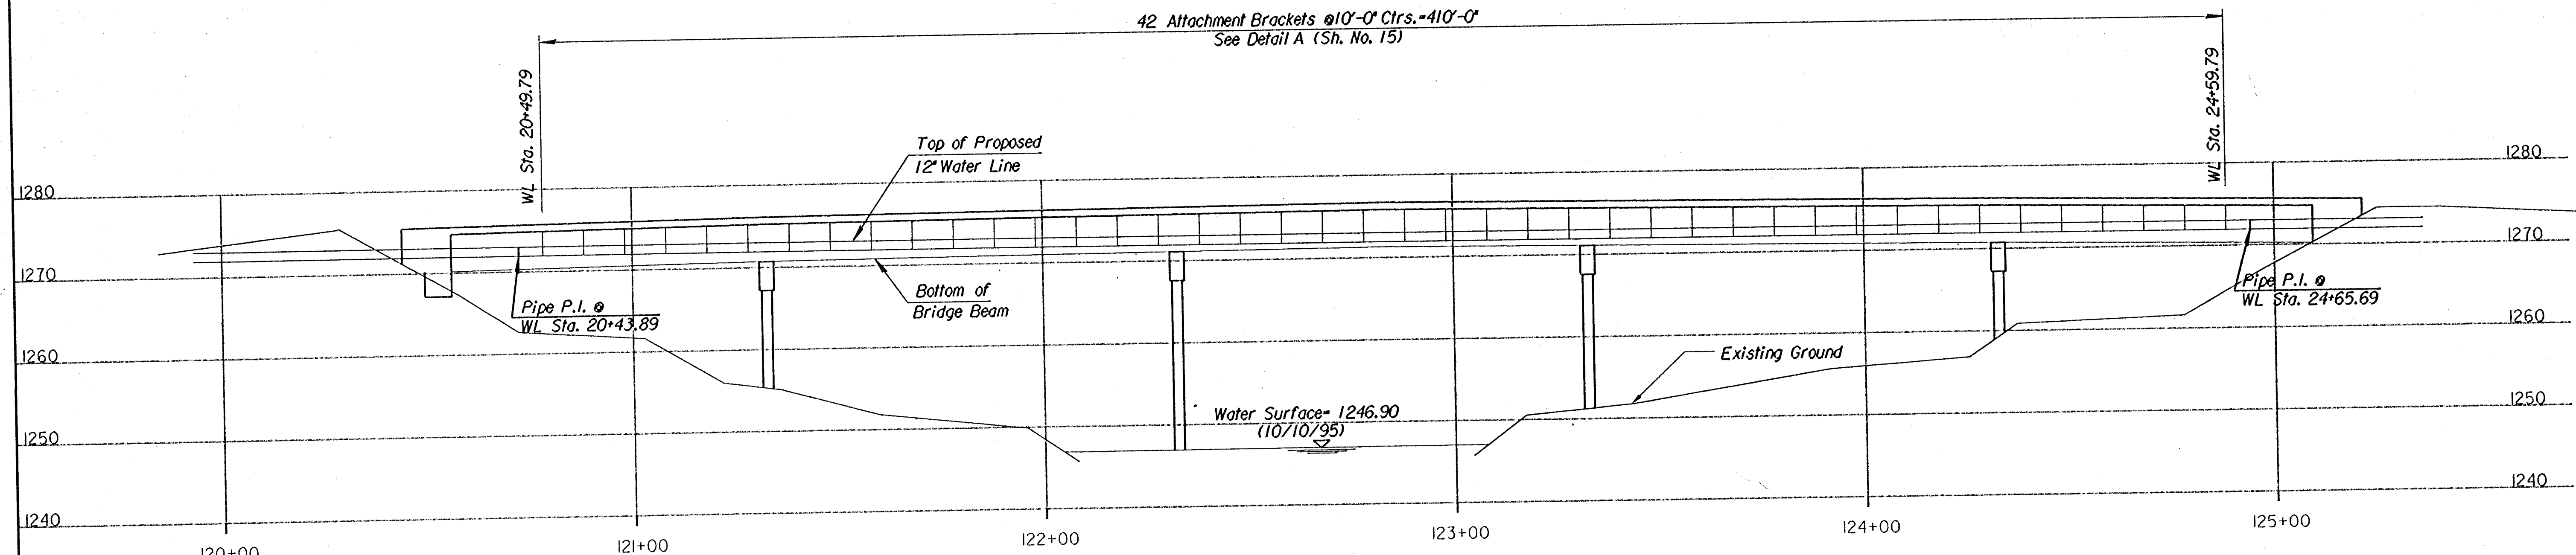


**ELEVATION**  
(Bridge Rail not shown for clarity)

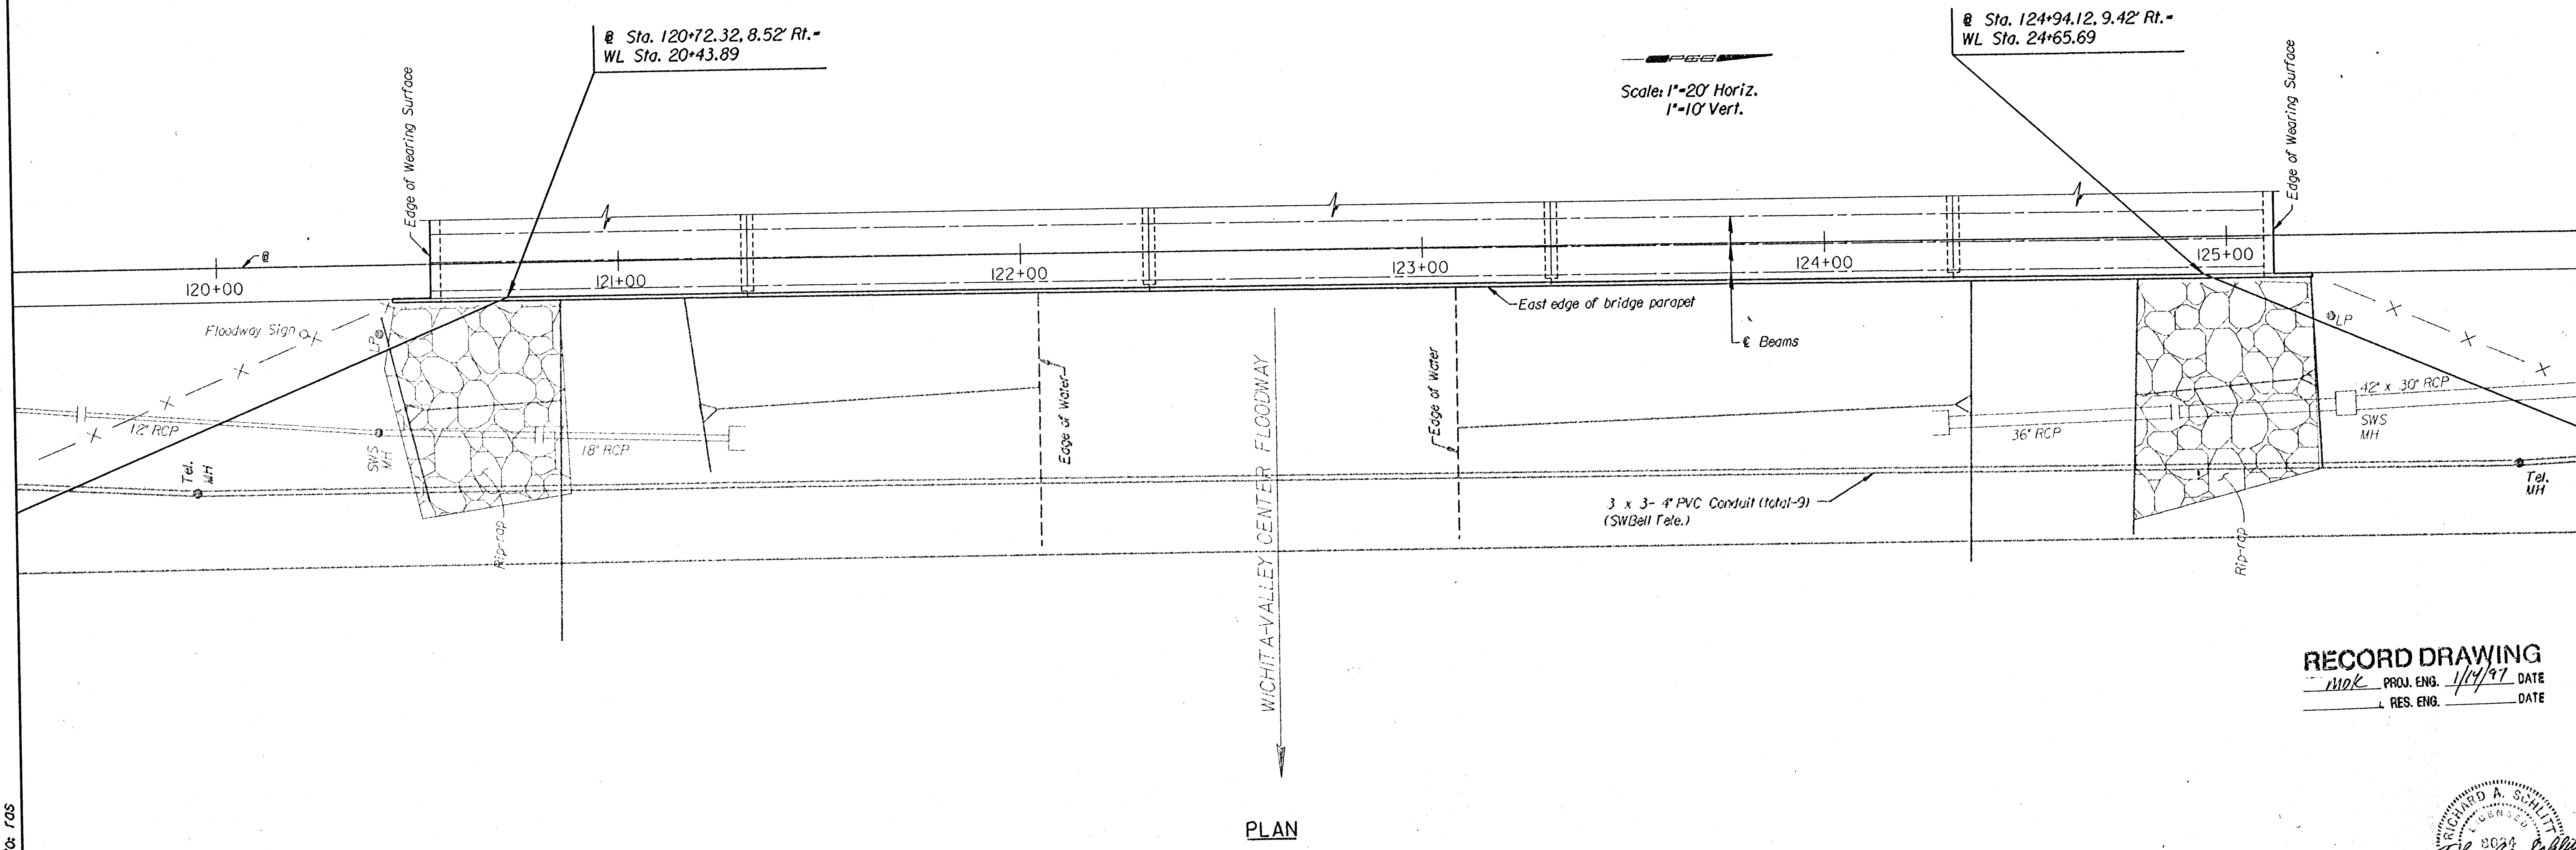

**PLAN**

**RECORD DRAWING**  
 PROJ. ENG. 1/14/97 DATE  
 RES. ENG. DATE

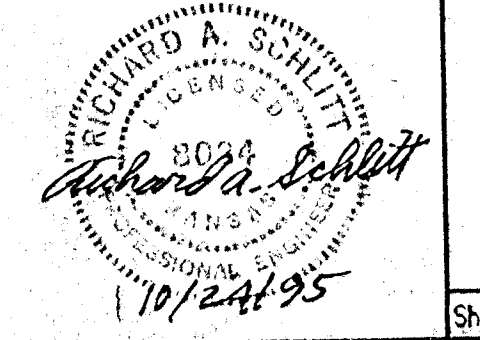

|                                              |                    |
|----------------------------------------------|--------------------|
| CITY OF HAYSVILLE<br>SEDGWICK COUNTY, KANSAS |                    |
| CONSTRUCTION LAYOUT                          |                    |
| OVER WICHITA VALLEY CENTER FLOODWAY          |                    |
| HAYSVILLE EMERGENCY WATERLINE                |                    |
| WATERLINE IMPROVEMENTS                       |                    |
| Professional Engineer                        | CONSULTANTS, P.A.  |
| Designed By: RAS                             | Job No. 22-95276   |
| Drawn By: NAF                                | Date: October 1995 |

i:/1995/95676/pbase.dgn  
 drawn by: naf  
 plotted by: ras 10-23-95  
 deliver to: ras