


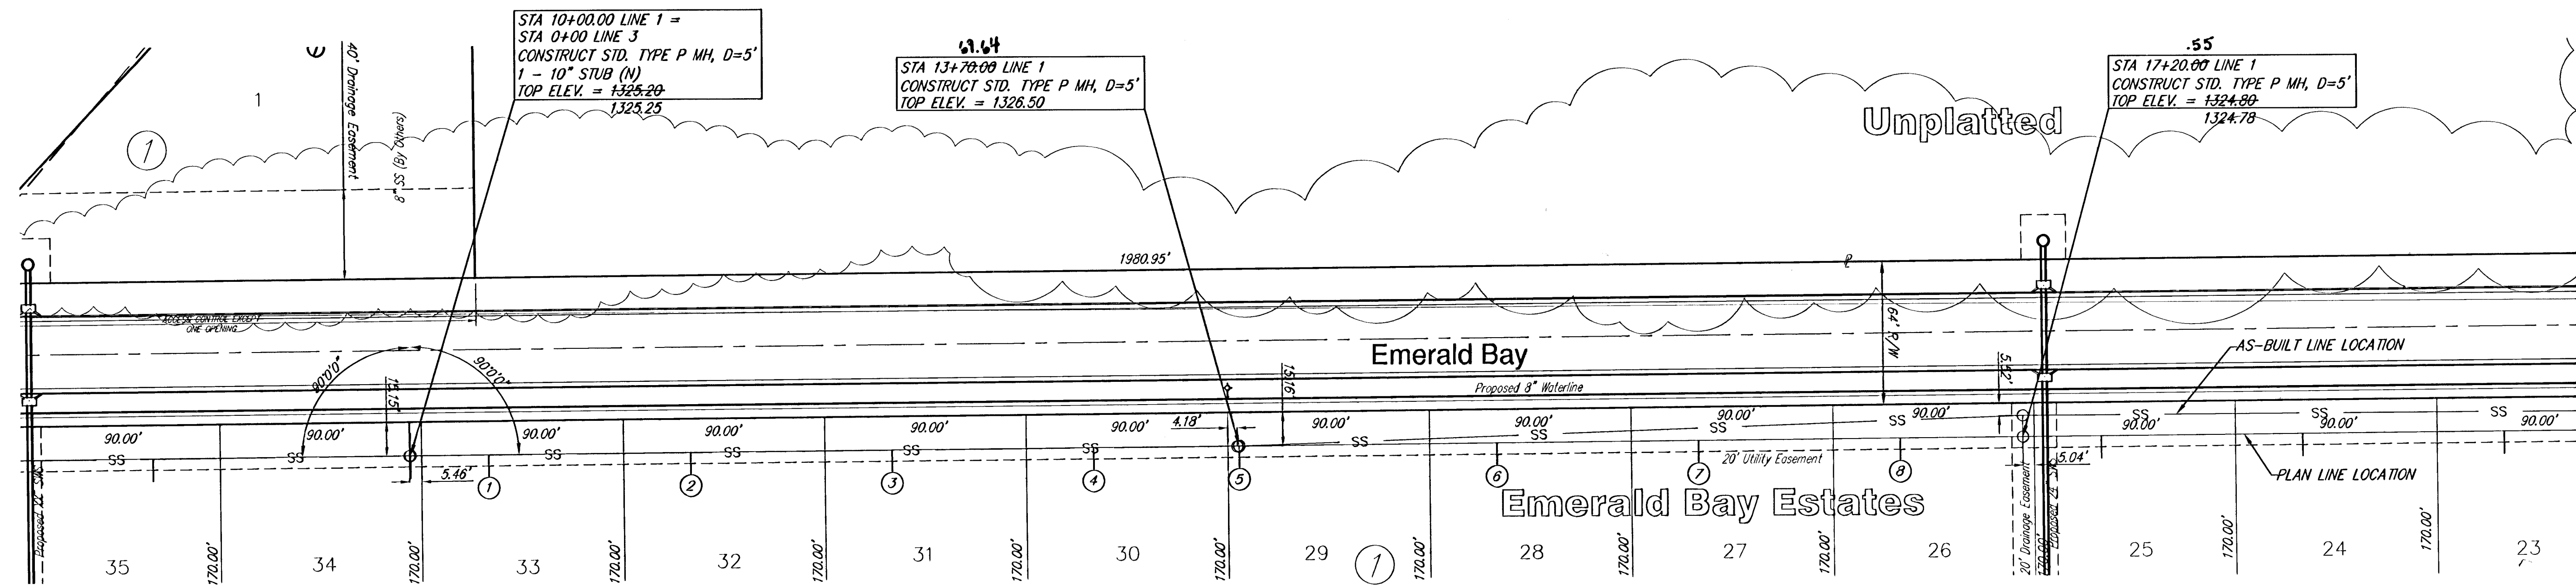

SCALE 1" = 40' HORIZ.
 1" = 5' VERT.
 IRON = ●


SEWER SERVICE TABLE

NUMBER	TYPE	LOCATION			FOR INFORMATION ONLY		
		LOT NO.	BLOCK NO.	LINE NO.	STATION\ DIRECTION	APPROXIMATE LENGTH 4" PIPE	
1	8" X 4" Tee Saddle	33	1	1	10+30/R	31.07 21'	10'
2	8" X 4" Tee Saddle	32	1	1	11+25/R	26.12 21'	10' 12.25
3	8" X 4" Tee Saddle	31	1	1	12+18/R	13.35 22'	10' 14
4	8" X 4" Tee Saddle	30	1	1	13+08/R	66.07 22'	10' 12
5	4" MH Riser	29	1	1	13+20/R	10.0 21'	10' 9
6	8" X 4" Tee Saddle	28	1	1	14+85/R	8.3 20'	10' 13
7	8" X 4" Tee Saddle	27	1	1	15+75/R	7.3 20'	10' 12
8	8" X 4" Tee Saddle	26	1	1	16+85/R	10.2 19'	10' 13

NOTE: ALL BACKFILL FOR SHALL BE SAND FLUSHED AND VIBRATED.

NOTE: Vertical Riser Pipe shall be extended to 2' minimum above ground water elevation and 4' maximum below proposed ground elevation.

11.2.07 "AS-BUILT"
 3-15-07
 AML 12.3.07
 AML

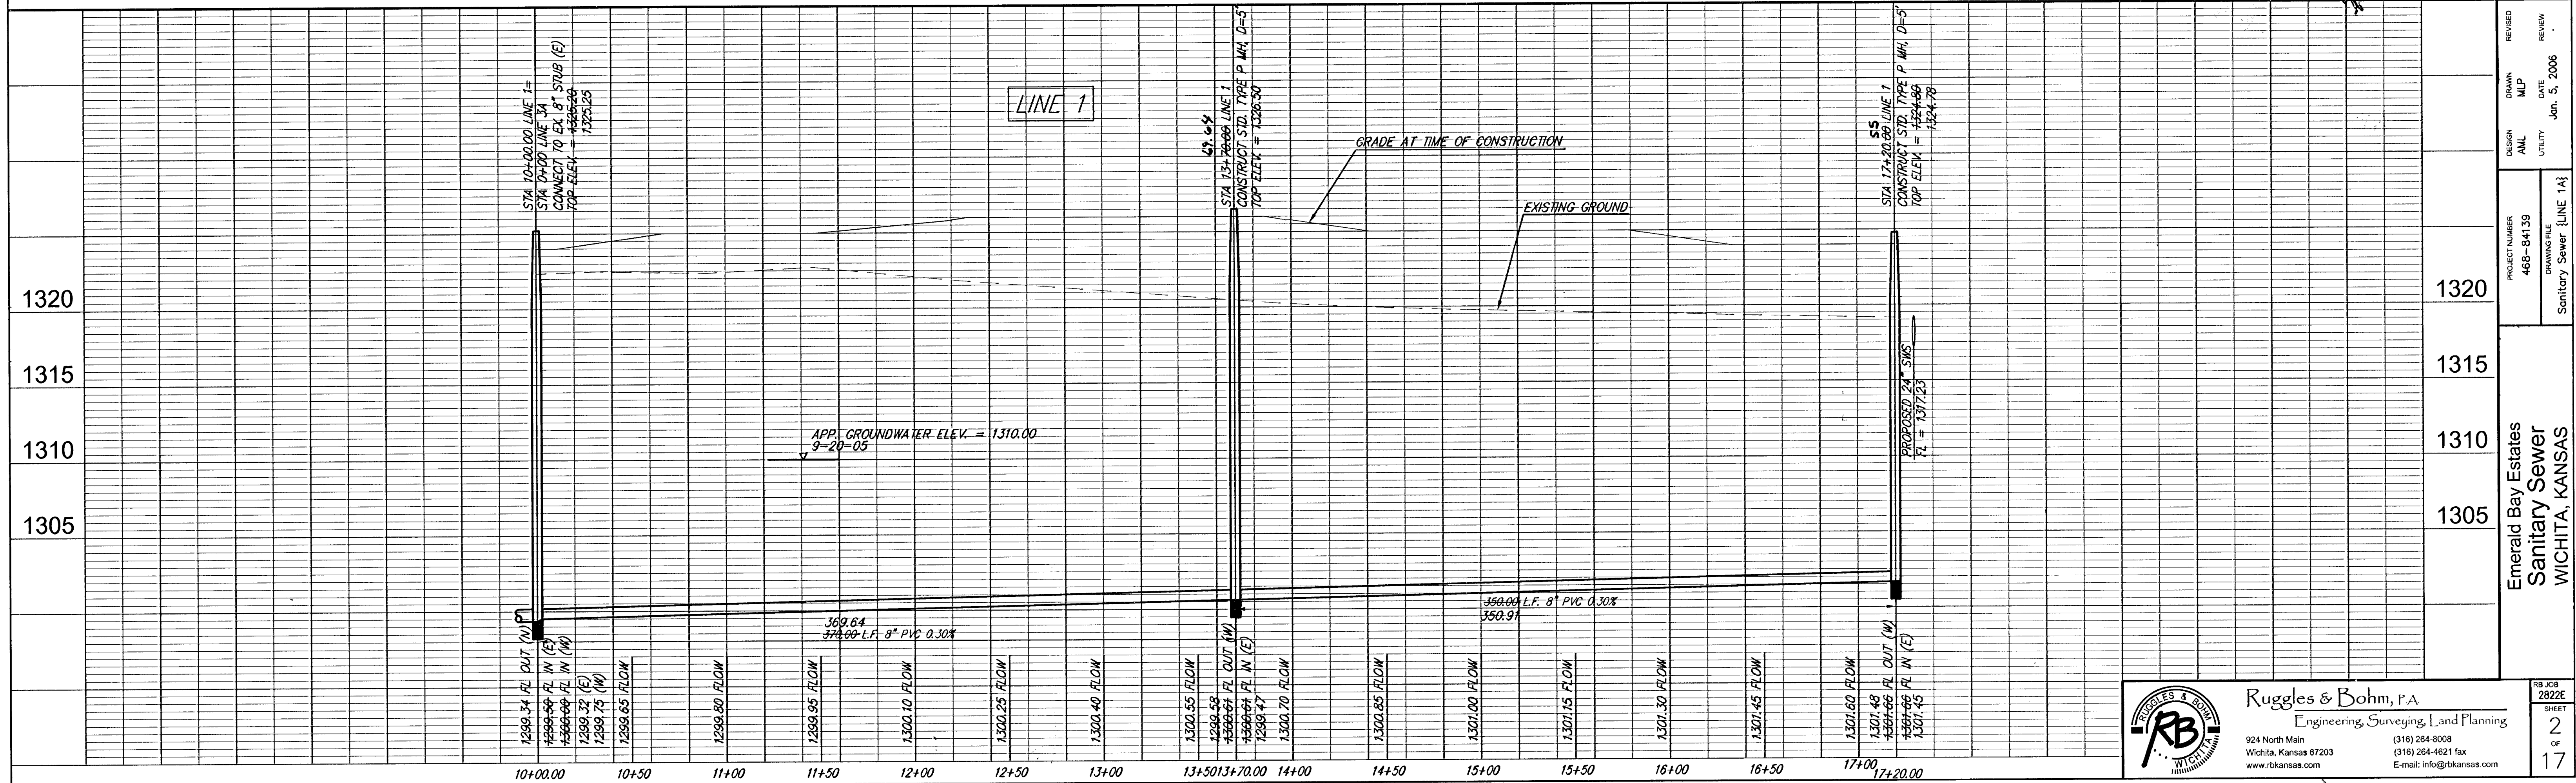

468-84139AB