


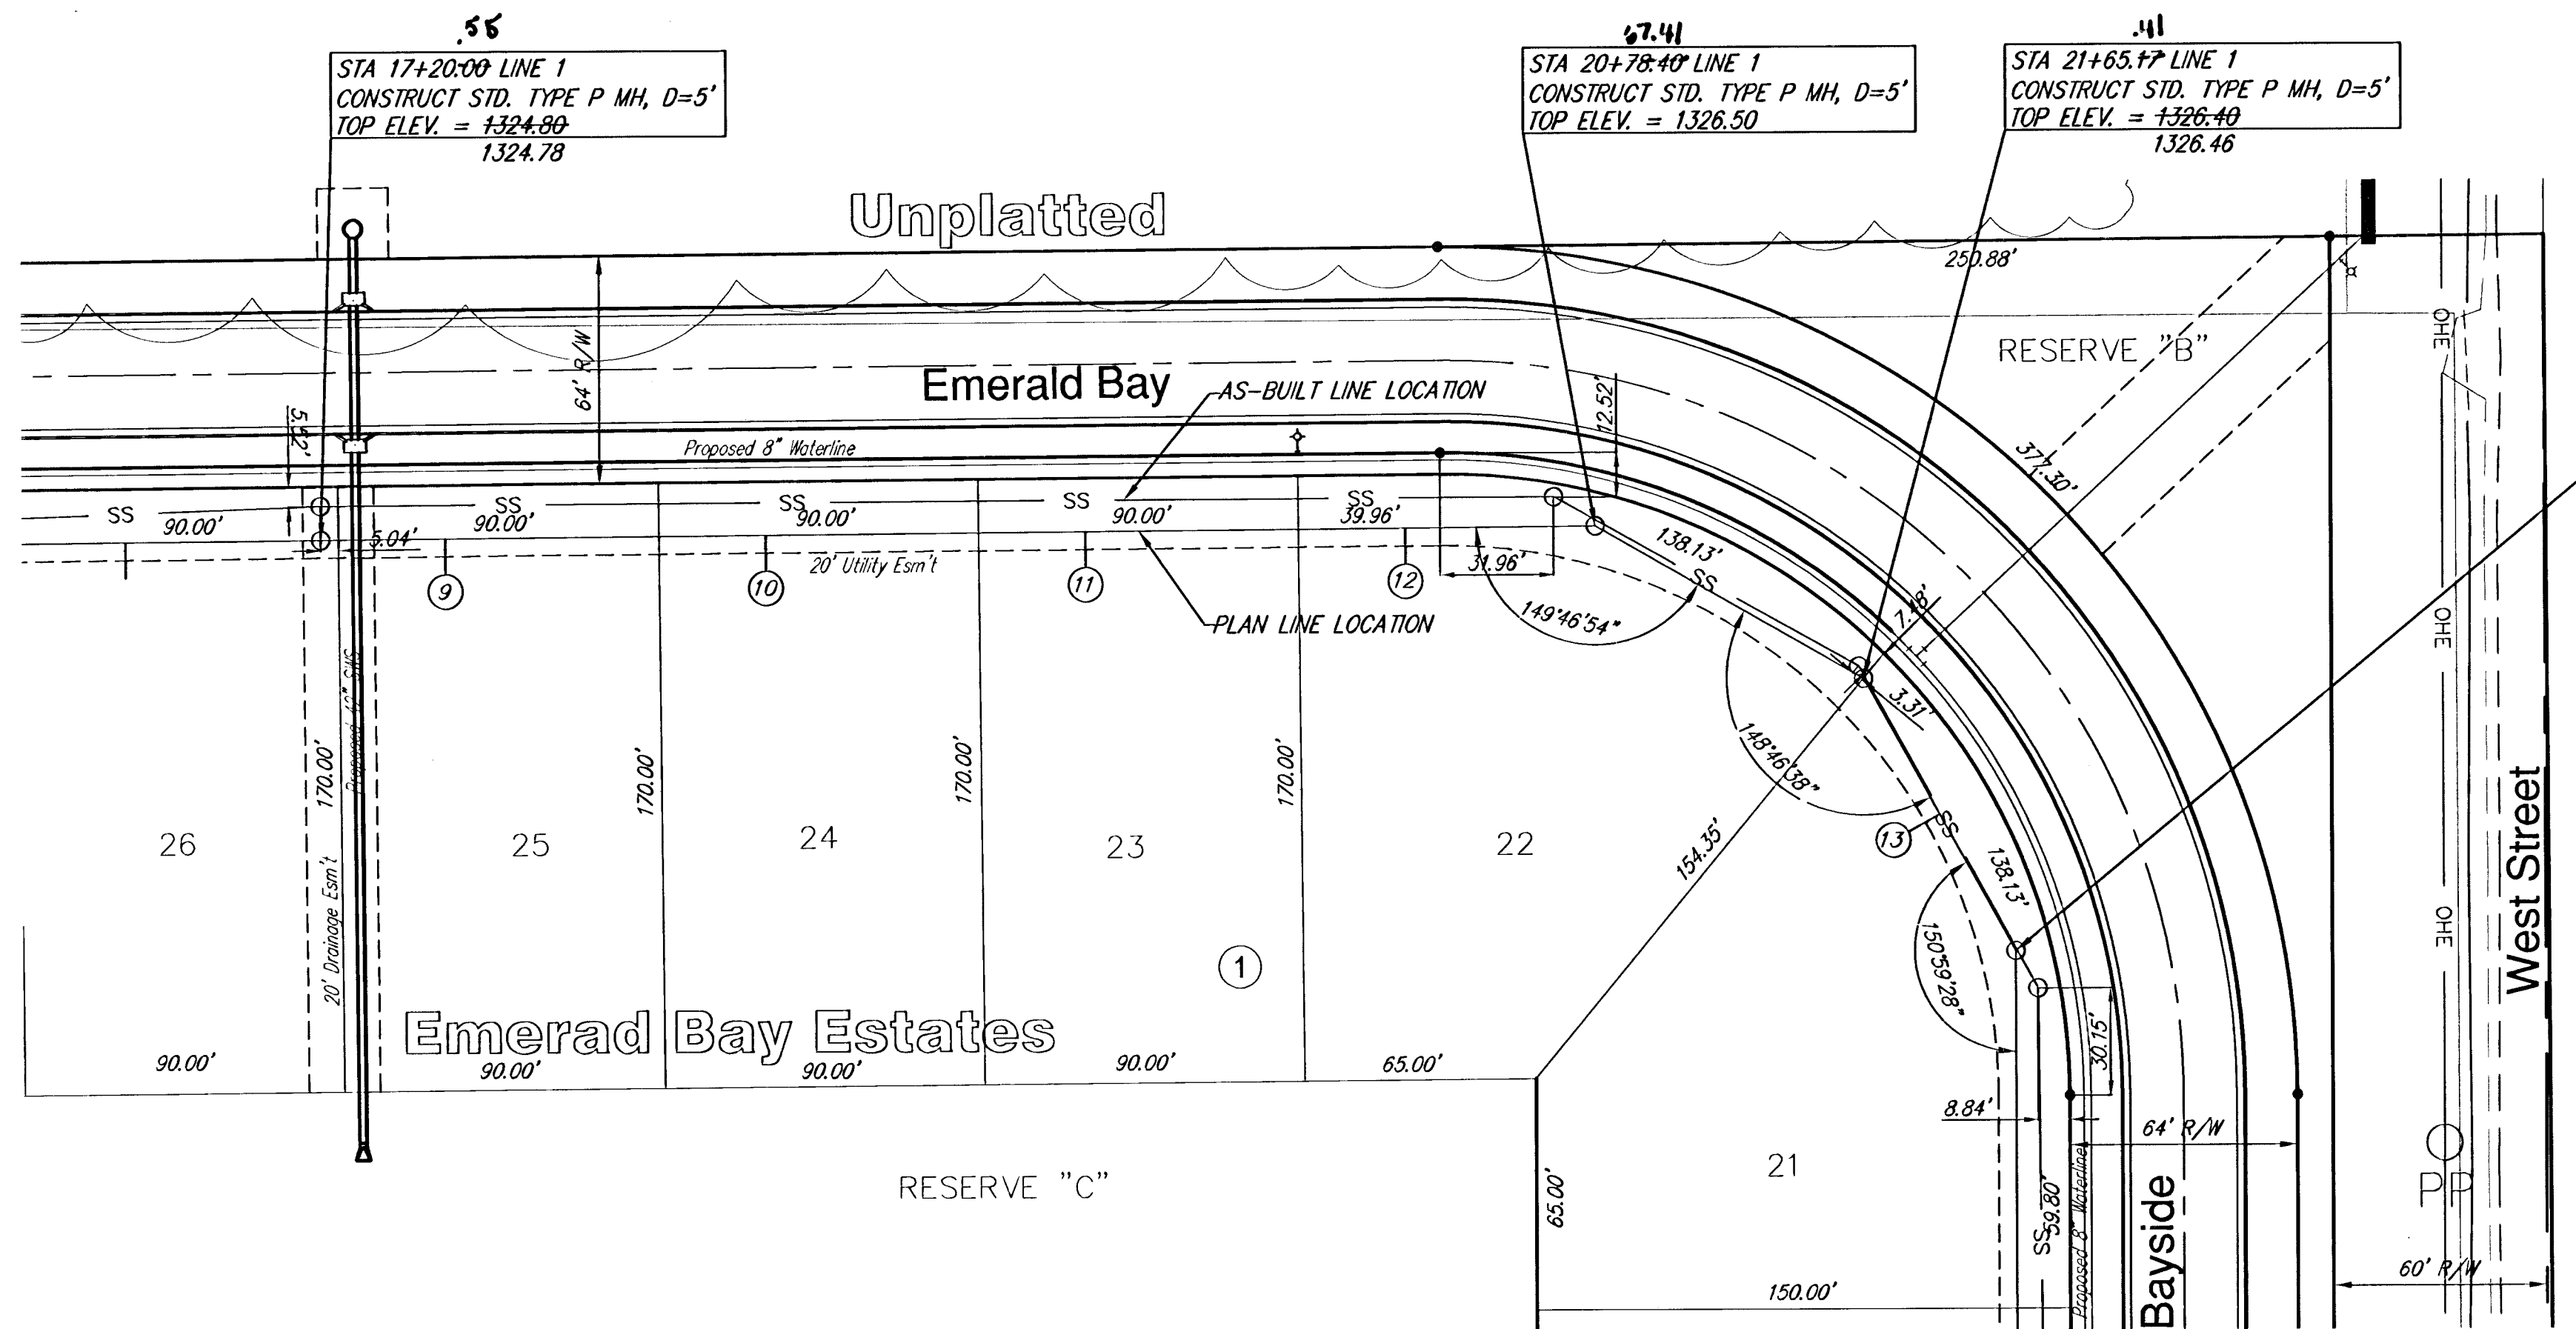

68.13
STA 22+52.80 LINE 1
CONSTRUCT STD. TYPE P MH, D=5'
TOP ELEV. = 1325.80
1325.84

SEWER SERVICE TABLE

NUMBER	TYPE	LOCATION			STATION\ DIRECTION	FOR INFORMATION ONLY	
		LOT NO.	BLOCK NO.	LINE NO.		APPROXIMATE LENGTH 4" PIPE	
9	8" X 4" Tee Saddle	25	1	1	17+58/R	56	16'
10	8" X 4" Tee Saddle	24	1	1	18+48/R	44	19'
11	8" X 4" Tee Saddle	23	1	1	19+35/R	19'	10' 10.5
12	8" X 4" Tee Saddle	22	1	1	20+25/R	210	19'
13	8" X 4" Tee Saddle	21	1	1	22+09/R	13	18'



NOTE: Vertical Riser Pipe shall be extended to 2' minimum above ground water elevation and 4' maximum below proposed ground elevation.

NOTE: ALL BACKFILL FOR SHALL BE SAND FLUSHED AND VIBRATED.



"AS-BUILT"
3-15-07
AML
12-1-11
AML

SCALE 1" = 40' HORIZ.
1" = 5' VERT.
IRON = •

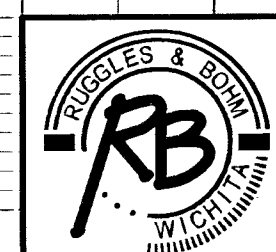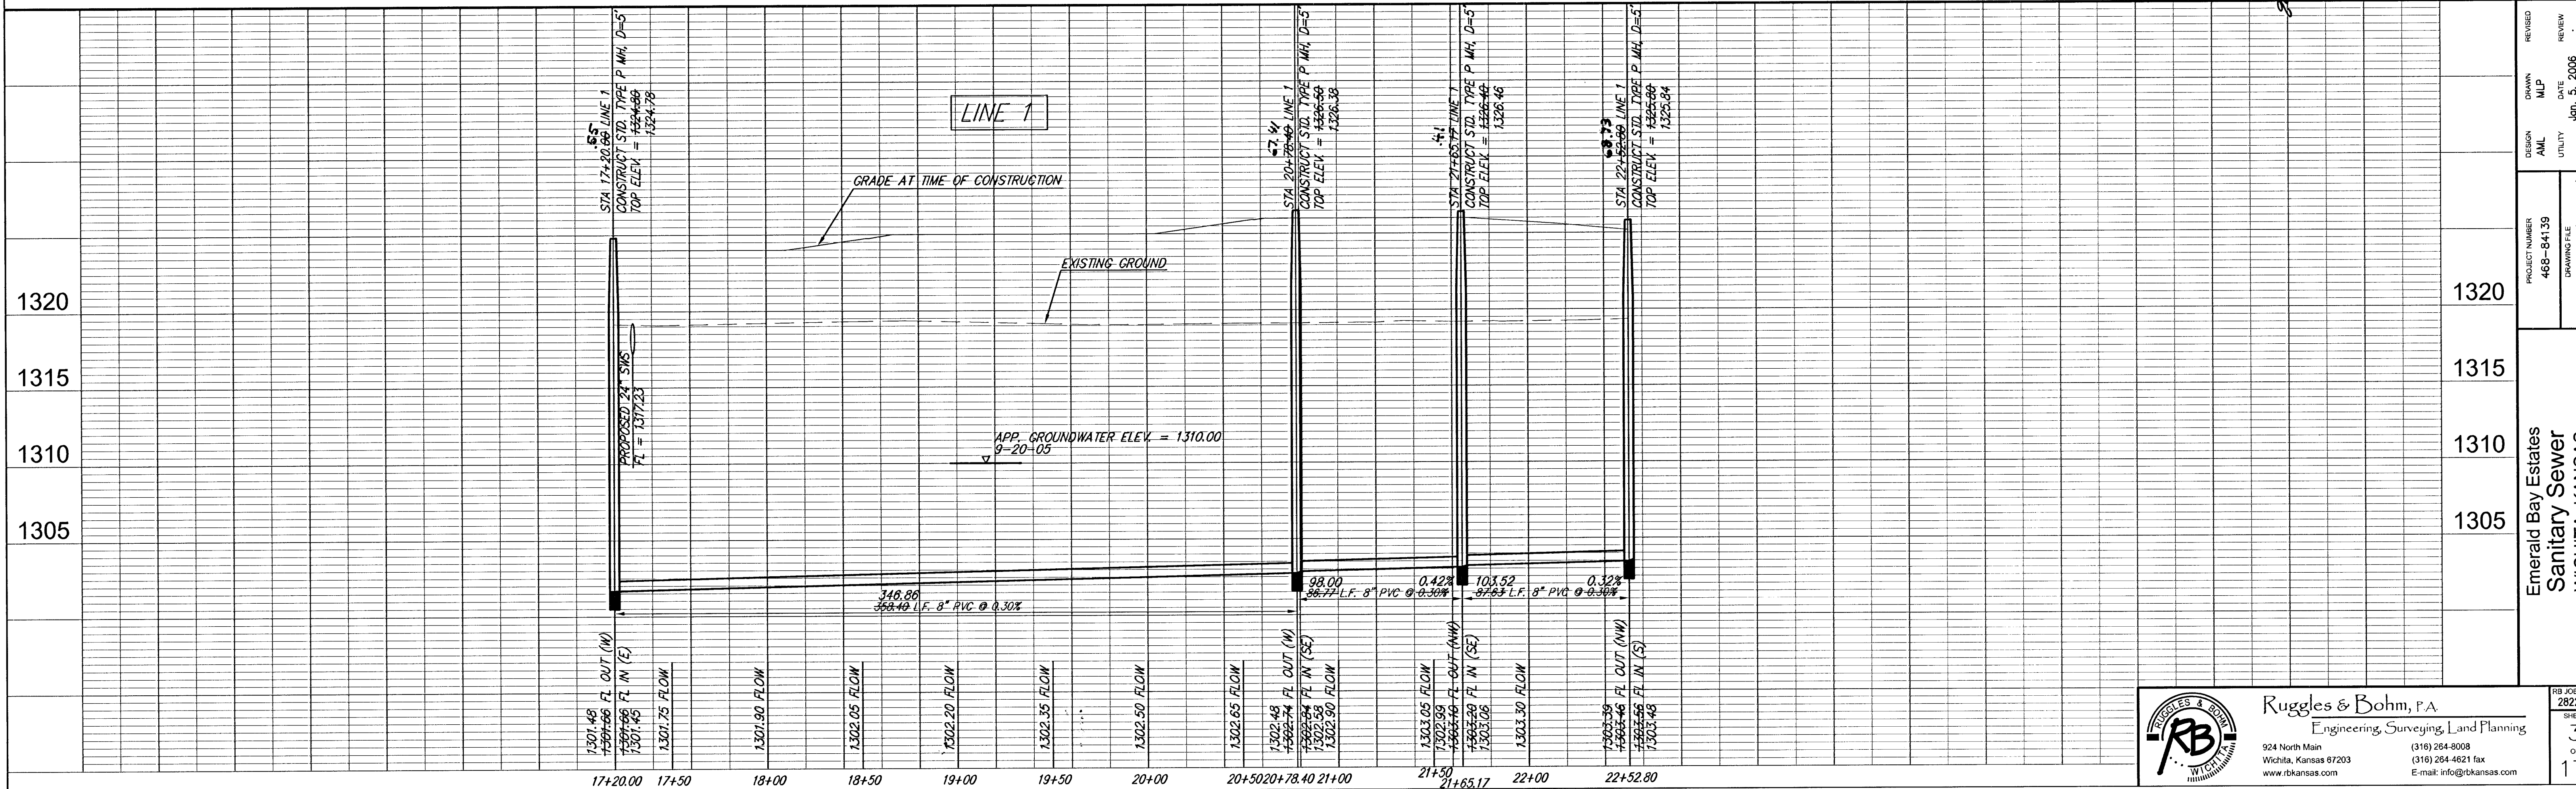

Ruggles & Bohm, P.A.
Engineering, Surveying, Land Planning
924 North Main
Wichita, Kansas 67203
www.rbkansas.com
(316) 264-8008
(316) 264-4621 fax
E-mail: info@rbkansas.com

RB JOB
2822E
3
OF
17

REVISION
DRAWN
MJP
DATE
Jan. 5, 2006
PROJECT NUMBER
468-84139
DRAWING FILE
Sanitary Sewer (LINE 1B)
Emerald Bay Estates
Sanitary Sewer
WICHITA, KANSAS