


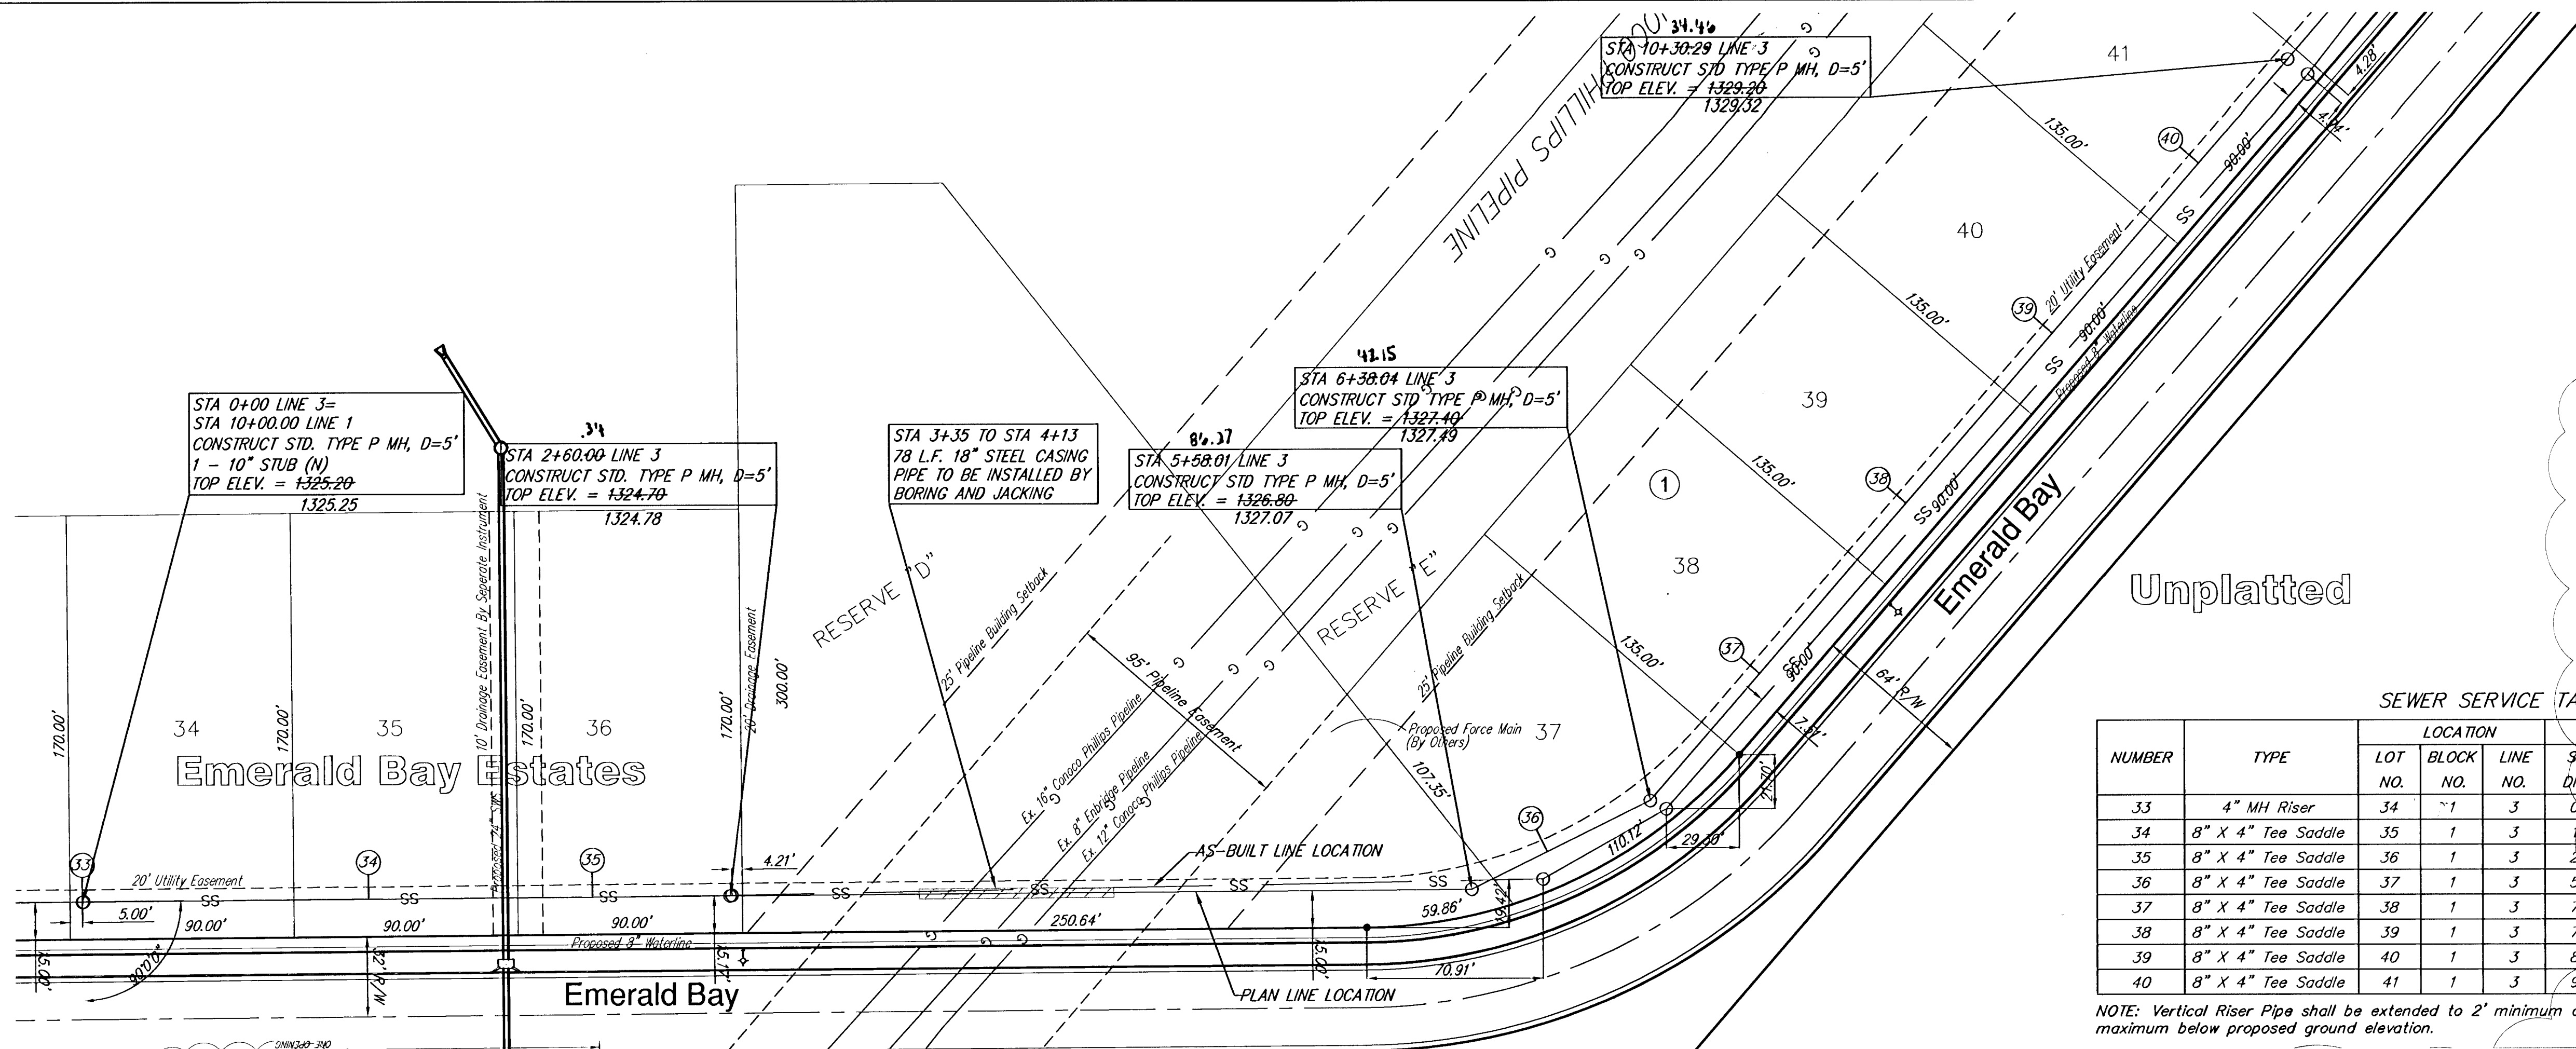

NOTE: ALL BACKFILL FOR SHALL BE SAND FLUSHED AND VIBRATED.

SEWER SERVICE TABLE



NUMBER	TYPE	LOCATION			STATION\ DIRECTION	FOR INFORMATION ONLY	
		LOT NO.	BLOCK NO.	LINE NO.		APPROXIMATE LENGTH 4" PIPE	
33	4" MH Riser	34	1	3	0+00/L	VERTICAL	HORIZONTAL
34	8" X 4" Tee Saddle	35	1	3	1+15/L	21'	10'
35	8" X 4" Tee Saddle	36	1	3	2+05/L	21'	10'
36	8" X 4" Tee Saddle	37	1	3	5+22/L	21'	10'
37	8" X 4" Tee Saddle	38	1	3	7+08/L	21'	10'
38	8" X 4" Tee Saddle	39	1	3	7+98/L	22'	10'
39	8" X 4" Tee Saddle	40	1	3	8+85/L	22'	10'
40	8" X 4" Tee Saddle	41	1	3	9+25/L	22'	10'

NOTE: Vertical Riser Pipe shall be extended to 2' minimum above ground water elevation and 4' maximum below proposed ground elevation.



SCALE 1" = 40' HORIZ.
1" = 5' VERT.
IRON = •

"AS-BUILT"
12-3-07
3-15-07
AML

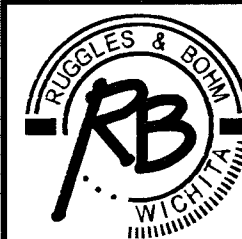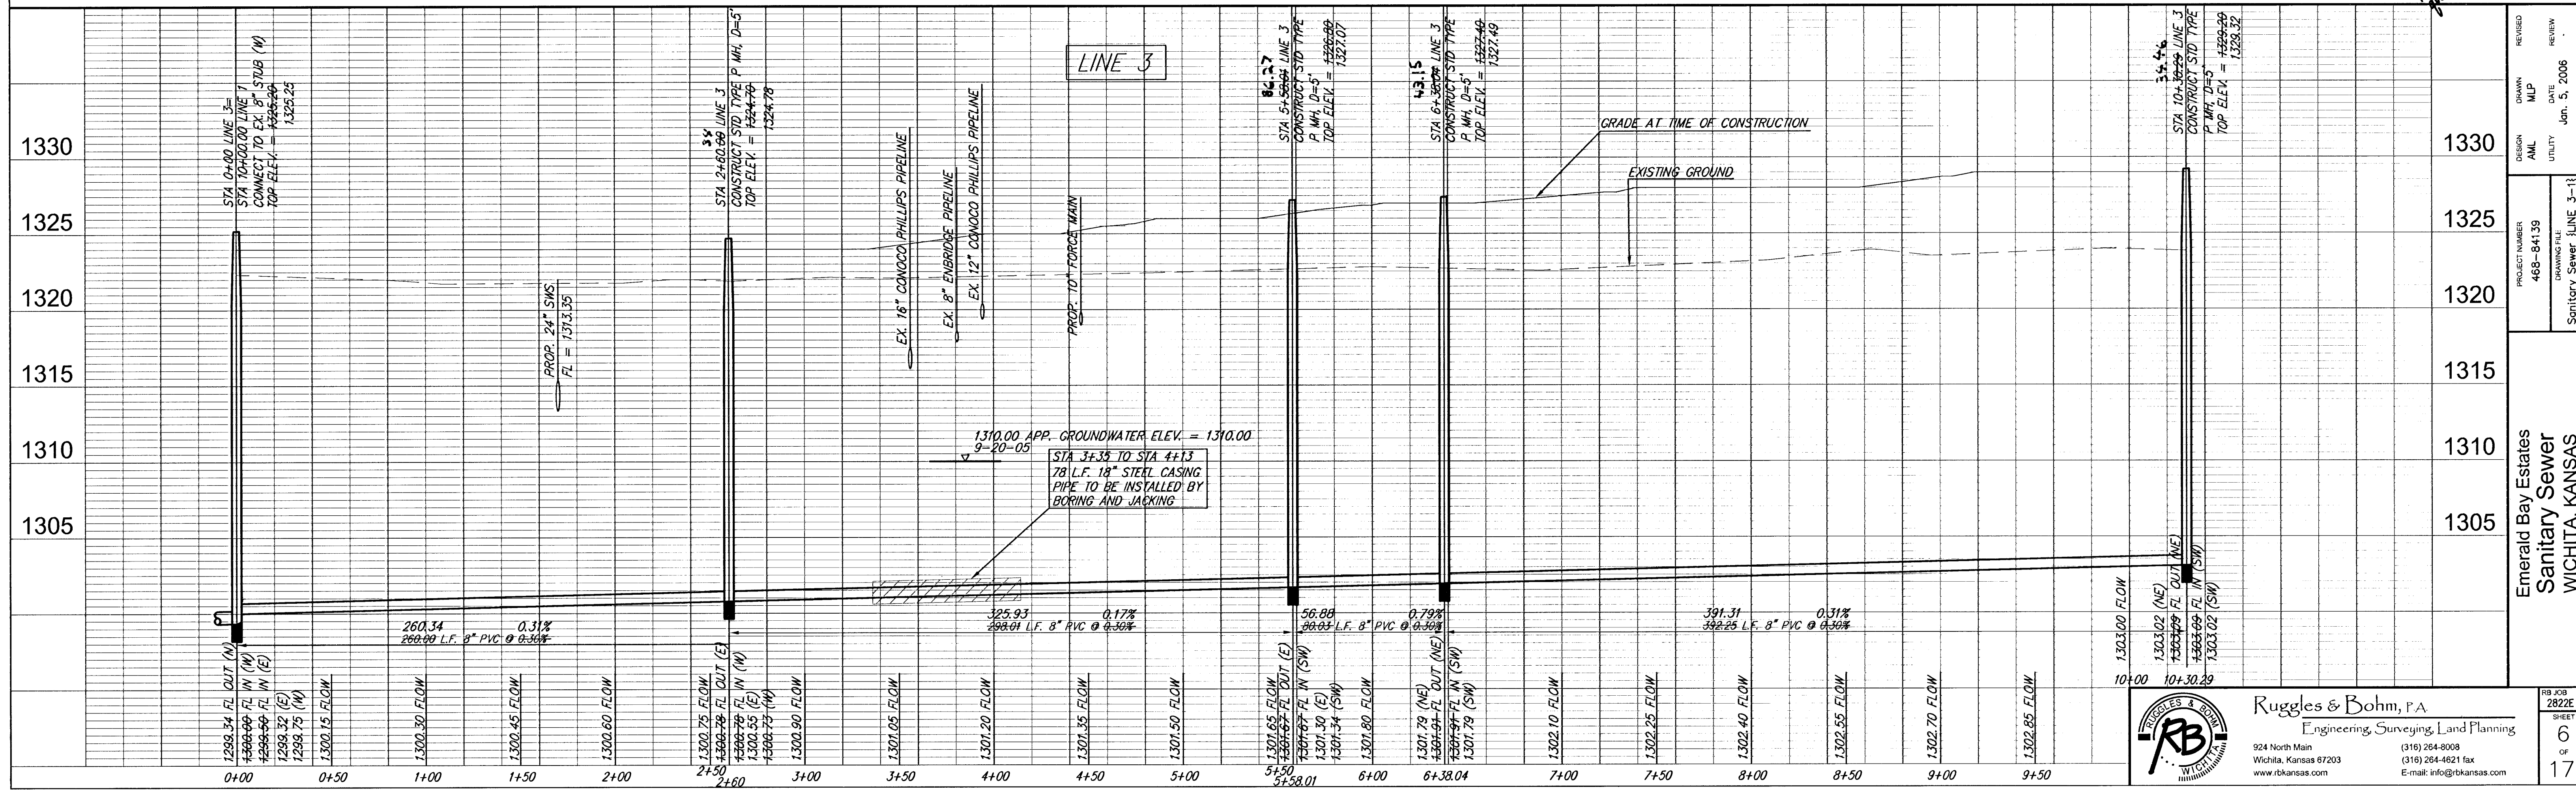

Ruggles & Bohm, P.A.
Engineering, Surveying, Land Planning
924 North Main
Wichita, Kansas 67203
(316) 264-8008
(316) 264-4621 fax
E-mail: info@rbkansas.com

REVIEW	DATE	BY	DATE	BY
REVIEW	Jan. 3, 2008	MLP	3-15-07	AML
DESIGN	468-84139	AML	3-15-07	AML
PROJECT NUMBER	468-84139	UTILITY	Sanitary Sewer	LINE 3-13
EMERALD BAY ESTATES	Sanitary Sewer	WICHITA, KANSAS		