
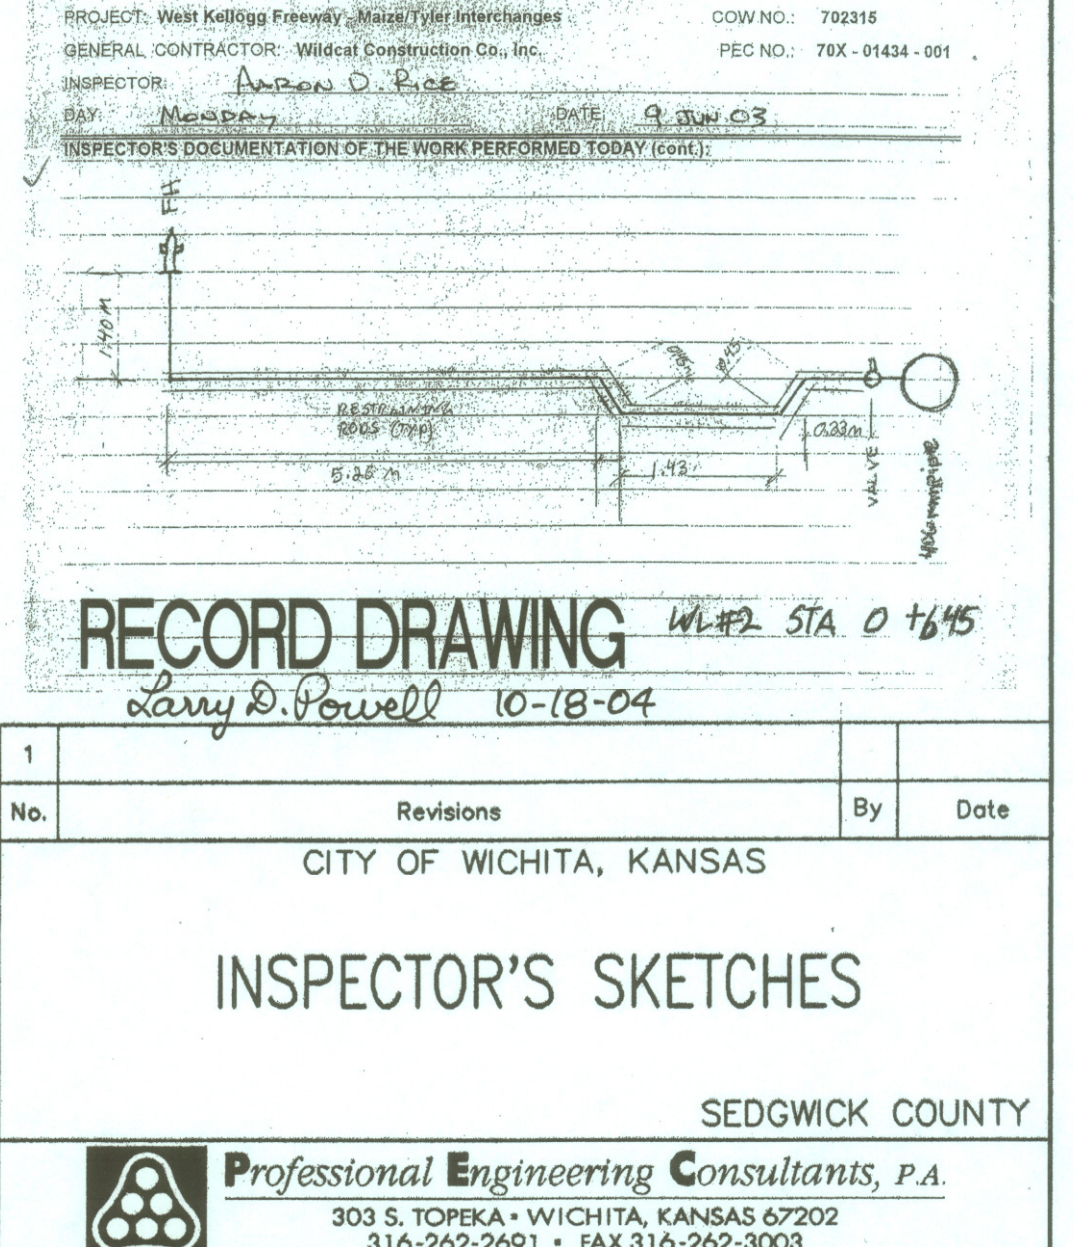
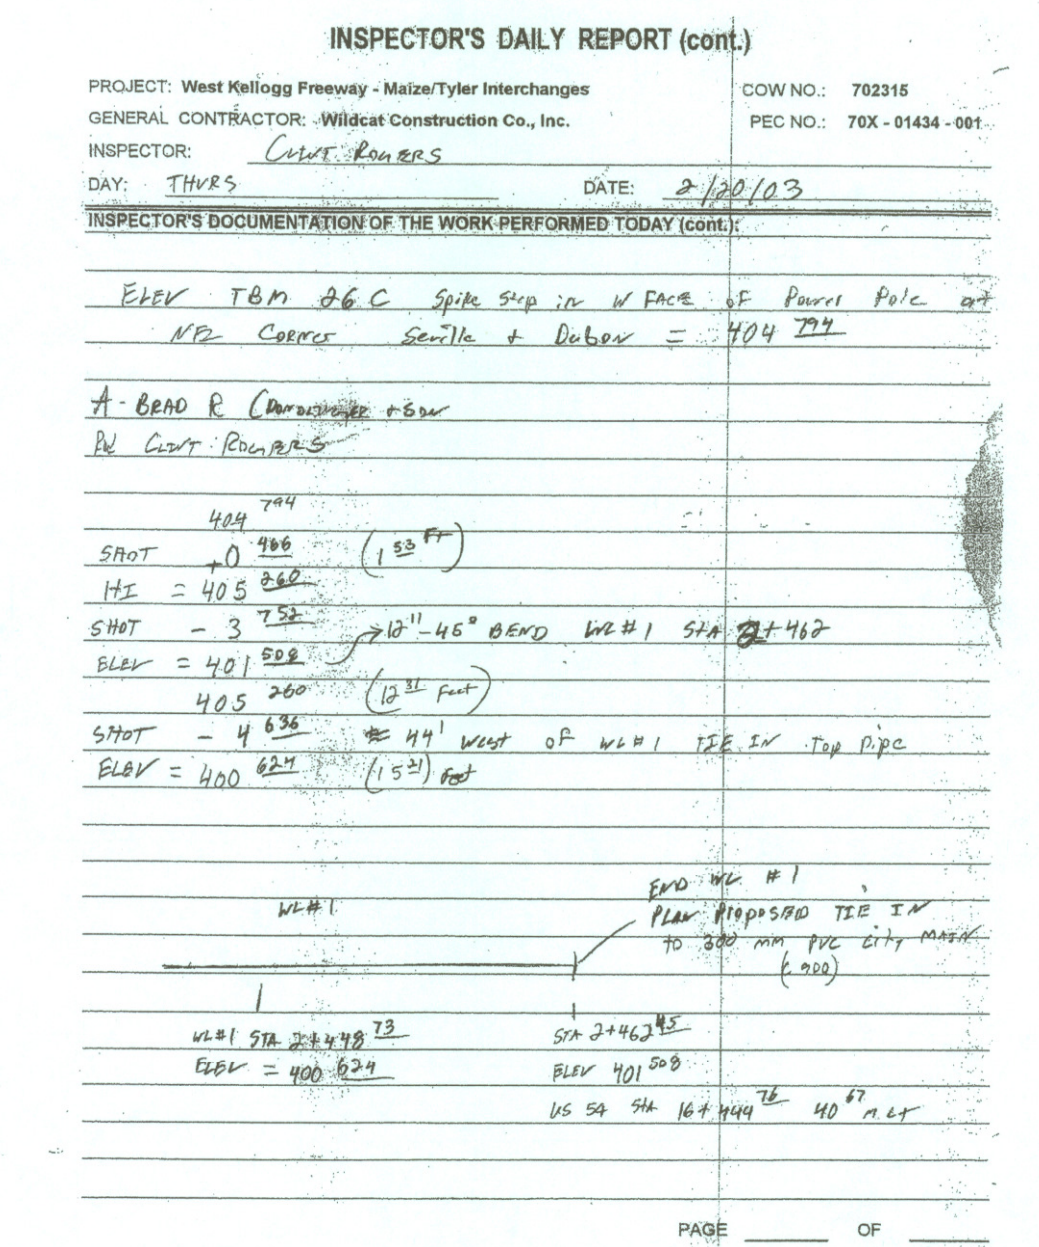
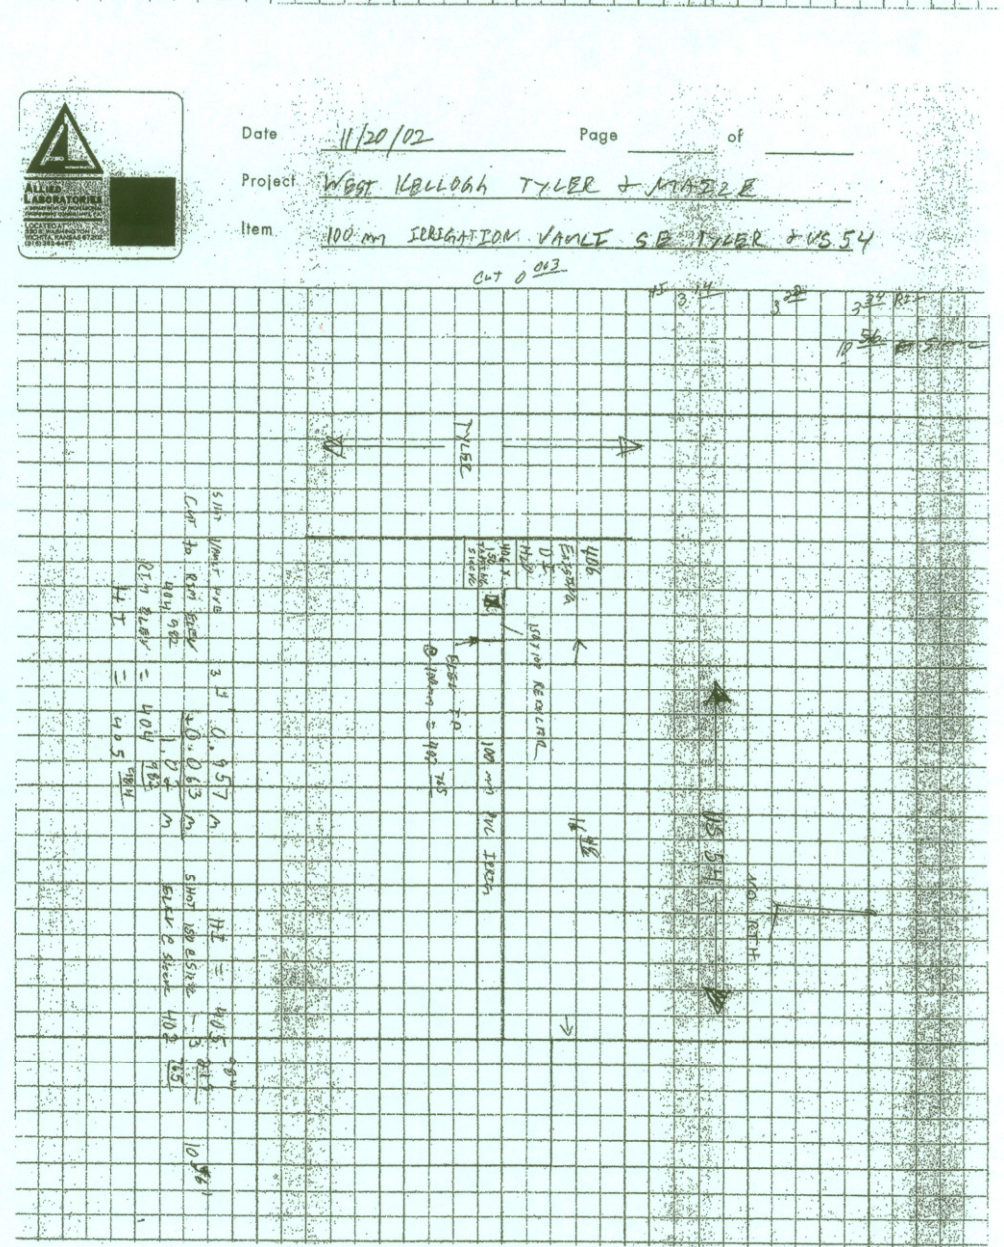
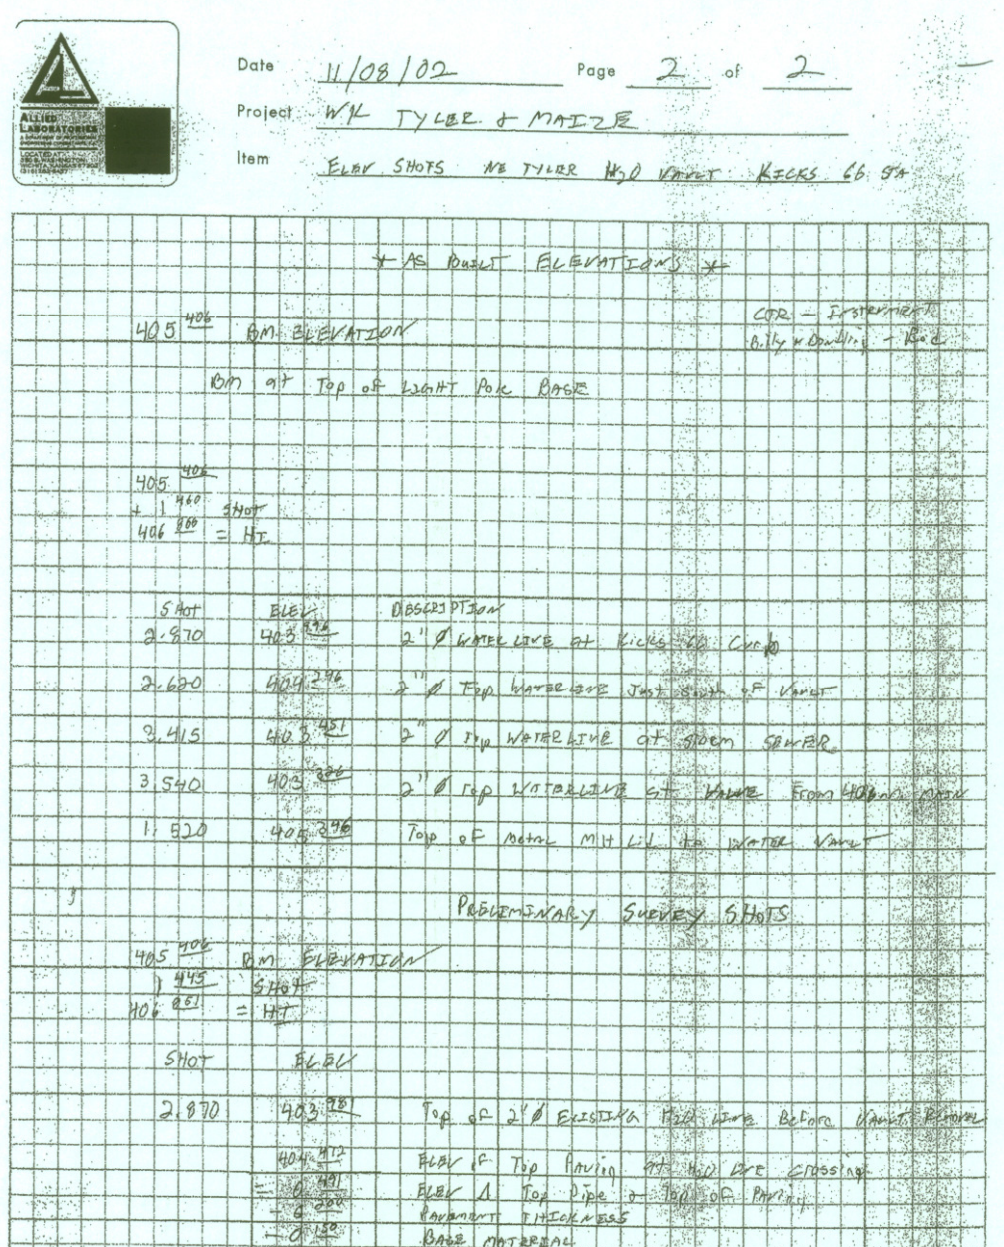
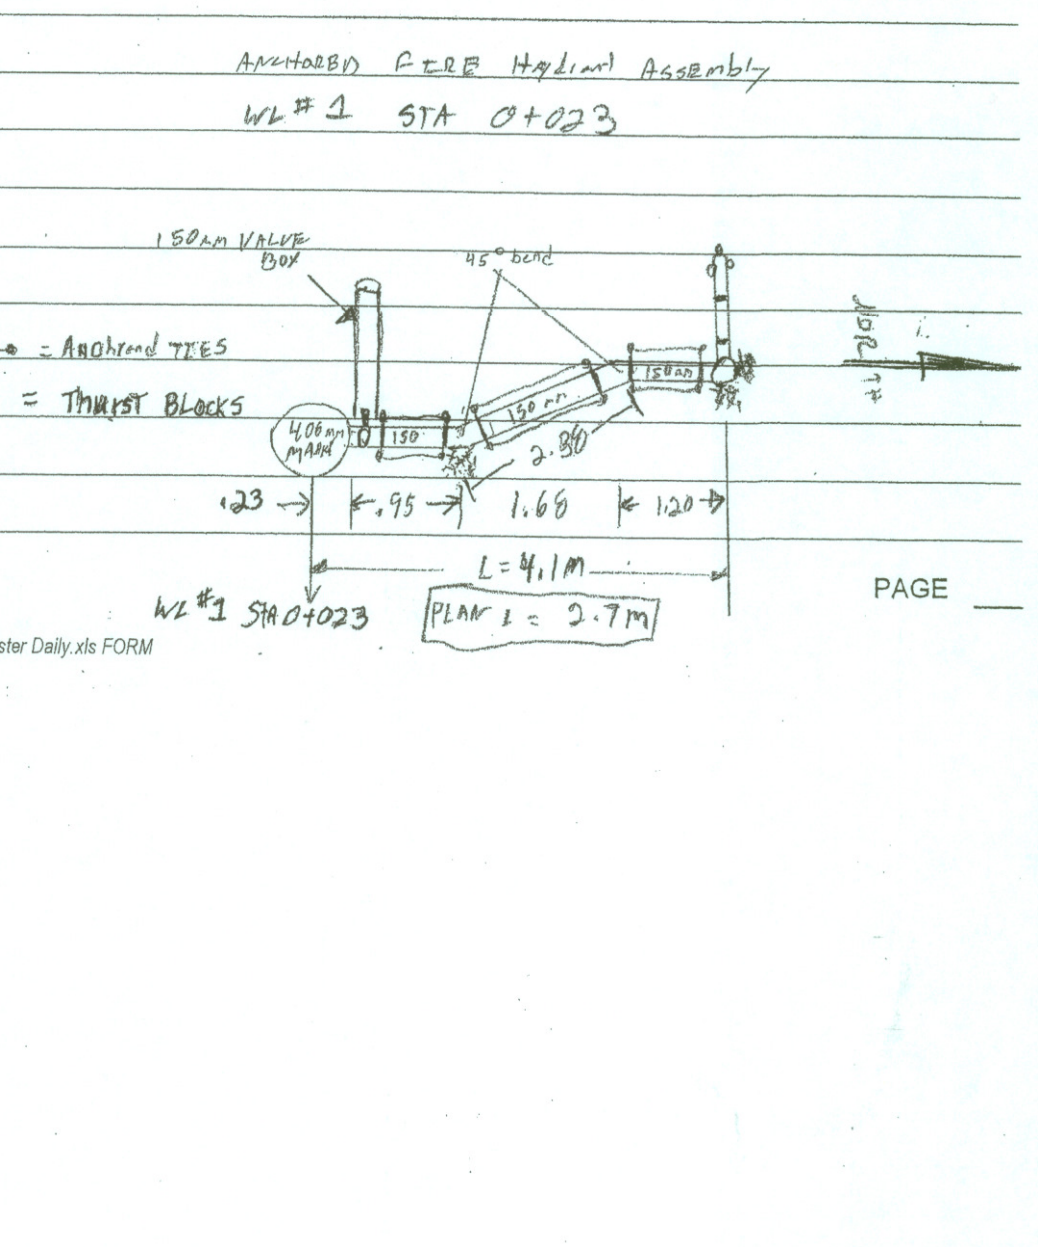
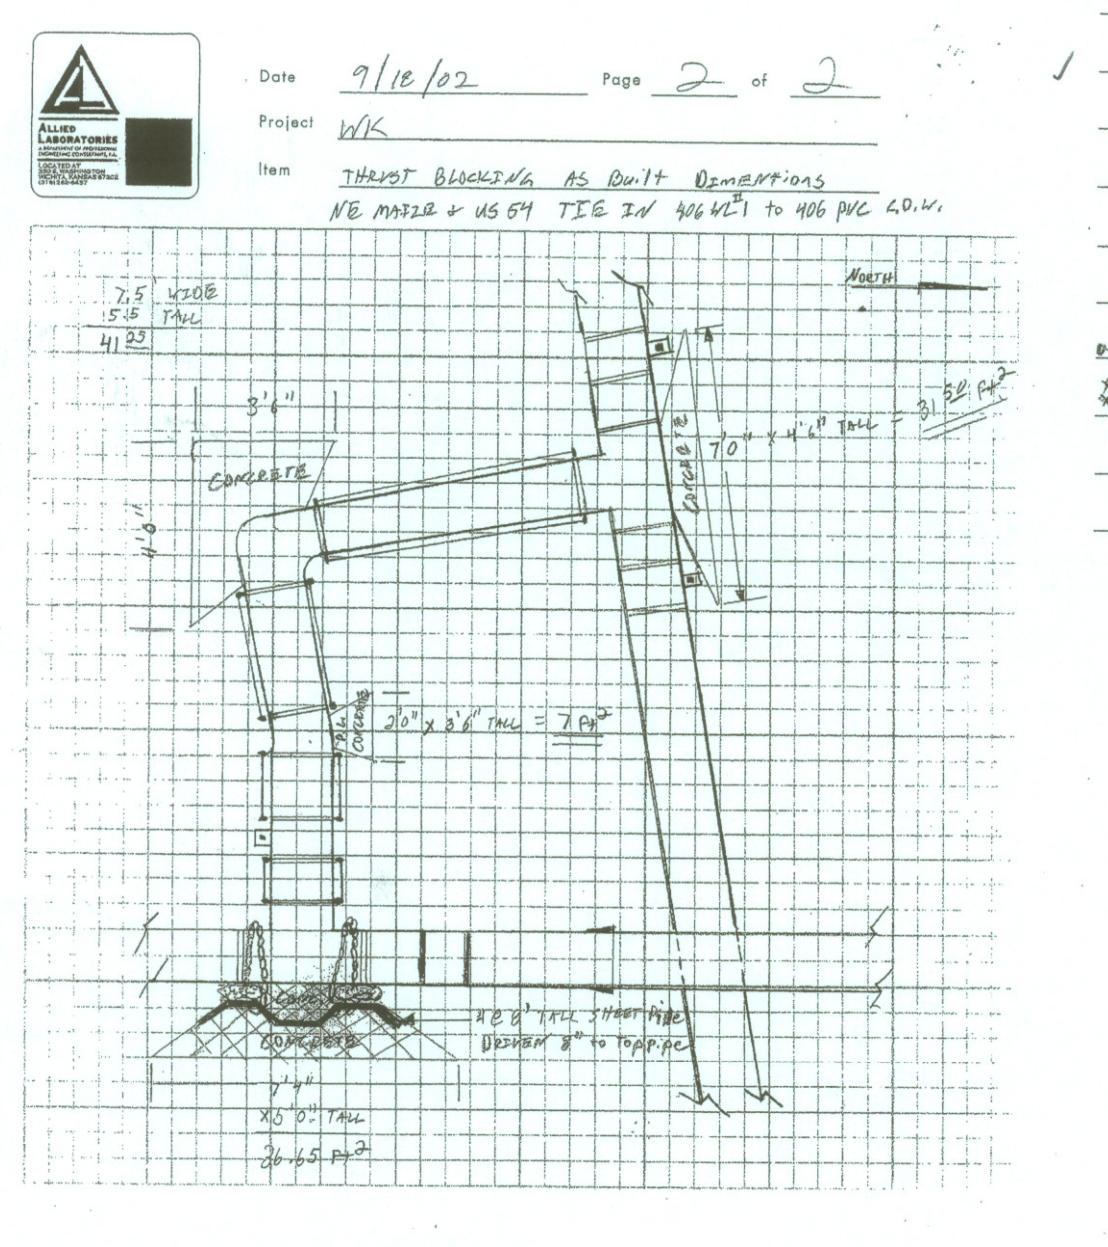
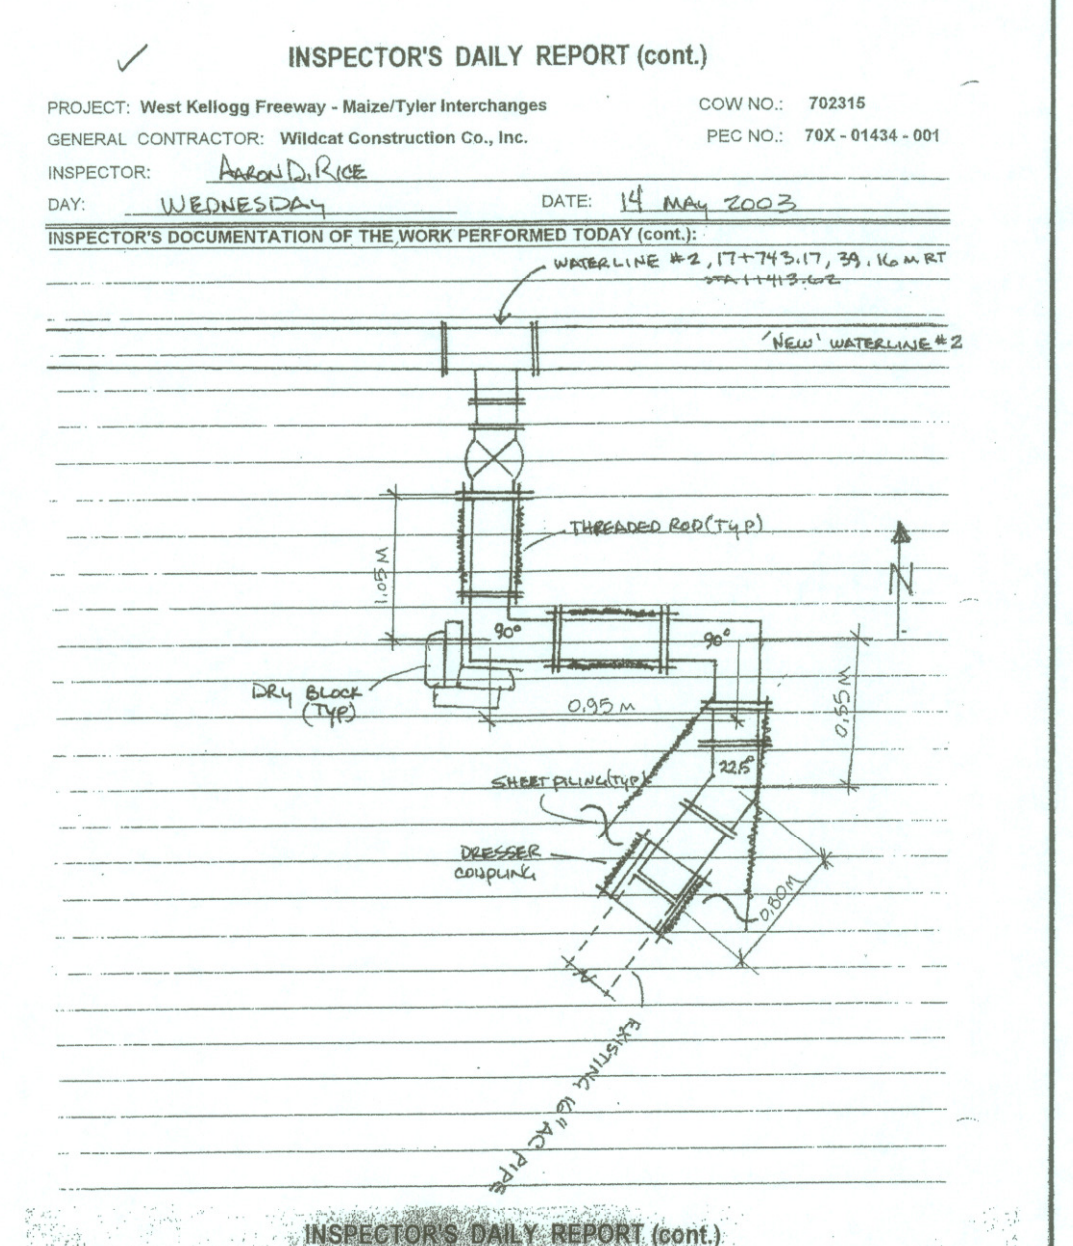
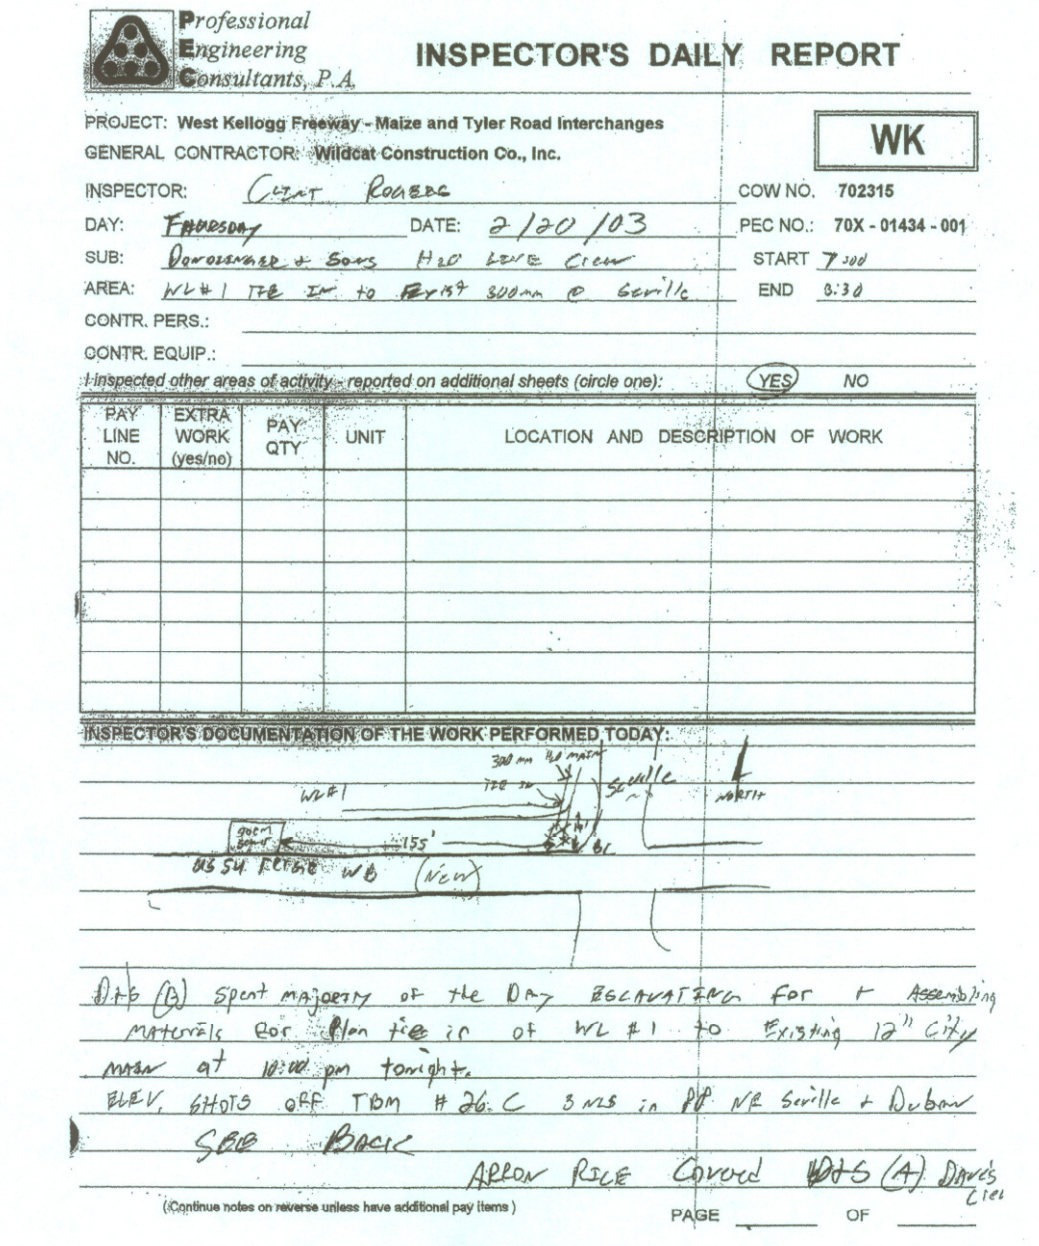
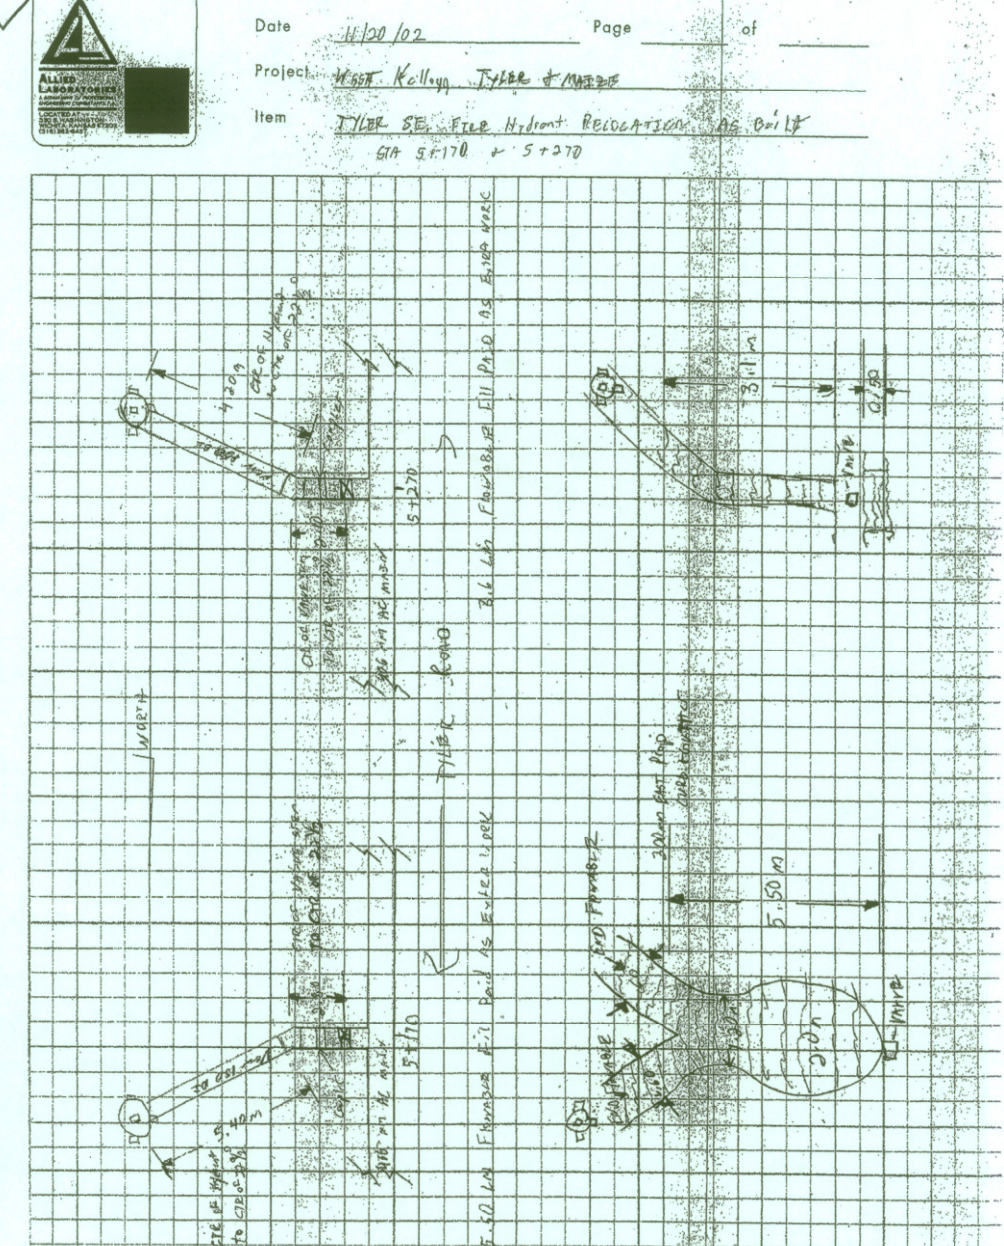
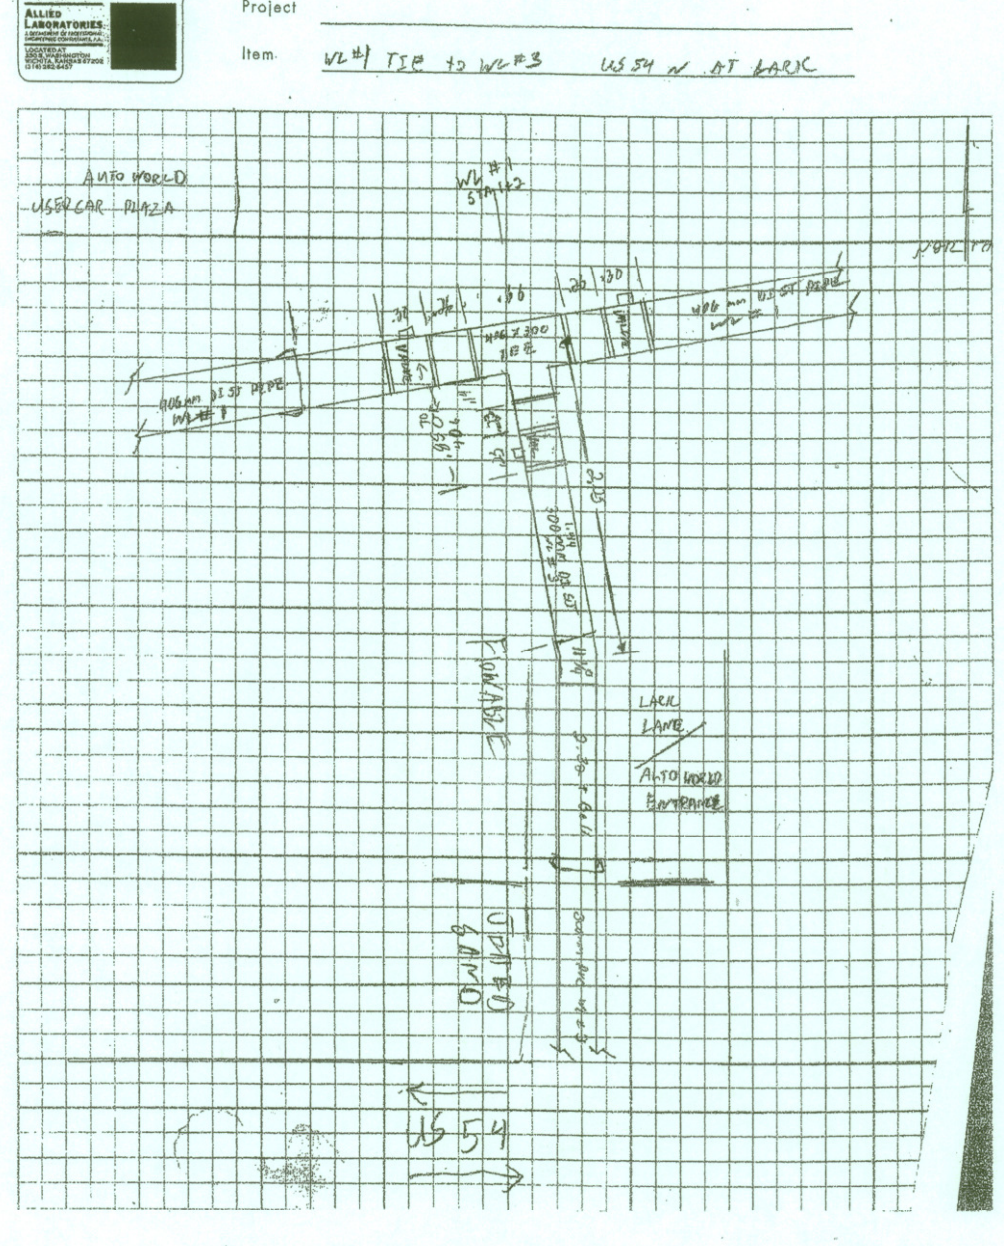
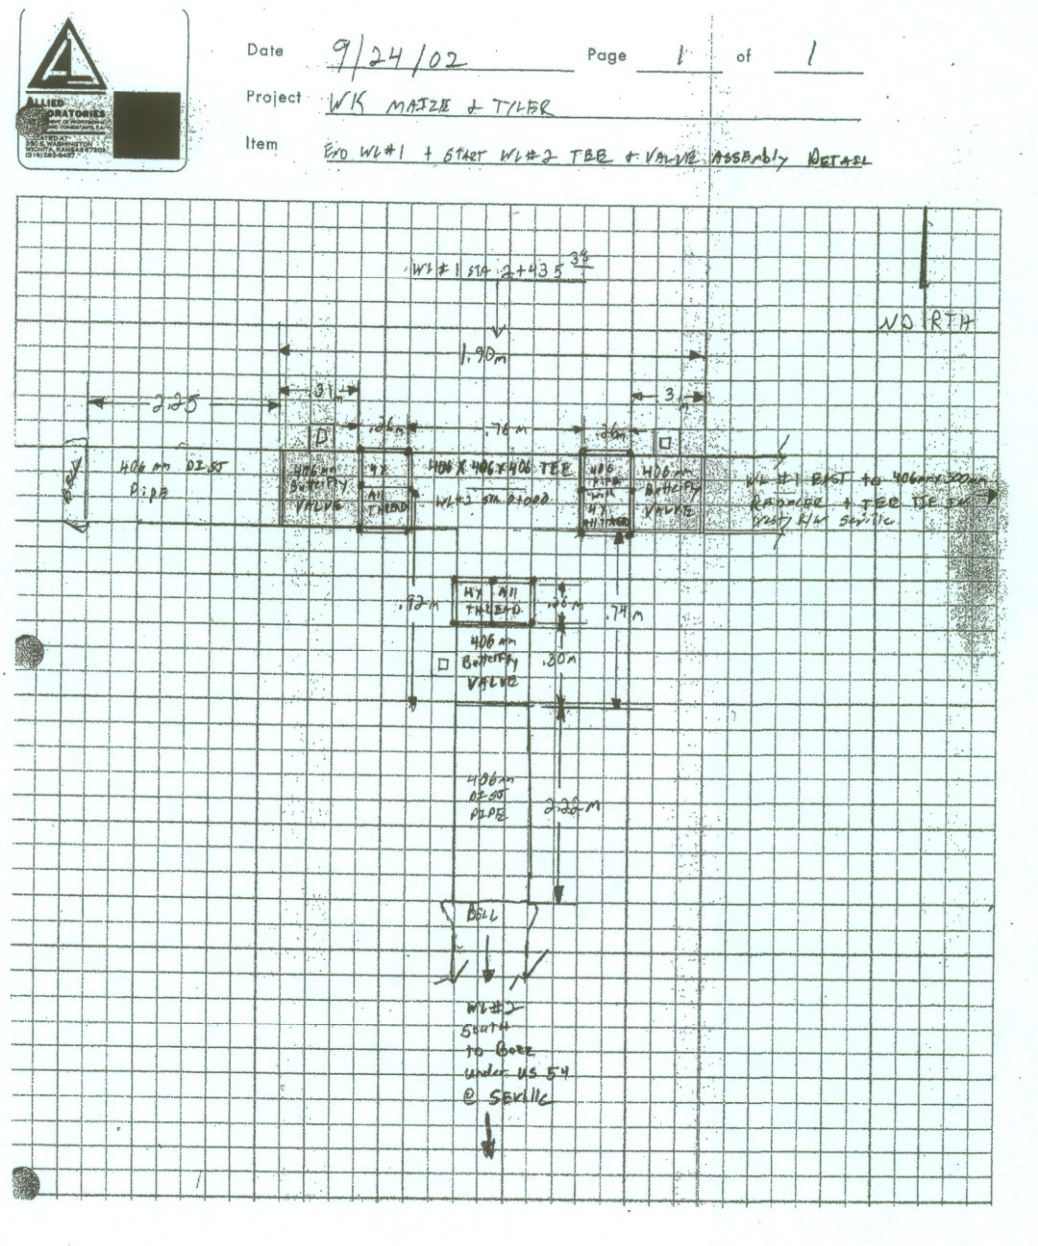
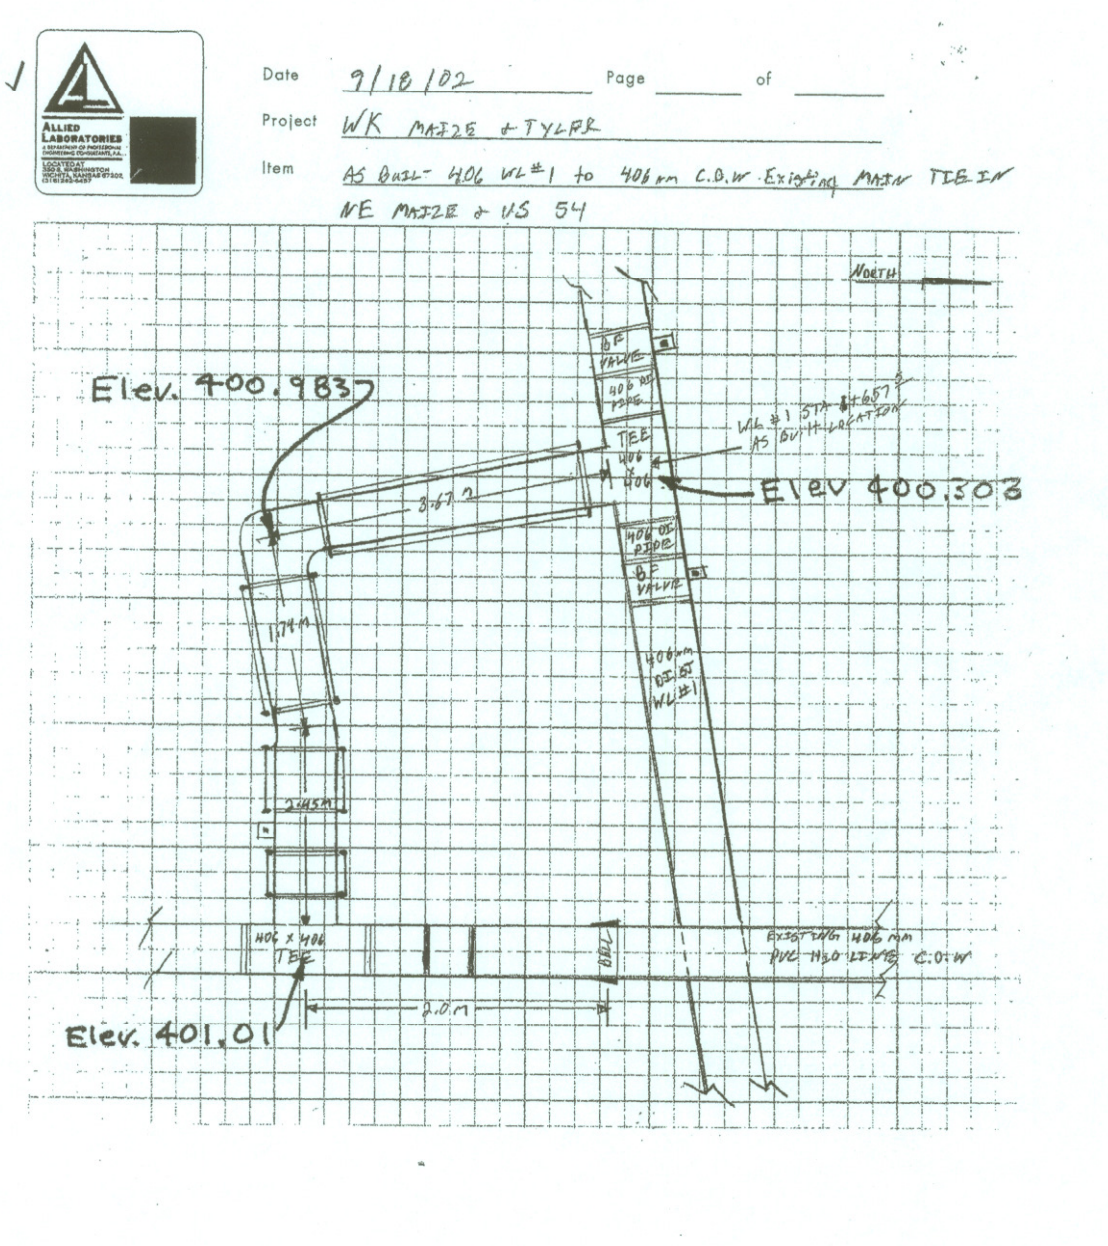
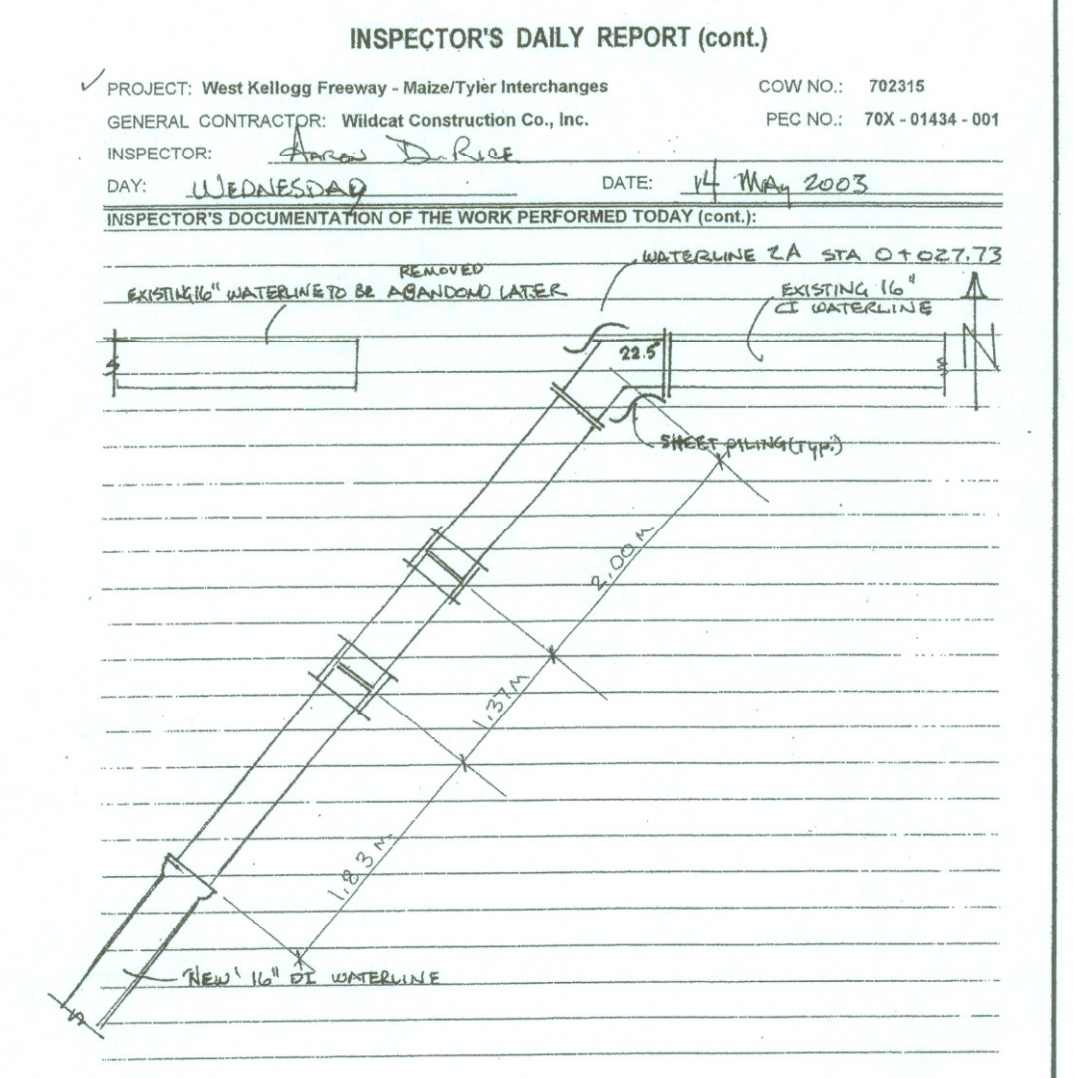
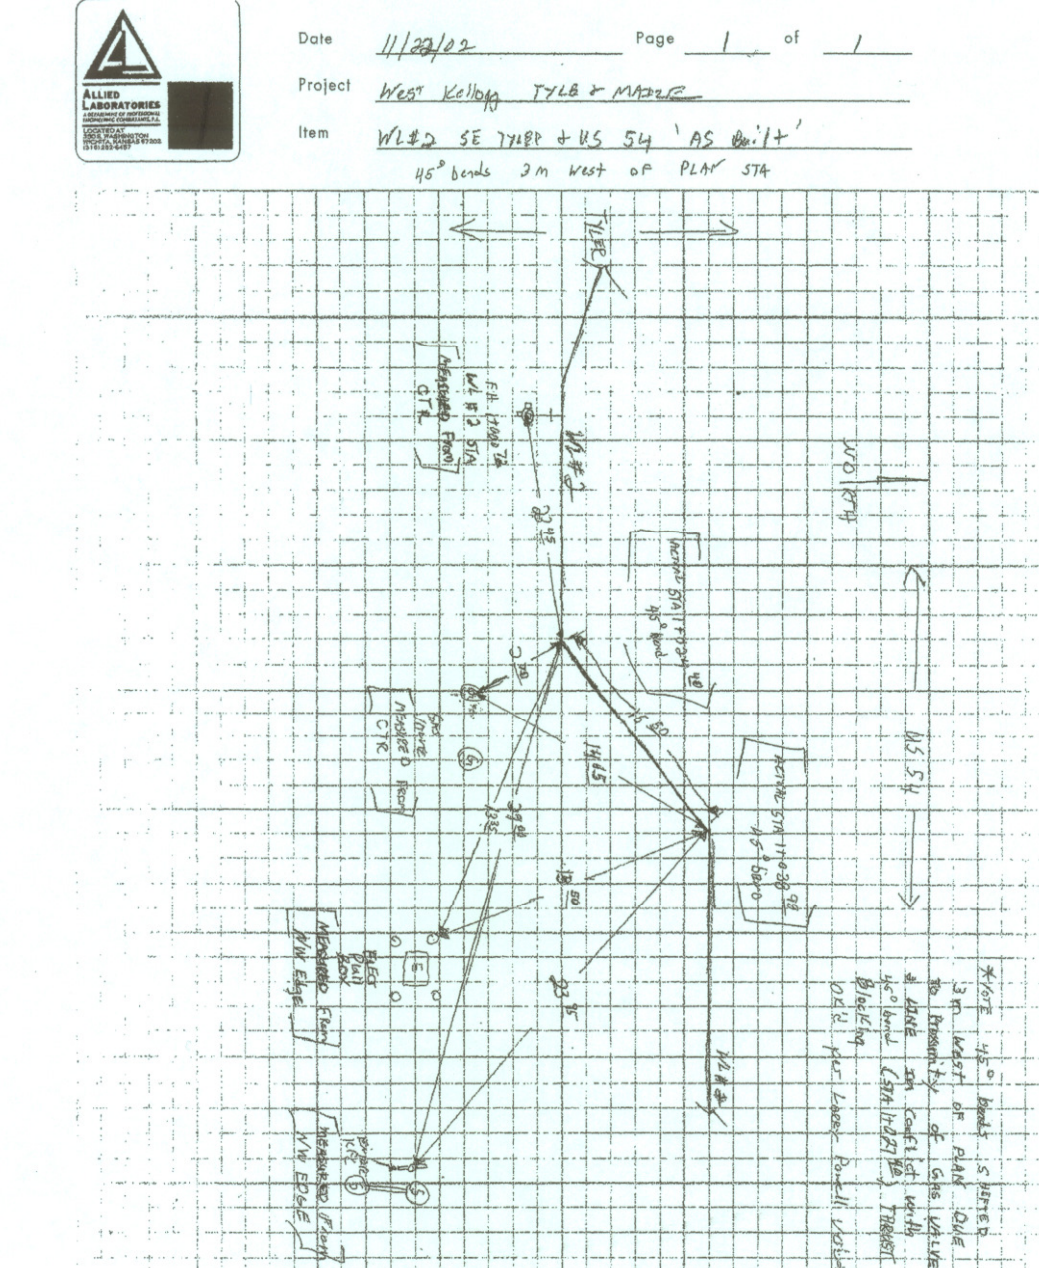
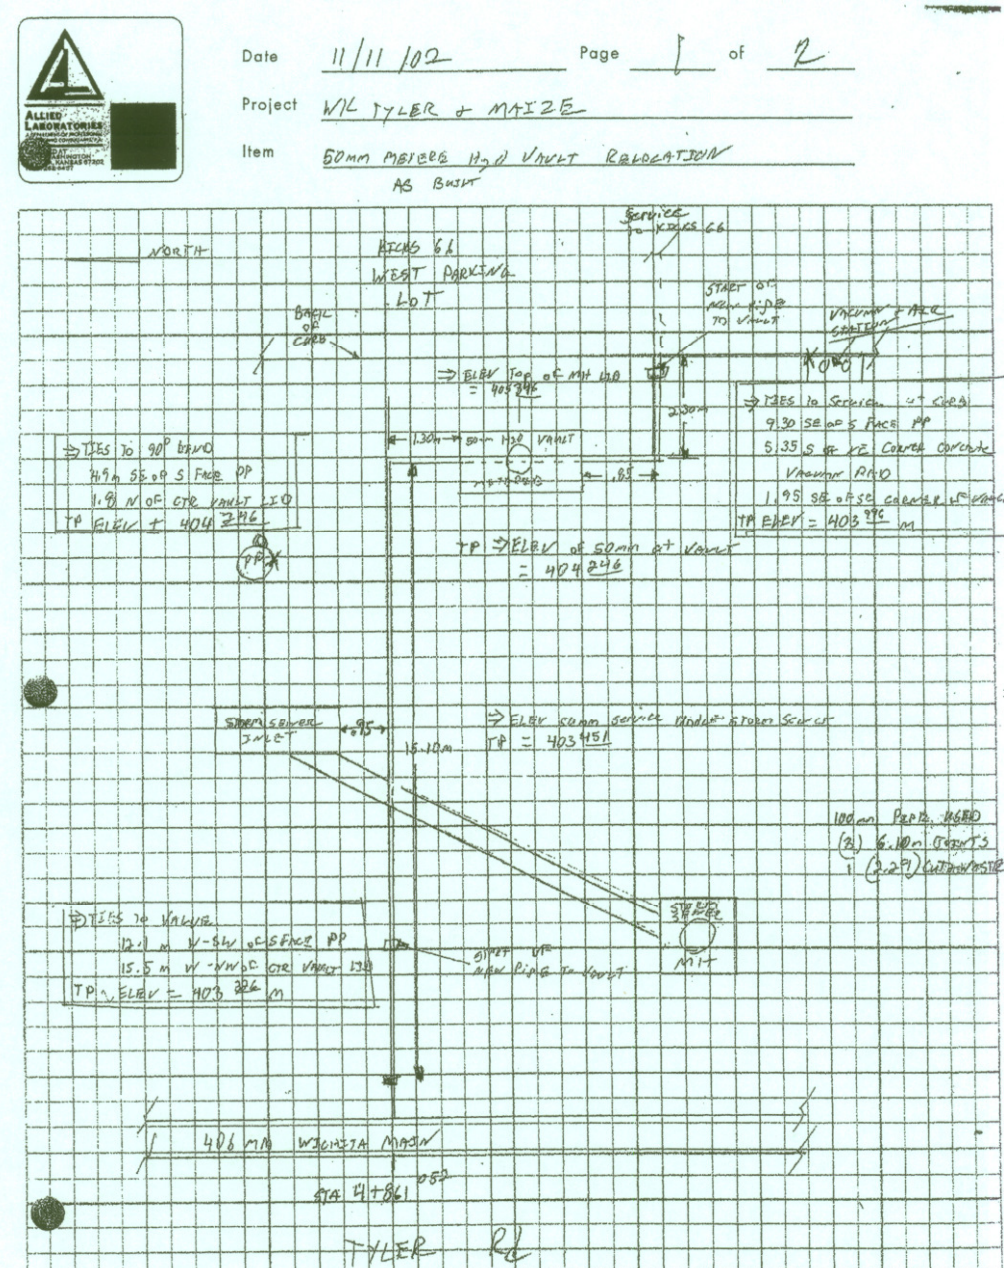
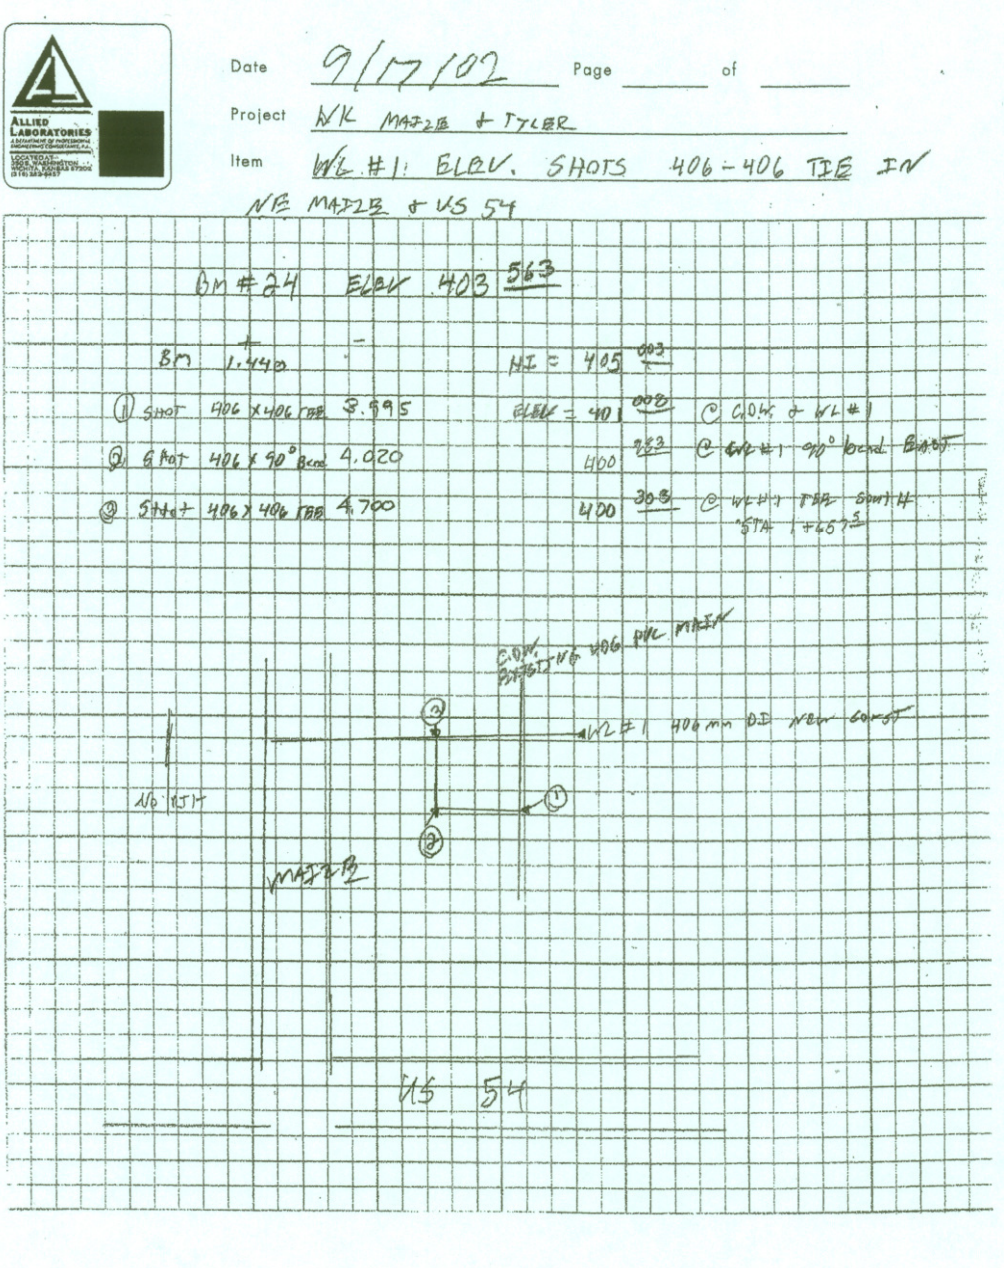
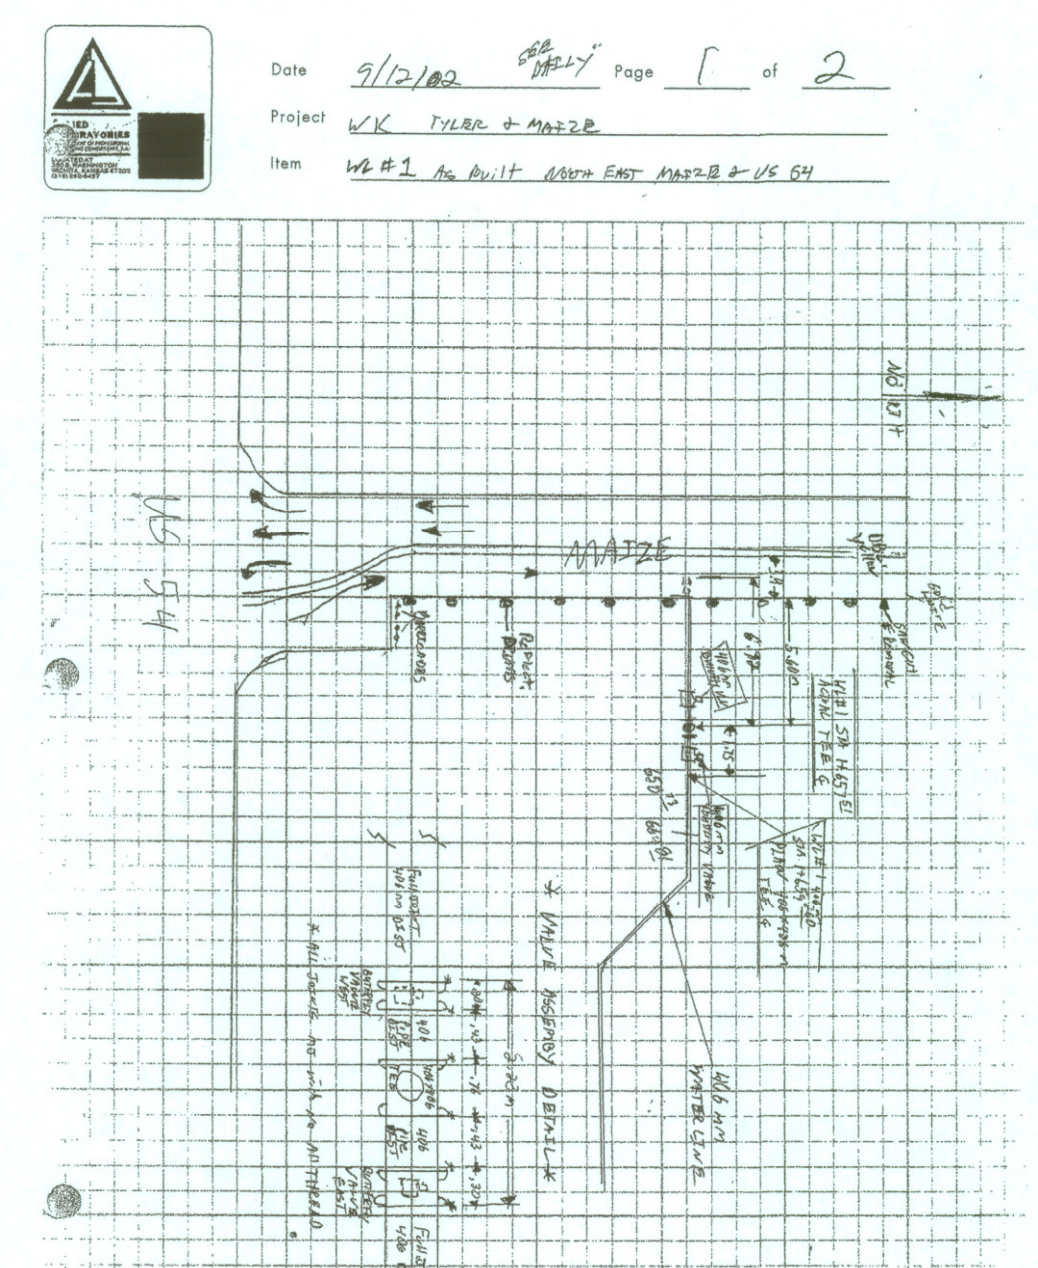


FHWA REGION NO.	STATE	PROJECT NO.	YEAR	SHEET NO.	TOTAL SHEETS
7	KANSAS	54-87 K-6657-01	2004	200A	1122

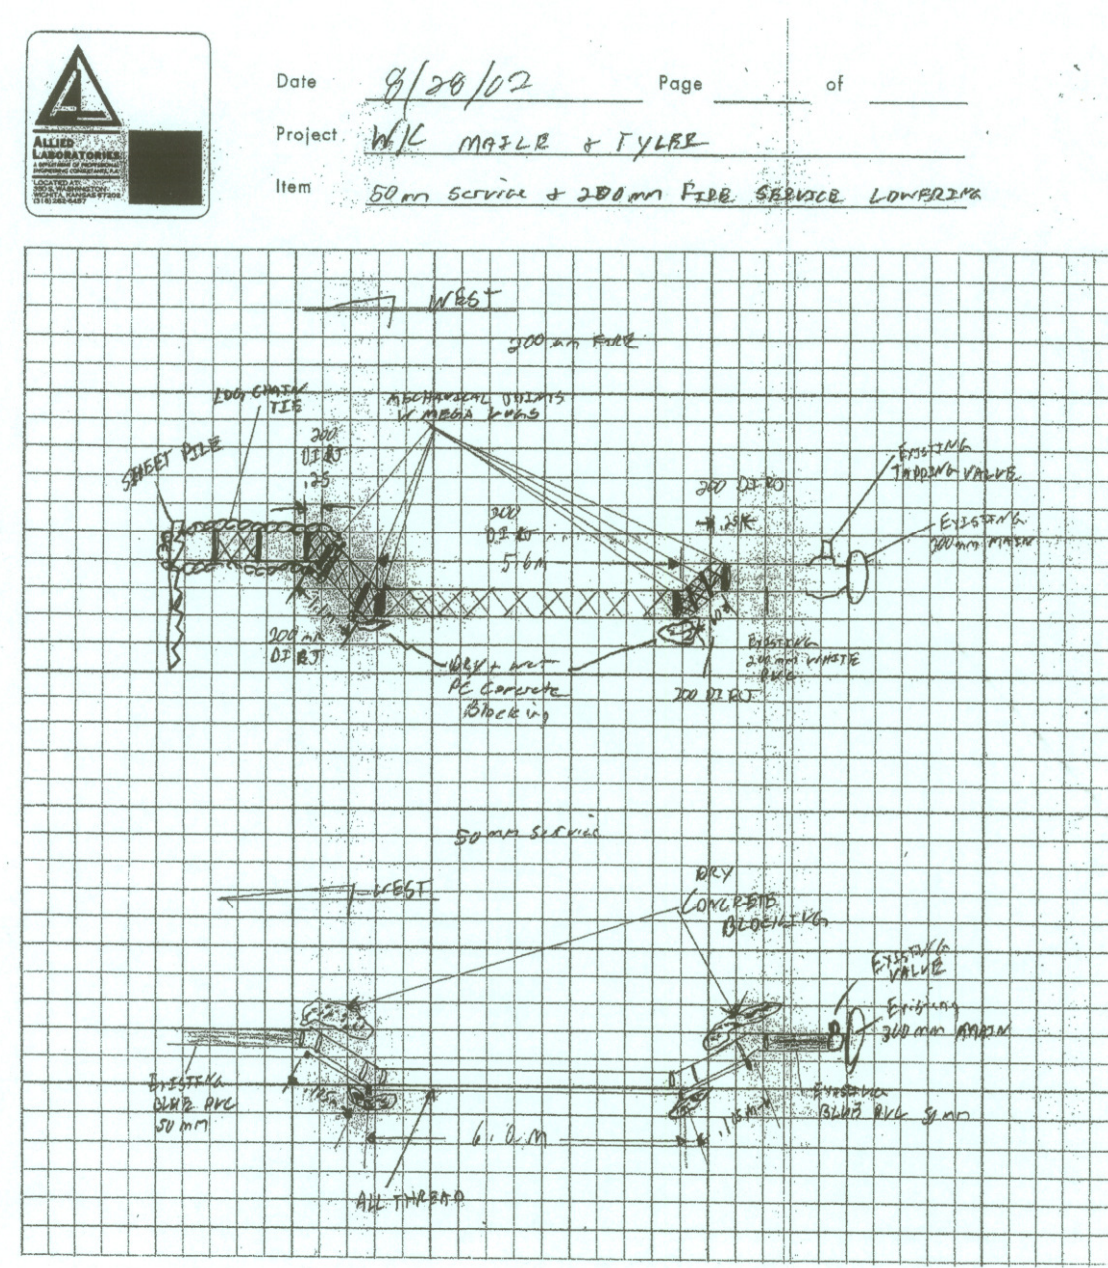

RECORD DRAWING  
 Larry D. Powell 10-18-04

No.	Revisions	By	Date

CITY OF WICHITA, KANSAS  
 SEDGWICK COUNTY  
 Professional Engineering Consultants, P.A.  
 303 S. TOPEKA • WICHITA, KANSAS 67202  
 316-262-2601 • FAX 316-262-3003

Designed by: KJW  
 Drawn by: KJW  
 Checked by: KJW  
 Date: FEBRUARY, 2004  
 Job No.: 97362

DSNR: KJW OPER: TJS SCALE: 1"=1.00  
 C:\1997\97362\007\AsBuilts\InspSketch200A 02-20-2004 01:33:18 pm