


FHWA REGION NO.	STATE	PROJECT NO.	YEAR	SHEET NO.	TOTAL SHEETS
7	KANSAS	54-B7 K-6657-01	2002	56	1122

REFERENCES NOTED	DATE
REFERENCES CHECKED	

DSNR: WDH OPER: JCP SCALE: 1:500
 i:/1997/97362/As-Builts/dgn's/Sh 056-pr174.dgn Last Rev: 8-7-07 By: gdr

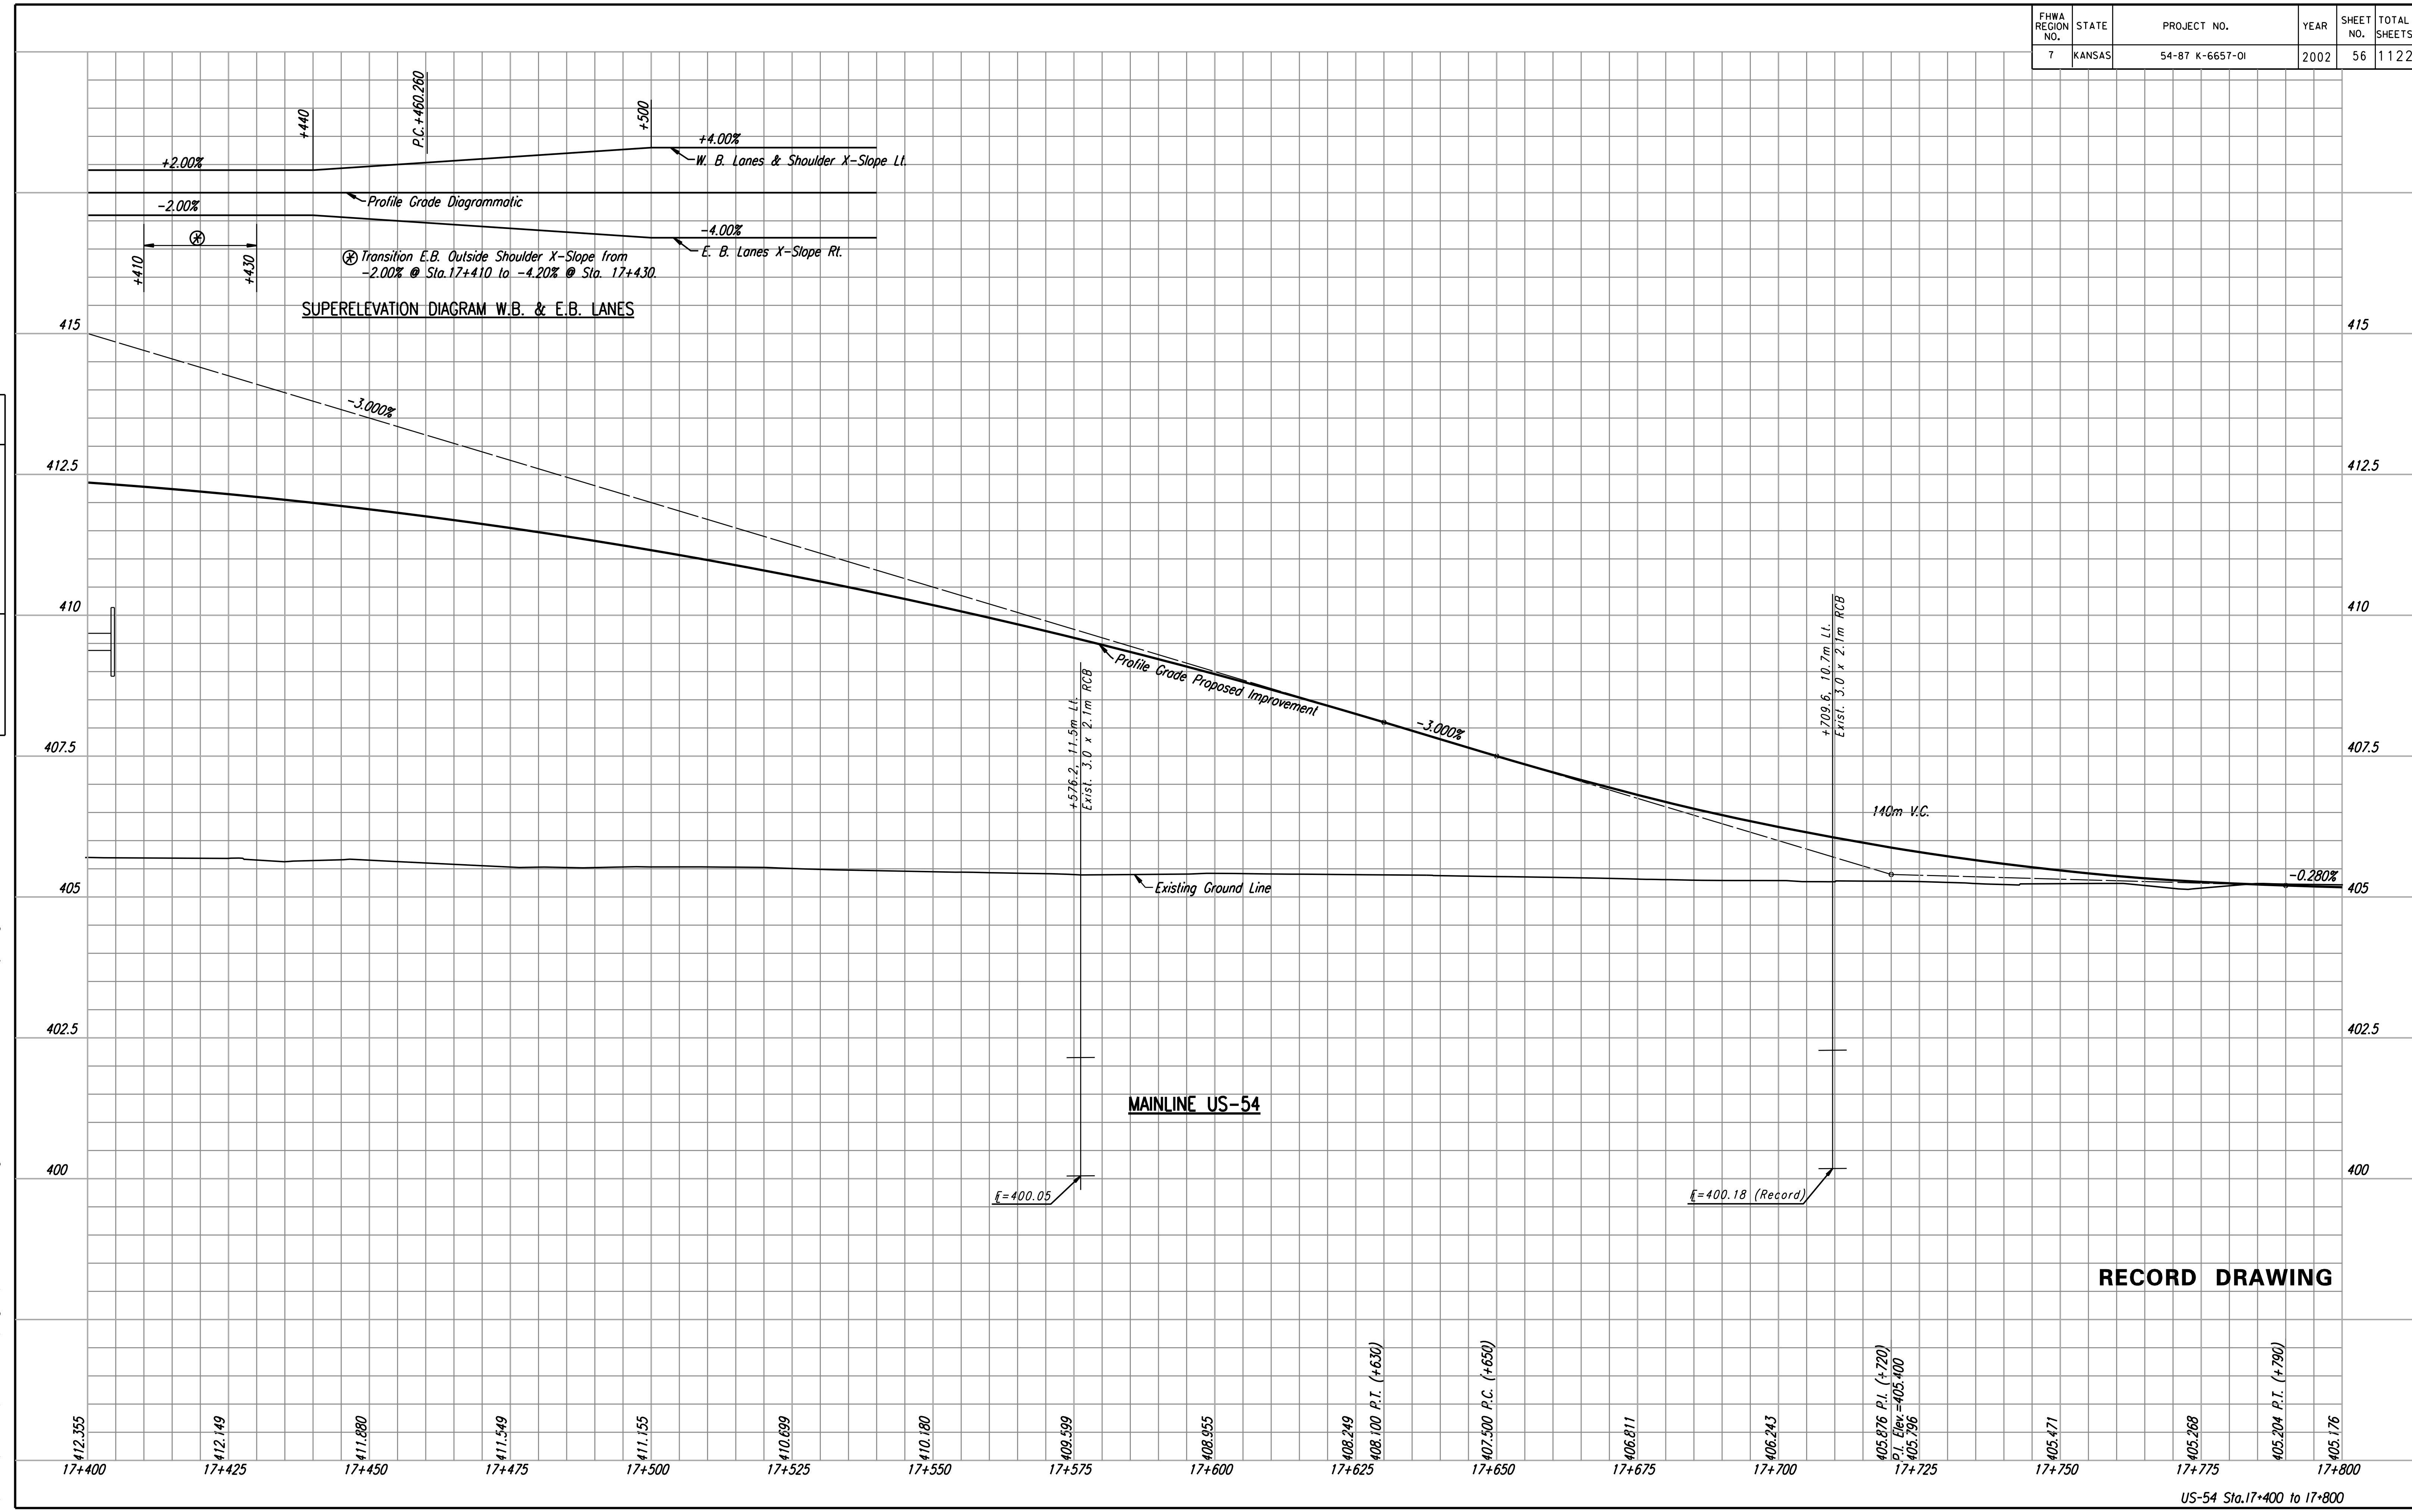

RECORD DRAWING