
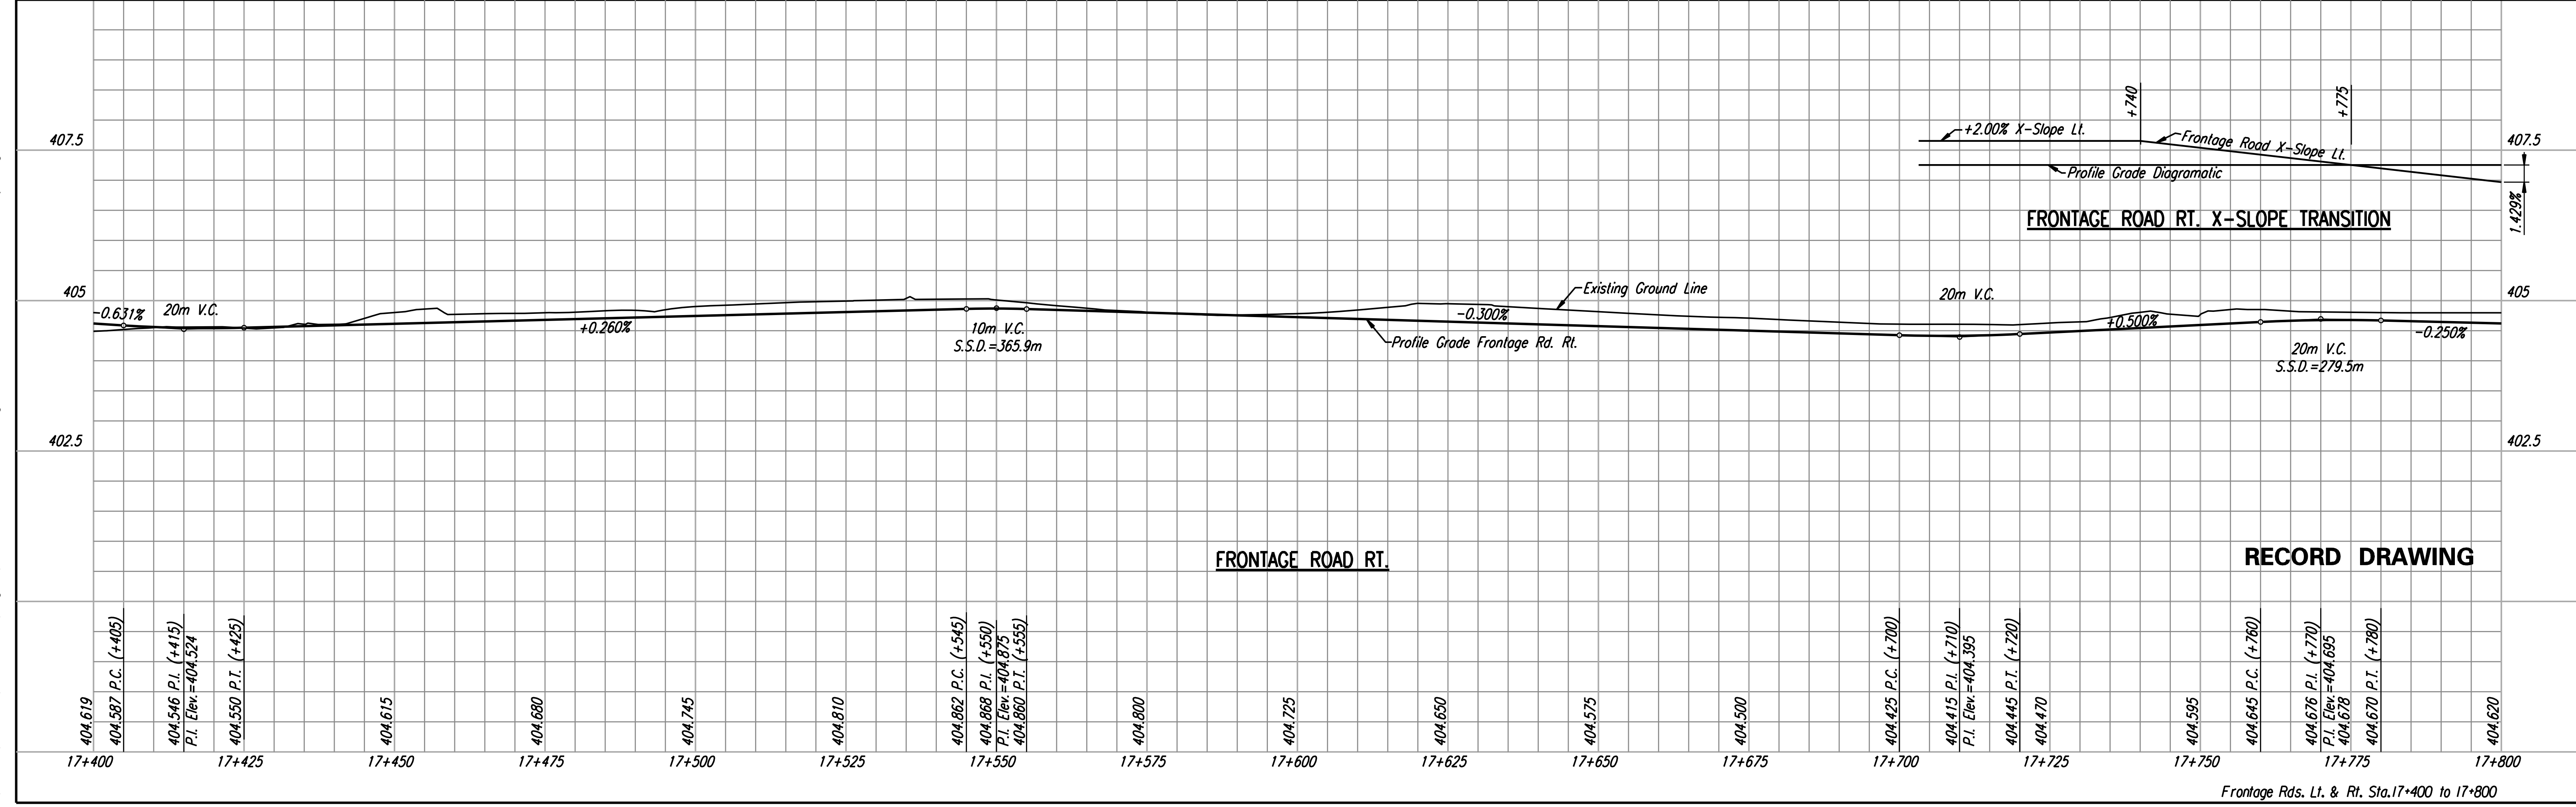


FHWA REGION NO.	STATE	PROJECT NO.	YEAR	SHEET NO.	TOTAL SHEETS
7	KANSAS	54-87 K-6657-01	2002	57	1122

REFERENCES NOTED	DATE
REFERENCES CHECKED	
BY	

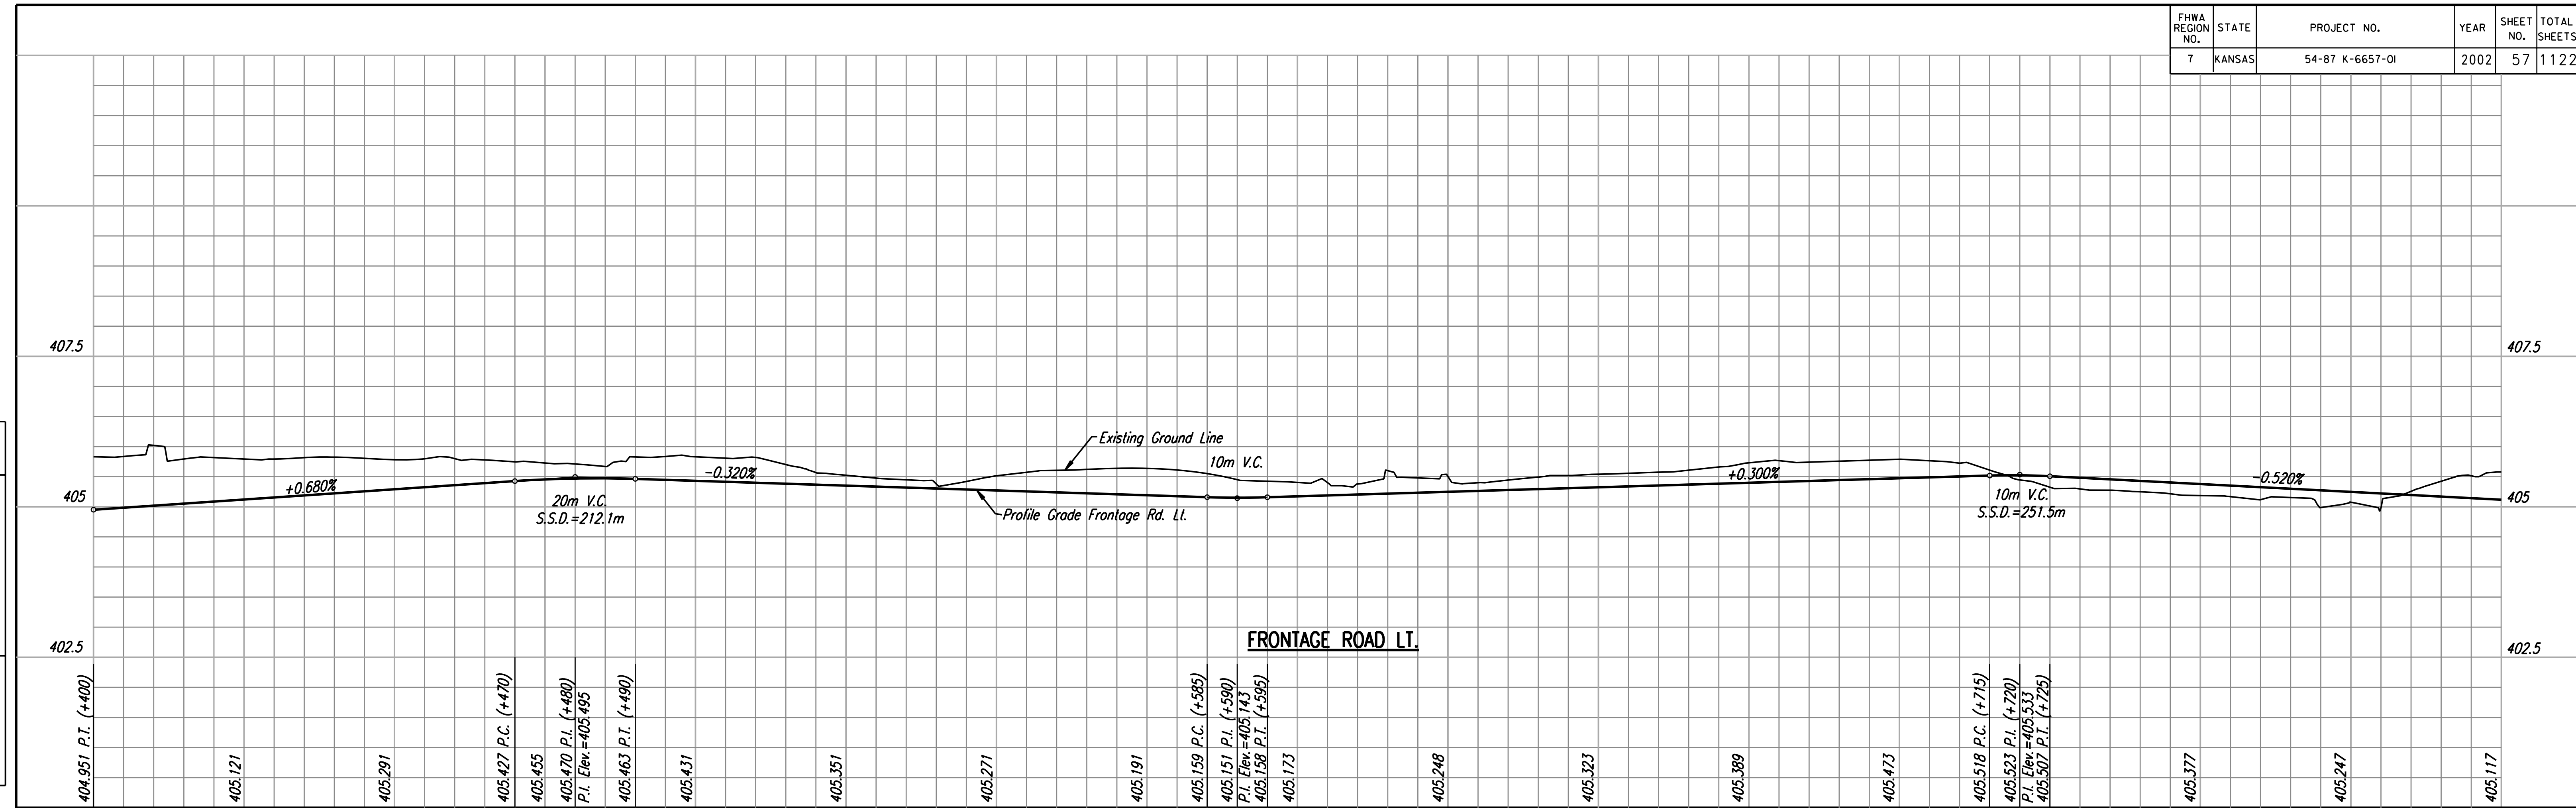

DSNR: JPS OPER: JGP SCALE: 1:500
 I:/1997/97362/As-Builts/dgn's/Sh 057-prfrd174.dgn Last Rev: 8-7-07 By: gdr

RECORD DRAWING

Frontage Rds. Lt. & Rt. Sta. 17+400 to 17+800