


FHWA REGION NO.	STATE	PROJECT NO.	YEAR	SHEET NO.	TOTAL SHEETS
7	KANSAS	54-87 K-6657-01	2002	63	1122

REFERENCES NOTED	BY	DATE
REFERENCES CHECKED		

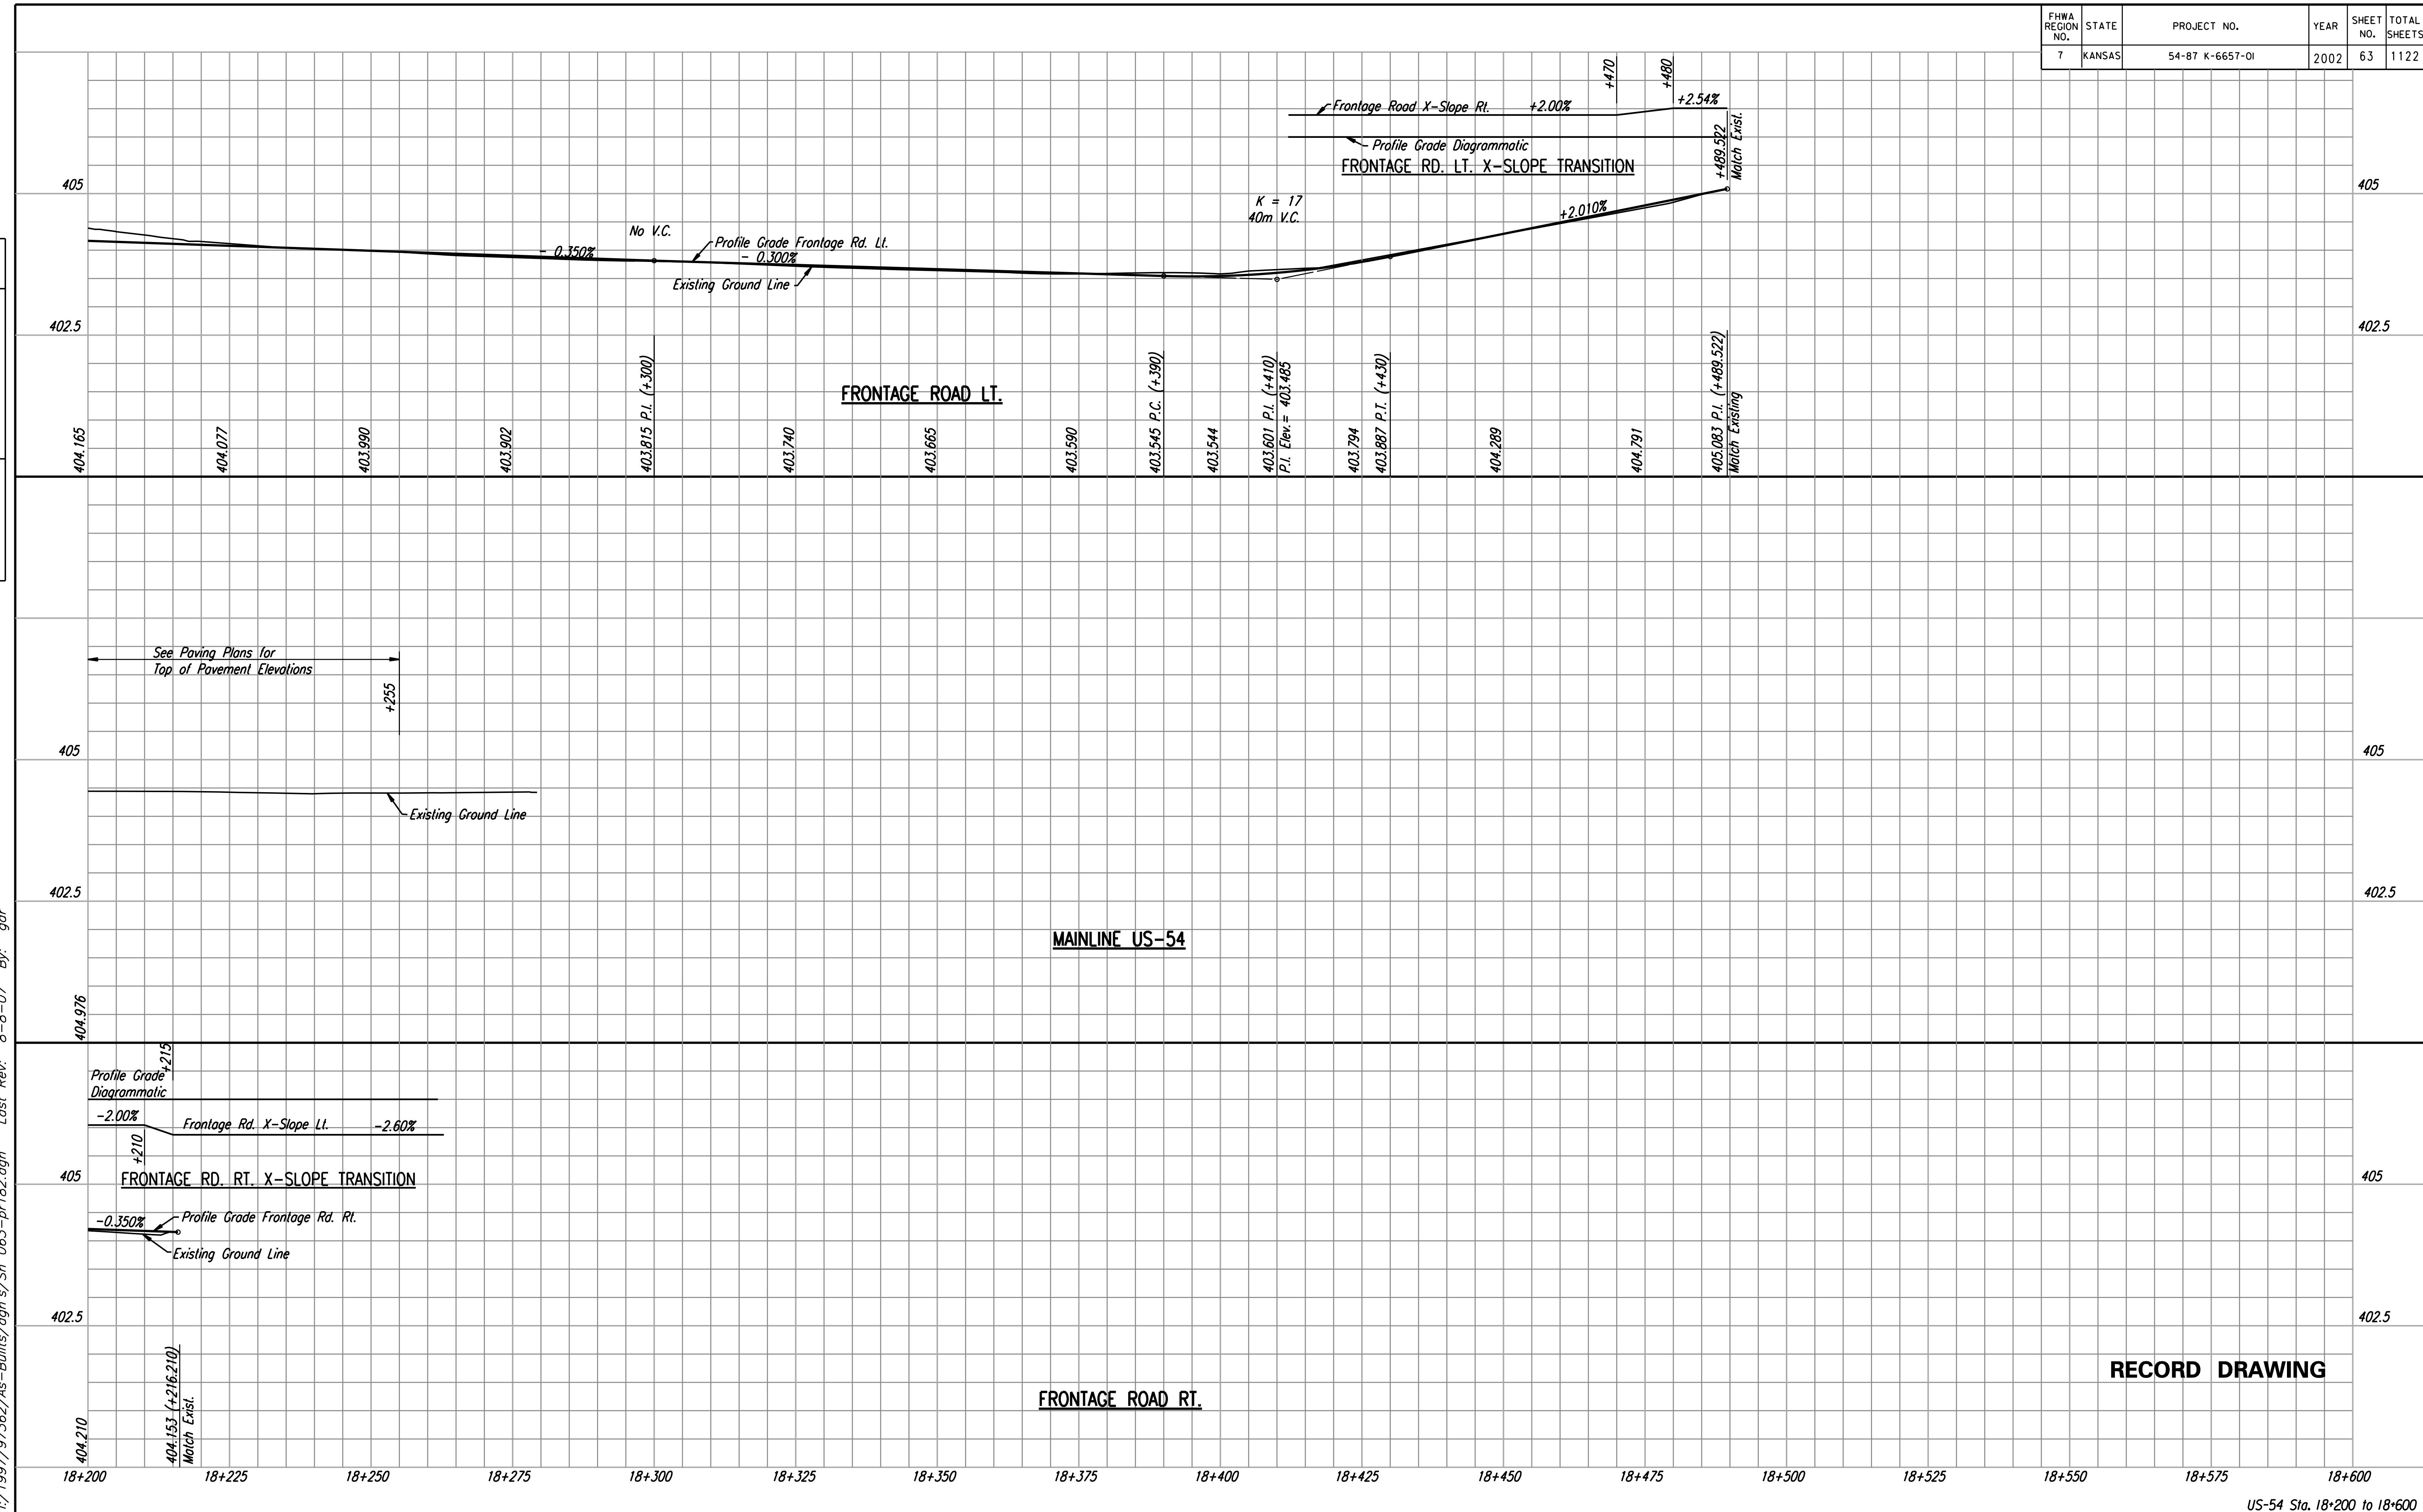

DSNR: WDH OPER: JGP SCALE: 1:500  
 I:/1997/97362/As-Builts/dgn's/Sh 063-pr182.dgn Last Rev: 8-8-07 By: gdr

**RECORD DRAWING**