
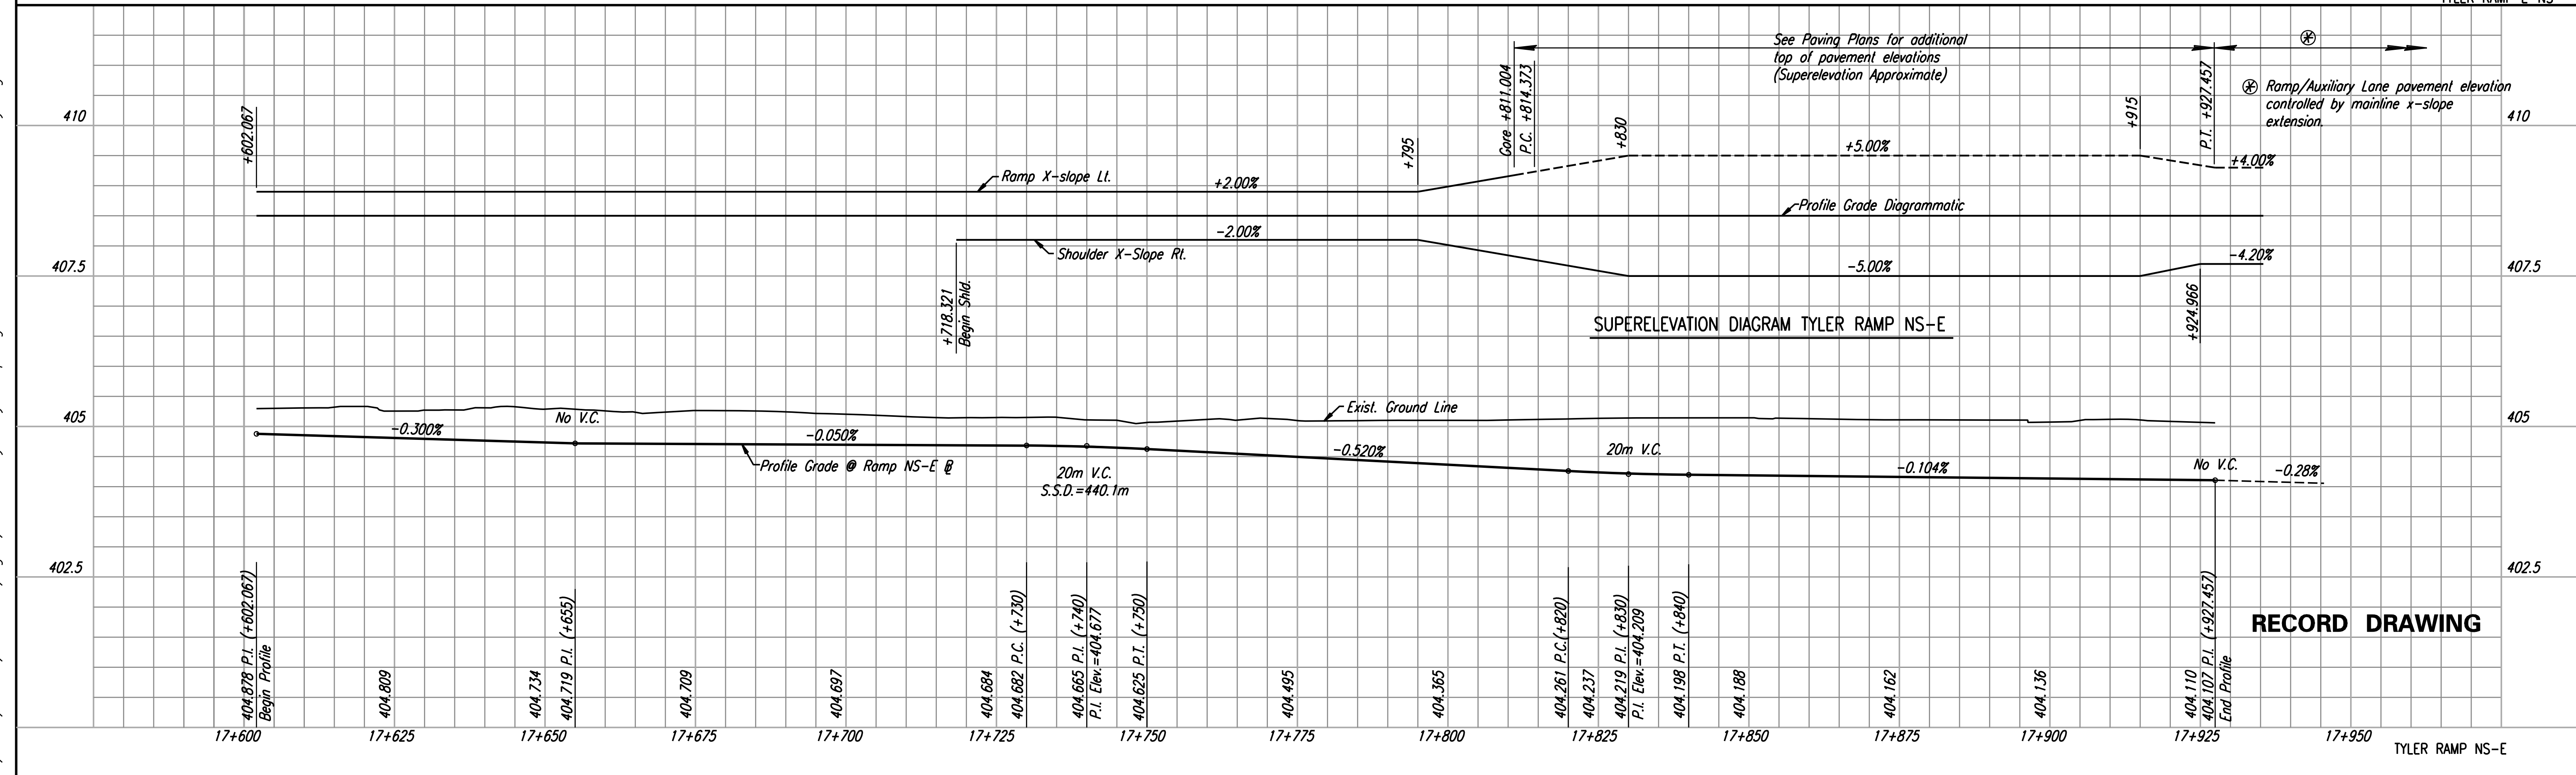


DATE	
BY	
REFERENCES NOTED	
REFERENCES CHECKED	

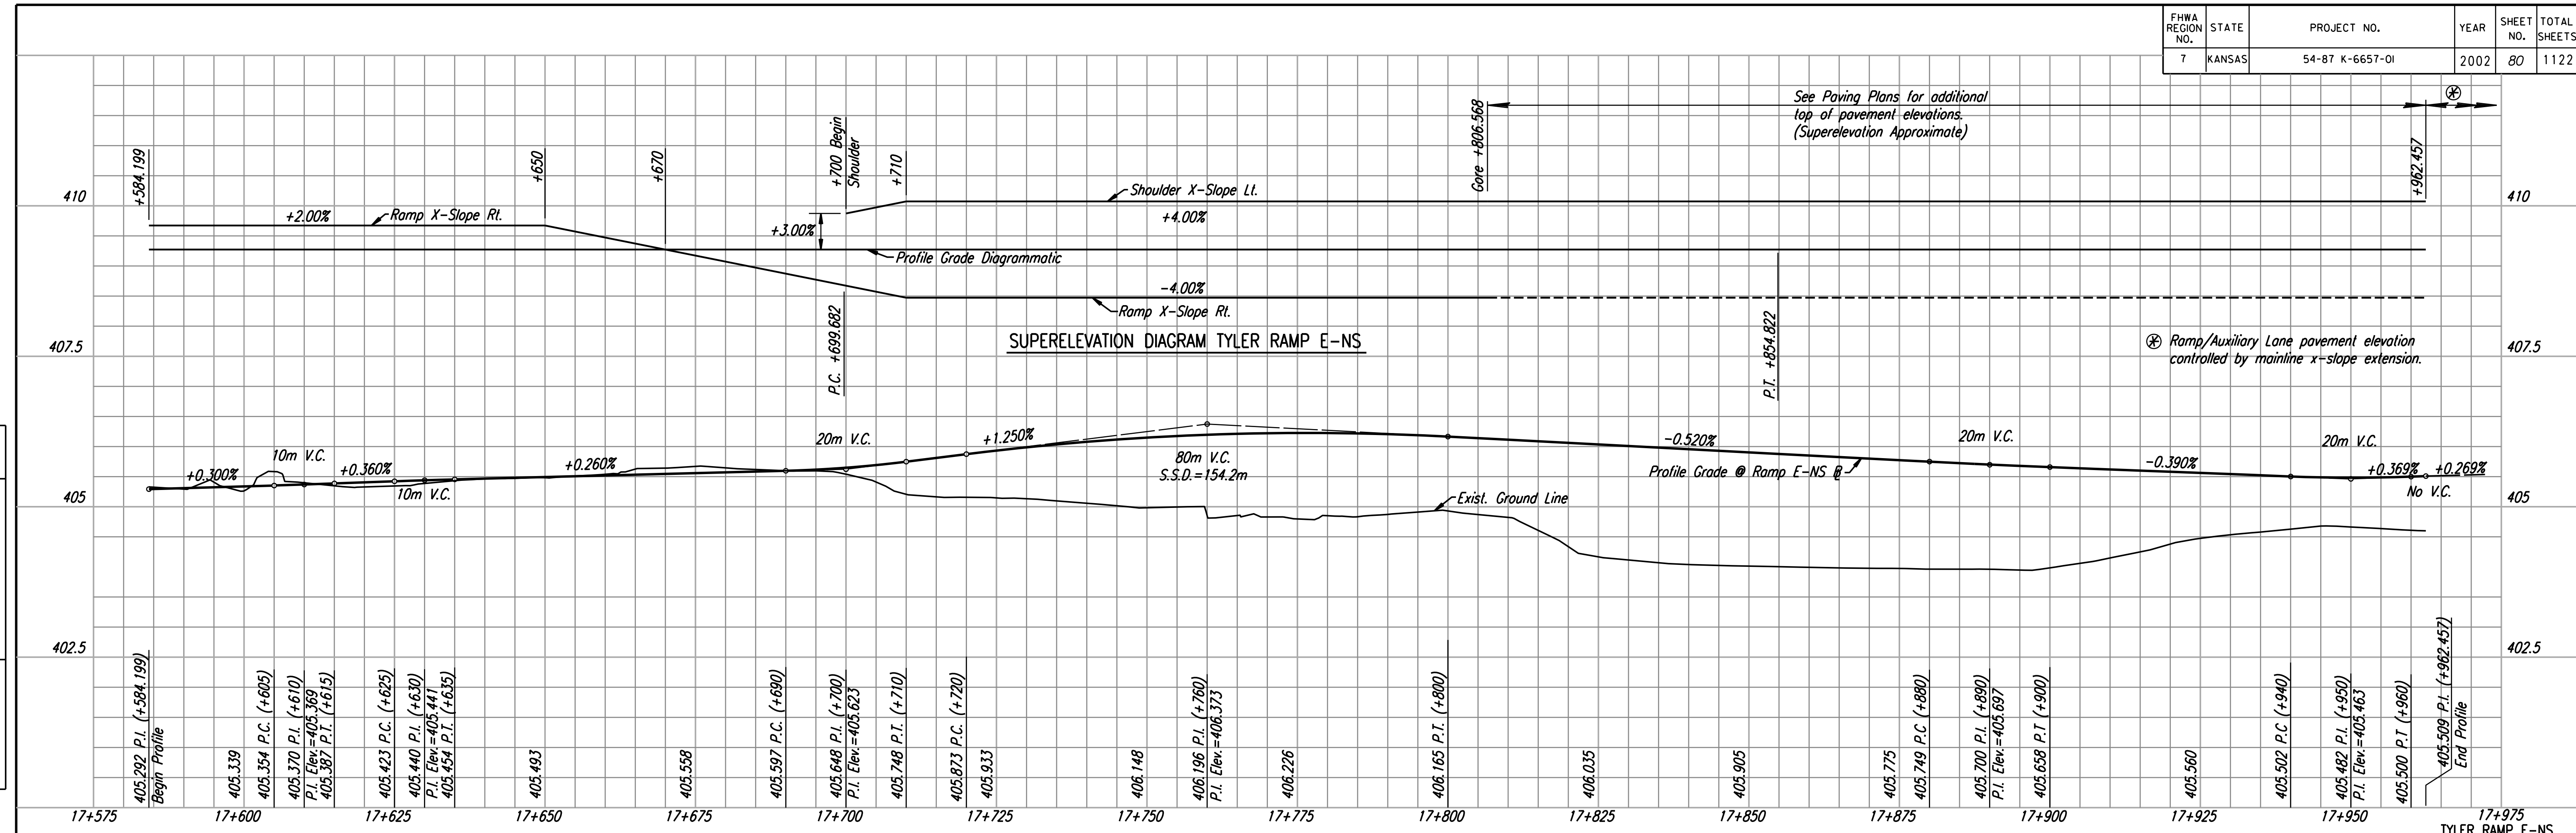

RECORD DRAWING

DSNR: WDH OPER: JGP SCALE: 1:500
 i:/1997/192362/As-Builts/dgn's/Sh 080-Tyler-tylermpe.dgn Last Rev: 8-9-07 By: gdr