
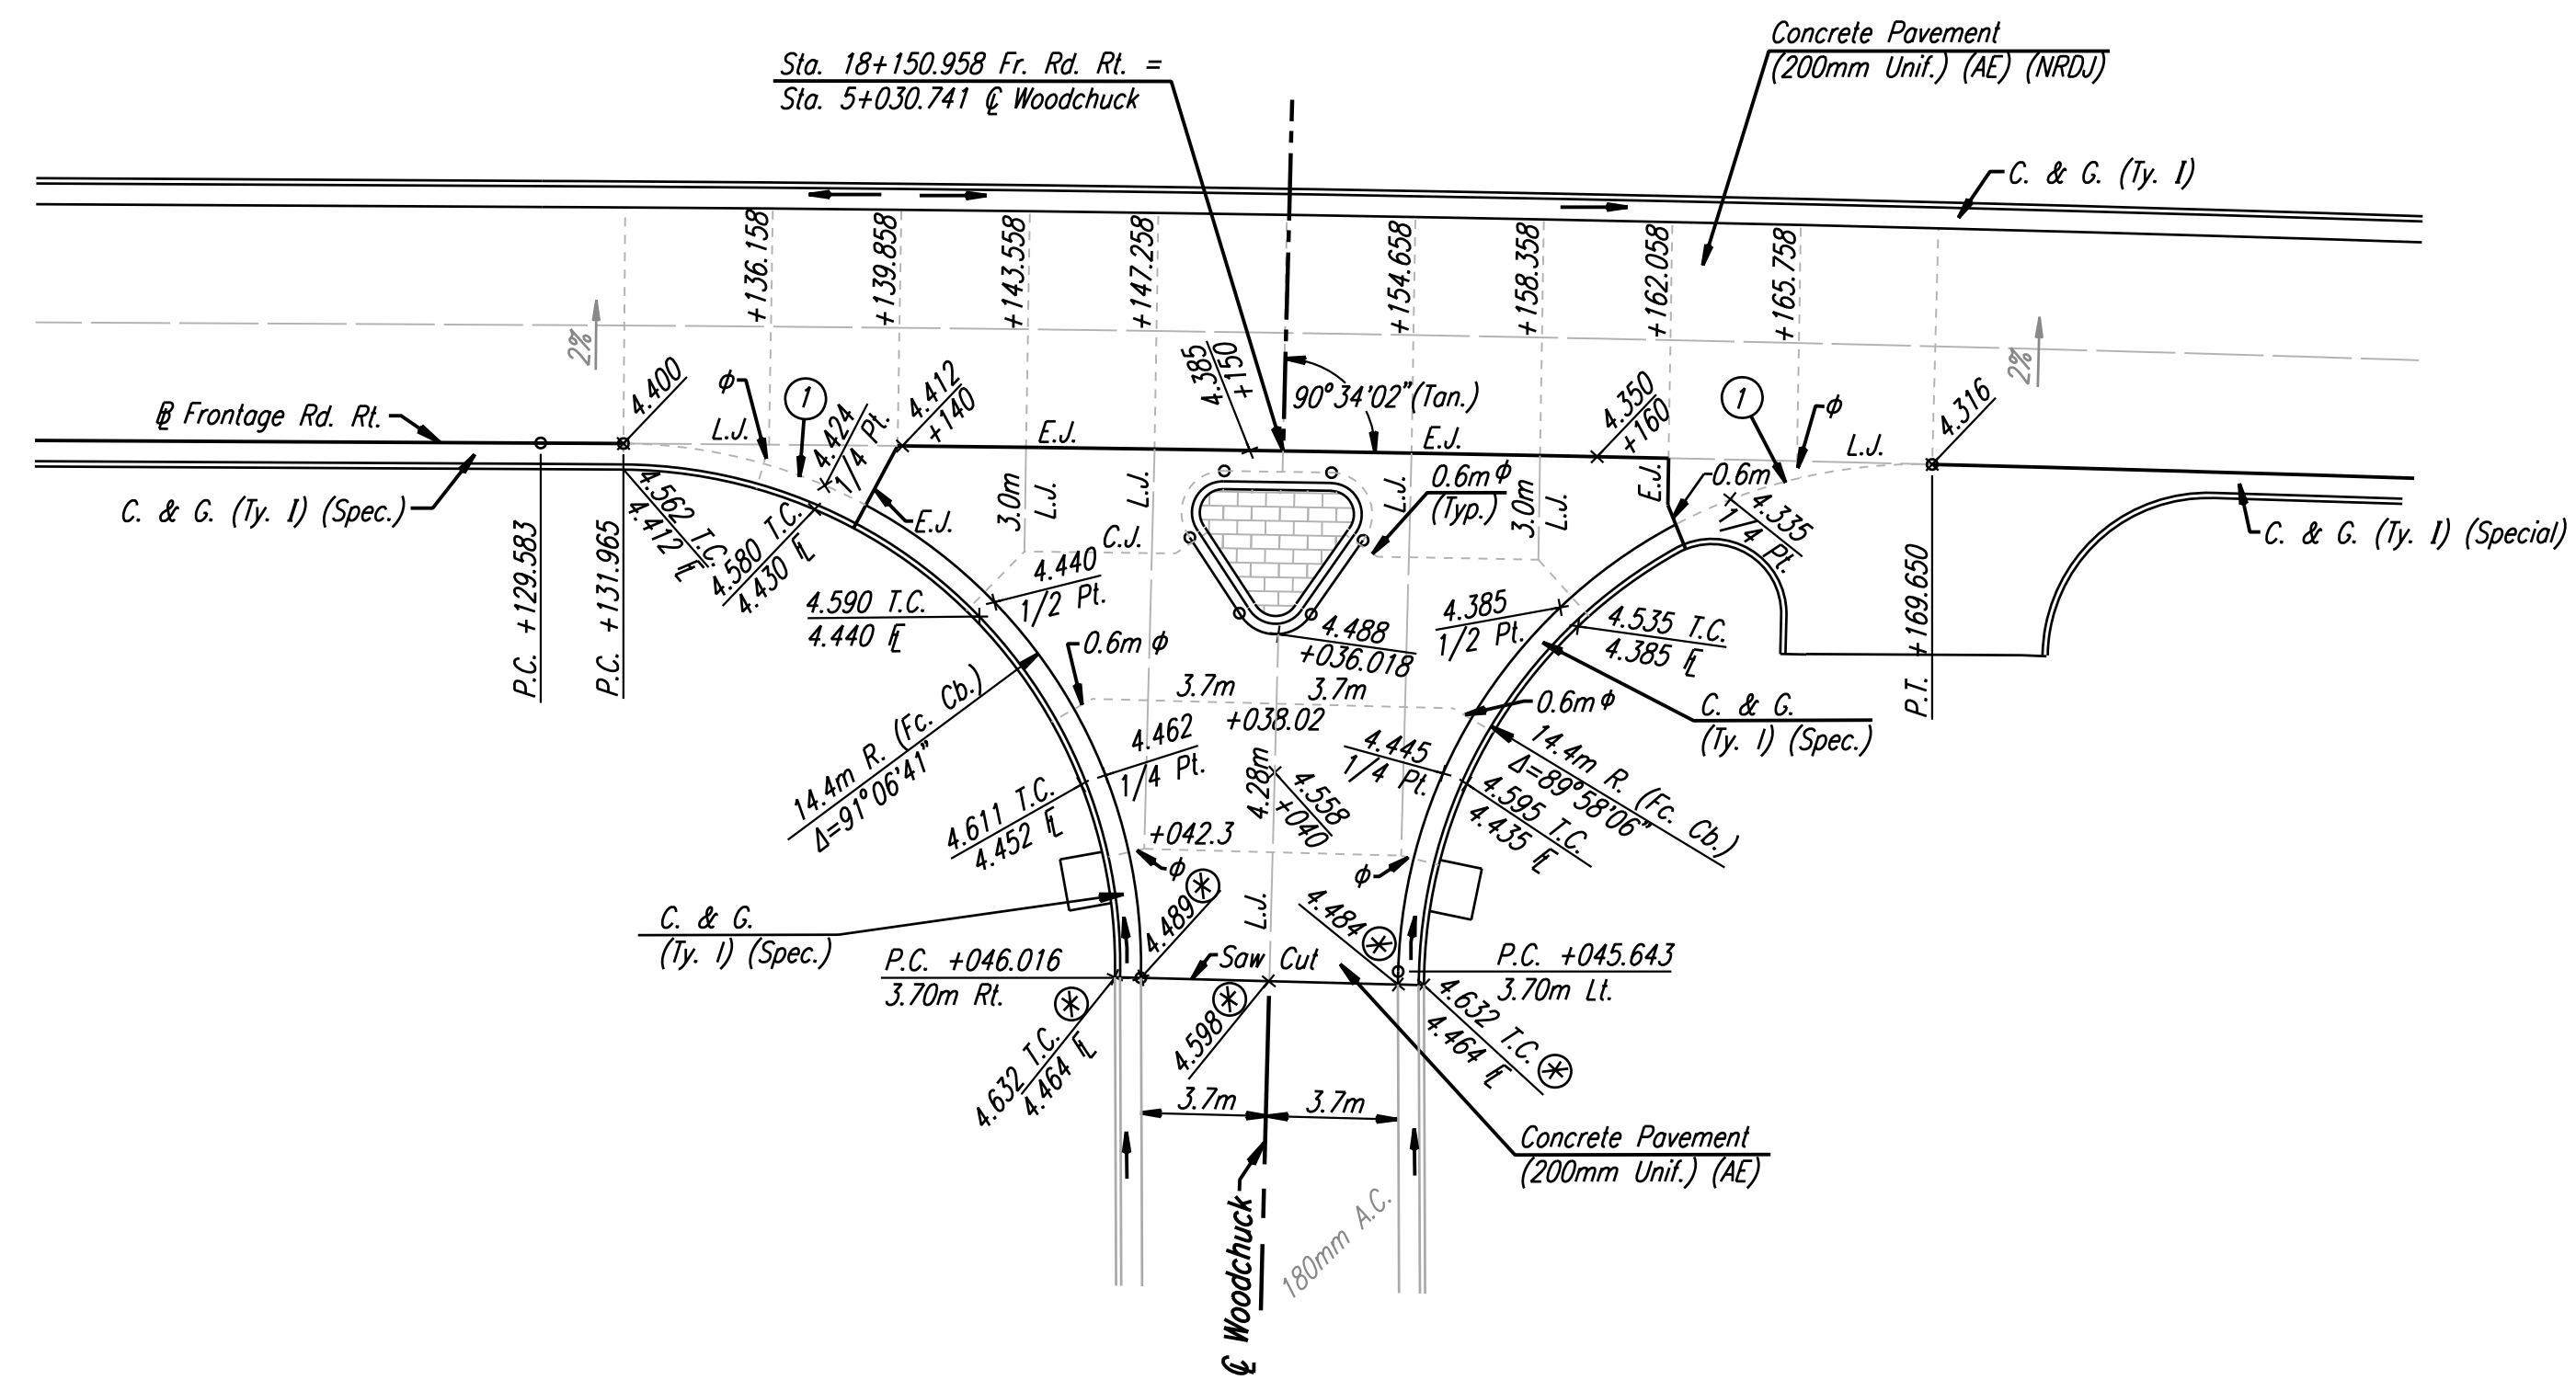


FHWA REGION NO.	STATE	PROJECT NO.	YEAR	SHEET NO.	TOTAL SHEETS
7	KANSAS	54-87 K-6657-01	2002	92	1122


DATE	
BY	
REFERENCES NOTED	
REFERENCES CHECKED	

DSNR: WDH OPER: JGP SCALE: 1:200
 i:/1997/97362/As-Builts/dgn/s/Sta_092-insect.dgn Last Rev: 8-10-07 By: gdr

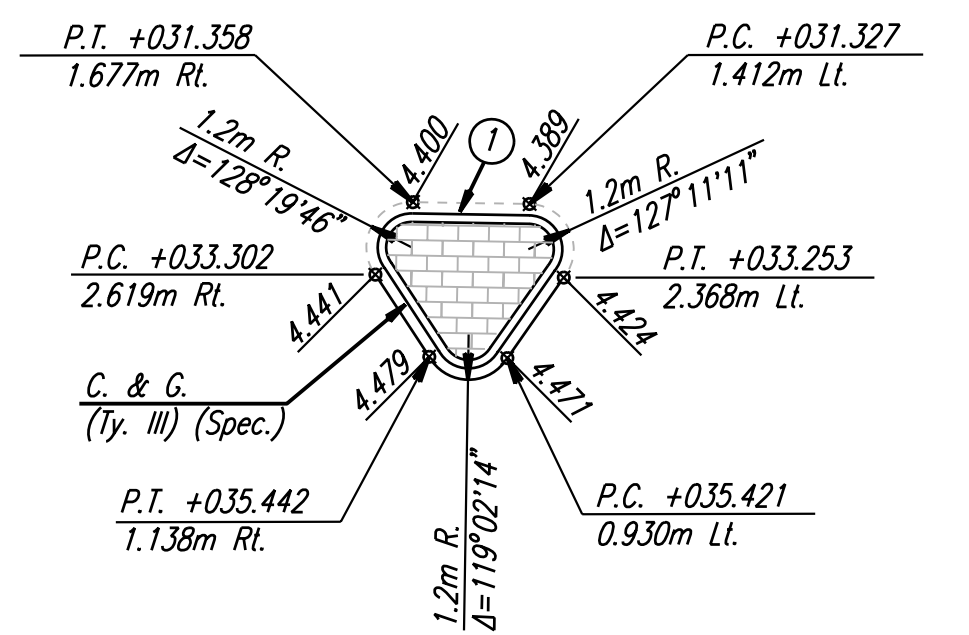

- ⊗ Match Existing. (See Note Below)
- * Warp gutter to drain
- φ Omit dowel or tie bars (Typ.)
- ① Curb to be cast monolithic with pavement. Paid for as C. & G.
- L.J. Longitudinal Joint (Tied)
- C.J. Transverse Contraction Joint
- E.J. Expansion Joint (Untied)
- [Brick Pattern] Paving Brick (Median)

Note: Spot Elevations are to top of finished pavement. Elevations shown on Woodchuck are proposed from C.O.W. Project No. 472-83286. Contractor to verify match elevations prior to beginning construction. Deviations from those elevations shown shall be reported to the Engineer so appropriate adjustments can be made.

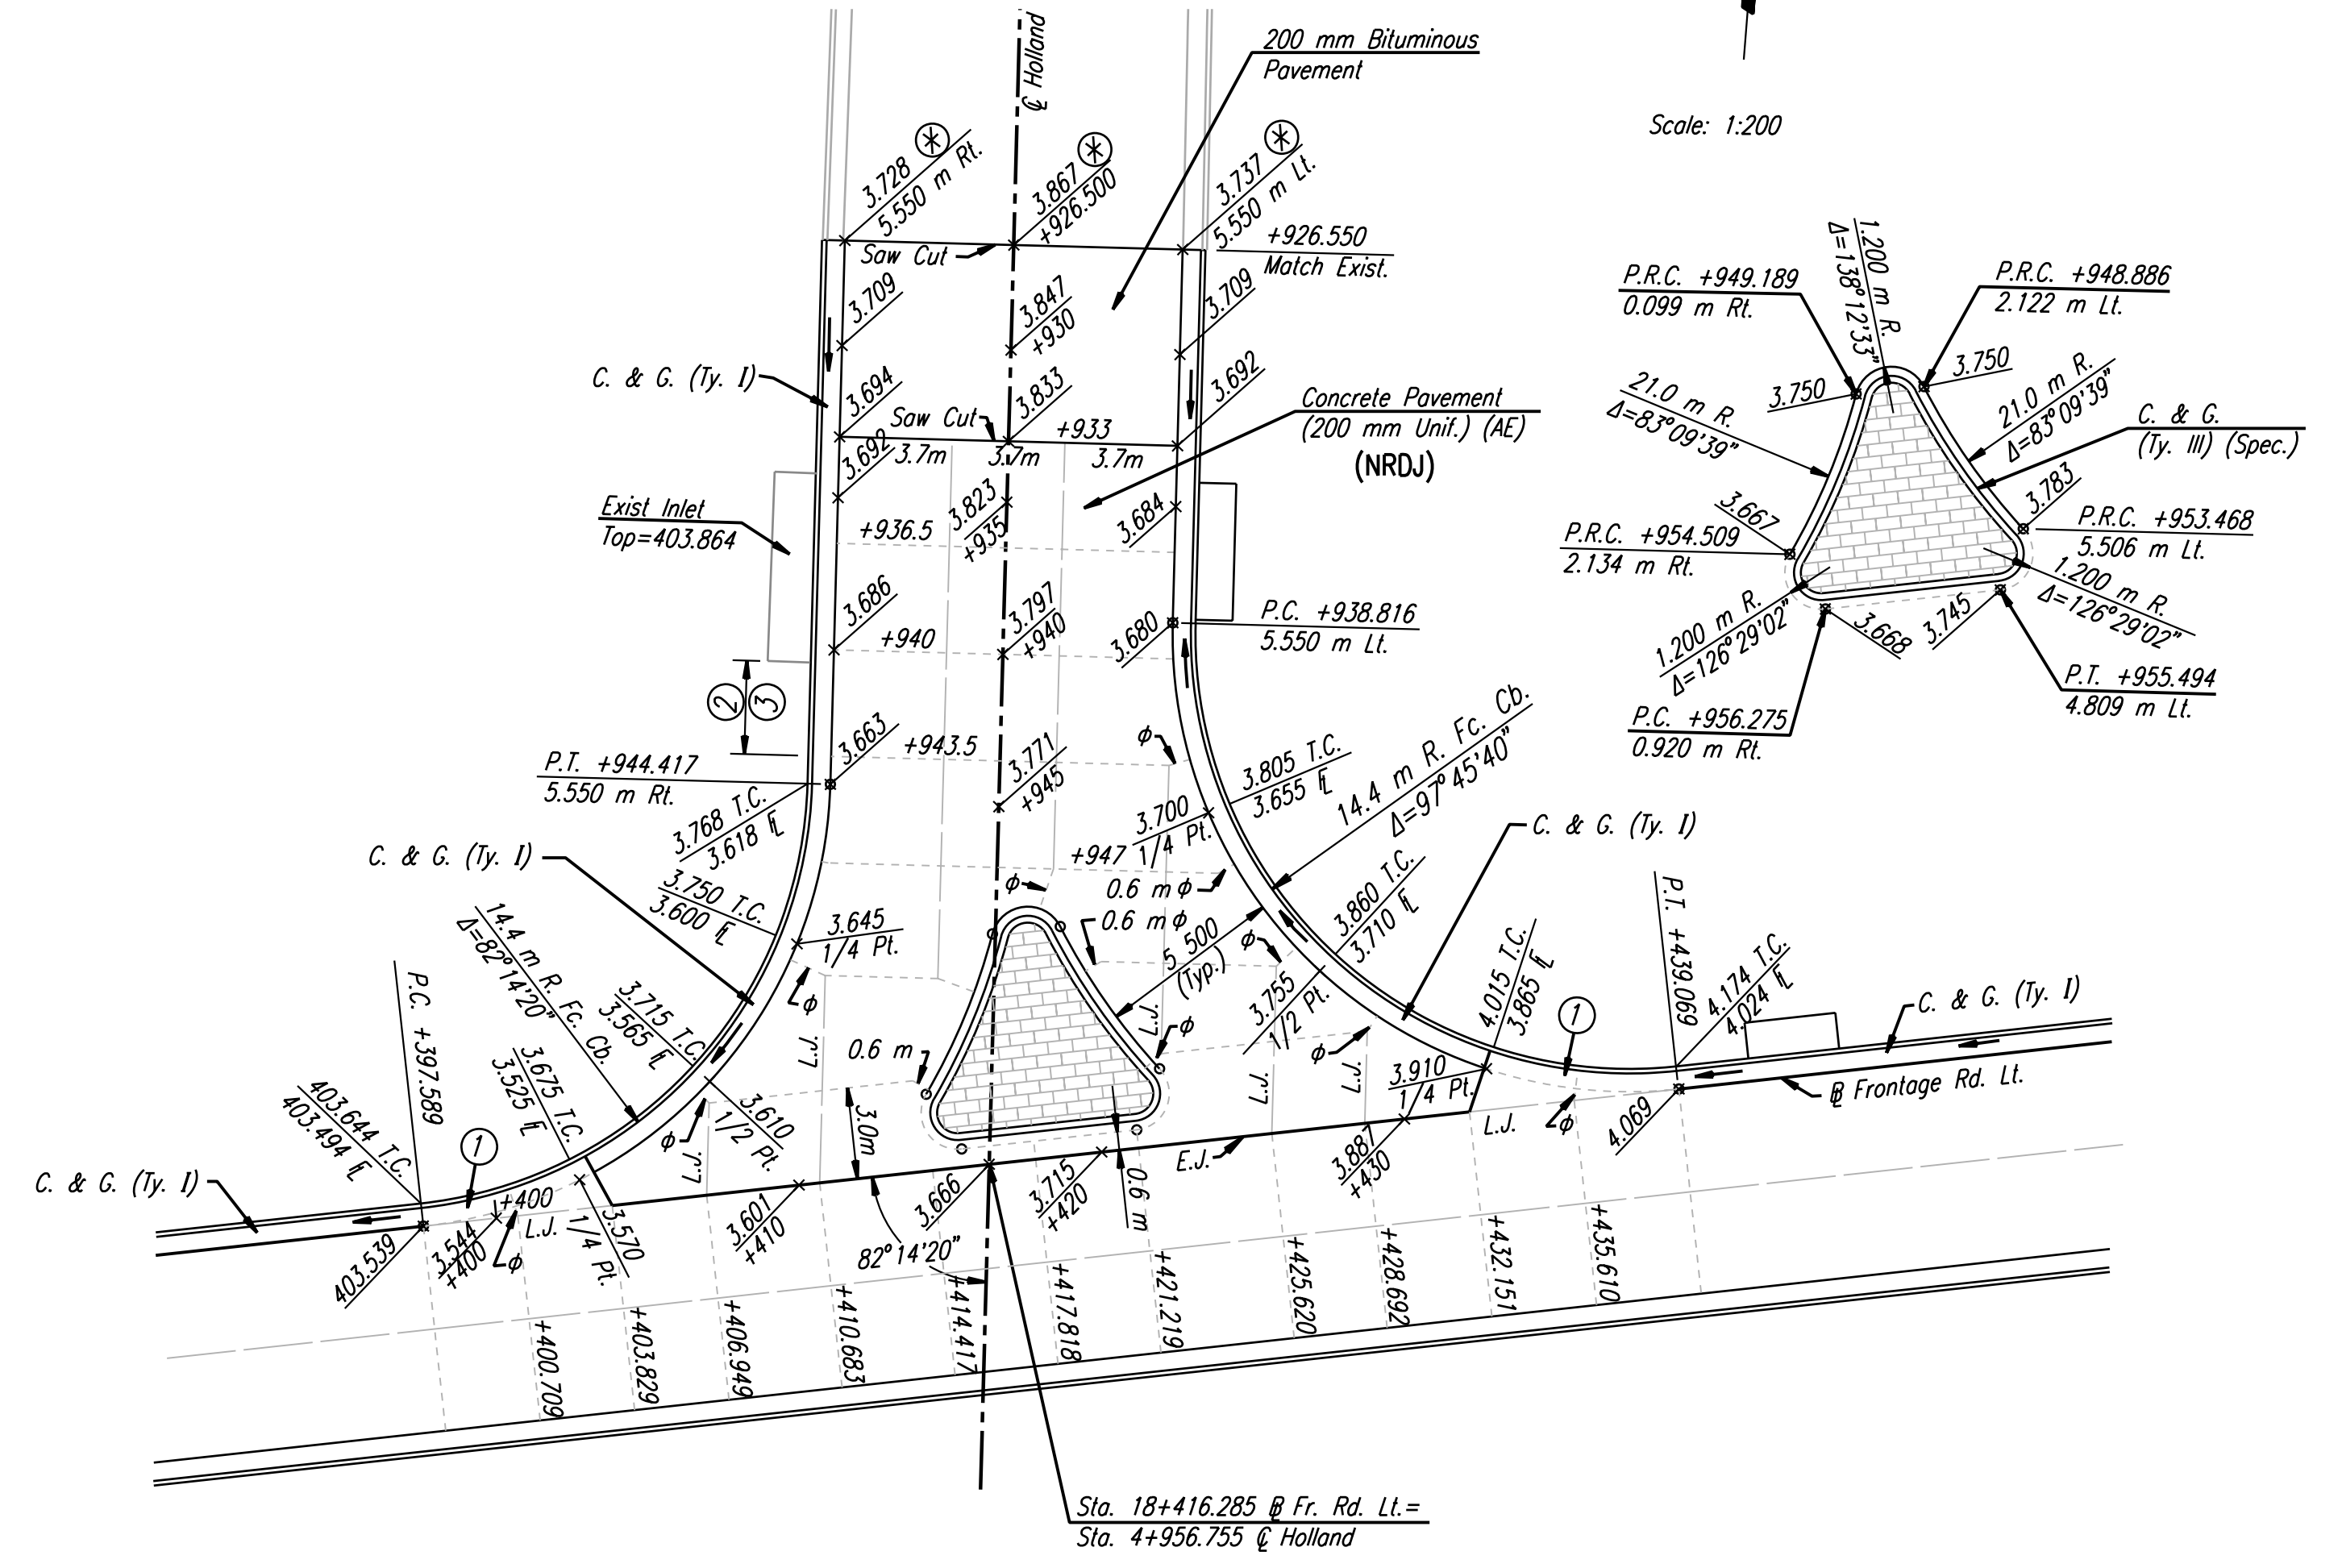

- ⊗ Match Existing.
- * Warp gutter to drain
- φ Omit dowel or tie bars (Typ.)
- ① Curb to be cast monolithic with pavement. Paid for as C. & G.
- ② Transition from C. & G. (Ty. I) to C. & G. (Ty. I) (Special).
- ③ Transition curb height to match inlet.
- L.J. Longitudinal Joint (Tied)
- C.J. Transverse Contraction Joint
- E.J. Expansion Joint (Untied)
- [Brick Pattern] Paving Brick (Median)

Note: Frontage Road Lt. X-Slope varies from -3.30% Rt. @ Sta. 18+380 to +2.54% Rt. @ Sta. 18+480.

RECORD DRAWING

Revisions		By	Date
No.			

CITY OF WICHITA
INTERSECTION DETAILS
 WOODCHUCK RT.
 HOLLAND LT.
 SEDGWICK COUNTY

Professional Engineering Consultants, P.A.
 303 S. TOPEKA • WICHITA, KANSAS 67202
 316-262-2691 • FAX 316-262-3003

Designed by	WDH	Checked by	WDH
Drawn by	JGP	Date	April, 2002
		Job No.	97362