


FHWA REGION NO.	STATE	PROJECT NO.	YEAR	SHEET NO.	TOTAL SHEETS
7	KANSAS	54-87 K-6657-01	2002	154	1122

DATE	
BY	
REFERENCES NOTED	
REFERENCES CHECKED	

DSNR: JPS OPER: JGP SCALE: 1:500  
 i:/1997/97362/As-Builts/dgn's/Sta\_154-sws150.dgn Last Rev: 8-2-07 By: gdr

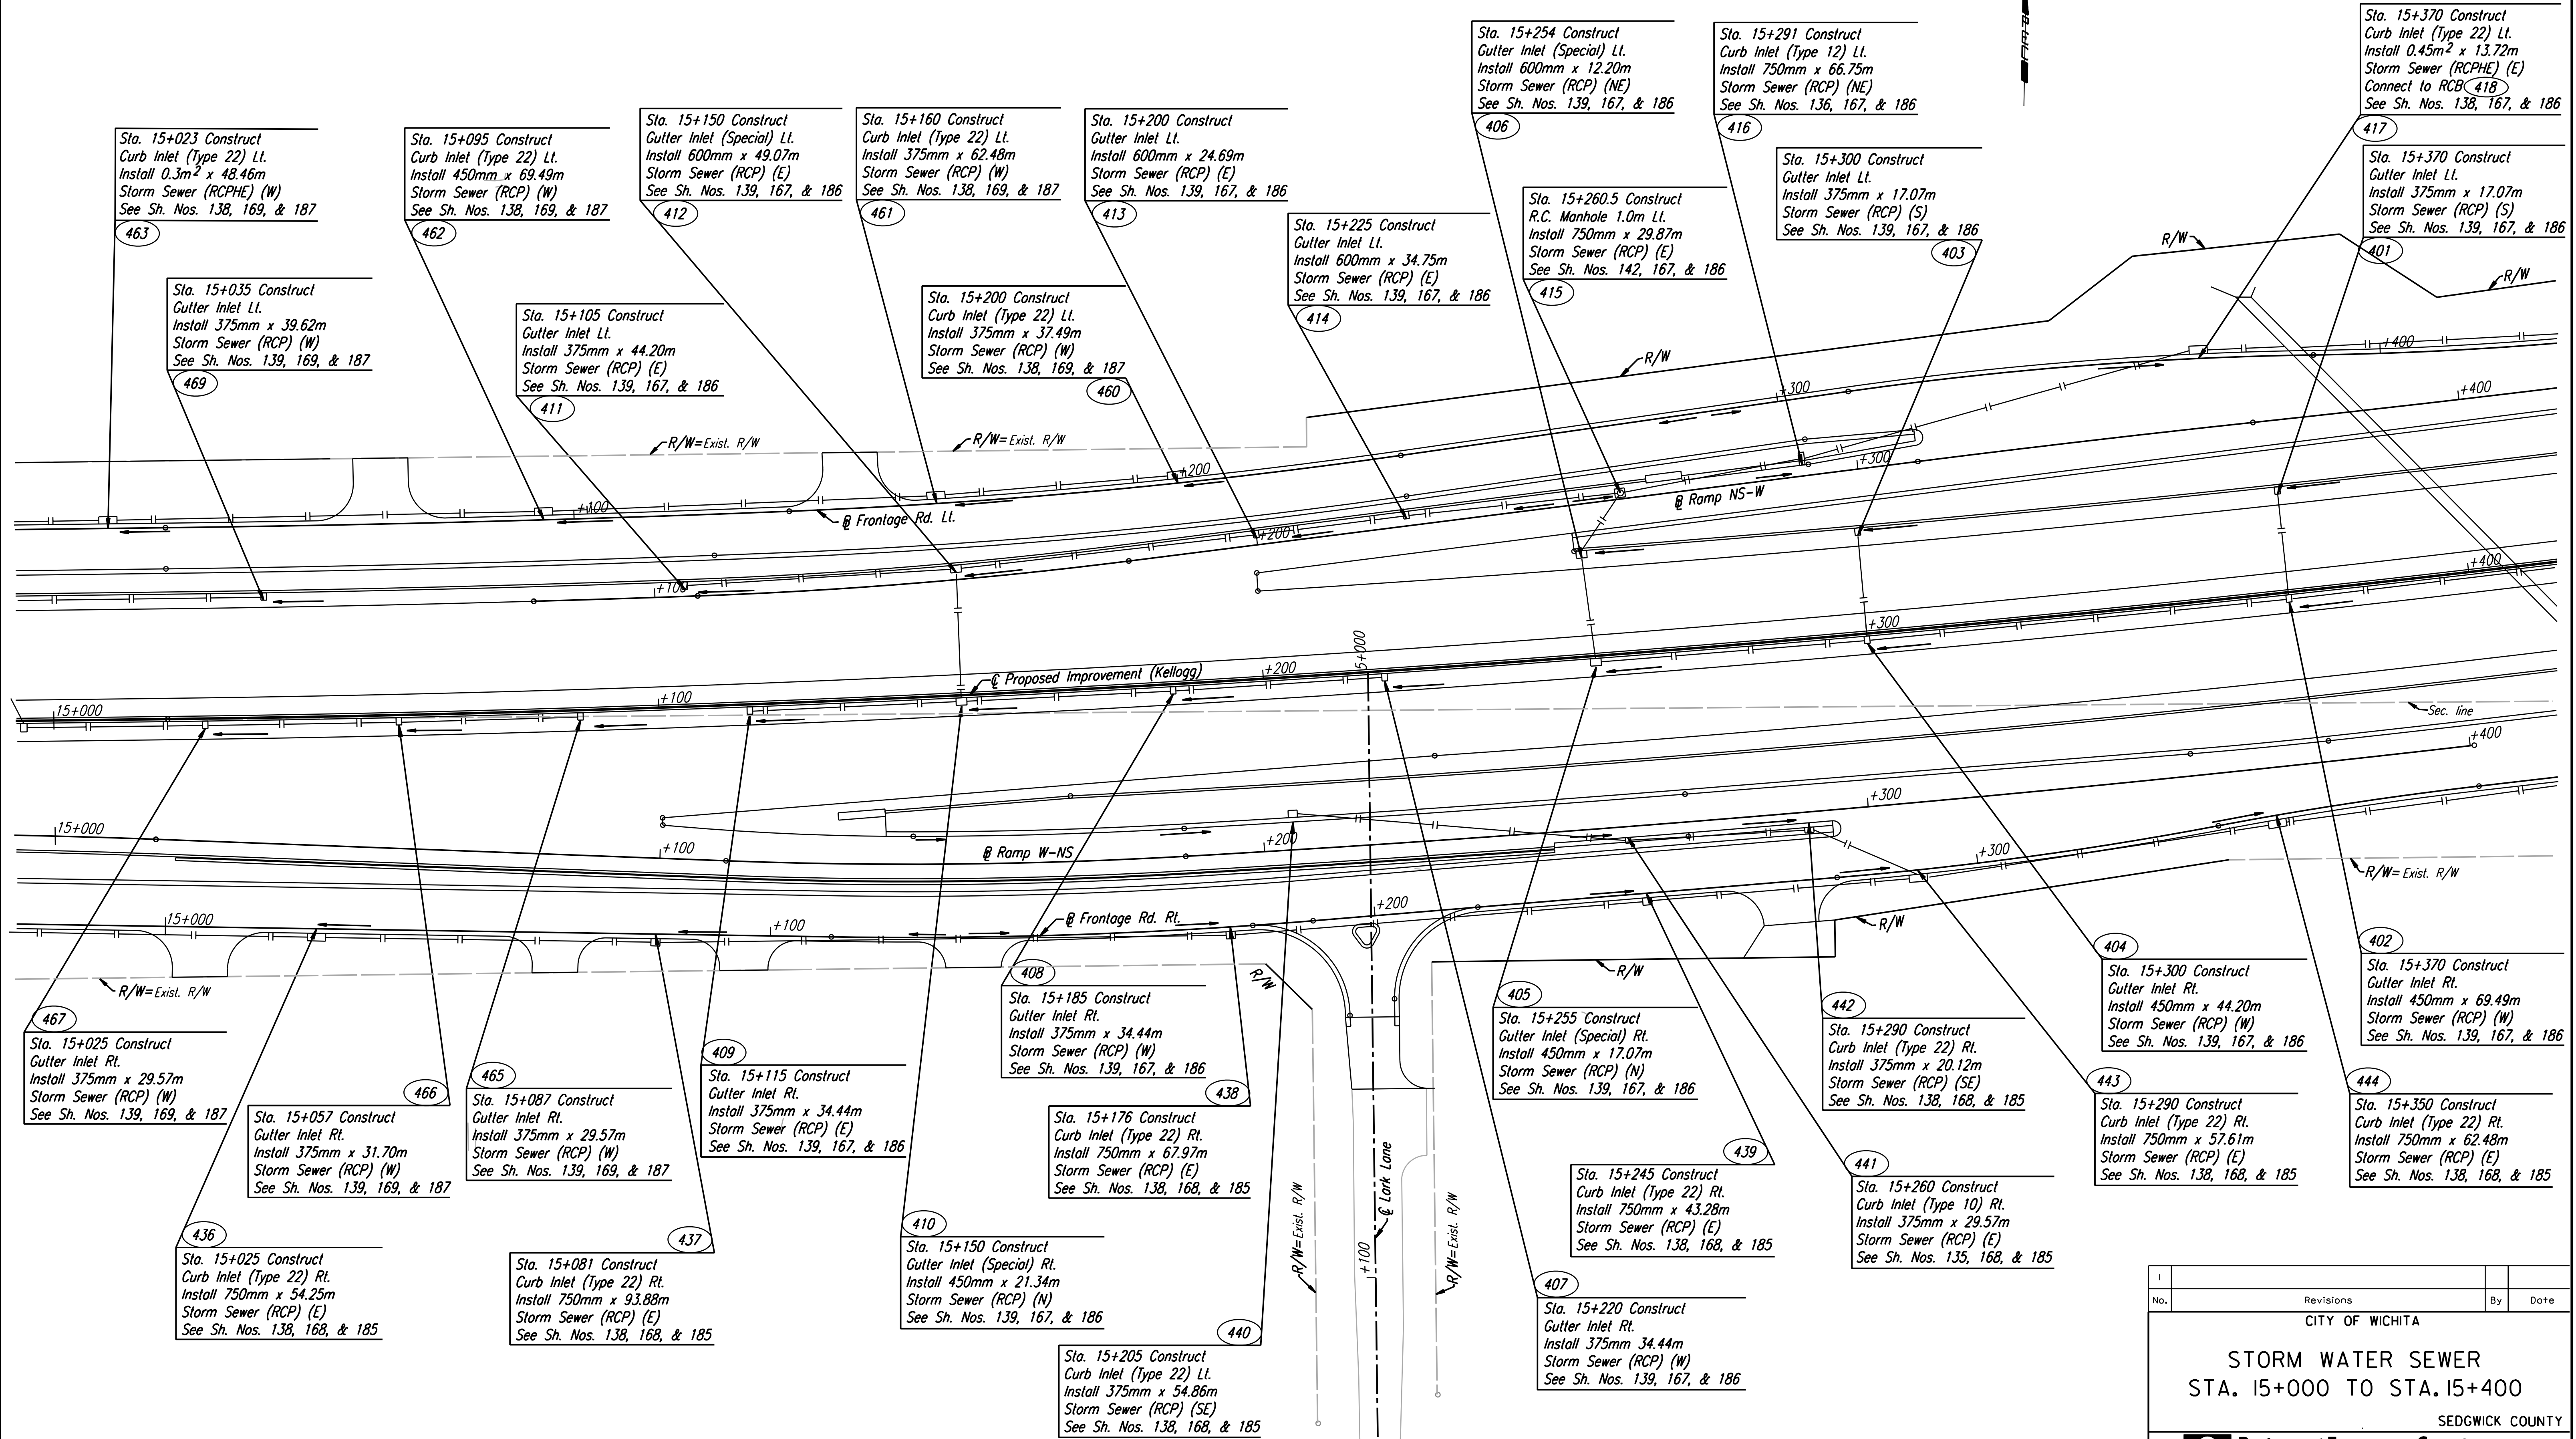

CITY OF WICHITA			
STORM WATER SEWER STA. 15+000 TO STA. 15+400			
SEDGWICK COUNTY			
Professional Engineering Consultants, P.A. 303 S. TOPEKA • WICHITA, KANSAS 67202 316-262-2691 • FAX 316-262-3003			
Designed by	RCH	Checked by	WDH
Drawn by	JGP	Date	April, 2002
		Job No.	97362

**RECORD DRAWING**