
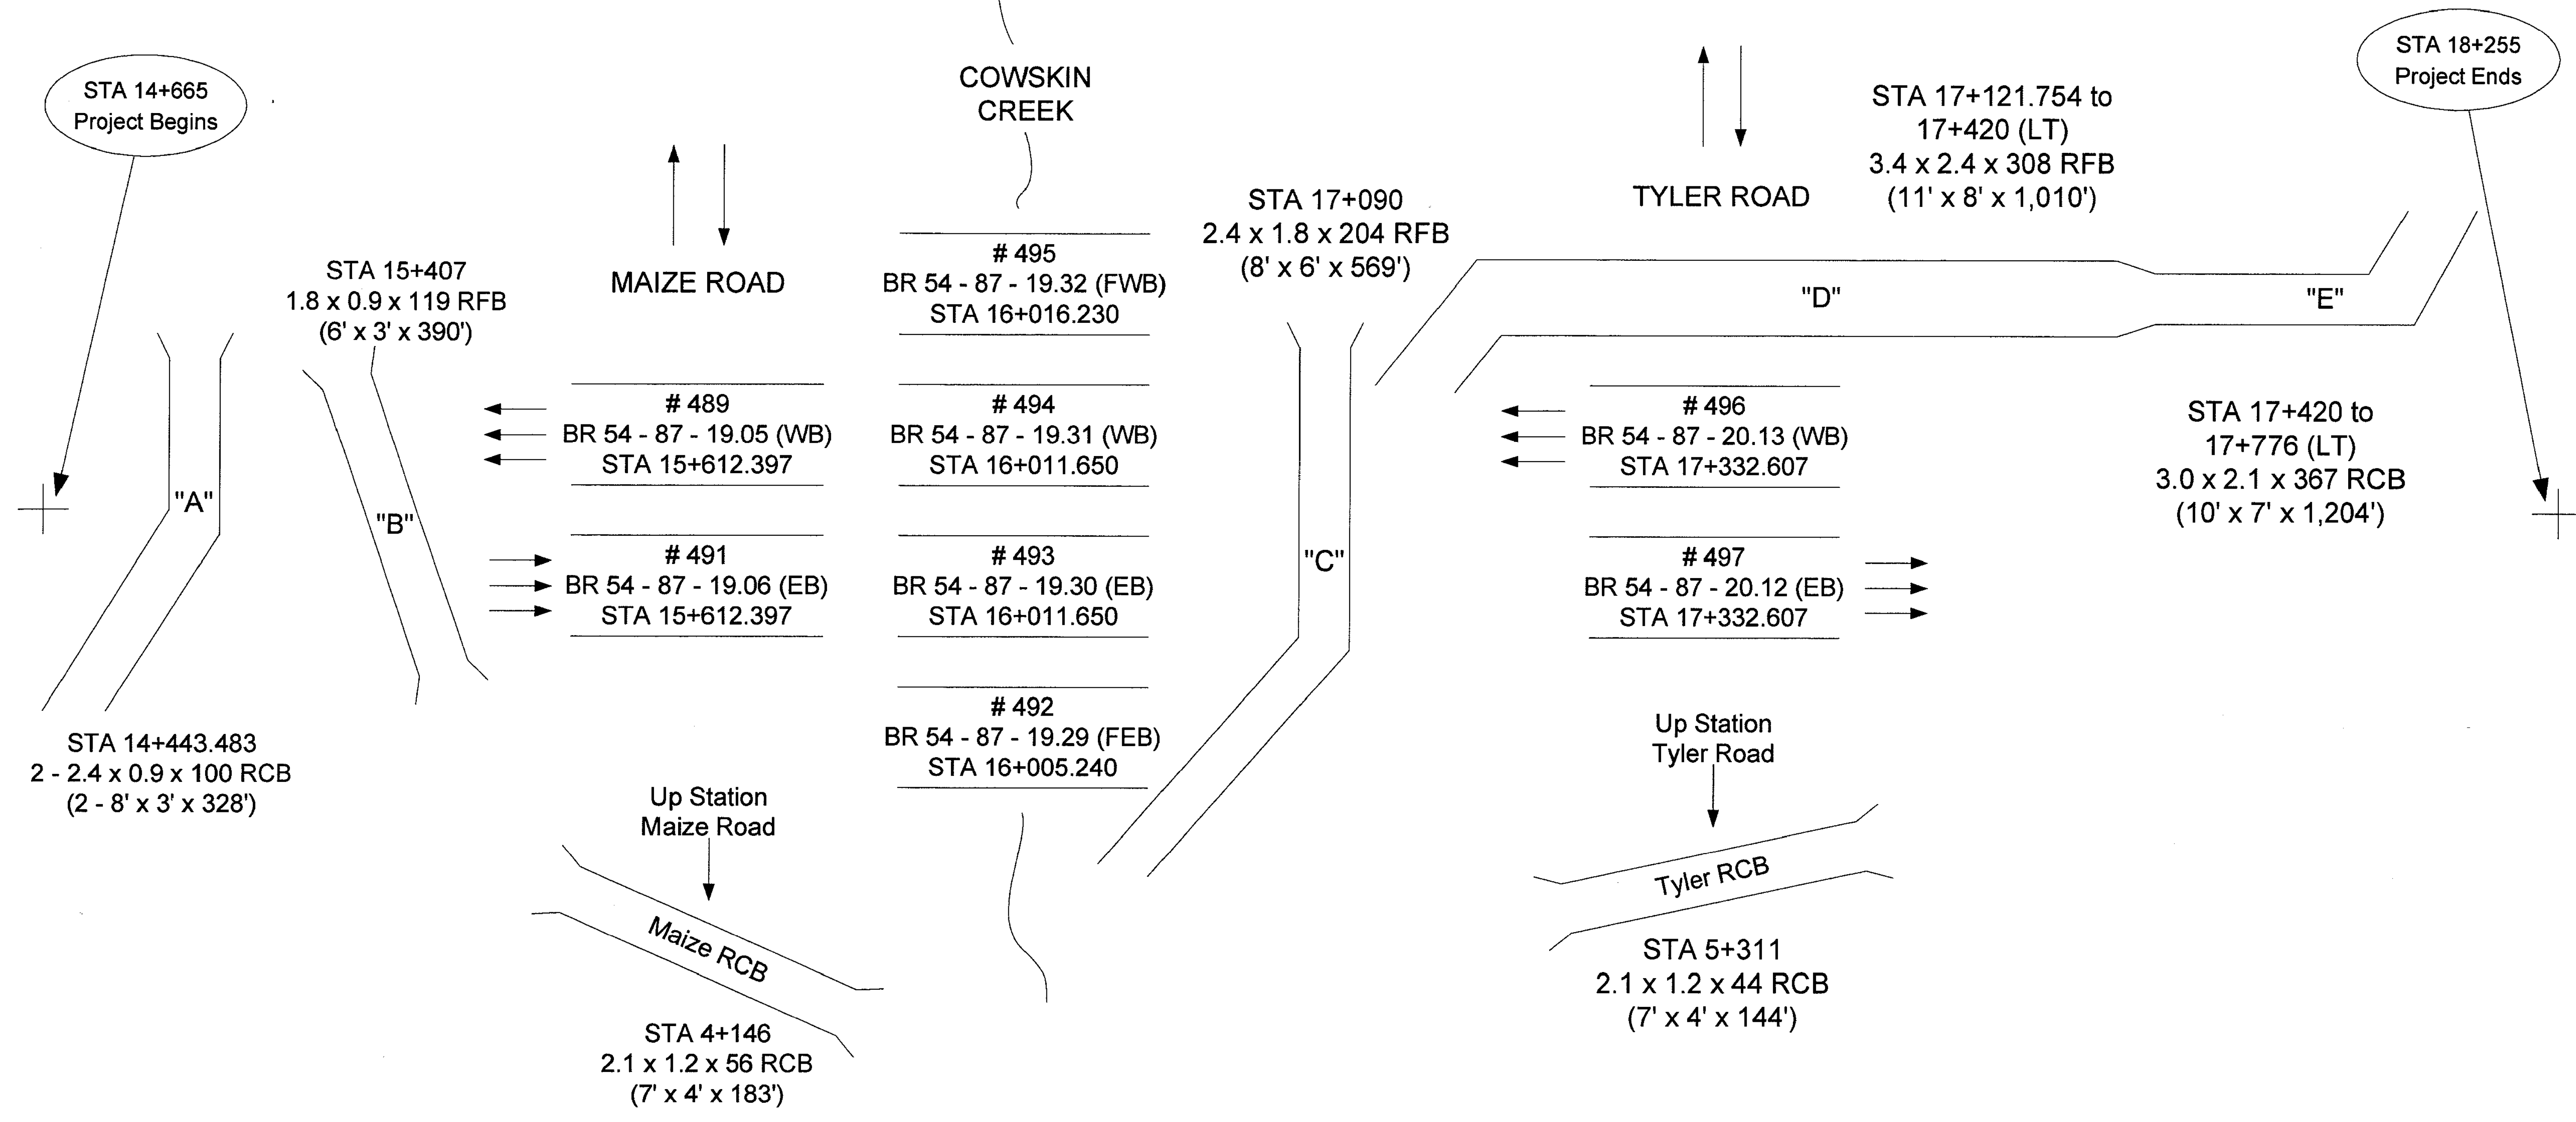


FHWA REGION NO.	STATE	PROJECT NO.	YEAR	SHEET NO.	TOTAL SHEETS
7	KANSAS	54-87 K-6657-01	2002	389a	1122

FIELD IDENTIFICATION for MAJOR DRAINAGE STRUCTURES

WEST KELLOGG FREEWAY - MAIZE and TYLER ROAD INTERCHANGES

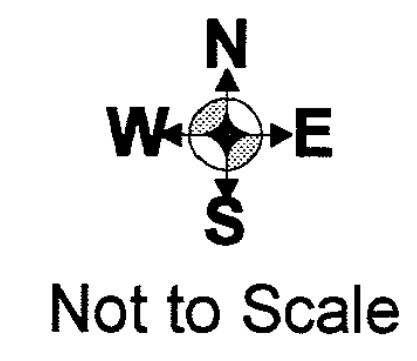

Professional Engineering Consultants, P.A.
 303 S. TOPEKA . WICHITA, KANSAS 67202 . 316-262-2691 . FAX 316-262-3003 . www.pec1.com . designers@pec1.com

DSWR: WDH OPER: JGP SCALE: i:/1997/97362/As-Builts/dgn/s/Val 2/V8_Files_With_Rasters/Sh 389a-Major_Drain_Struct.dgn Last Rev: 8-28-07 By: gdr