


STATE	PROJECT NO.	YEAR	SHEET NO.	TOTAL SHEETS
KANSAS	54-87 K-6657-01	2002	595	1122

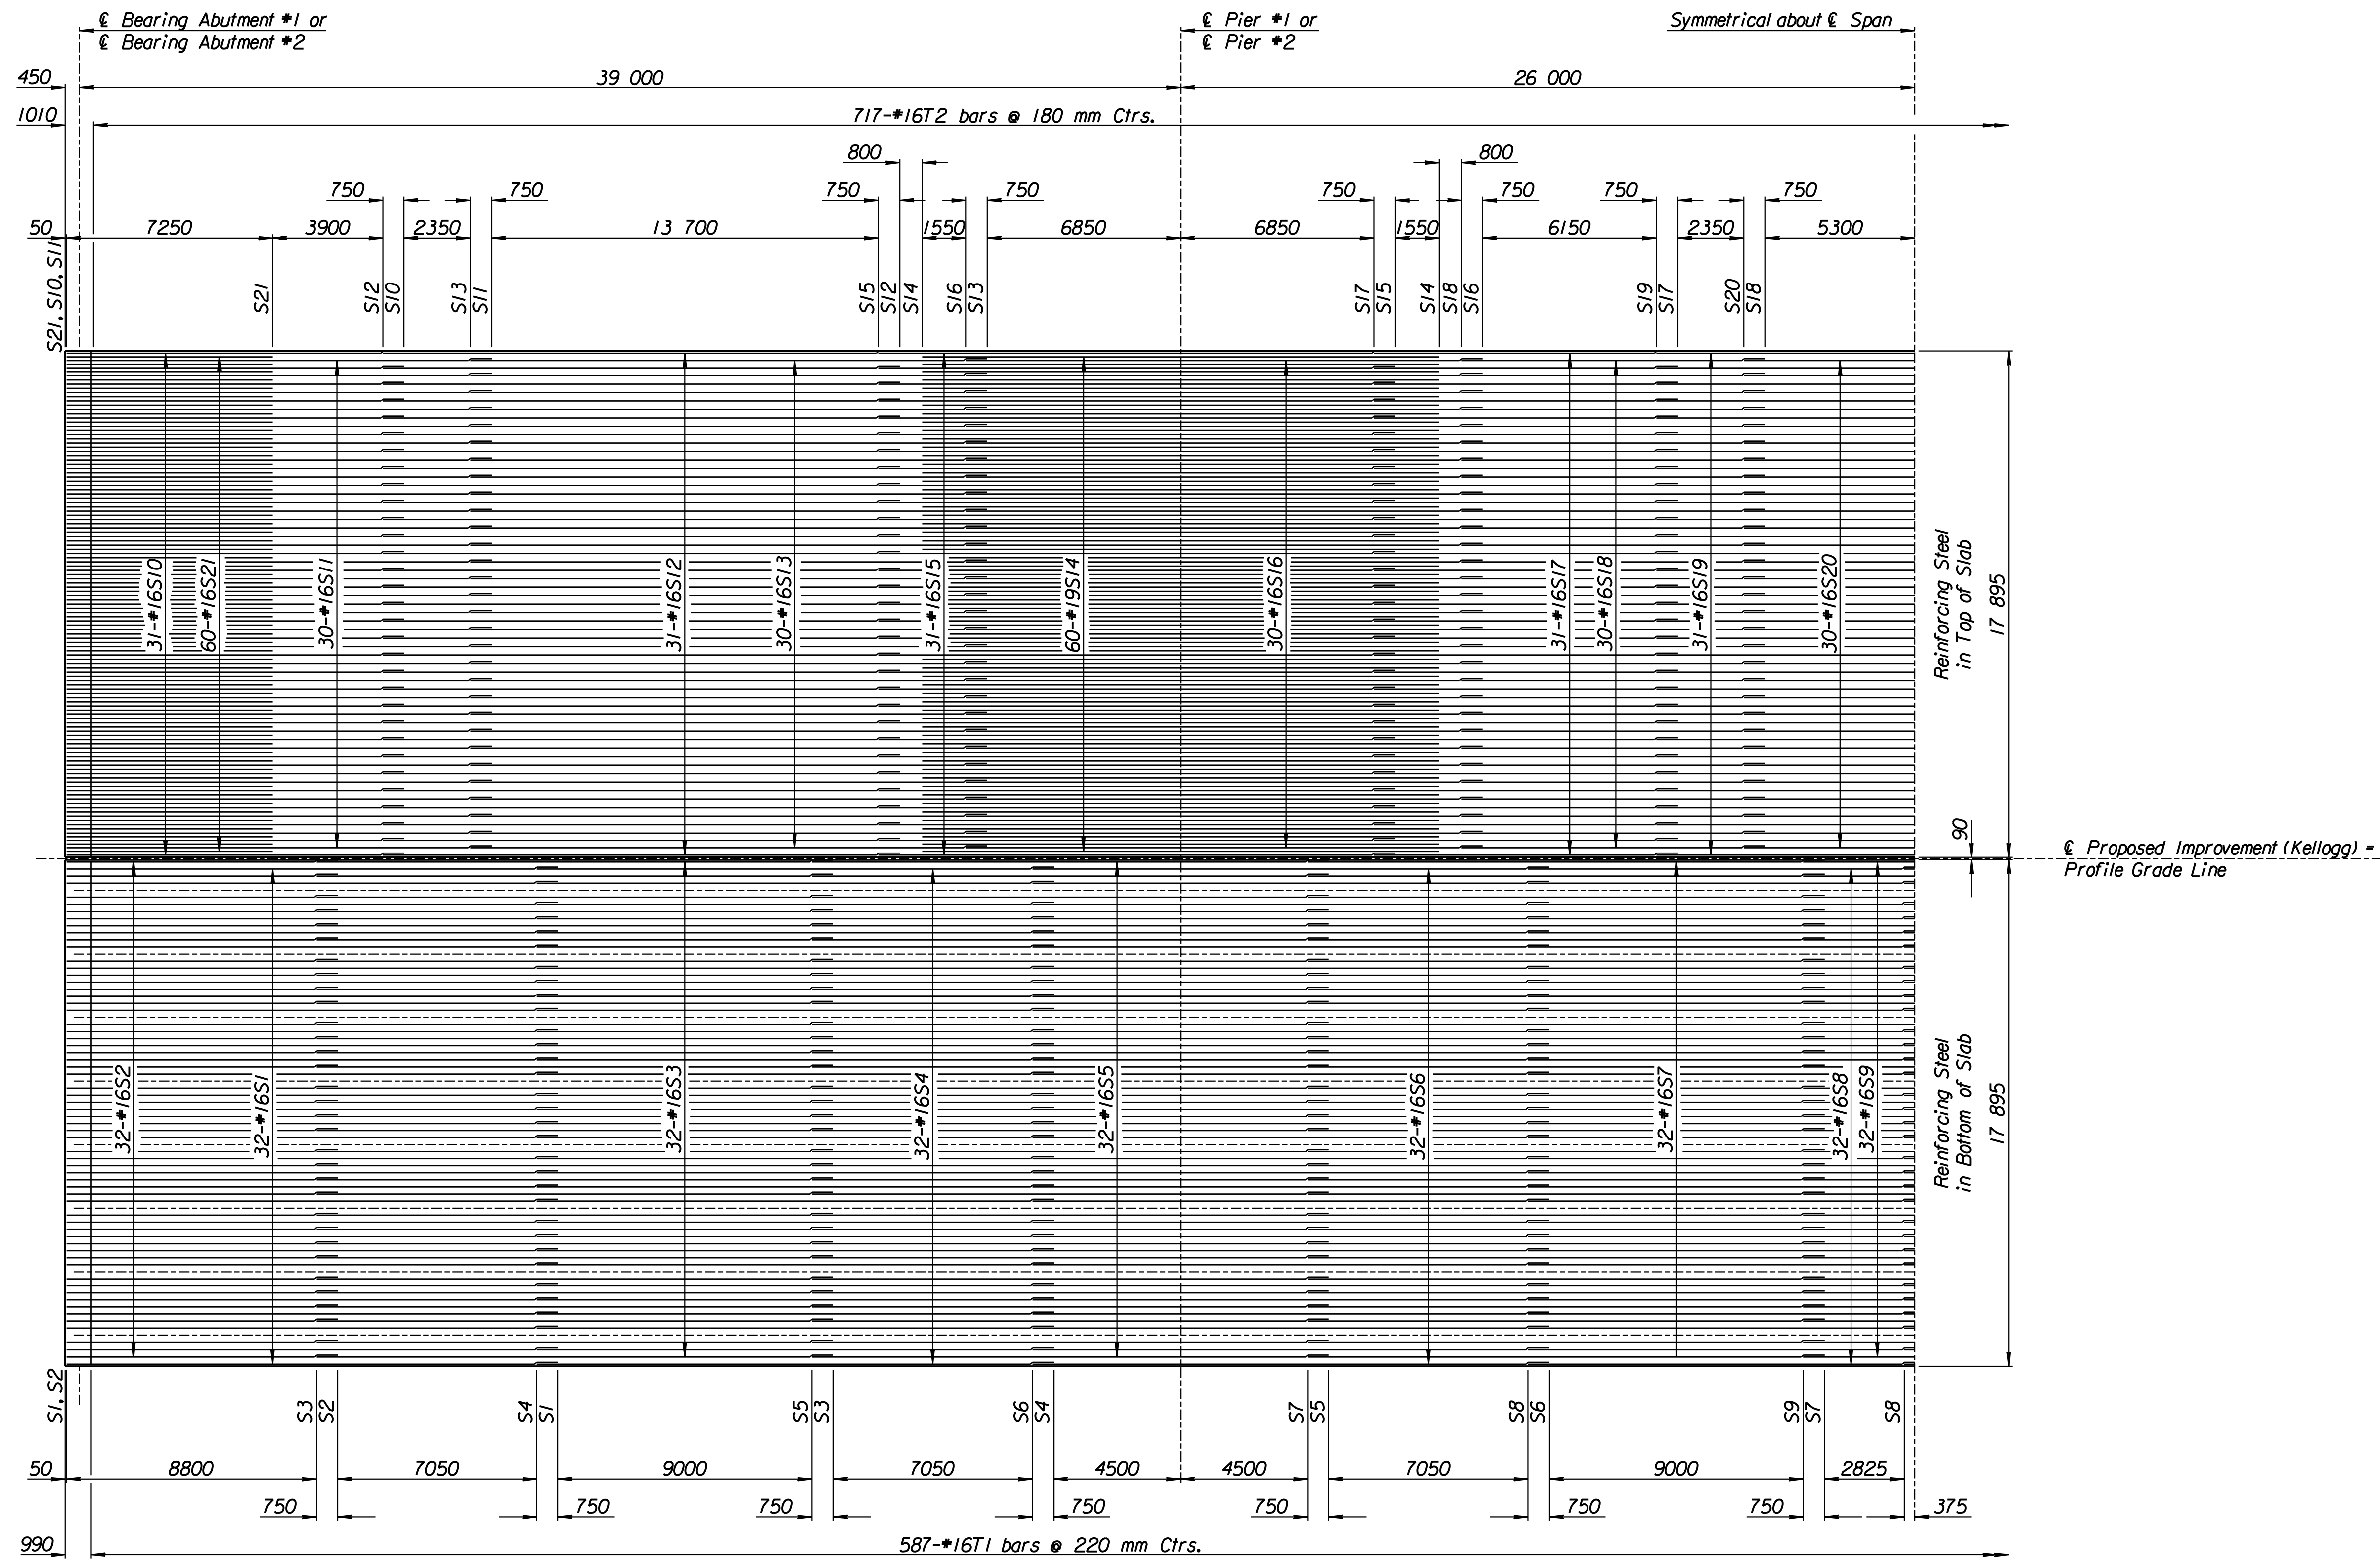

PLAN

Scale: 1/32"=1'-0"
 Drawn by: wil
 Plotted by: gdr
 1/1997/97/362/As-Builts/dgn/s/Vol_3/Sh_595-supplay.dgn Last Rev: 9-6-07 By: gdr

RECORD DRAWING

1			
No.	Revisions	By	Date
CITY OF WICHITA BR. NO. 54-87-20.13 (496) W.B. STA. 17+332.607 BR. NO. 54-87-20.12 (497) E.B. STA. 17+332.607 SUPERSTRUCTURE LAYOUT KELLOGG (US-54) OVER TYLER ROAD SEDGWICK COUNTY			
Professional Engineering Consultants, P.A. 303 S. TOPEKA • WICHITA, KANSAS 67202 316-262-2691 • FAX 316-262-3003			
Designed by	P.D.F.	Checked by	R.A.S.
Drawn by	W.L.L.	Date	Apr 11 2002
		Job No.	97362