



STATE	PROJECT NO.	YEAR	SHEET NO.	TOTAL SHEETS
KANSAS	54-87 K-6657-01	2002	745	1122

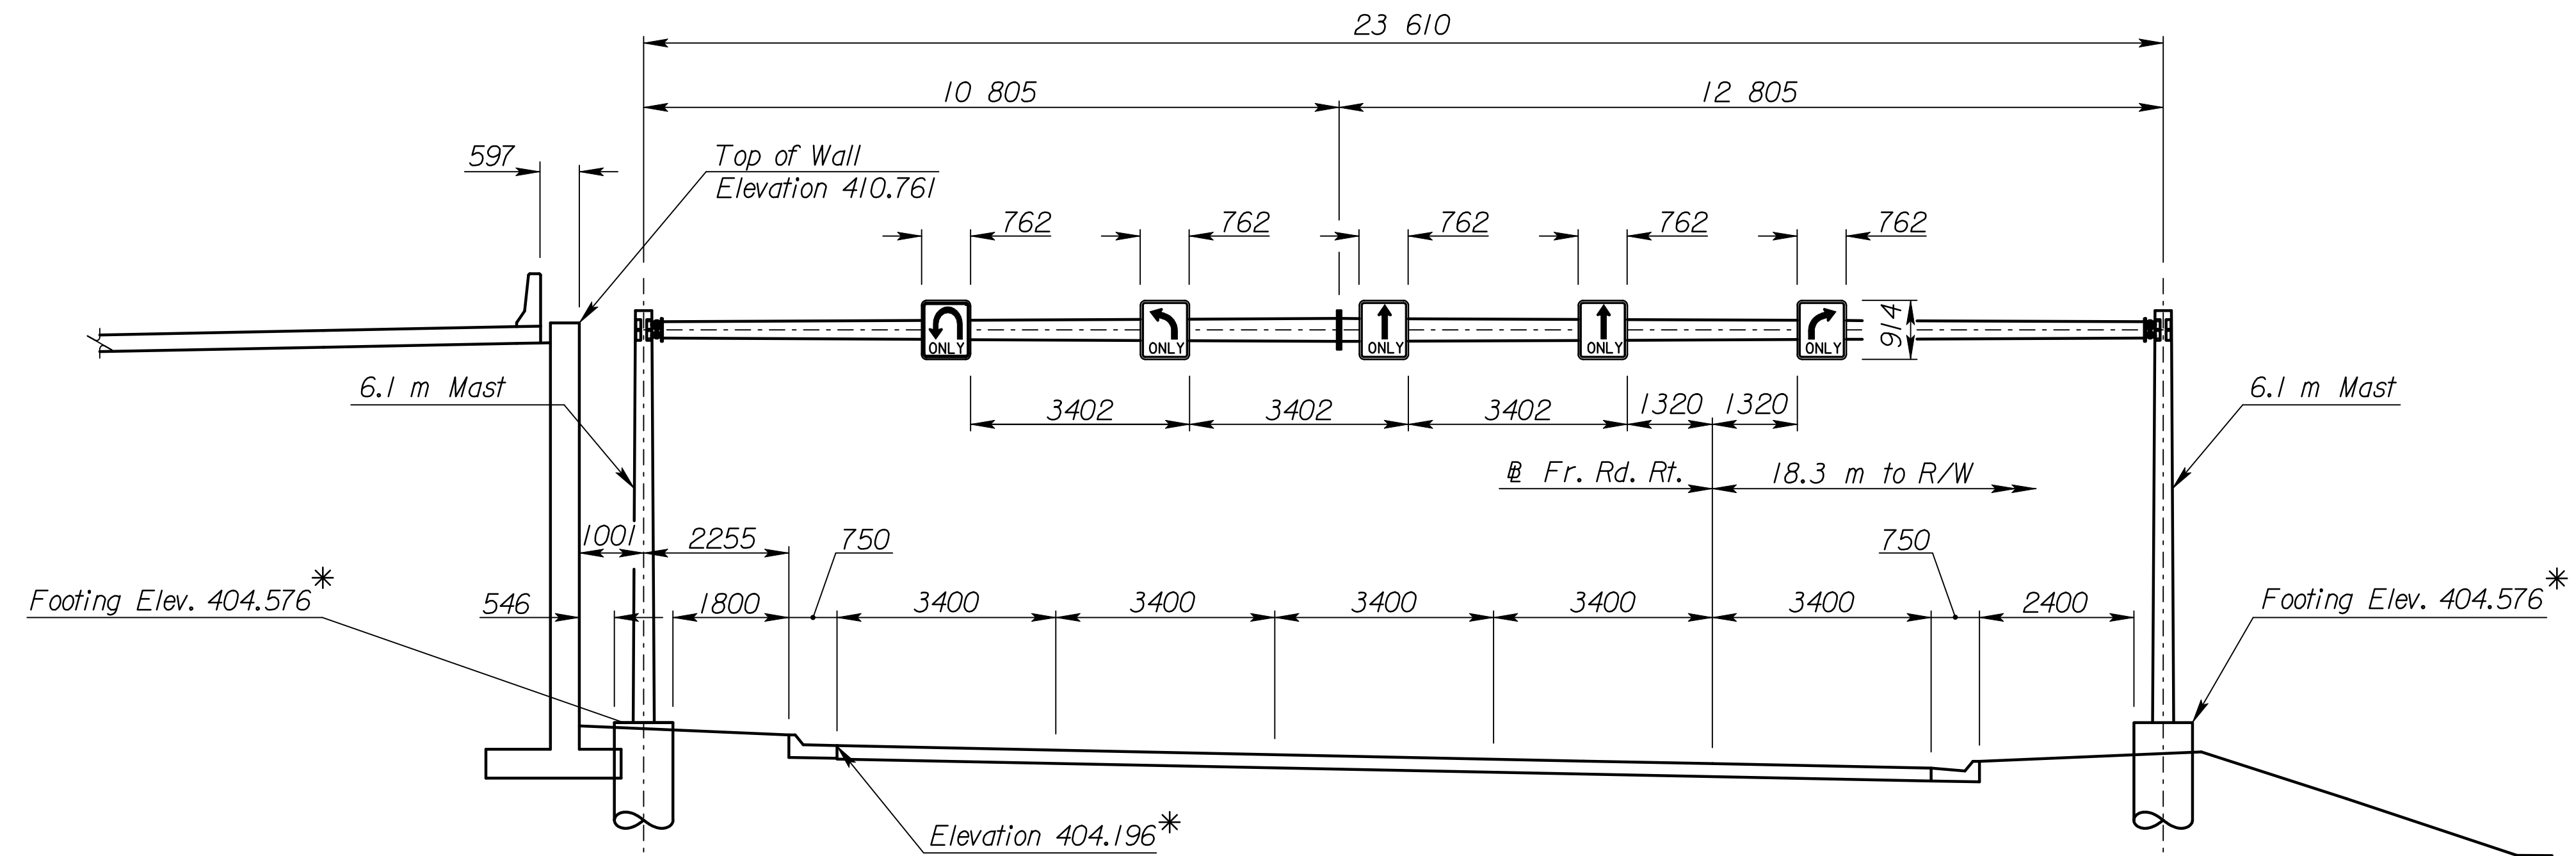

ELEVATION
Fr. Rd. Rt. Sta. 15+460

* Note: Vary the footing elevations as necessary to maintain a minimum vertical clearance of 5.300 m.

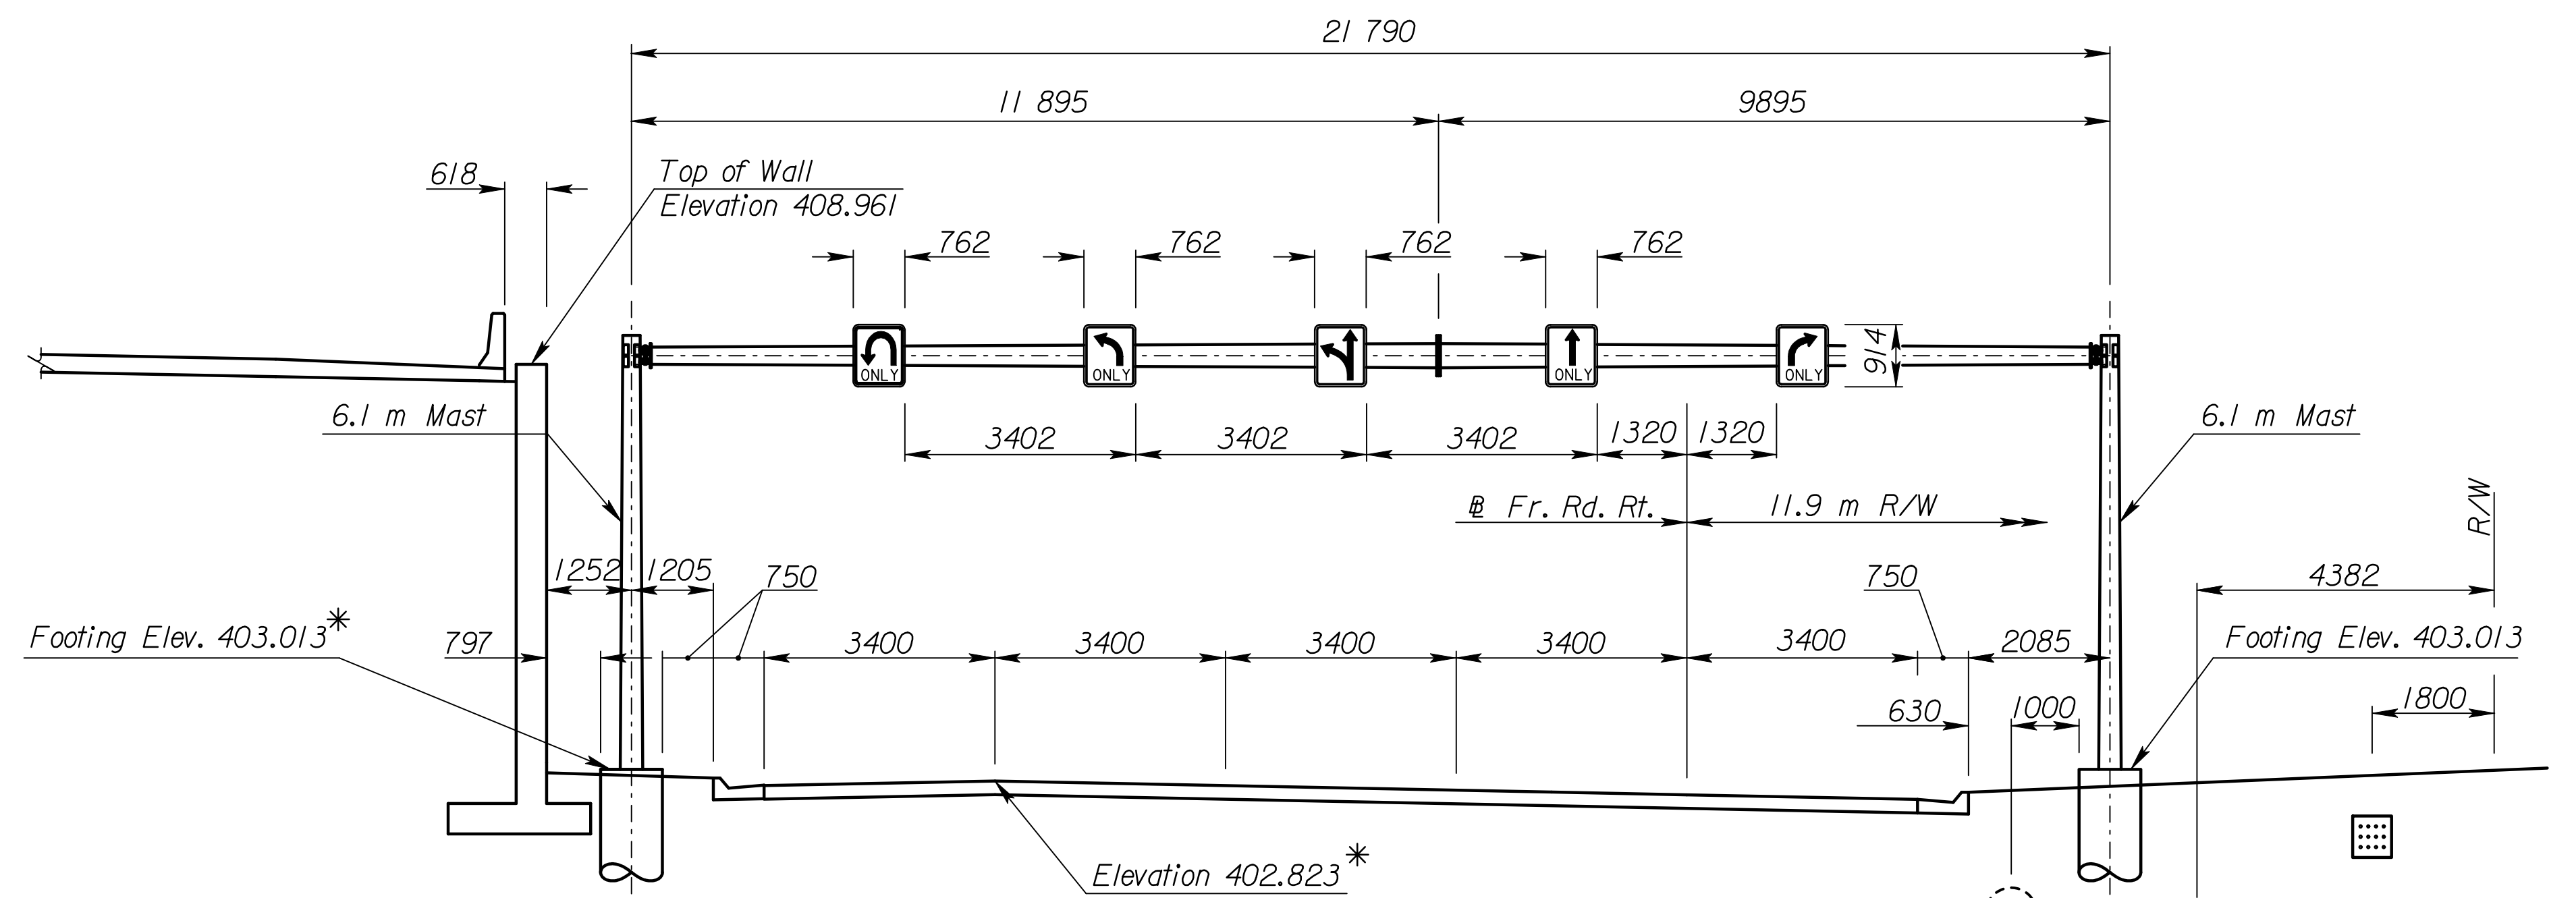

ELEVATION
Fr. Rd. Lt. Sta. 15+756

RECORD DRAWING

Scale = 1/000
I:\1997\97362\As-Builts\dgn's\Vol 4\Sh 745-KDOT STD-Sign-Mono Tubes.dgn Last Rev. 10-3-07 By: gdr

3					
2					
1					
NO.	DATE	REVISIONS	BY	APP'D	
KANSAS DEPARTMENT OF TRANSPORTATION					
SINGLE TAPERED TUBE SPAN TYPE OVERHEAD SIGN STRUCTURE CONSTRUCTION LAYOUT					
PROJ. NO. 54-87 K-6657-01			SEDGWICK CO.		
SHEET NO. 1 OF 44	SCALE	APP'D			
DESIGNED SMB	DETAILED SMB	QUANTITIES	CADD		
DESIGN CK.	DETAIL CK.	QUAN. CK.	CADD CK.		