


ELEVATION

\* Note: Use this point as a control point for all elevations.

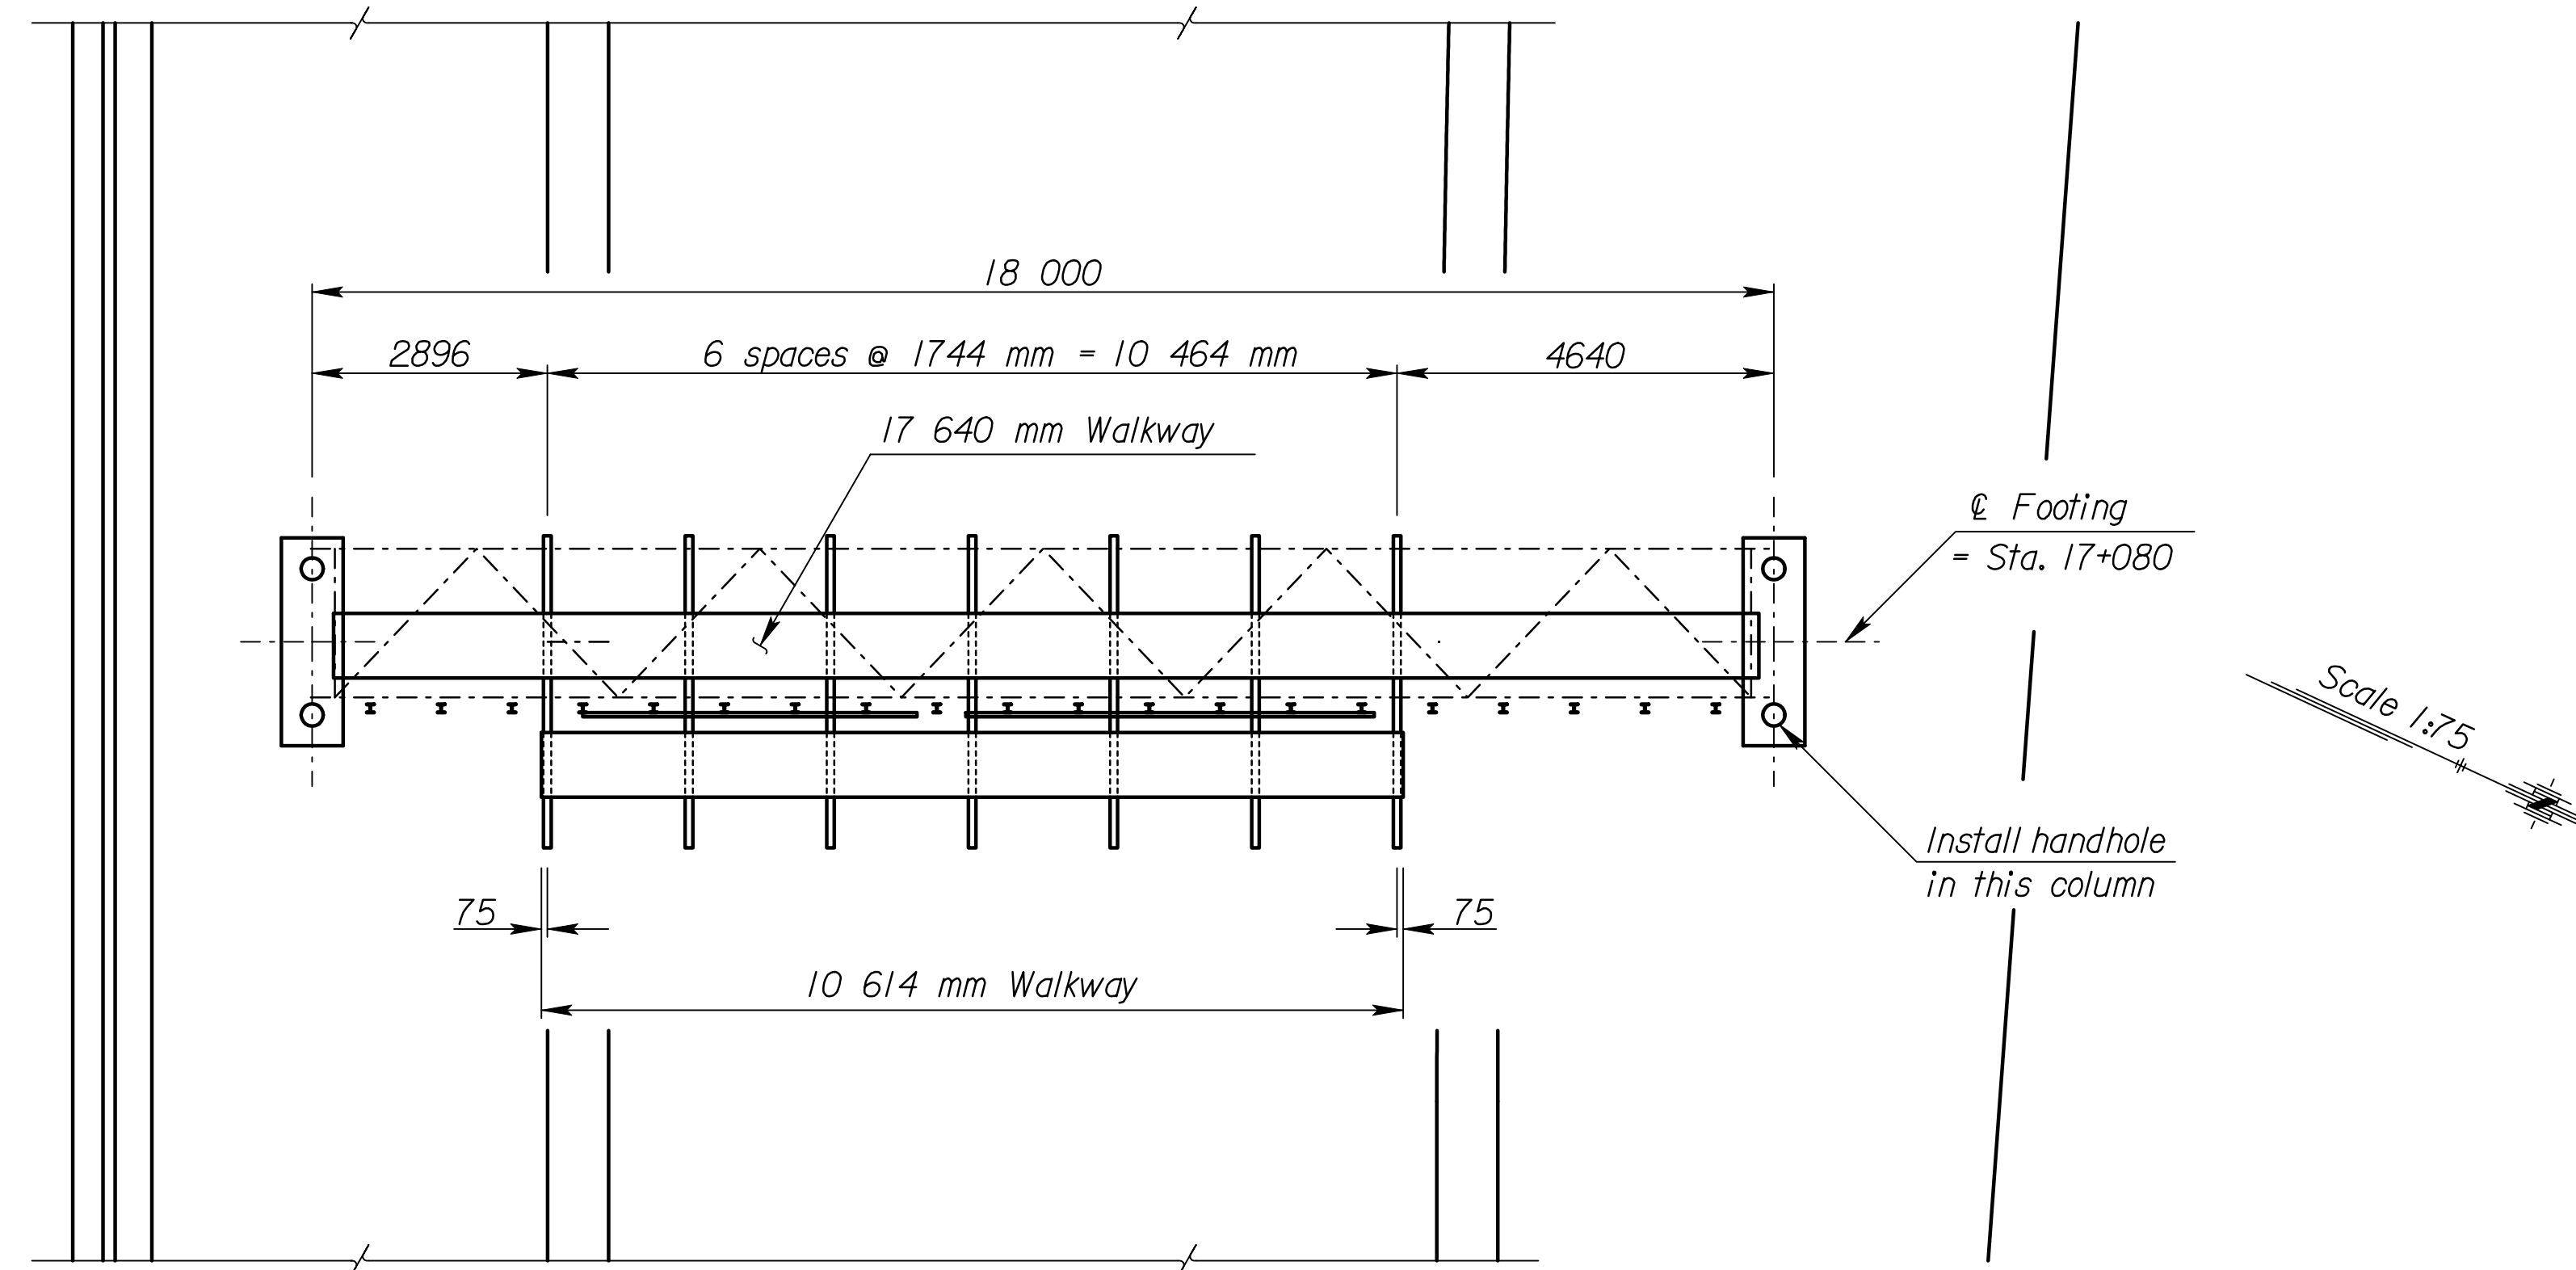

PLAN

ALUMINUM DETAILS			
TRUSS	Member 1 Wall Thickness		3.76
	Member 2 Wall Thickness		3.05
	N = 10	X = 280 S = 1744	Camber = 22
END SUPPORTS	Member 1 Wall Thickness		4.19
	Member 2 Wall Thickness		3.05
	Left	N = 3 S = 1535 L = 7025	
	Right	N = 3 S = 1600 L = 7220	
FOOTINGS	Left Type	B	Right Type B

3				
2				
1				
NO.	DATE	REVISIONS	BY	APP'D

KANSAS DEPARTMENT OF TRANSPORTATION  
 WB US-54 Fr. Rd. Lt. STATION 17+080  
 SPAN TYPE OVERHEAD SIGN STRUCTURE  
 CONSTRUCTION LAYOUT  
 ALUMINUM ALTERNATE

**RECORD DRAWING**

PROJ. NO. 54-87 K-6657-01	SEDGWICK CO.				
SHEET NO. 14 OF 44	SCALE				
DESIGNED	SMB	DETAILED	SMB	QUANTITIES	CADD
DESIGN CK.	DETAIL CK.	QUAN. CK.	CADD CK.		