


FHWA REGION NO.	STATE	PROJECT NO.	YEAR	SHEET NO.	TOTAL SHEETS
7	KANSAS	54-87 K-6657-01	2002	806	1122

DATE	
BY	
REFERENCES NOTED	
REFERENCES CHECKED	

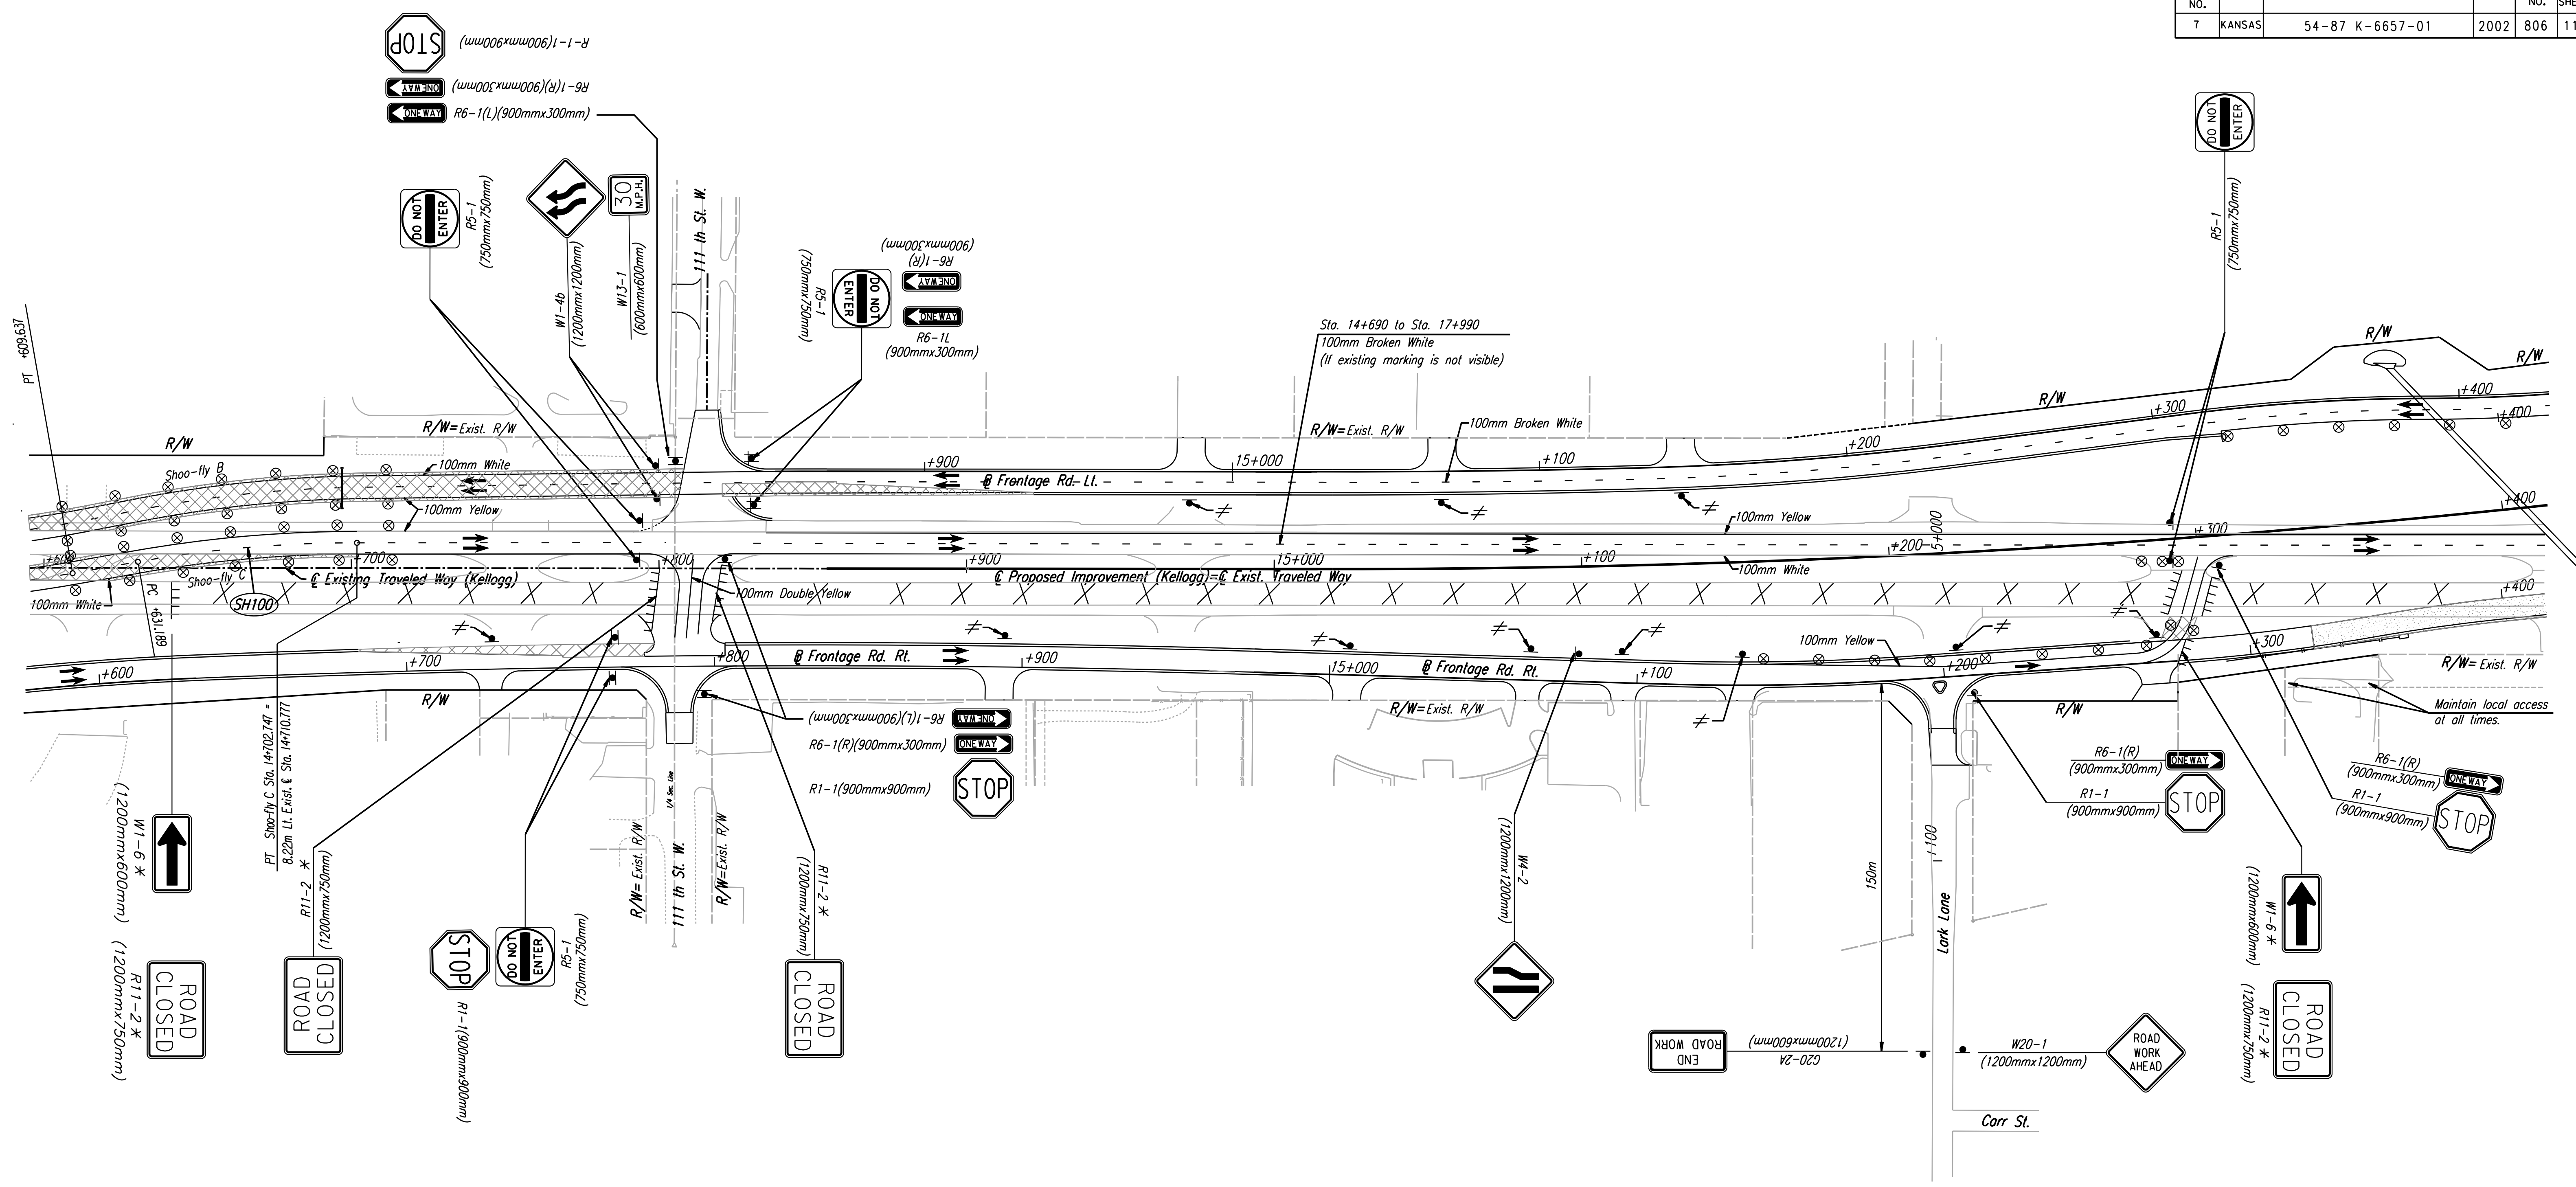

DSNR: OPER: JGP Scale: 1:1000
 12/1997/197362/As-Built/dgn/s/Vol 4/Sh 806-TC Stage 2a-pl 46rev.dgn Last Rev: 10-4-07 By: gdr

No.	Revisions	By	Date

CITY OF WICHITA
TRAFFIC CONTROL
STAGE 2A & 2B
STA. 14+600 TO STA. 15+400
 SEDGWICK COUNTY

Professional Engineering Consultants, P.A.
 303 S. TOPEKA • WICHITA, KANSAS 67202
 316-262-2691 • FAX 316-262-3003

Designed by	RPC, RWM	Checked by	WDH
Drawn by	JGP	Date	April, 2002
		Job No.	97362