


FHWA REGION NO.	STATE	PROJECT NO.	YEAR	SHEET NO.	TOTAL SHEETS
7	KANSAS	54-87 K-6657-01	2002	814B	1122

DATE	
BY	
REFERENCES NOTED	
REFERENCES CHECKED	

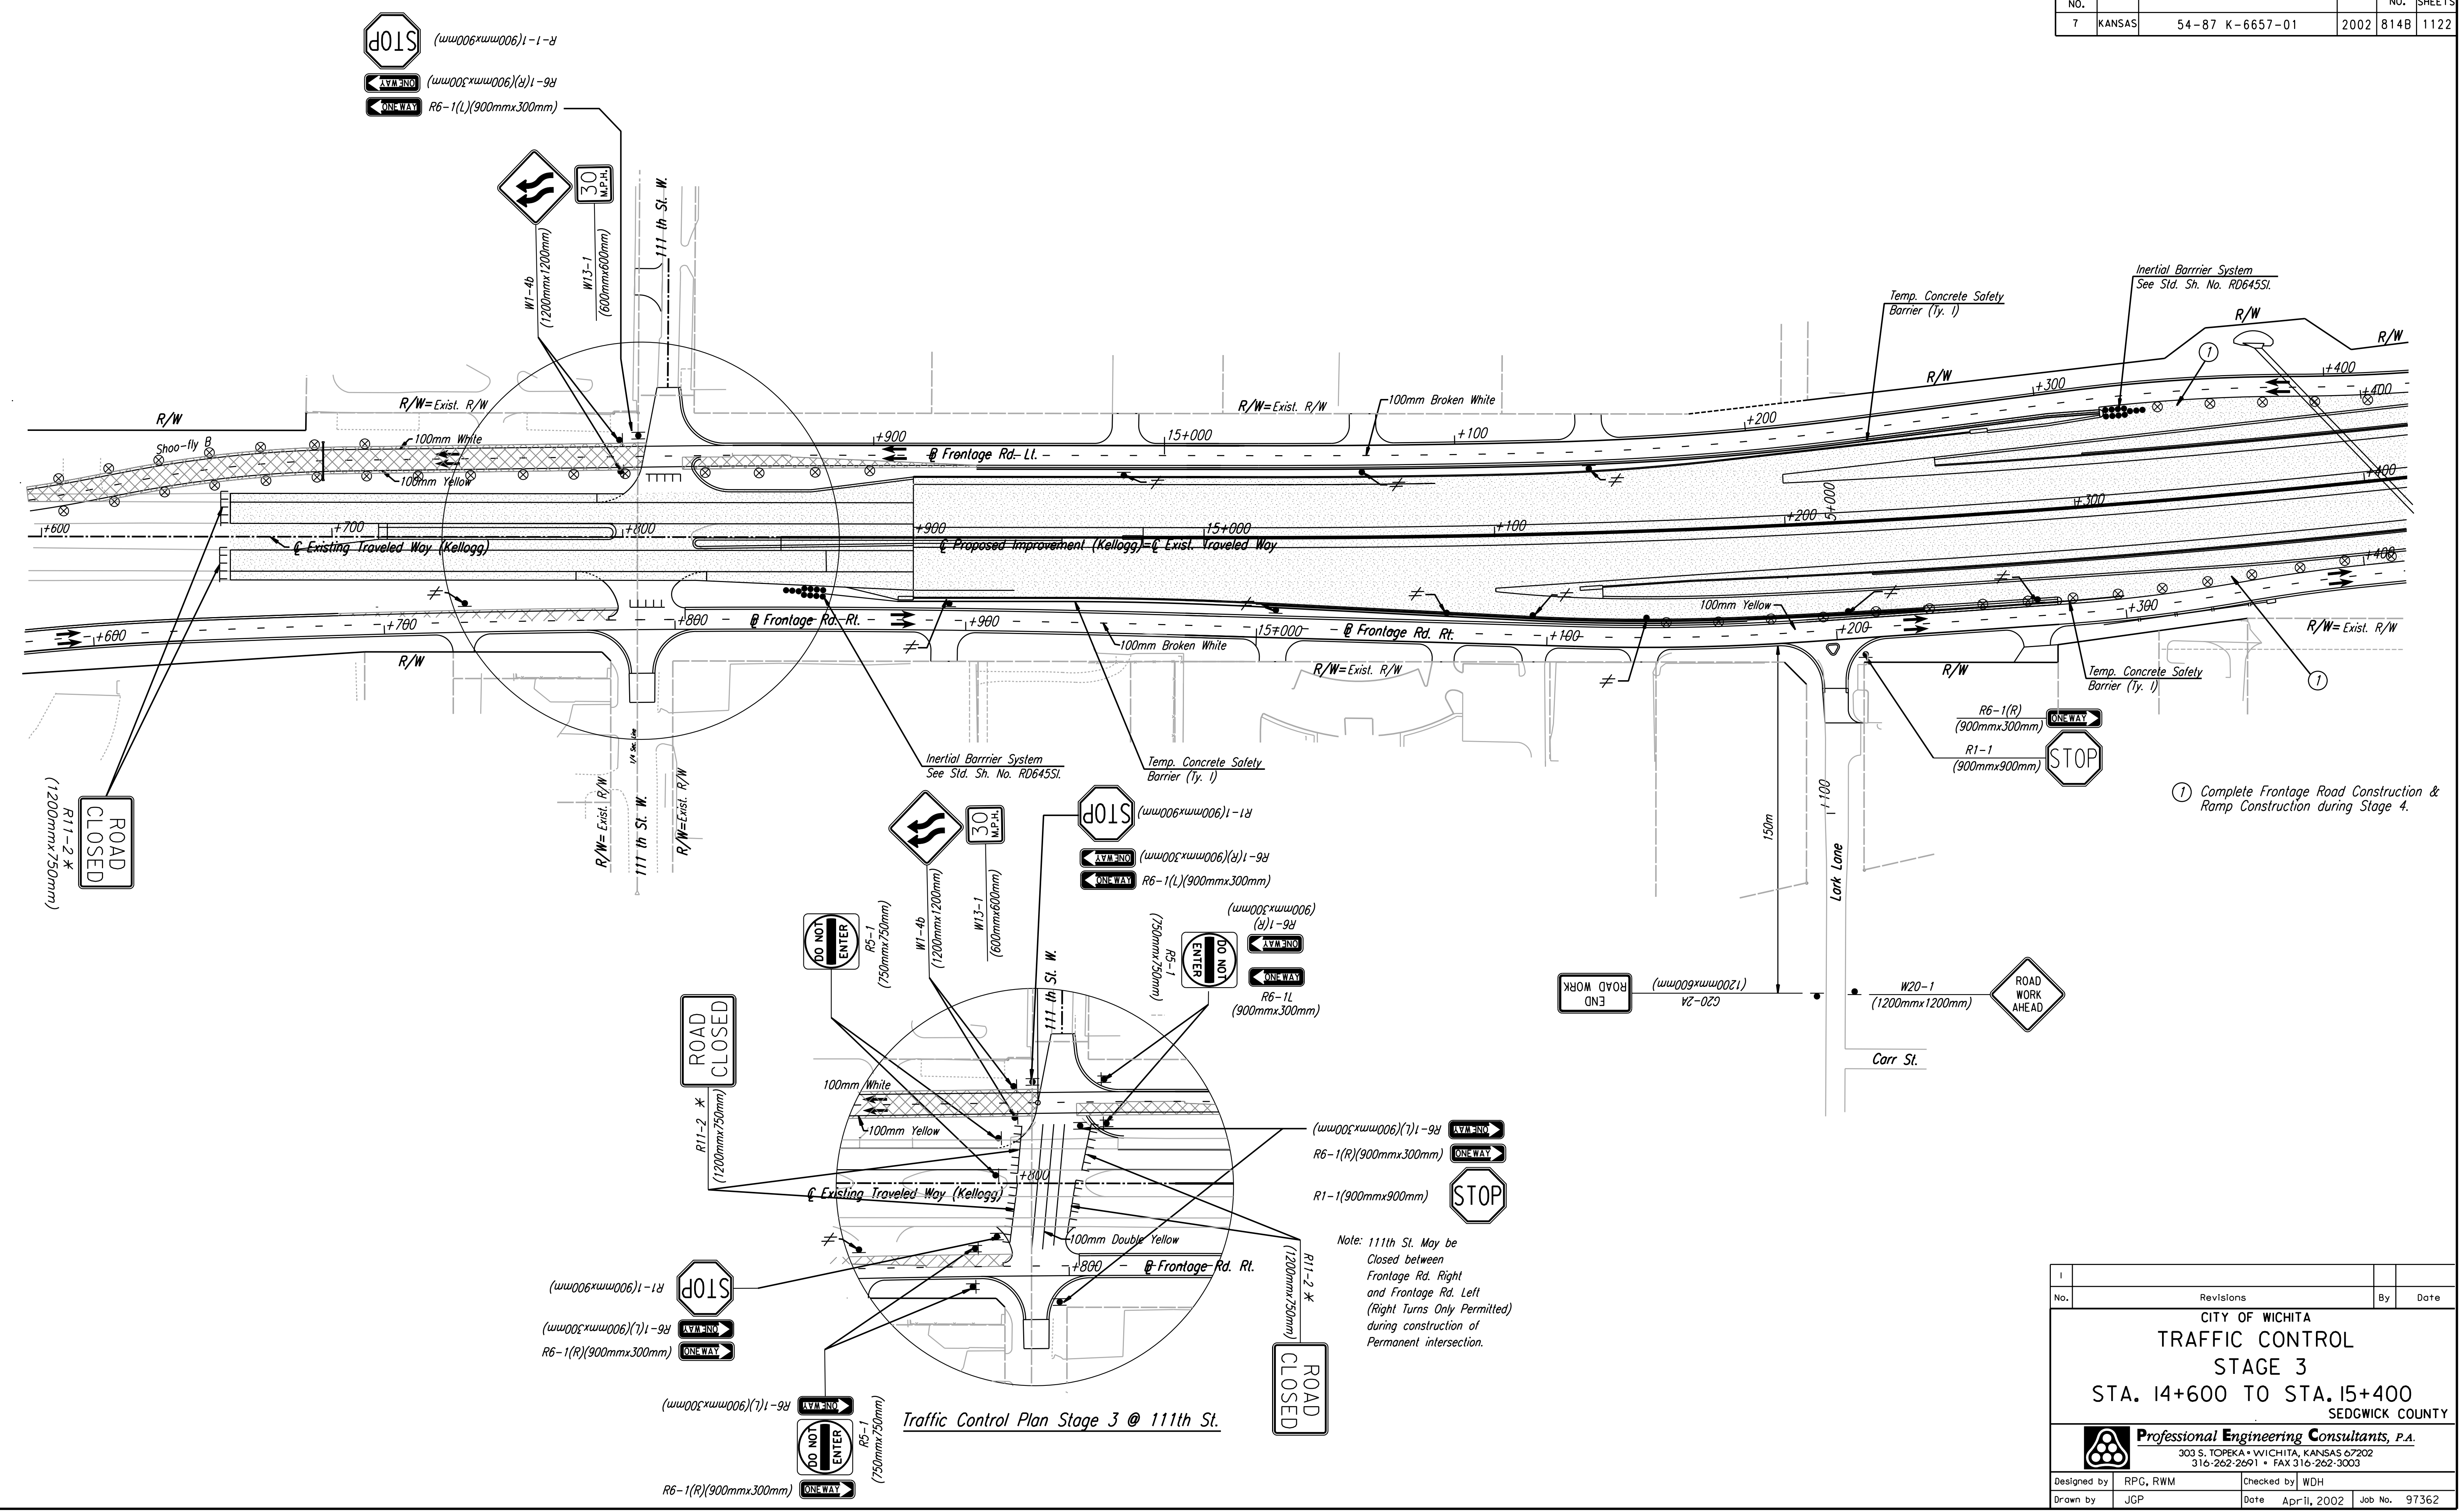

DSNR: OPER: JGP Scale: 1:1000  
 12/1997/197-362/As-Built/dgn/s/Vol 4/Sh 814b.TC Stage 3-pl/46.dgn Last Rev: 10-5-07 By: gdr

CITY OF WICHITA			
TRAFFIC CONTROL			
STAGE 3			
STA. 14+600 TO STA. 15+400			
SEDGWICK COUNTY			
Professional Engineering Consultants, P.A.			
303 S. TOPEKA • WICHITA, KANSAS 67202			
316-262-2691 • FAX 316-262-3003			
Designed by	RPC, RWM	Checked by	WDH
Drawn by	JGP	Date	April, 2002
		Job No.	97362