


REG NO.	STATE	PROJECT NO.	YEAR	SHEET NO.	TOTAL SHEETS
7	KANSAS	54-87 K-6657-01	2002	898	1122

FINAL SURVEY NO.	BY	DATE
FINAL SURVEY NOTE BOOK NO.	SURVEYED AREAS	PLOTTED TEMPLATE AREAS

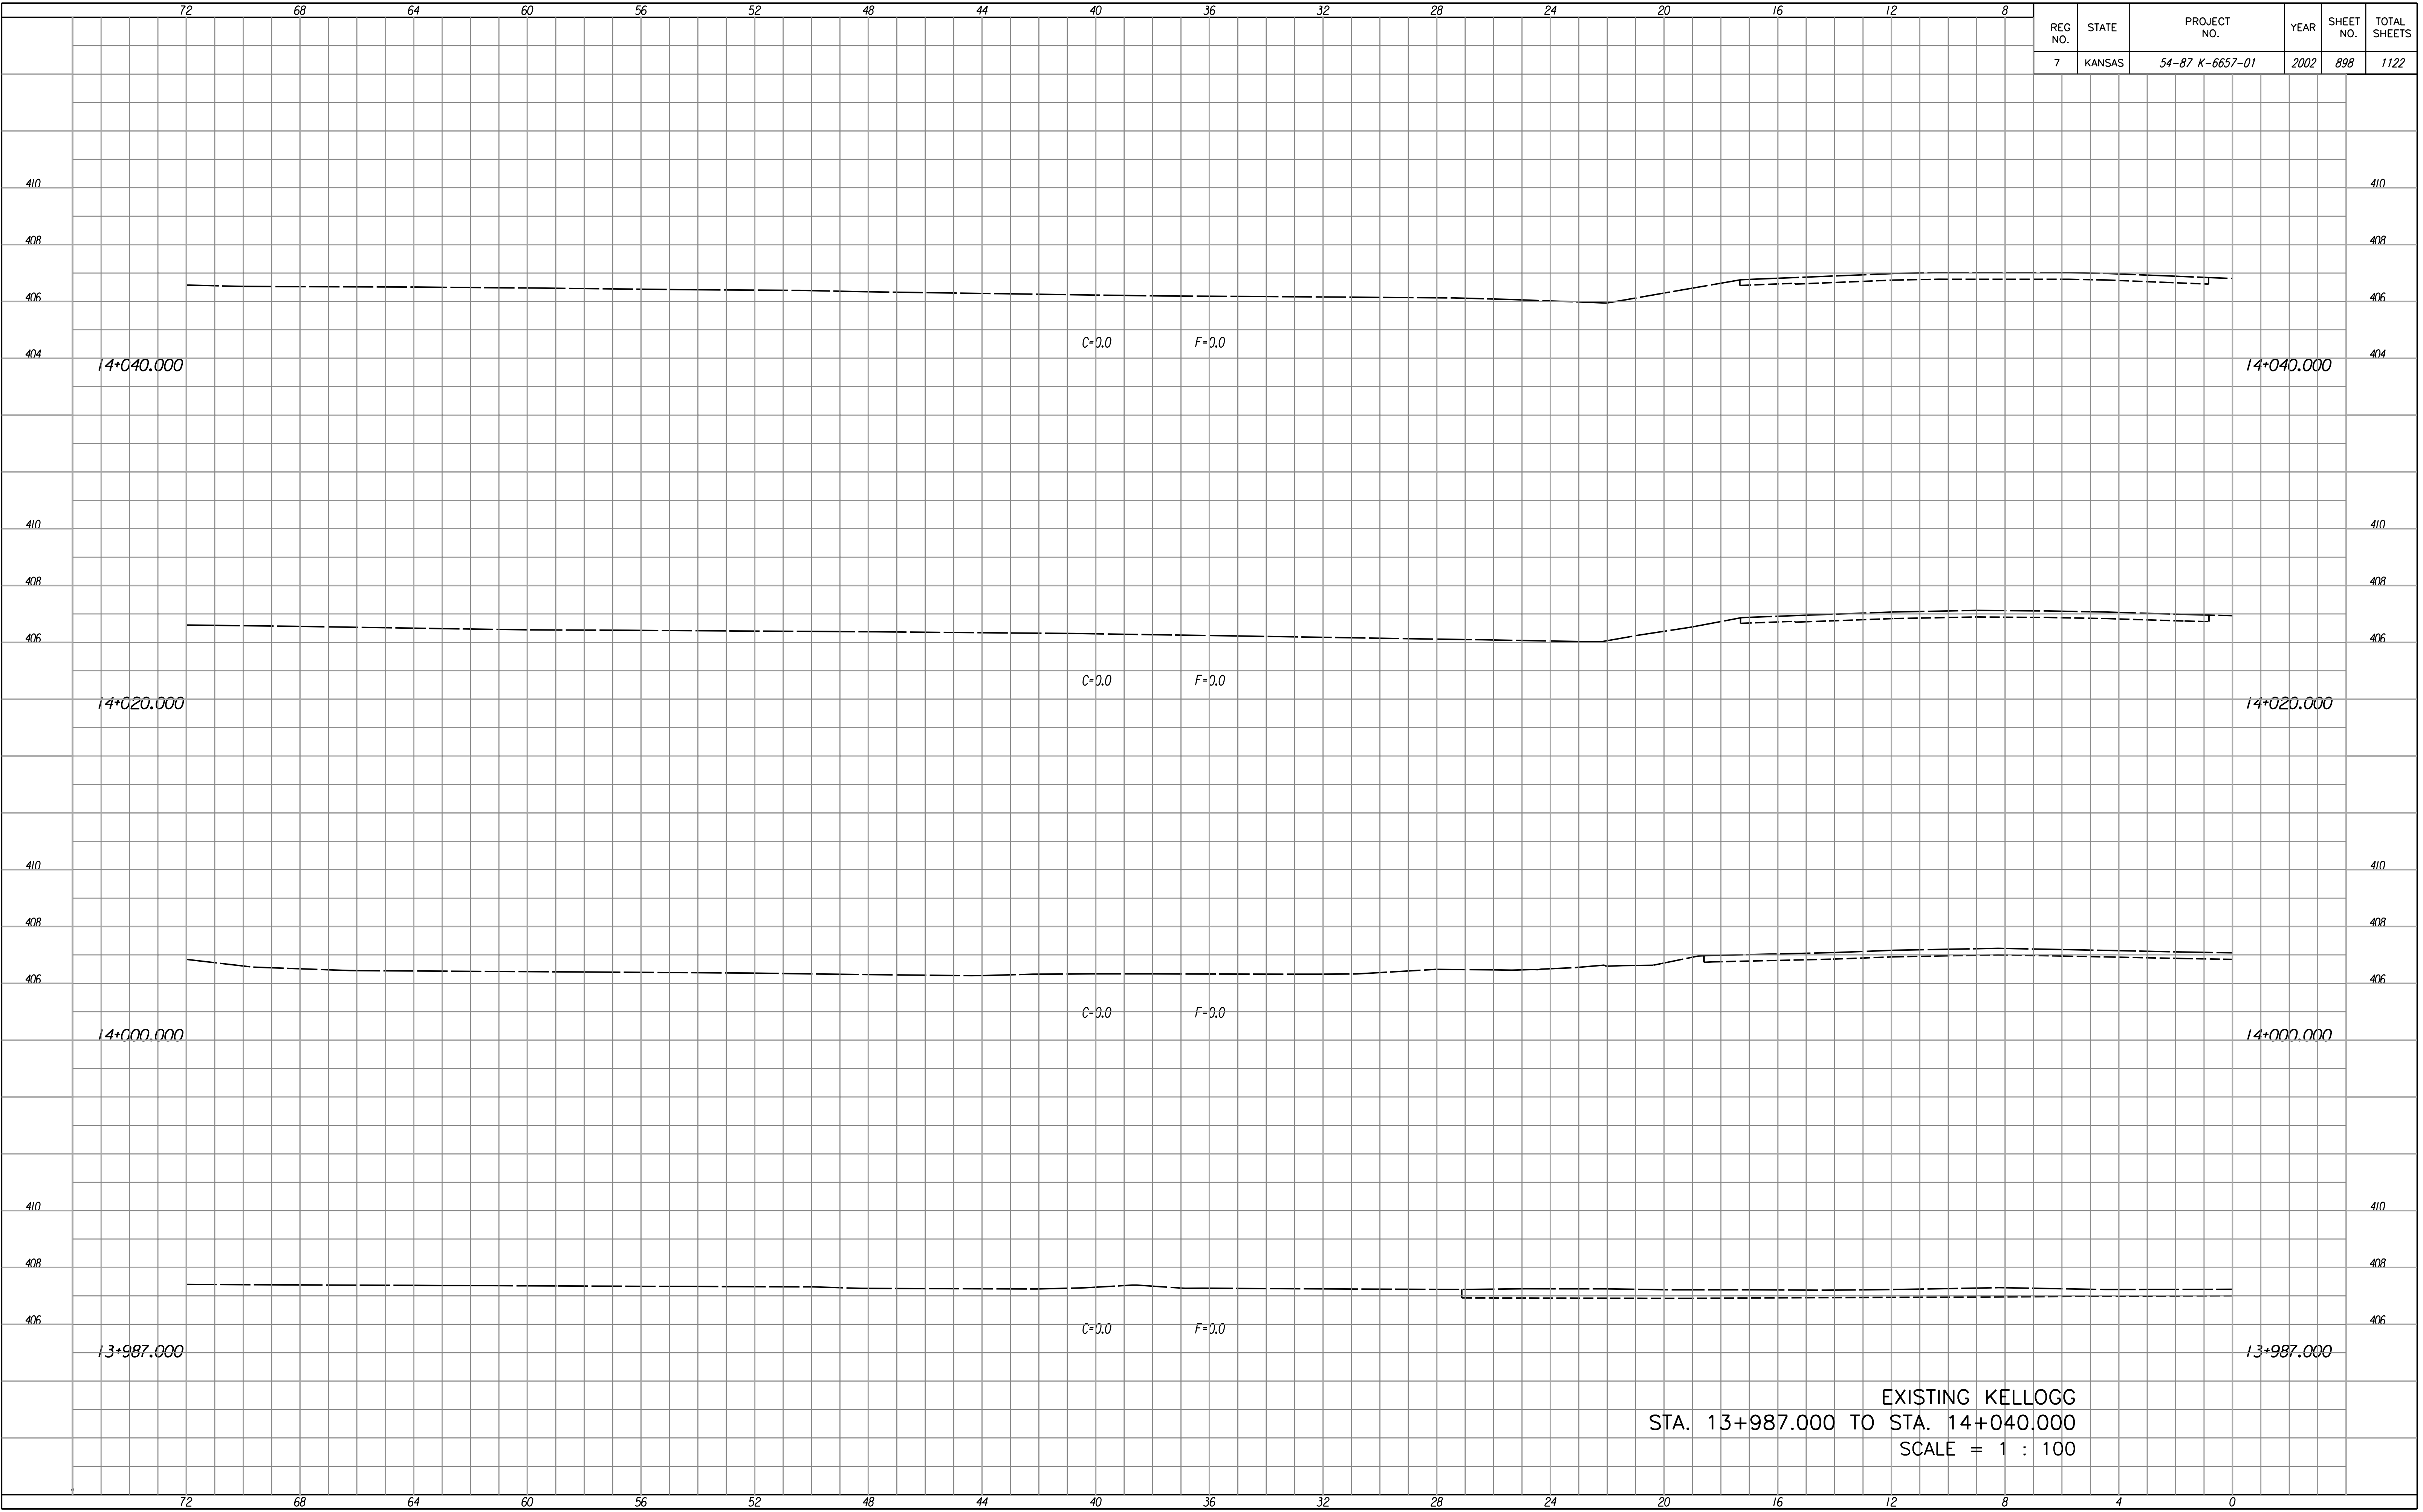

Scale : 100
 Last Rev : 10-12-07 By: ndr
 Design File : I:\1997\97362\As-Built\dgn\Vol 5\Sh 0898-Mainline-x3139871.dgn