


REG. NO.	STATE	PROJECT NO.	YEAR	SHEET NO.	TOTAL SHEETS
7	KANSAS	54-87 K-6657-01	2002	918	1122

FINAL SURVEY NO.	BY	DATE
SURVEYED		
PLOTTED		
TEMPLATE AREAS CHECKED		

Scale : 100  
 Last Rev. : 10-12-07 By: gdr  
 Design File : i:/1997/97662/As-Built/dgn/s/Vol 5/Sh 0918-Mainline-rs14740L.dgn

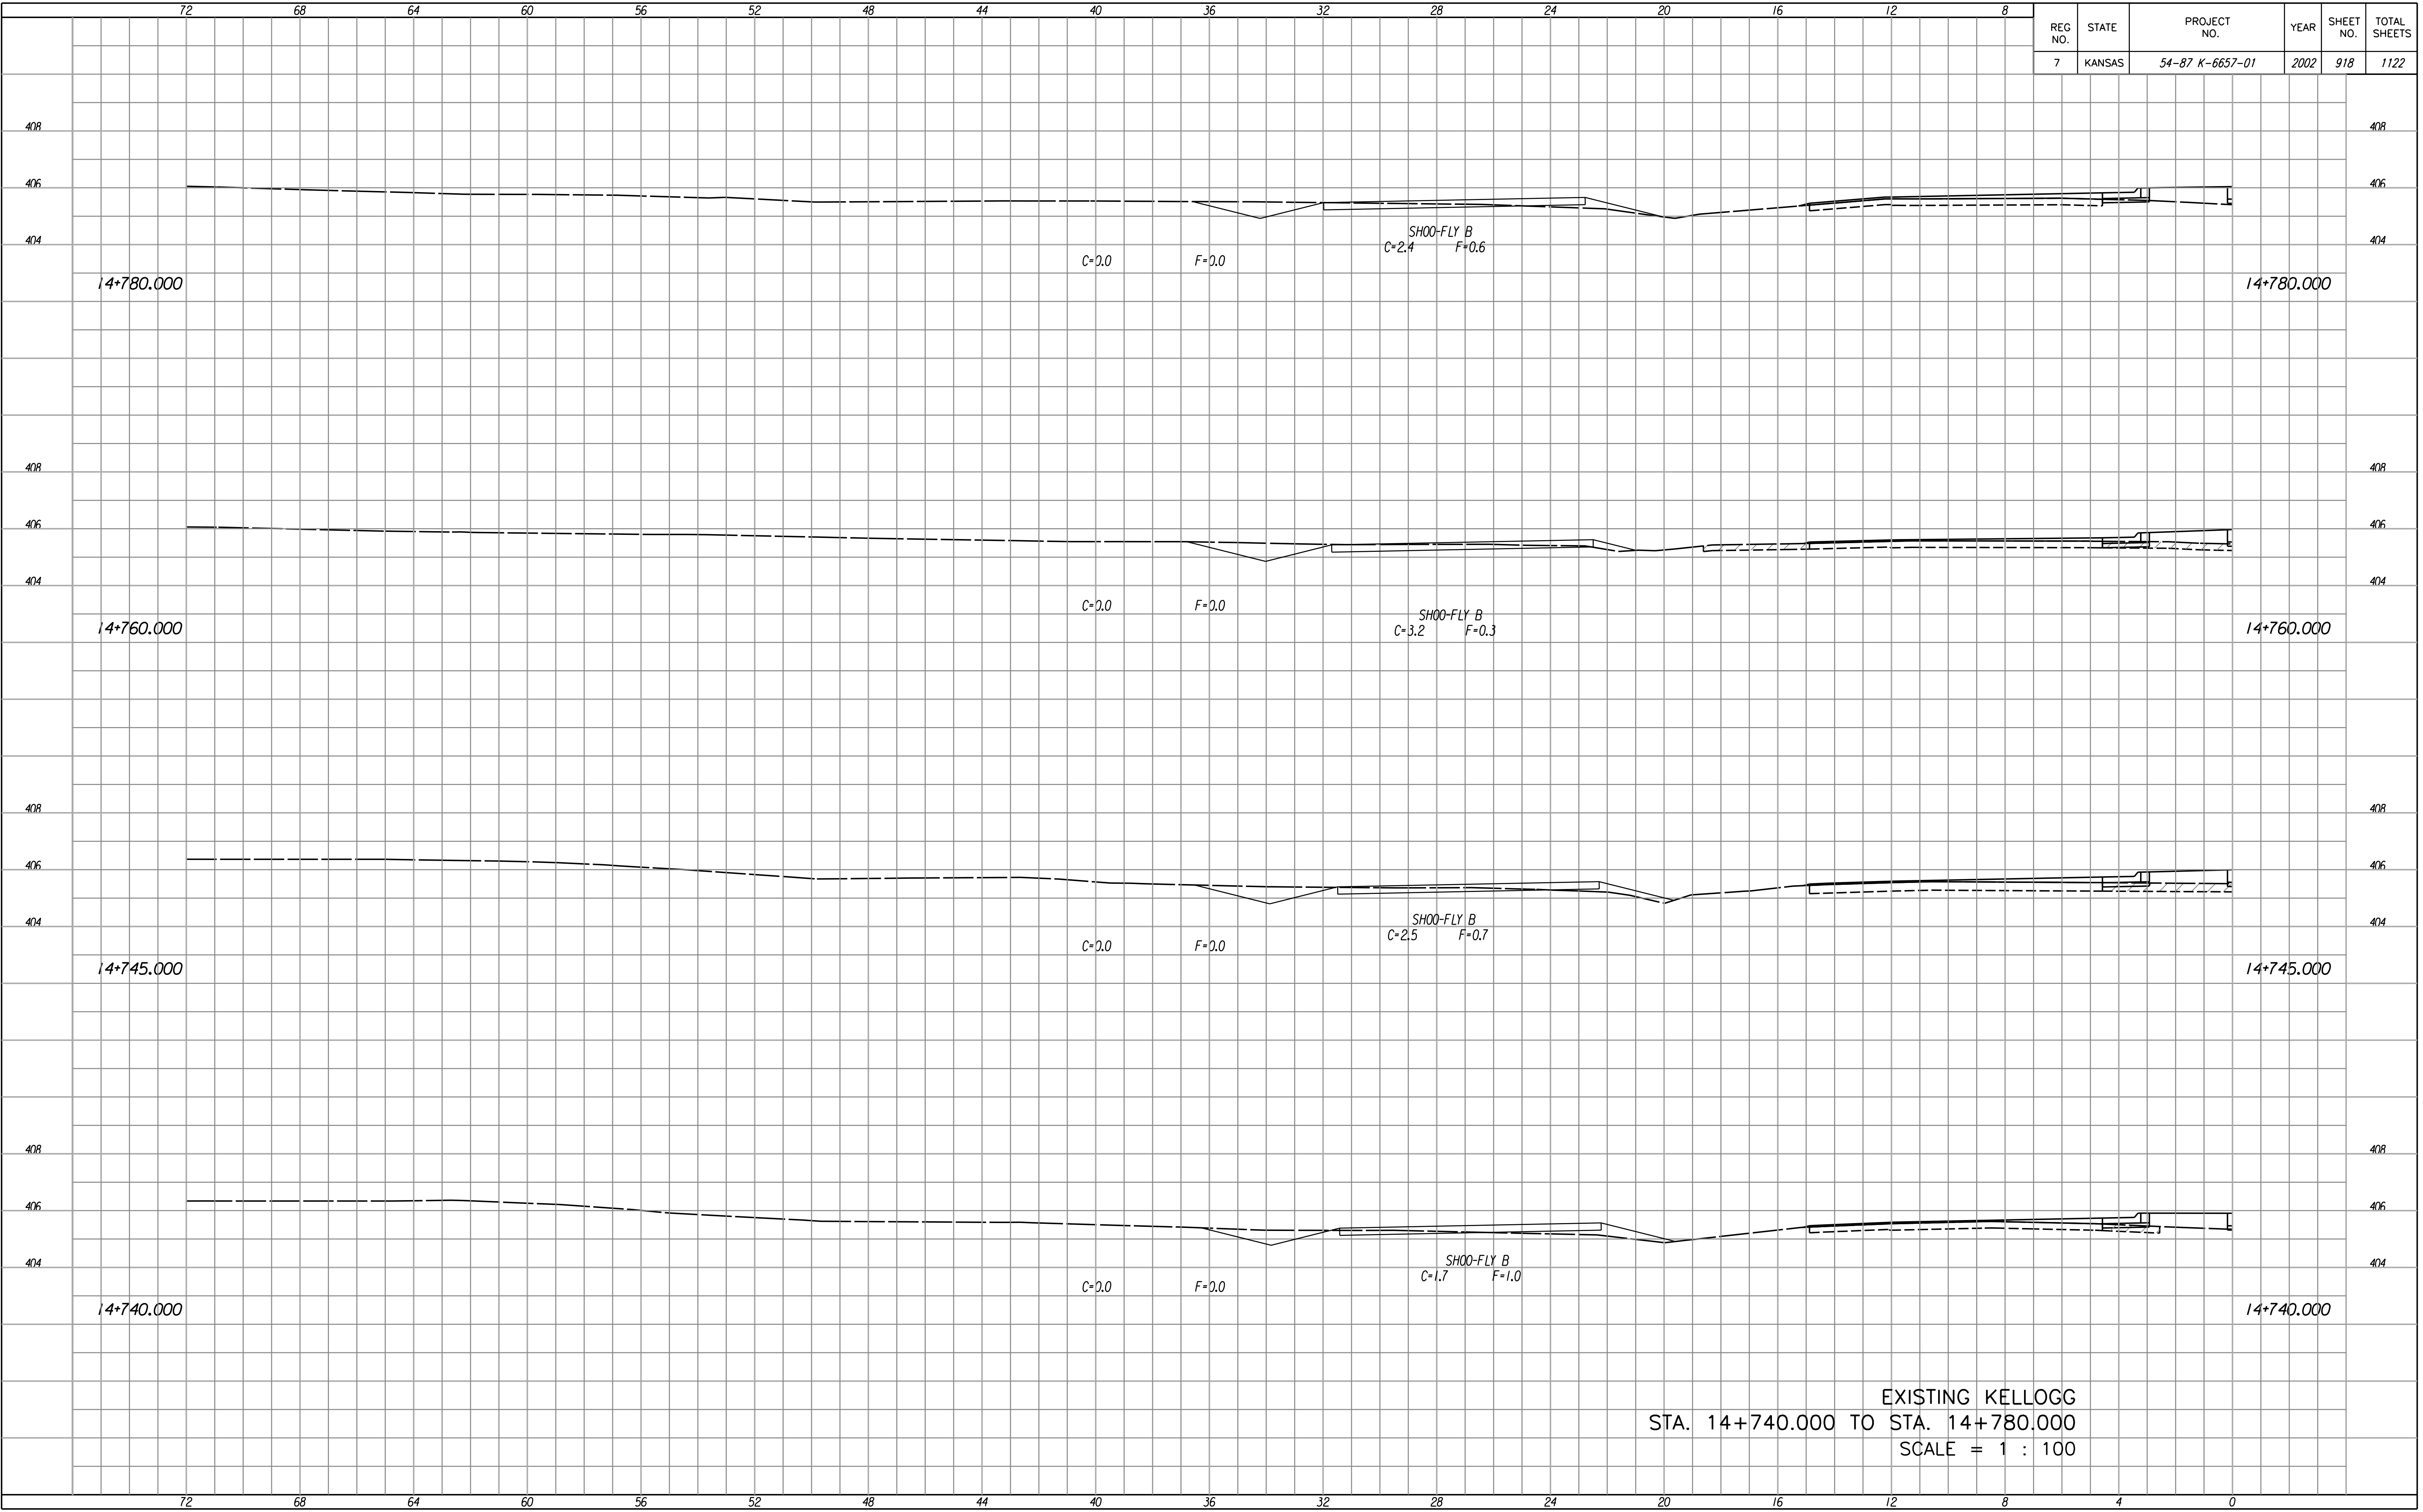

EXISTING KELLOGG  
 STA. 14+740.000 TO STA. 14+780.000  
 SCALE = 1 : 100