


REG NO.	STATE	PROJECT NO.	YEAR	SHEET NO.	TOTAL SHEETS
7	KANSAS	54-87 K-6657-01	2002	999	1122

FINAL SURVEY NO.	BY	DATE
SURVEYED	PLOTTED	DATE
NOTE BOOK NO.	TEMPLATE AREAS	CHECKED

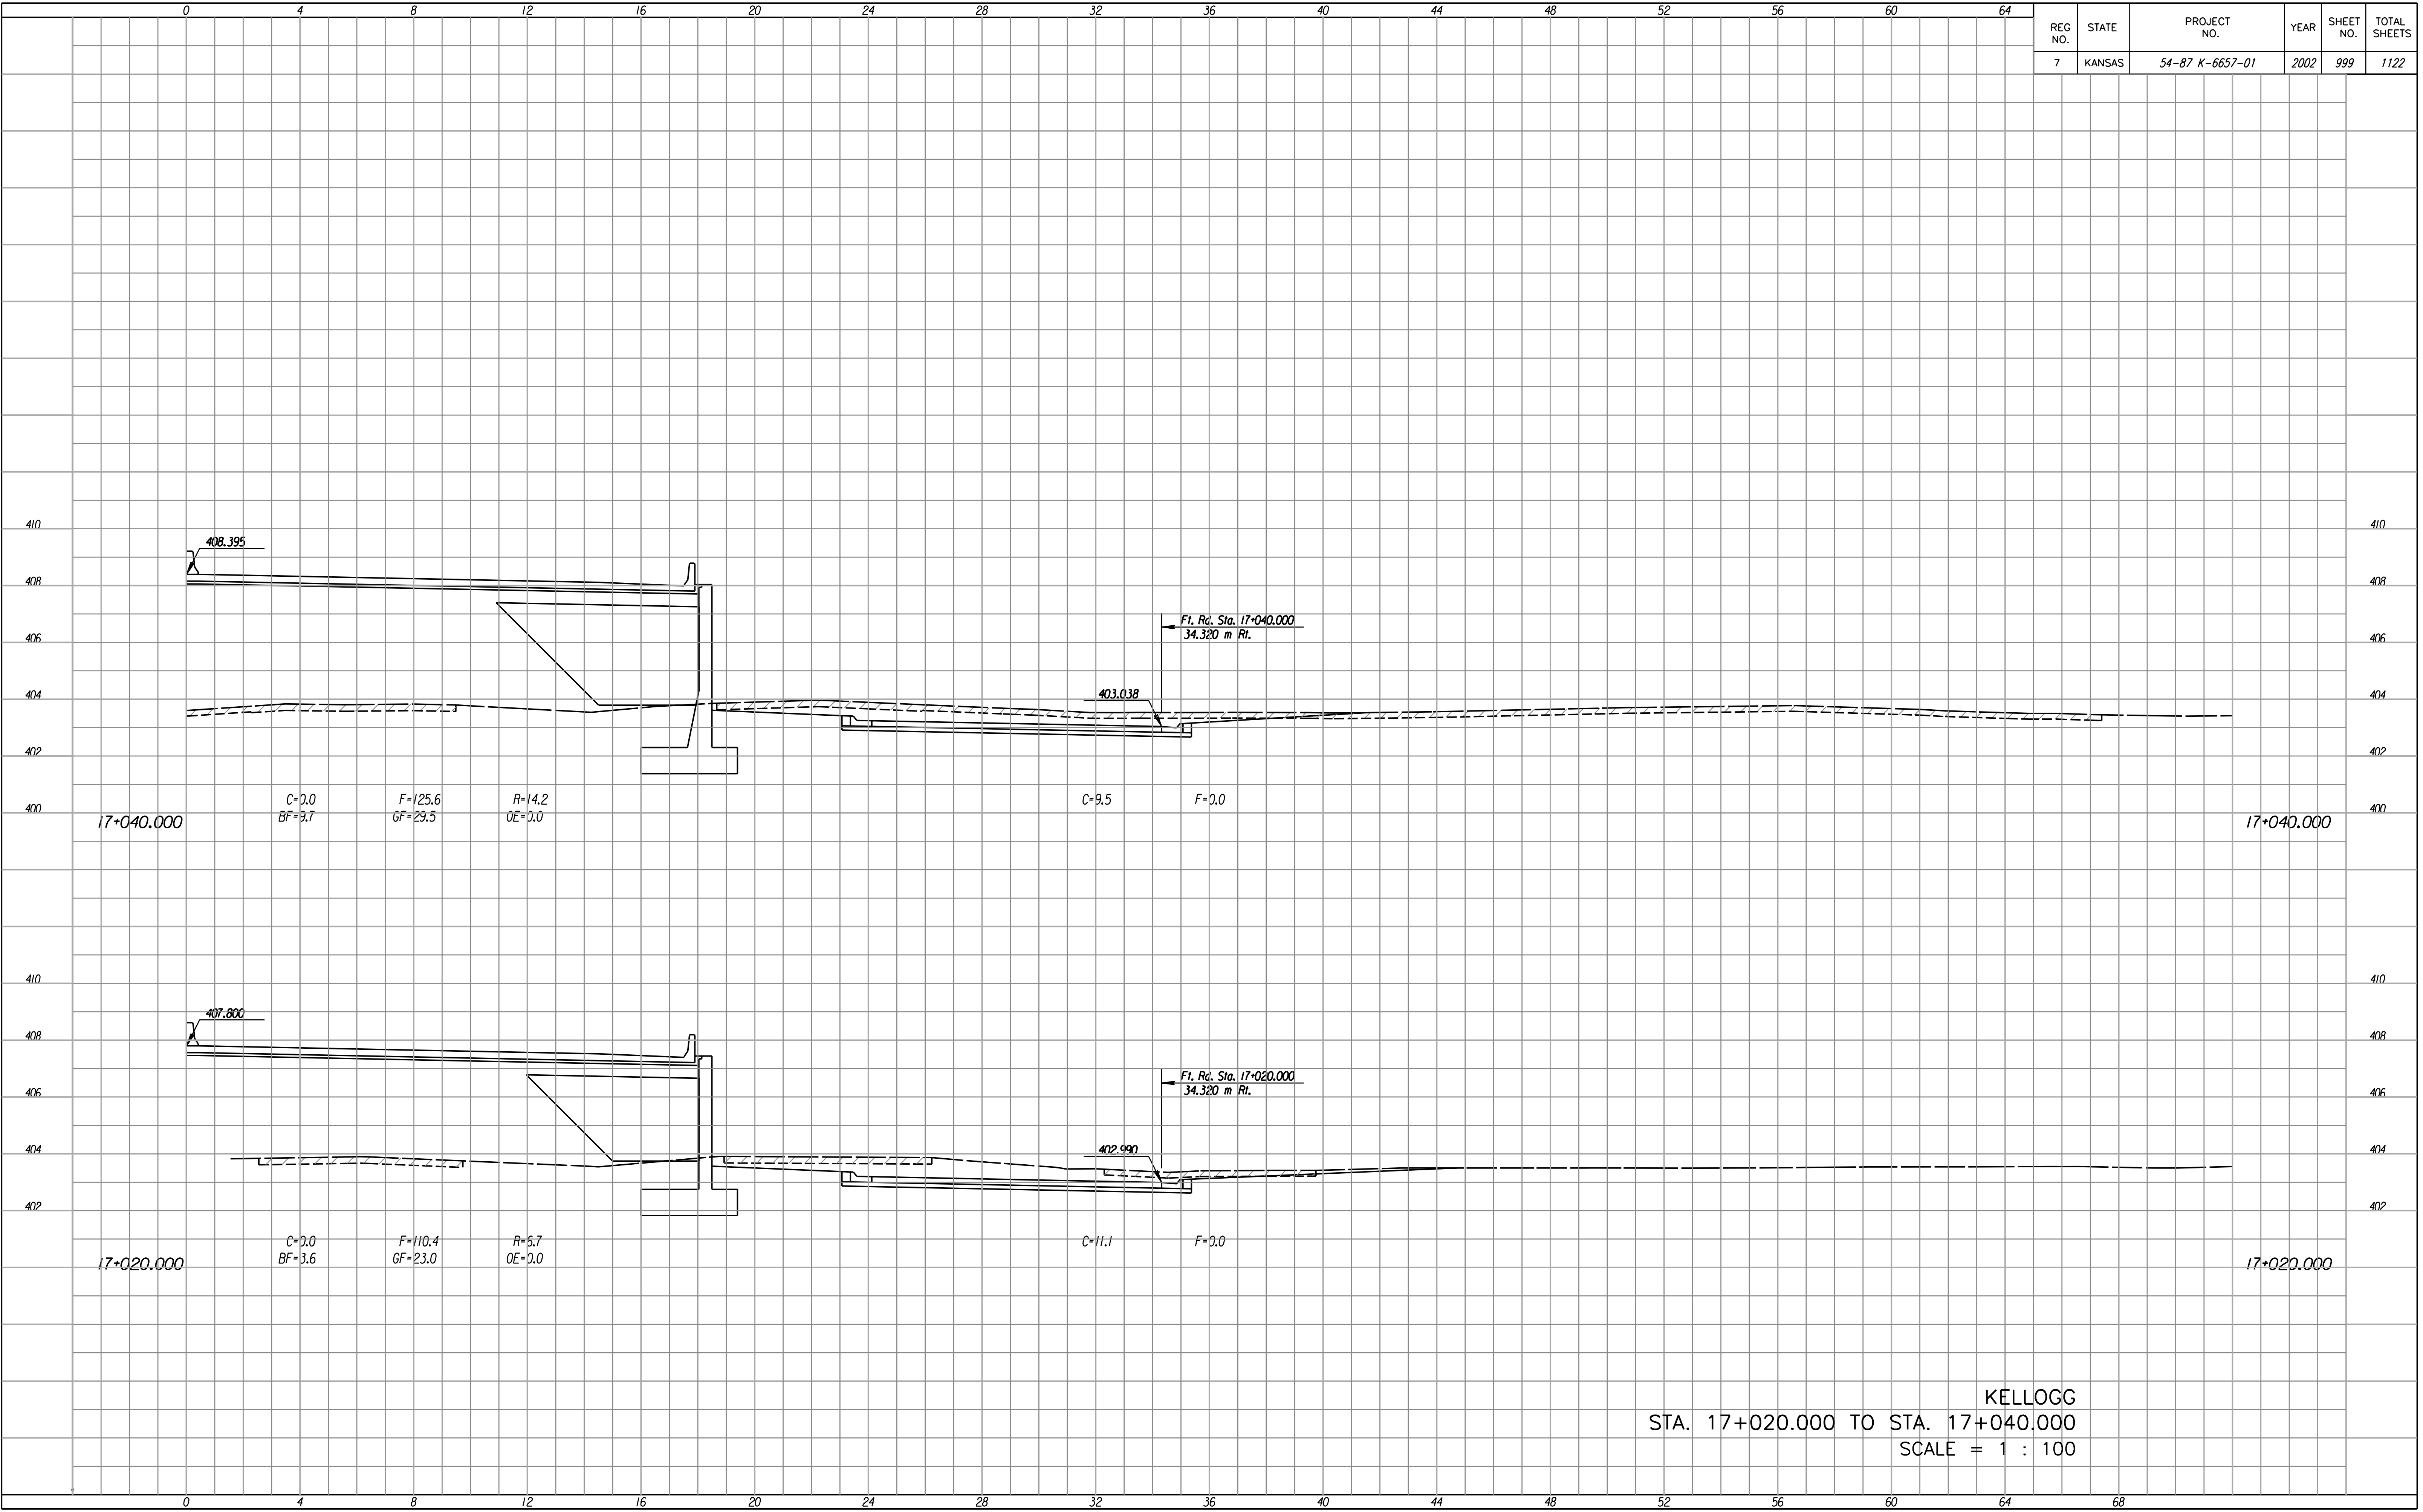

Last Rev. : 10-12-07 By: gdr
 Scale : 100
 Design File : i:/1997/97162/As-Builts/dgn/s/Vol 5/Sh 0999-Mainline-xst170200rt.dgn

KELLOGG
 STA. 17+020.000 TO STA. 17+040.000
 SCALE = 1 : 100