


REG. NO.	STATE	PROJECT NO.	YEAR	SHEET NO.	TOTAL SHEETS
7	KANSAS	54-87 K-6657-01	2002	1006	1122

FINAL SURVEY NO.	BY	DATE
SURVEYED		
PLOTTED		
TEMPLATE		
AREAS		
CHECKED		

Last Rev. : 10-12-07 By: gdr
 Scale : 100
 Design File : i:/1997/971662/As-Builts/dgn/s/Vol 5/Sh 1006-Mainline-xst17166L.dgn

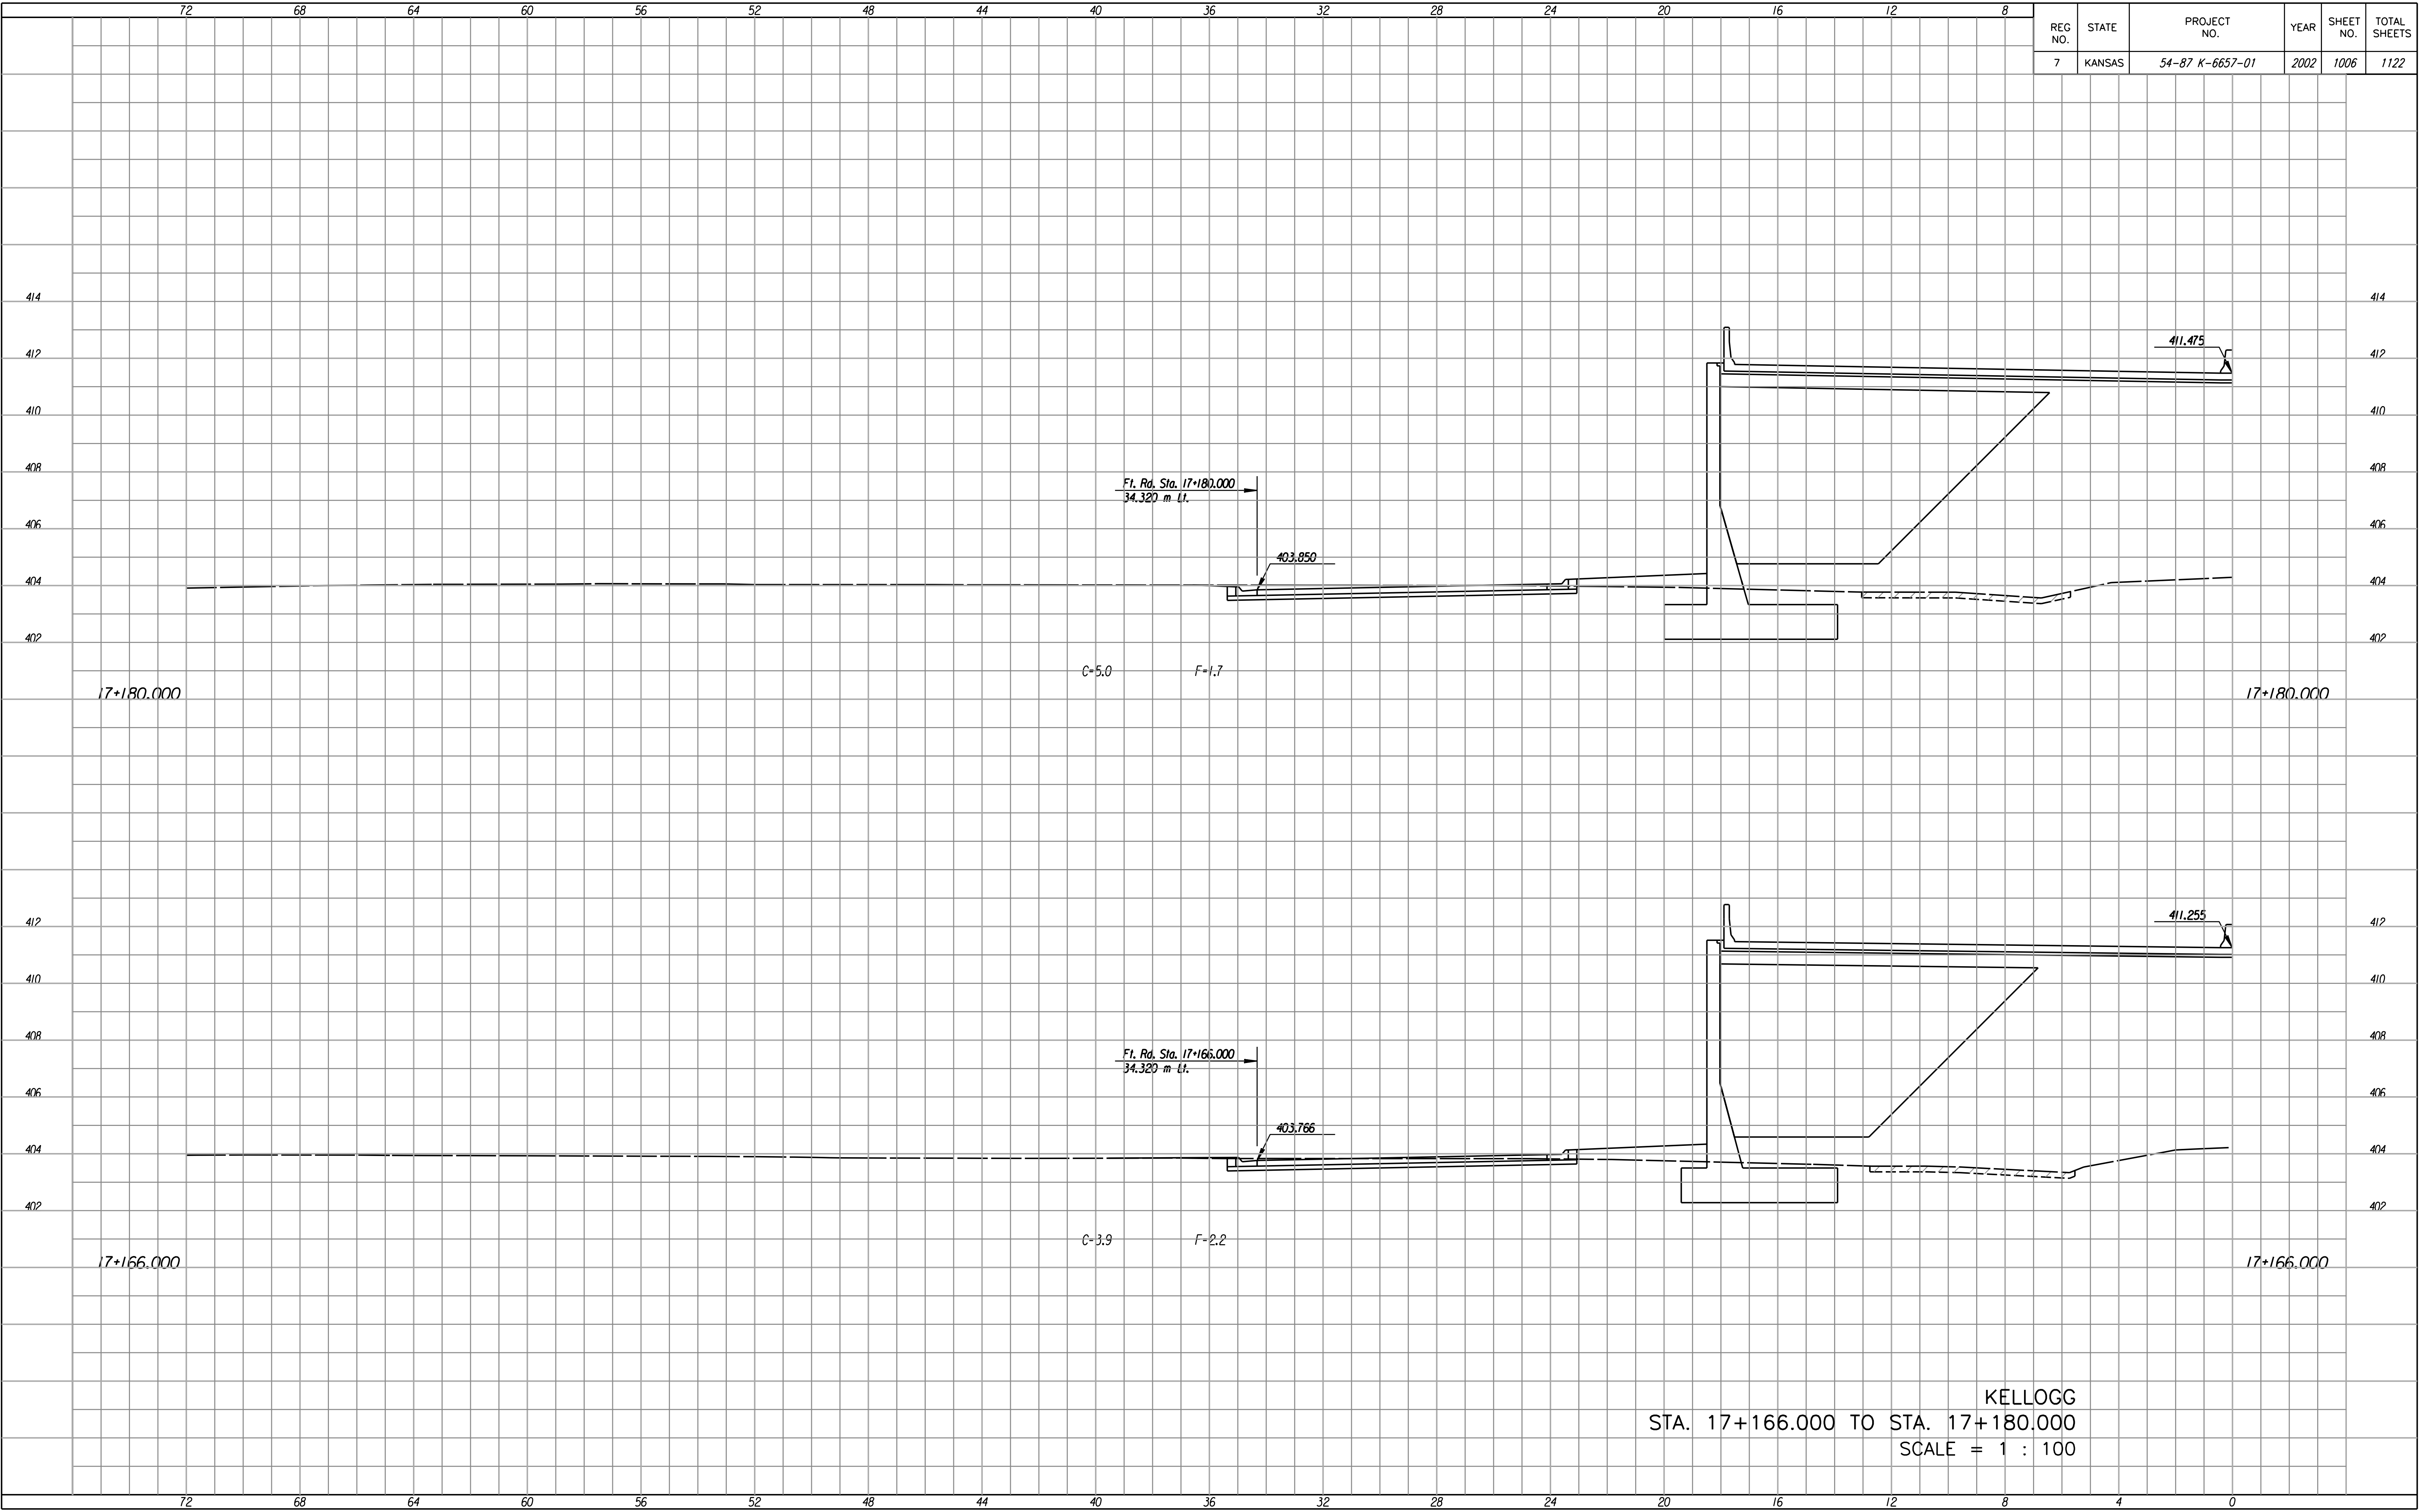

KELLOGG
 STA. 17+166.000 TO STA. 17+180.000
 SCALE = 1 : 100