


REG. NO.	STATE	PROJECT NO.	YEAR	SHEET NO.	TOTAL SHEETS
7	KANSAS	54-87 K-6657-01	2002	1024	1122

FINAL SURVEY NO.	BY	DATE
SURVEYED		
PLOTTED		
TEMPLATE AREAS CHECKED		
NO. AREAS CHECKED		

Last Rev. : 10-12-07 By: gdr
 Scale : 100
 Design File : i:\1997\97662\As-Builts\ dgn's\Vol 5\Sh 1024-Mainline-xst7634L.dgn

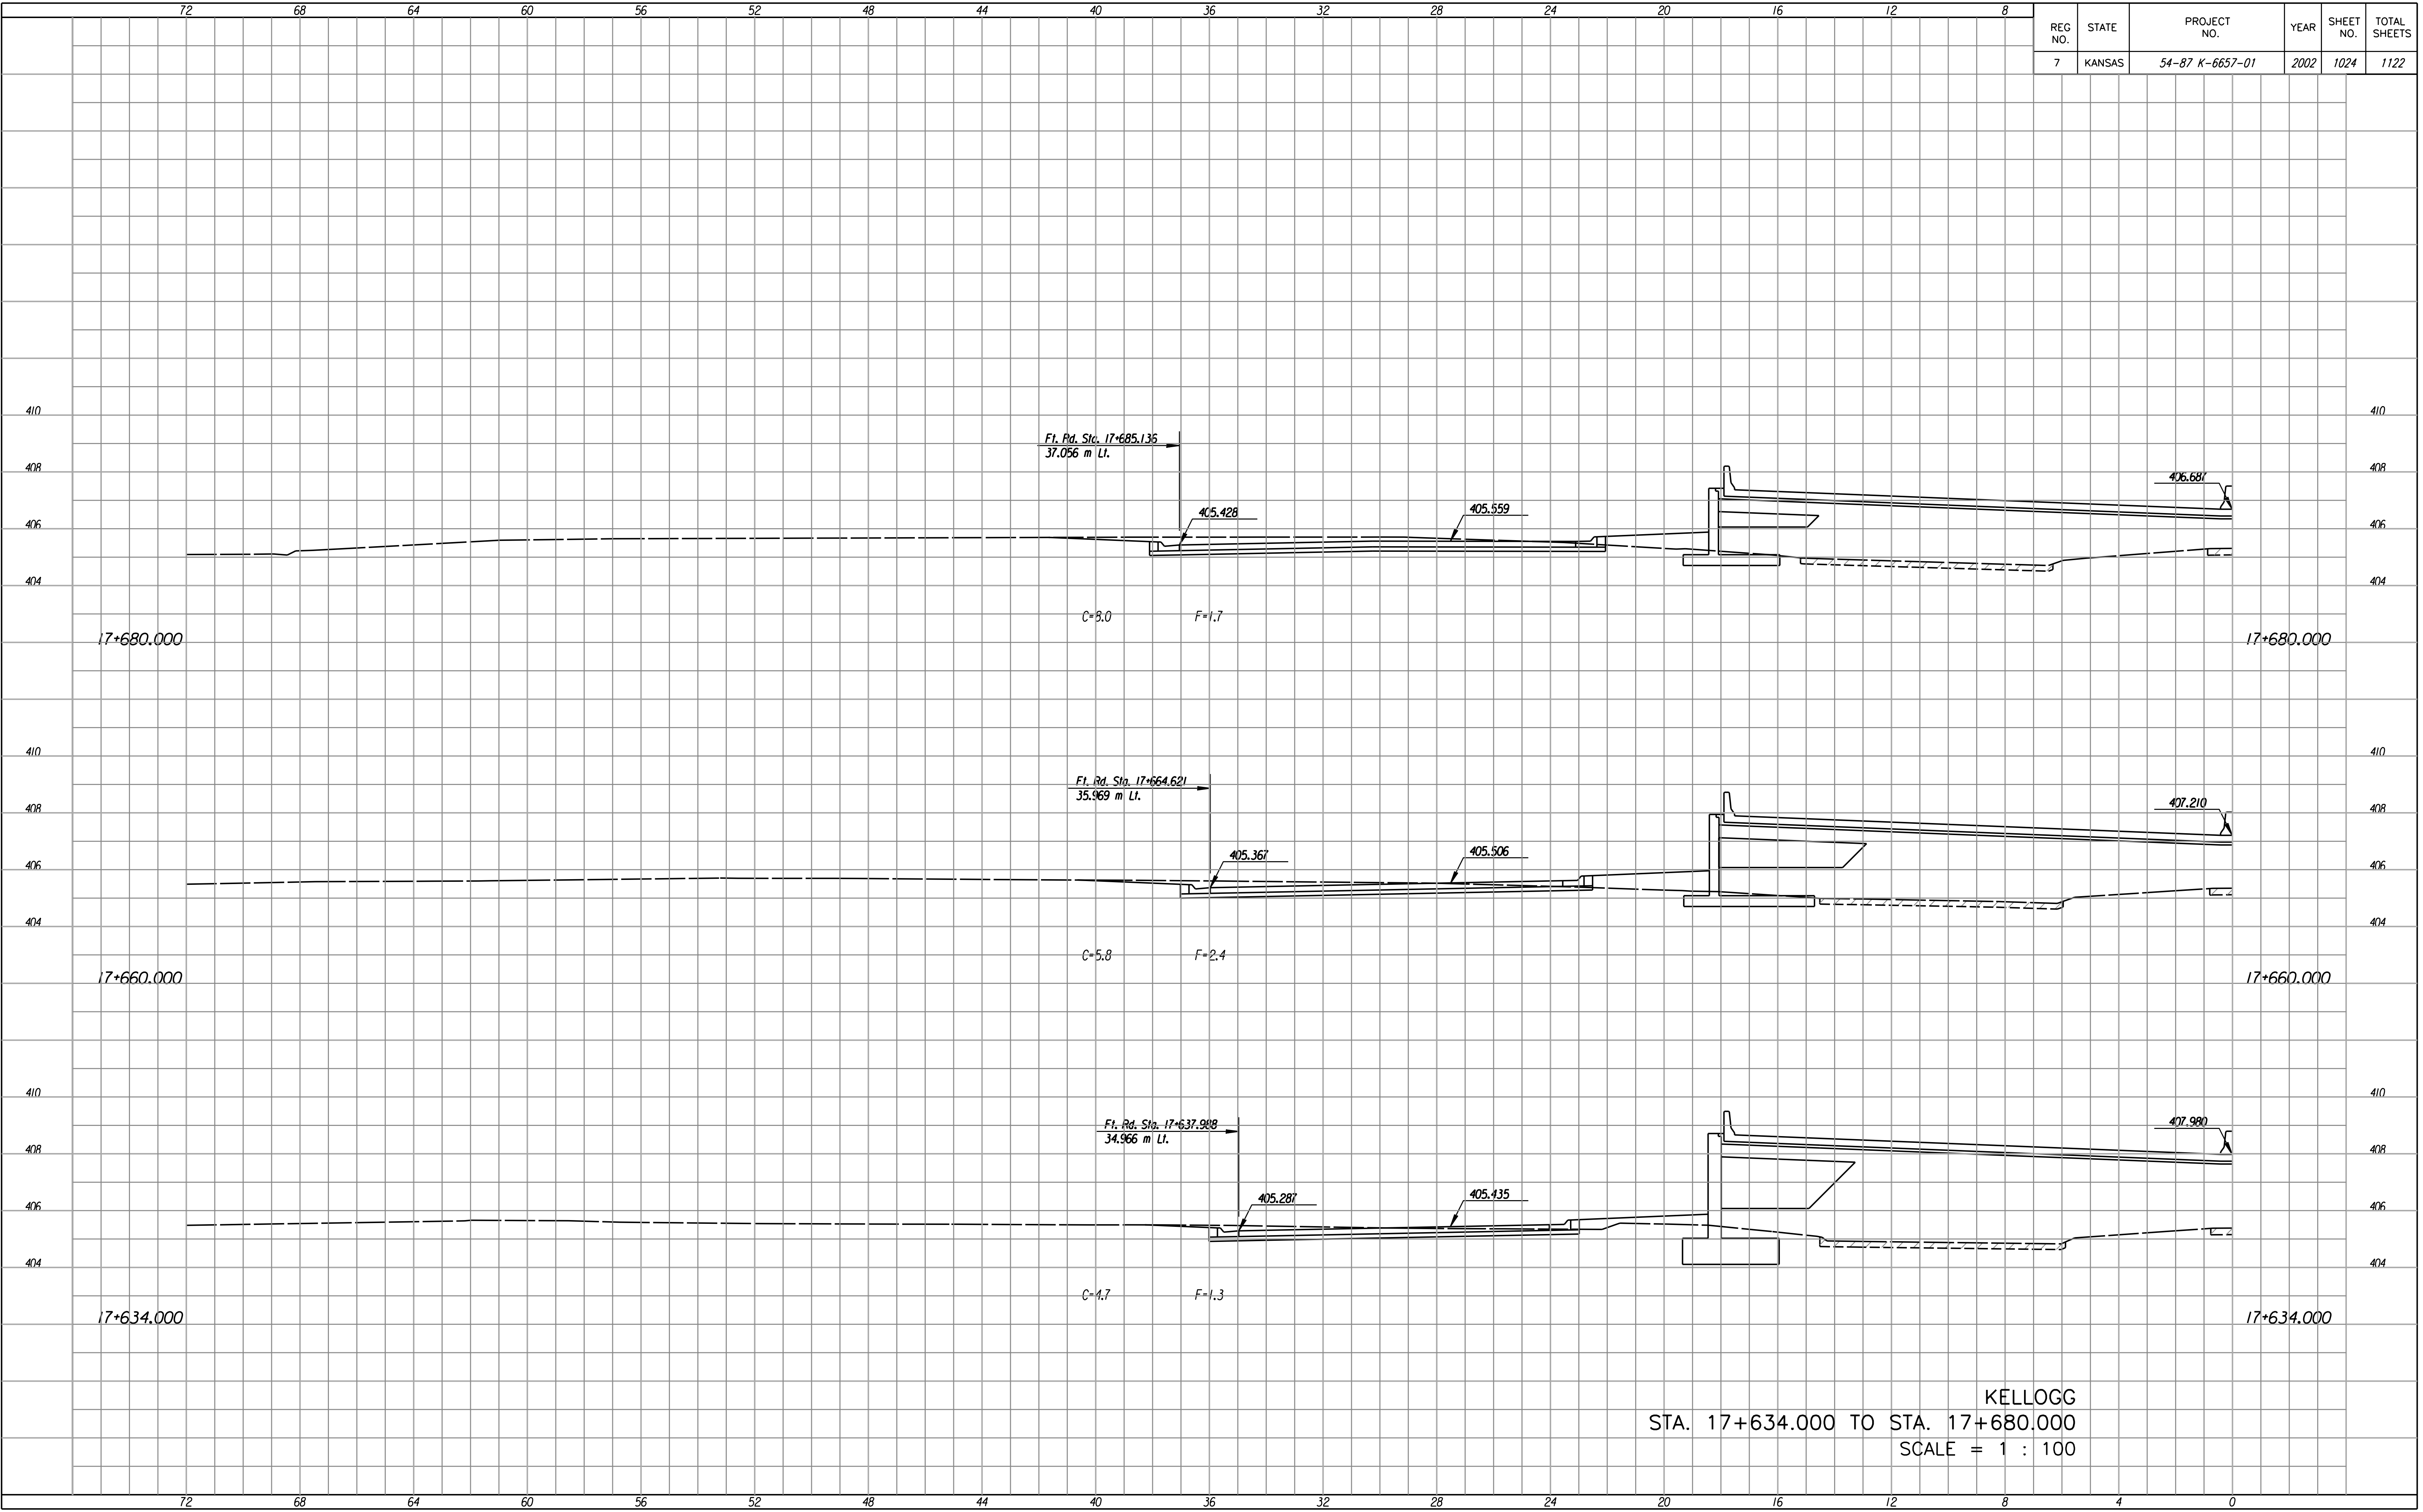

KELLOGG
 STA. 17+634.000 TO STA. 17+680.000
 SCALE = 1 : 100