


REG. NO.	STATE	PROJECT NO.	YEAR	SHEET NO.	TOTAL SHEETS
7	KANSAS	54-87 K-6657-01	2002	1037	1122

FINAL SURVEY NO.	DATE
SURVEYED BY	
PLOTTED BY	
TEMPLATE AREAS CHECKED	
NO. AREAS CHECKED	

Last Rev. : 10-12-07 By: gdr
 Scale : 100
 Design File : i:\1997\97662\As-Built\ dgn\Vol 5\Sh 1037-Mainline-xst7980Rt.dgn

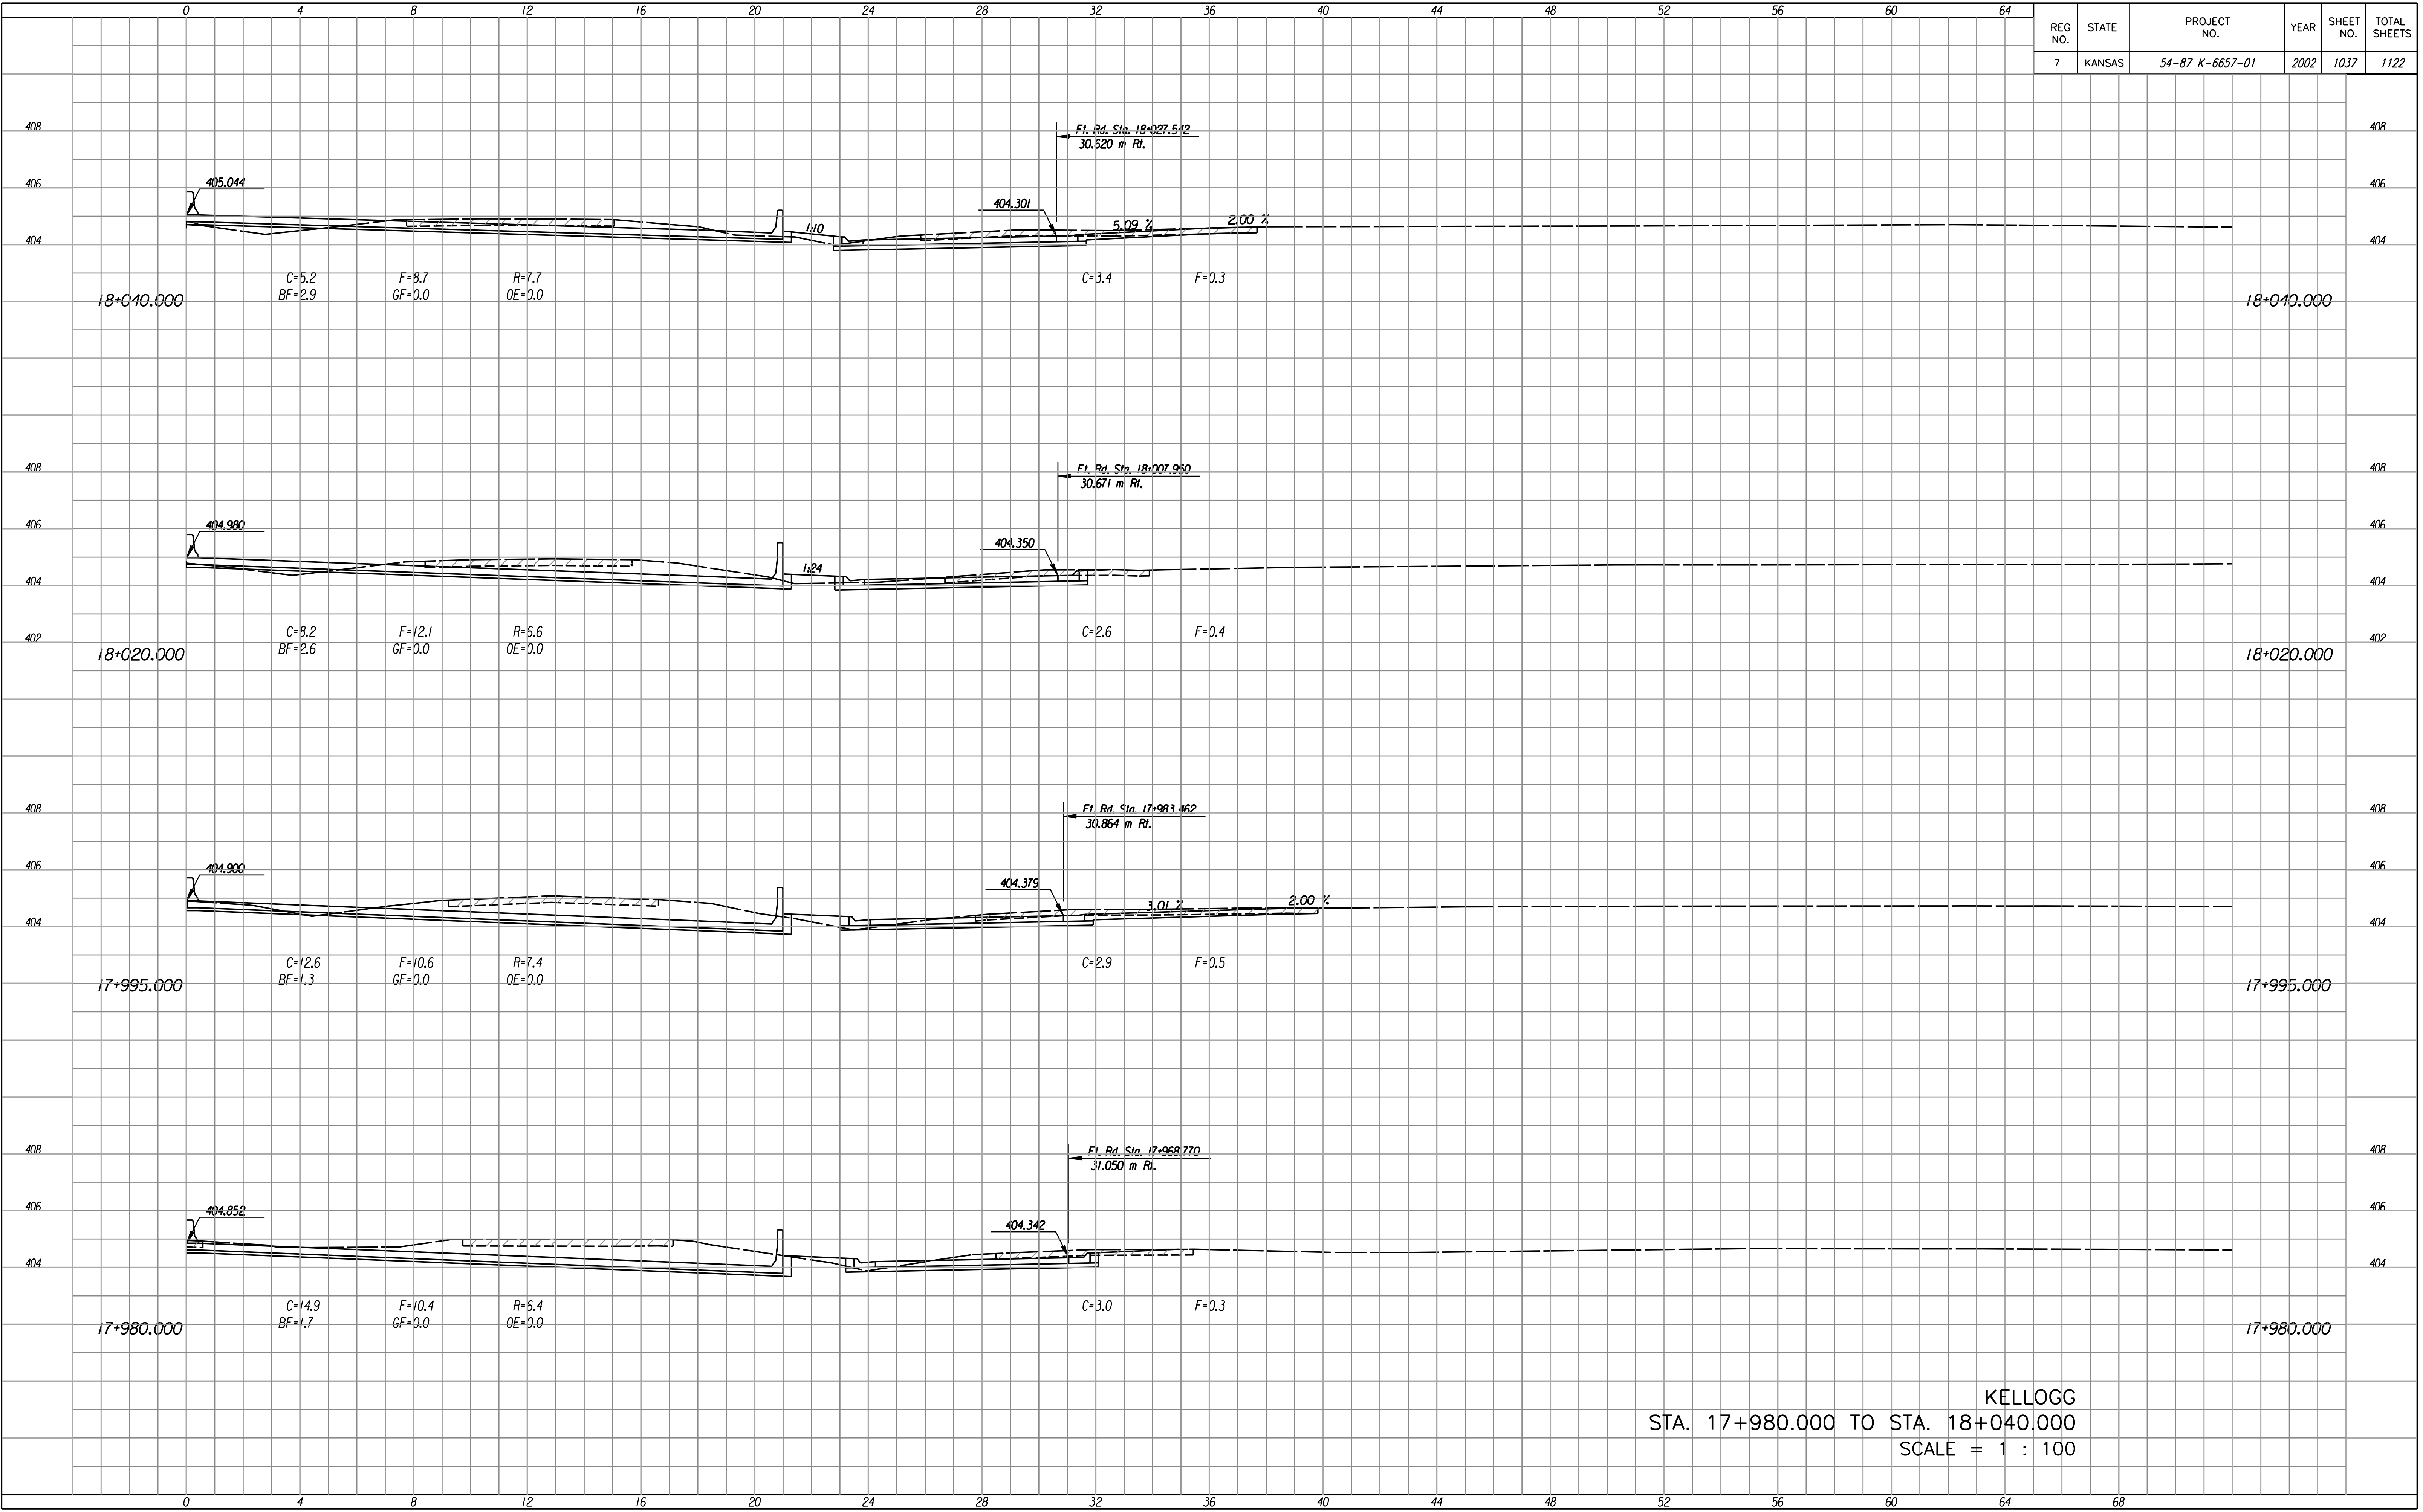

KELLOGG
 STA. 17+980.000 TO STA. 18+040.000
 SCALE = 1 : 100