


FHWA REG NO.	STATE	PROJECT NO.	YEAR	SHEET NO.	TOTAL SHEETS
7	KANSAS	54-87 K-6657-01	2002	1061	1122
32		36	40		

DATE	
BY	
SURVEYED	
PLOTTED	
TEMPLATE	
AREAS	
CHECKED	
FINAL SURVEY NOTE BOOK NO.	

DSNR: RCH OPER: SVB SCALE: 1:100
 1/1997/97362/As-Built/egn's/Vol.5/Sh_1061-Maize-KS3670

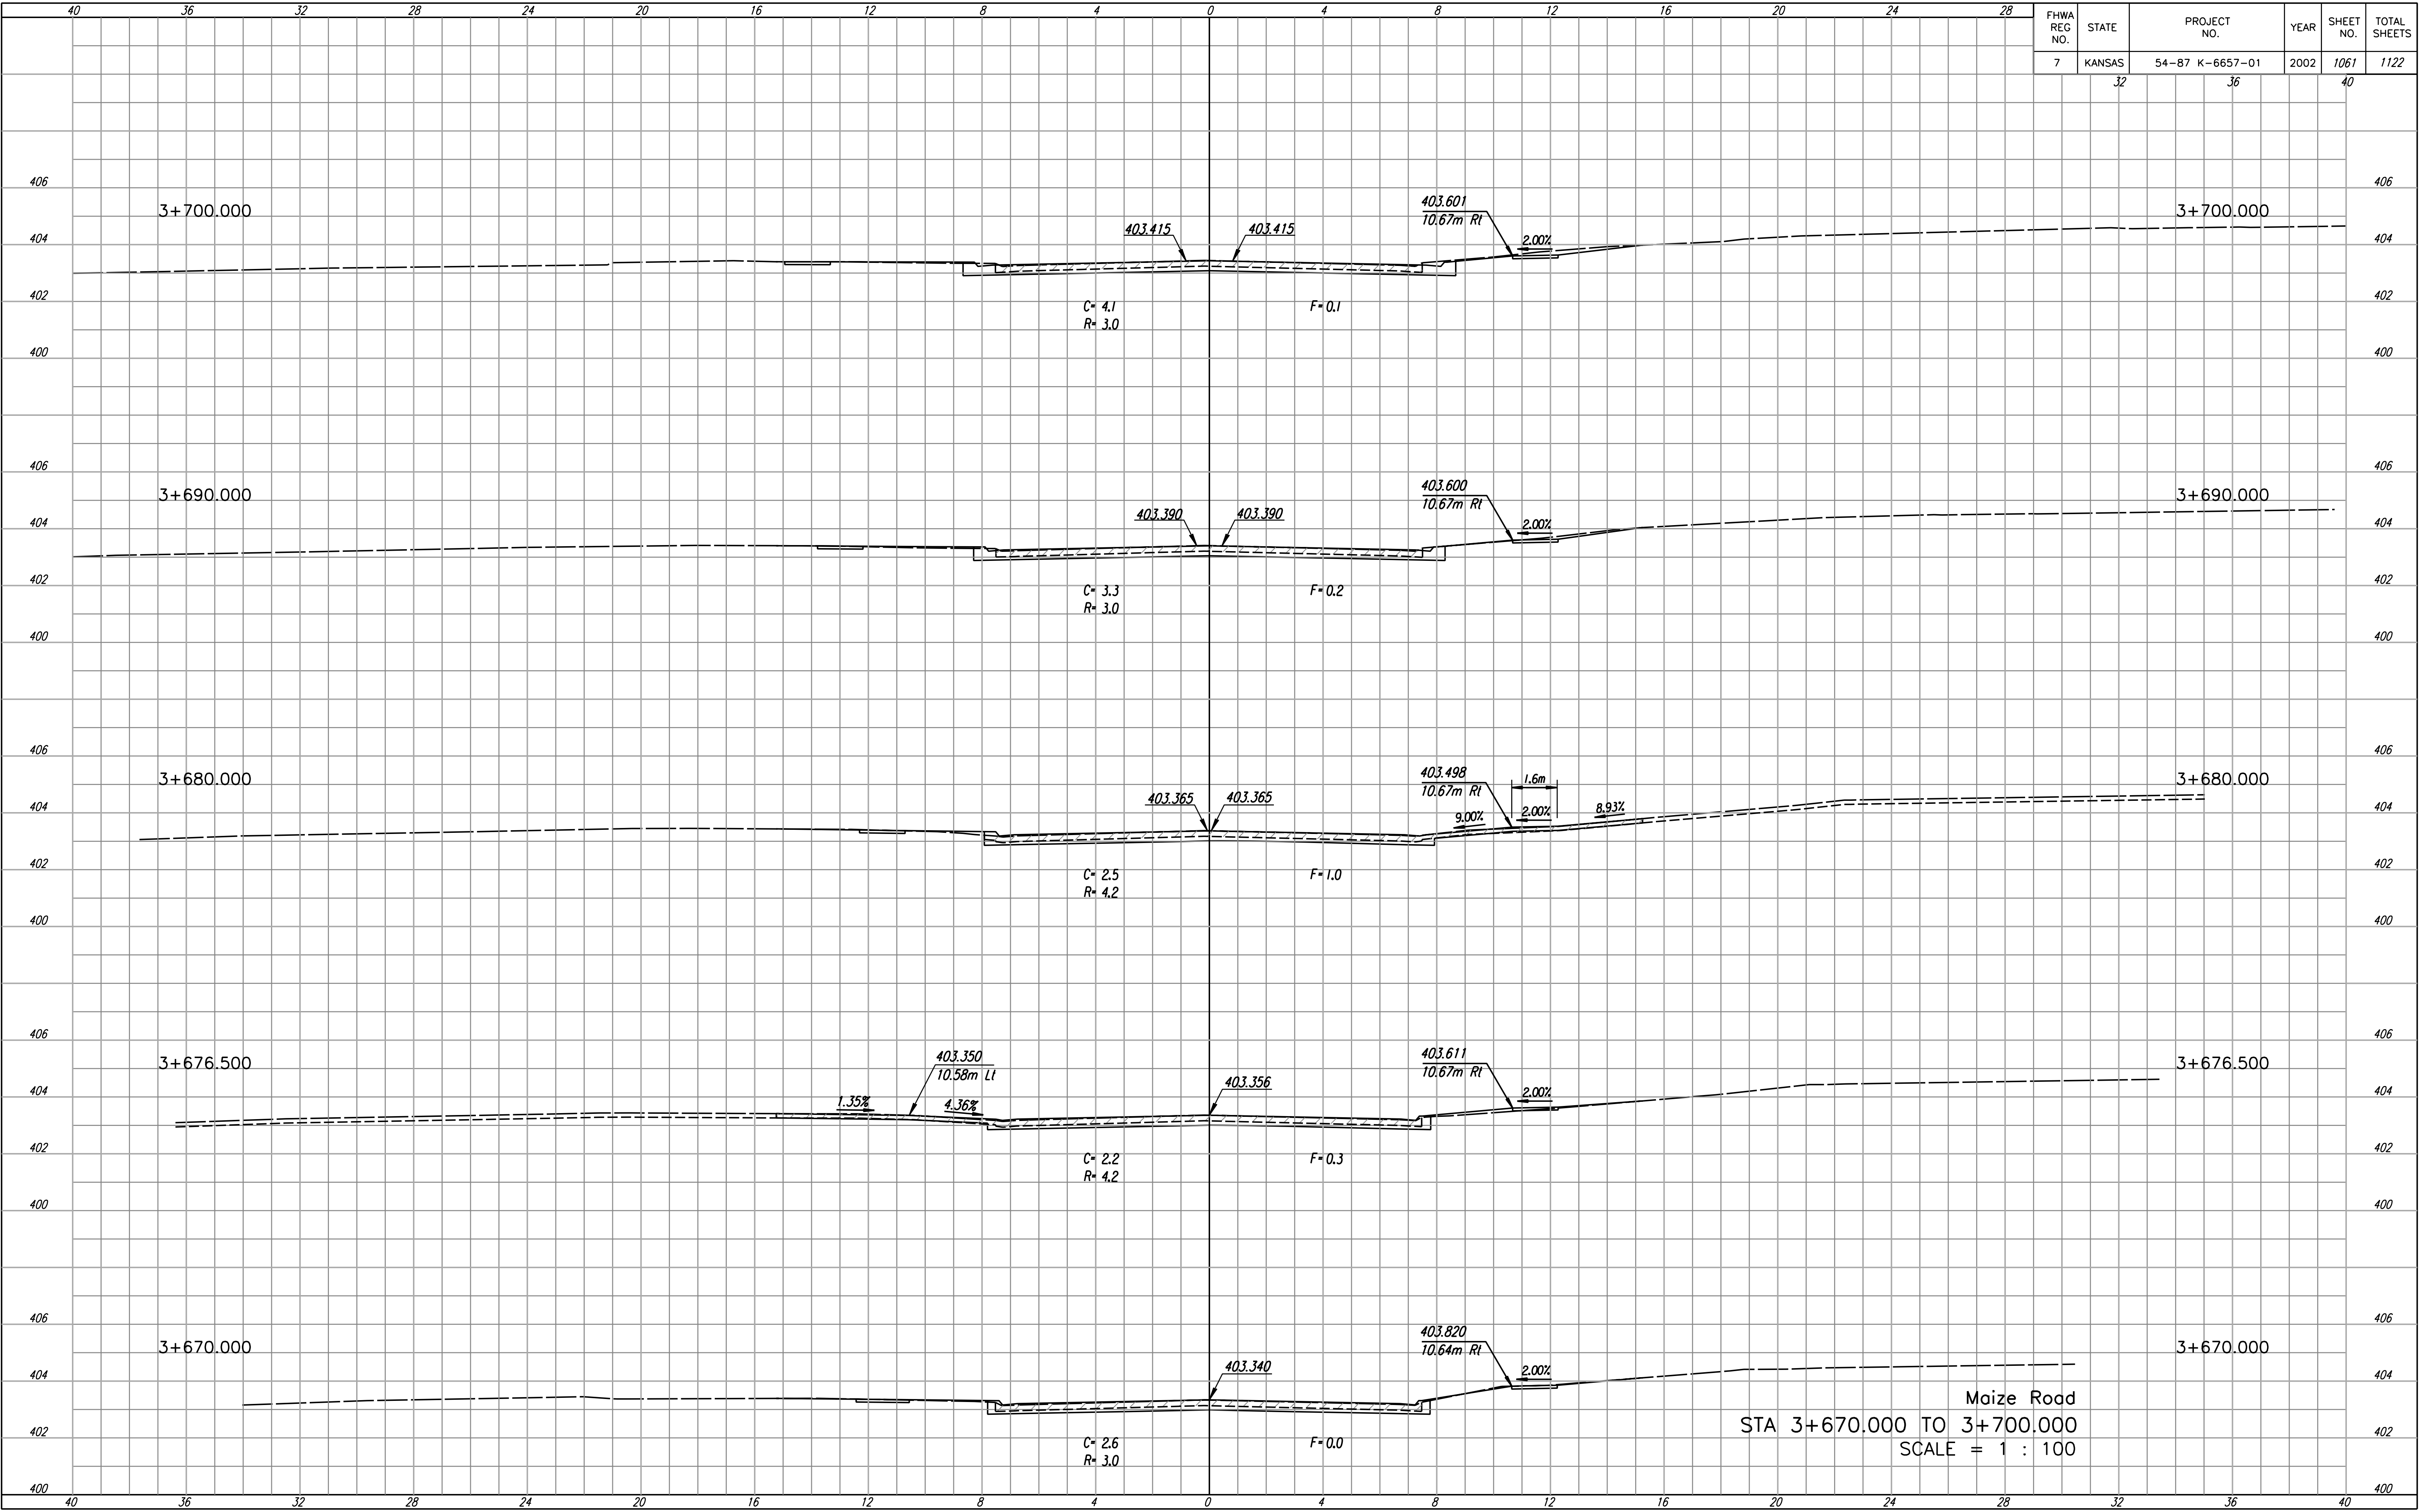

Maize Road
 STA 3+670.000 TO 3+700.000
 SCALE = 1 : 100