


FHWA REG NO.	STATE	PROJECT NO.	YEAR	SHEET NO.	TOTAL SHEETS
7	KANSAS	54-87 K-6657-01	2002	1070	1122
		72	76	80	

FINAL SURVEY NO.	BY	DATE
SURVEYED		
PLOTTED		
TEMPLATE		
AREAS		
CHECKED		

DSWR: RCH OPER: SVB SCALE: 1:100
 I:/1997/07262/As-Built/egn's/61.5/Sh_1070-Maize-153990Right.dgn

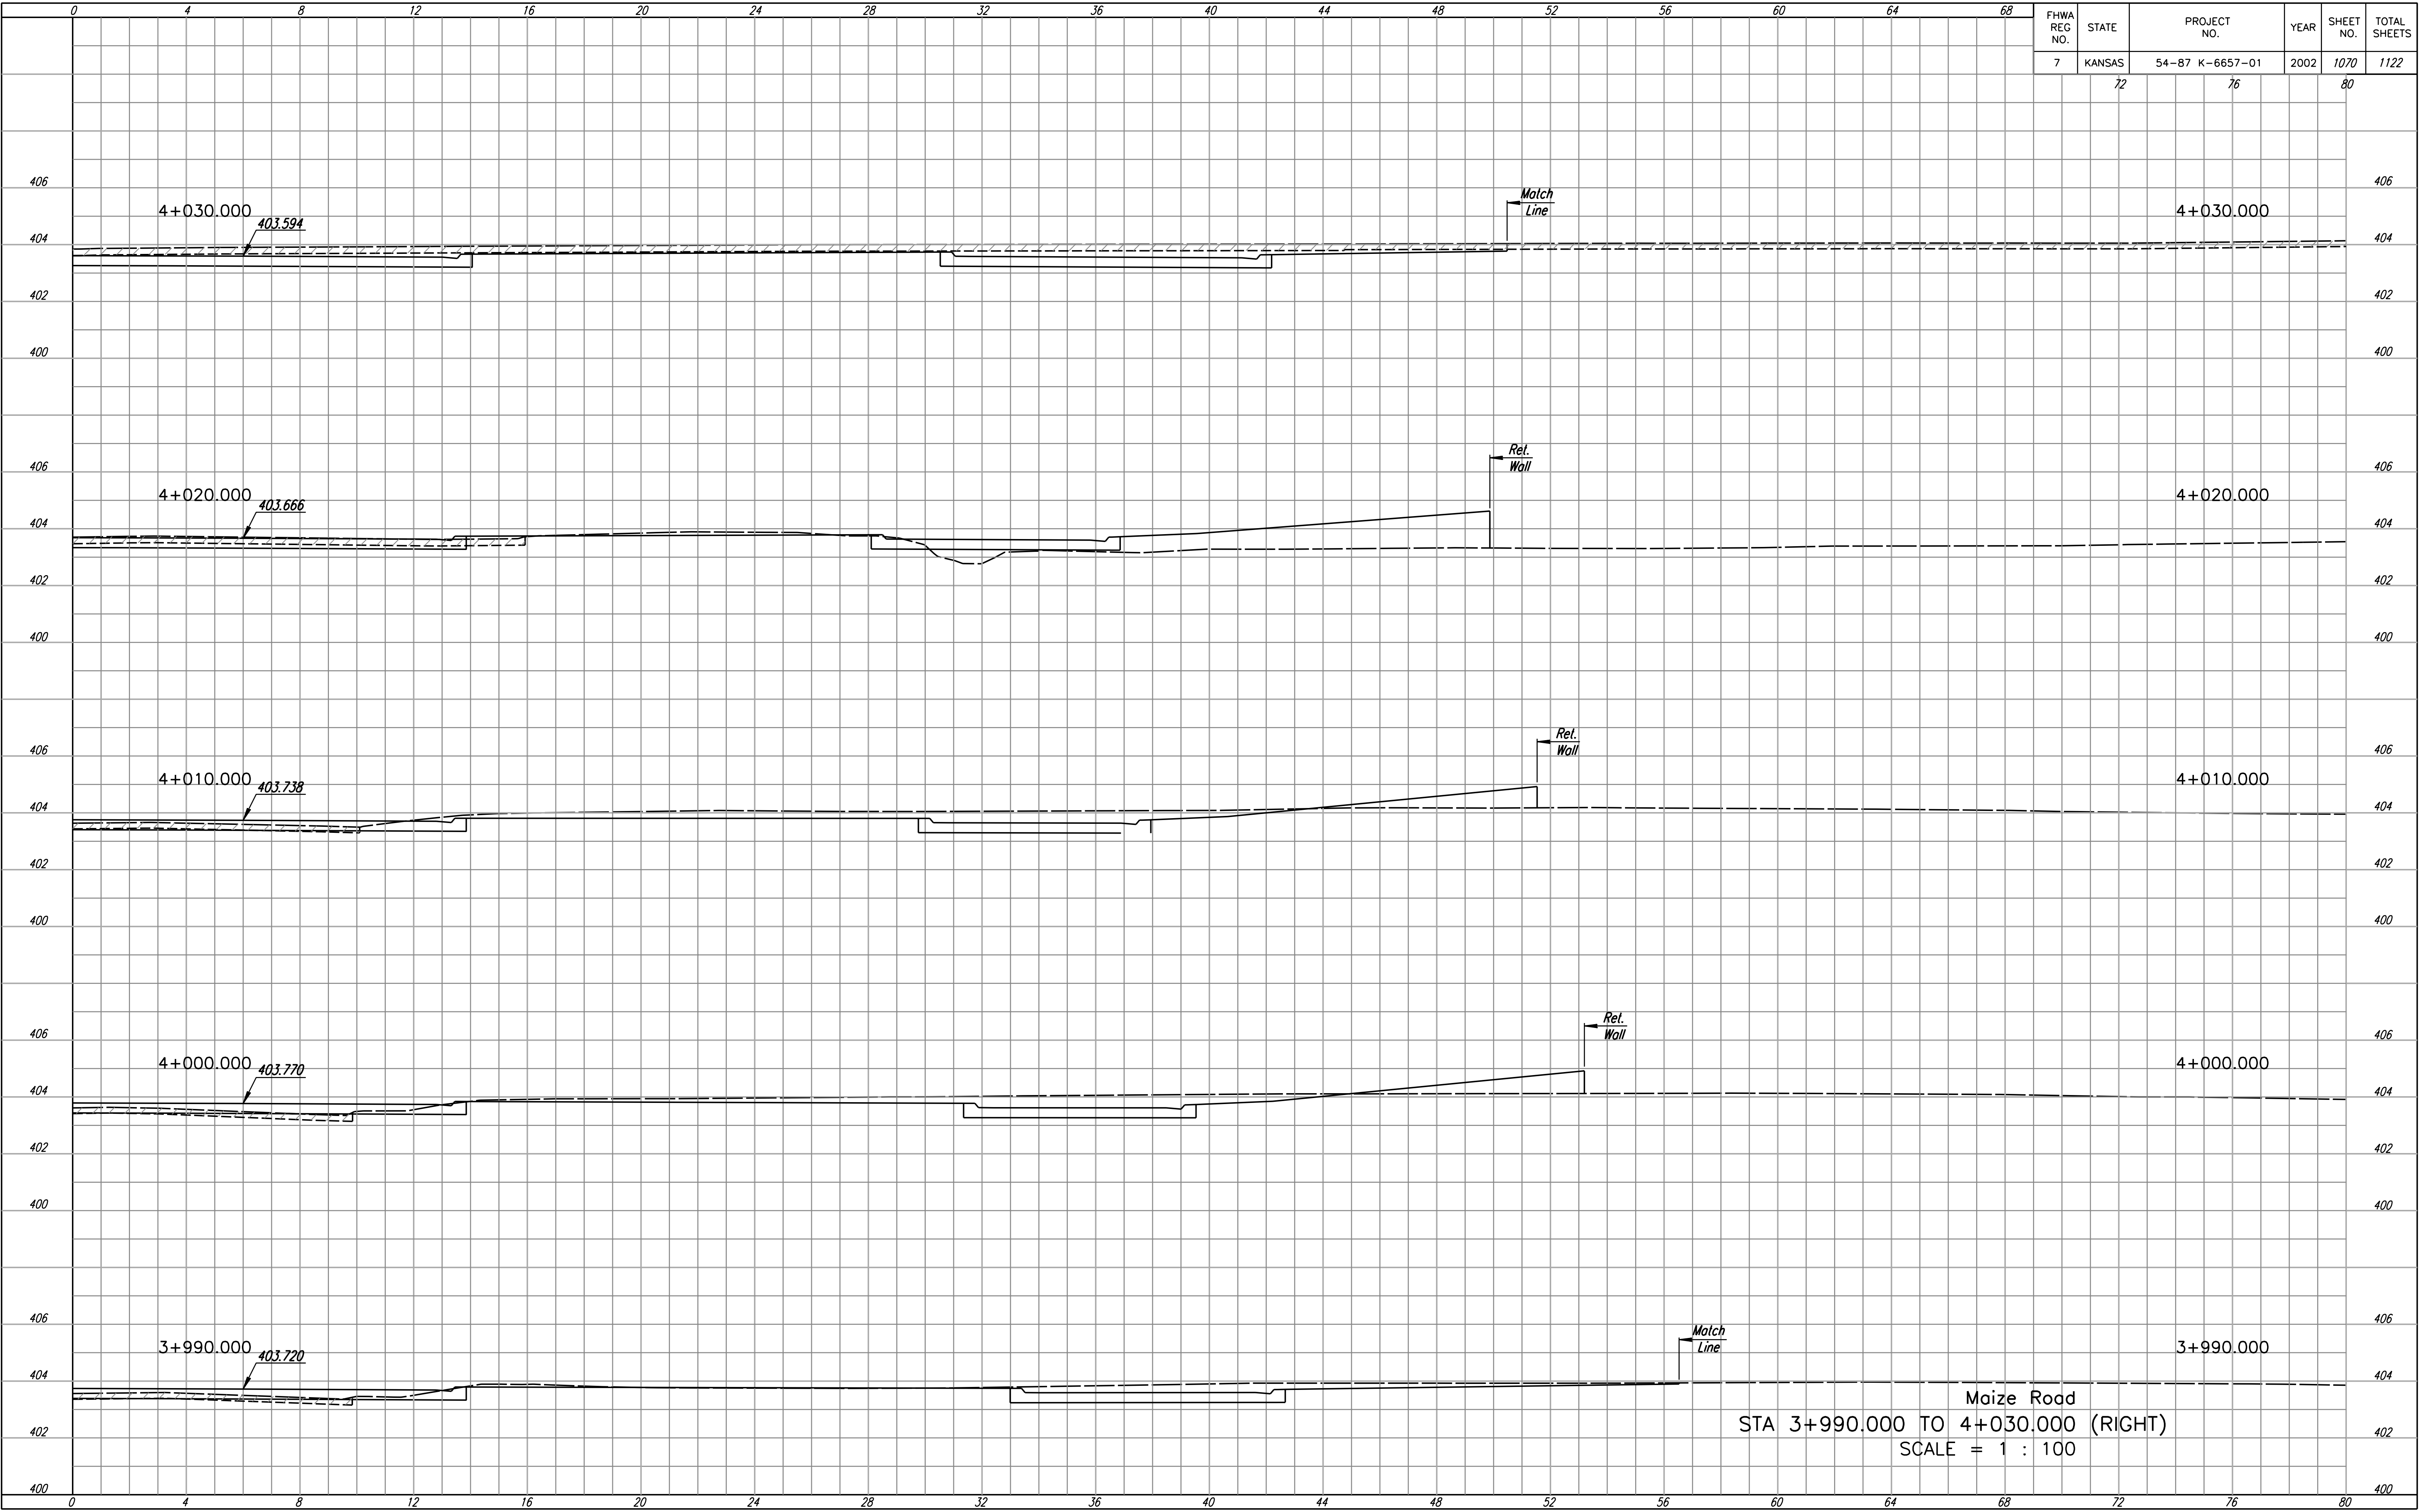

Maize Road
 STA 3+990.000 TO 4+030.000 (RIGHT)
 SCALE = 1 : 100