


Scale Plan 1"=40'
Profile 1"=10' Horiz.
1"=5' Vert.

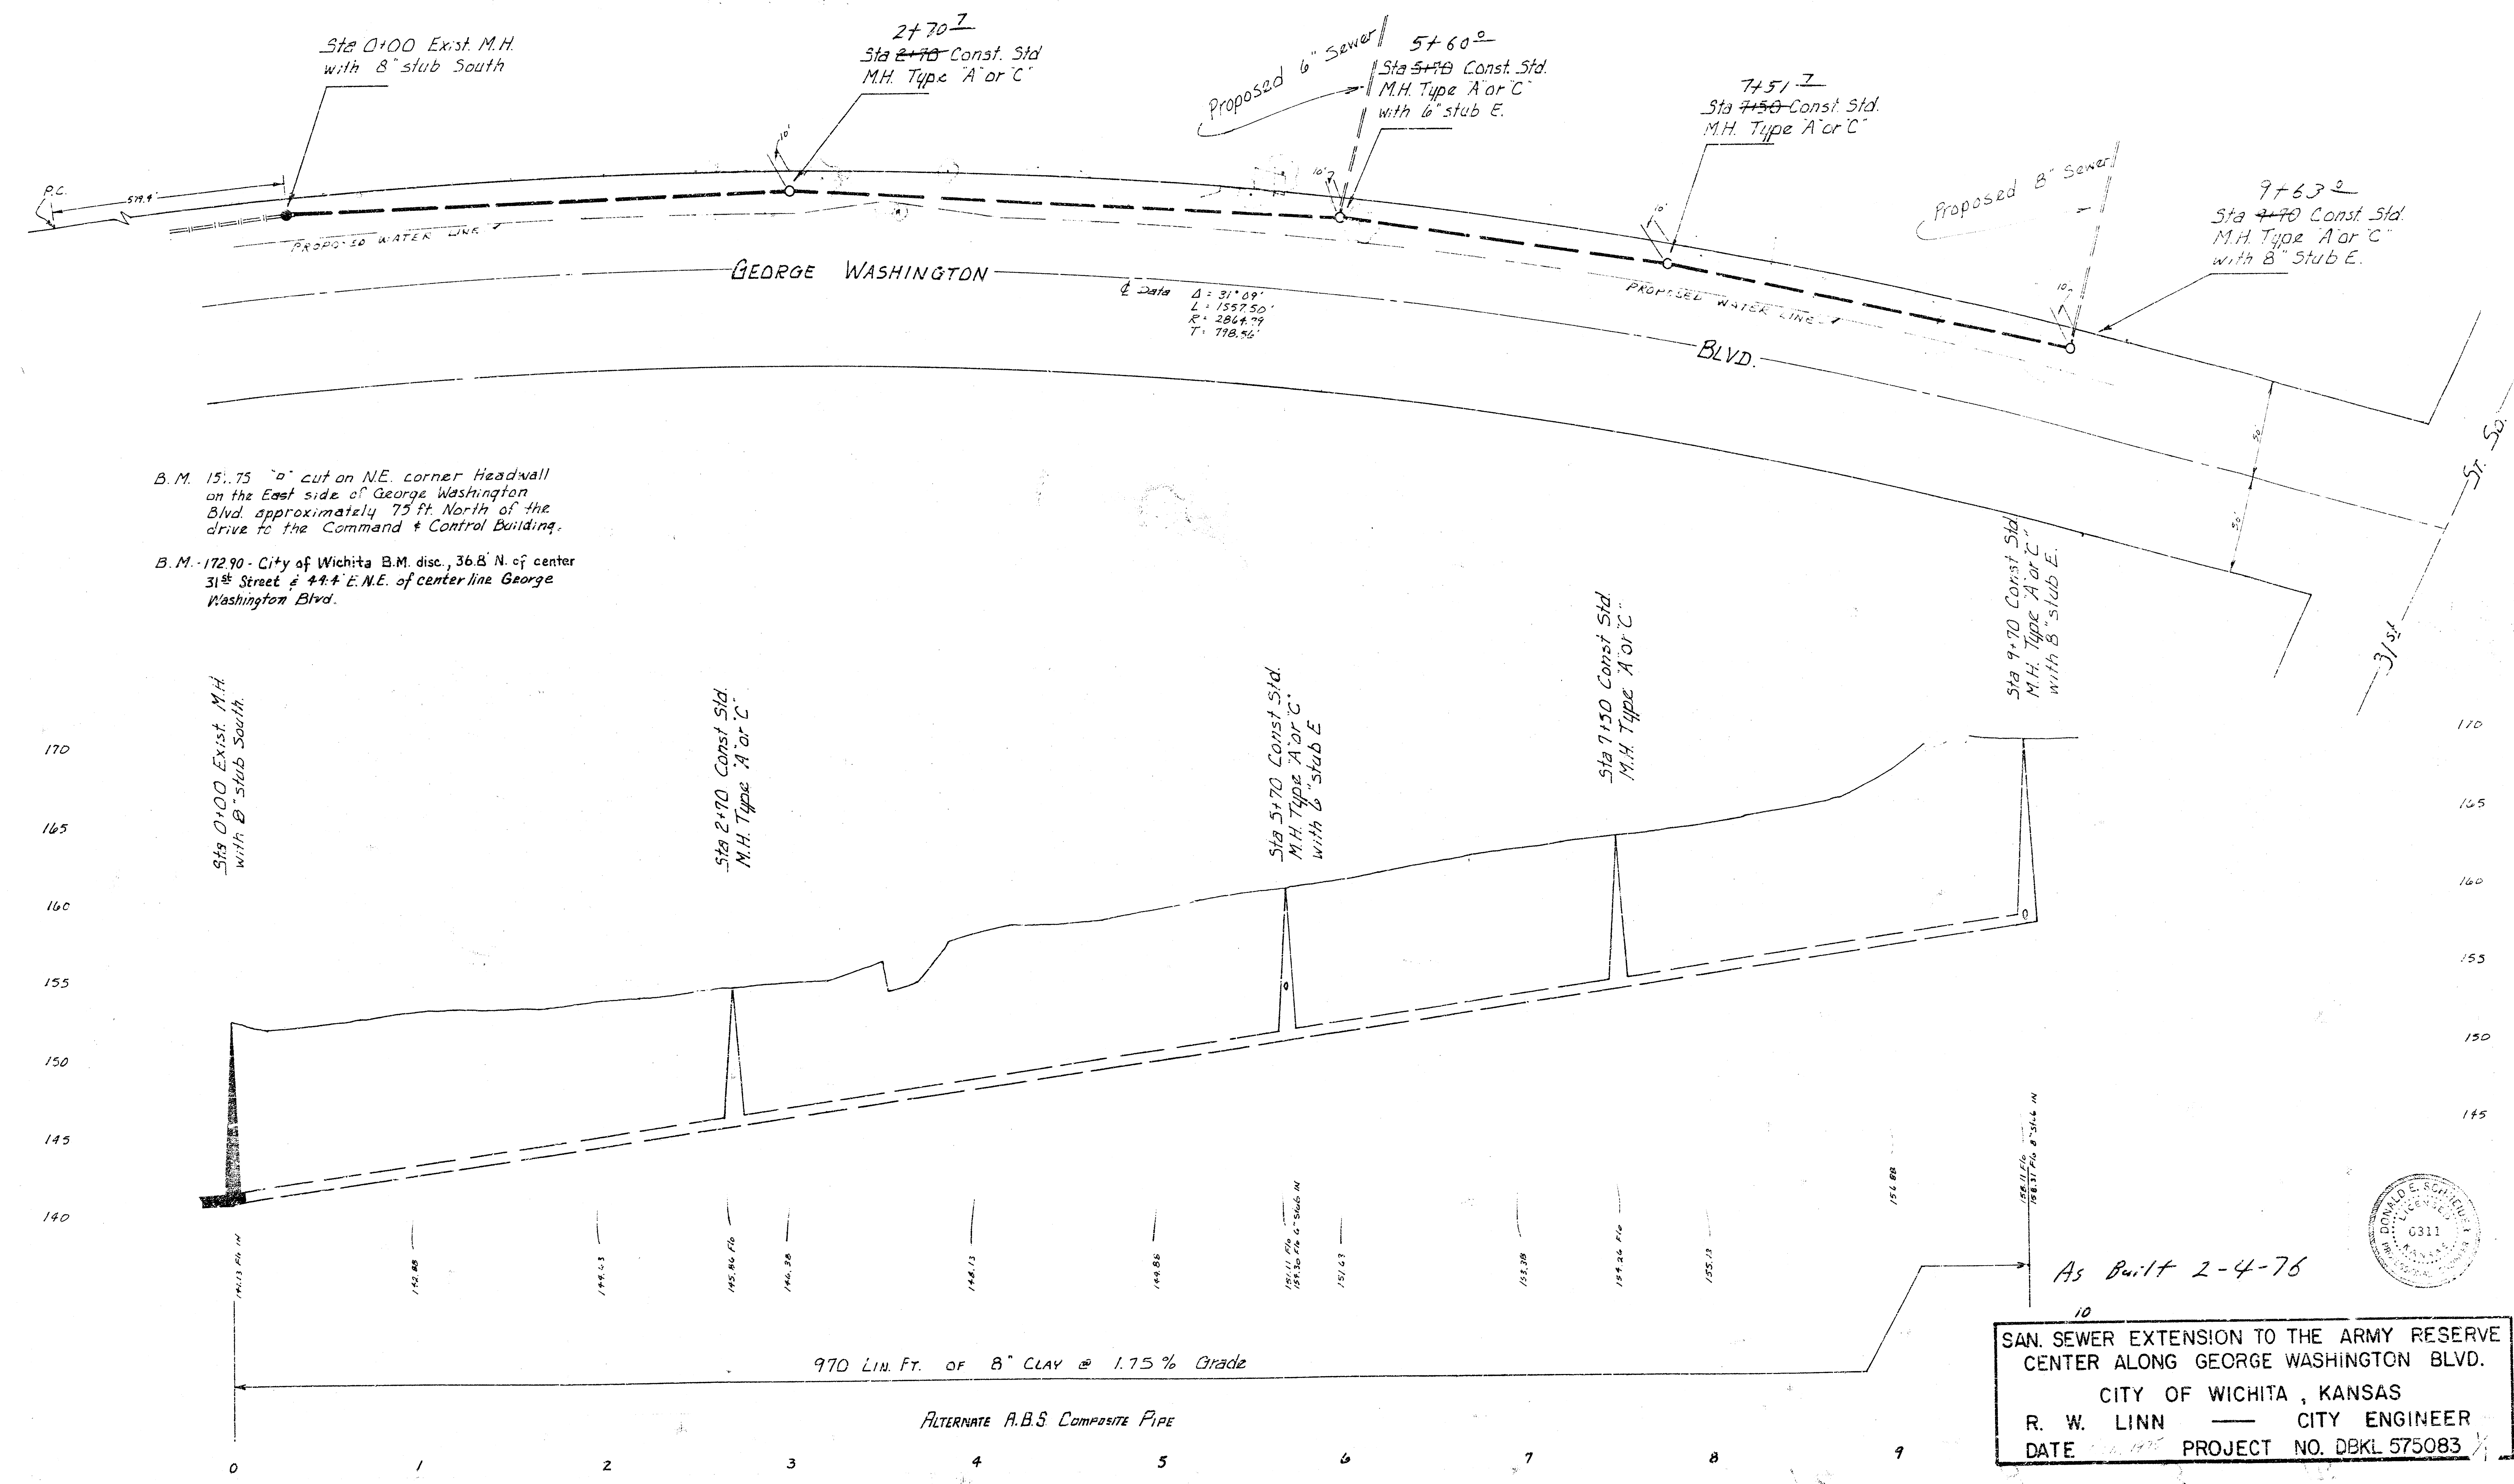

As Built 2-4-76

10

SAN SEWER EXTENSION TO THE ARMY RESERVE CENTER ALONG GEORGE WASHINGTON BLVD.

CITY OF WICHITA, KANSAS

R. W. LINN — CITY ENGINEER

DATE 1-14-76 PROJECT NO. DBKL 575083

