
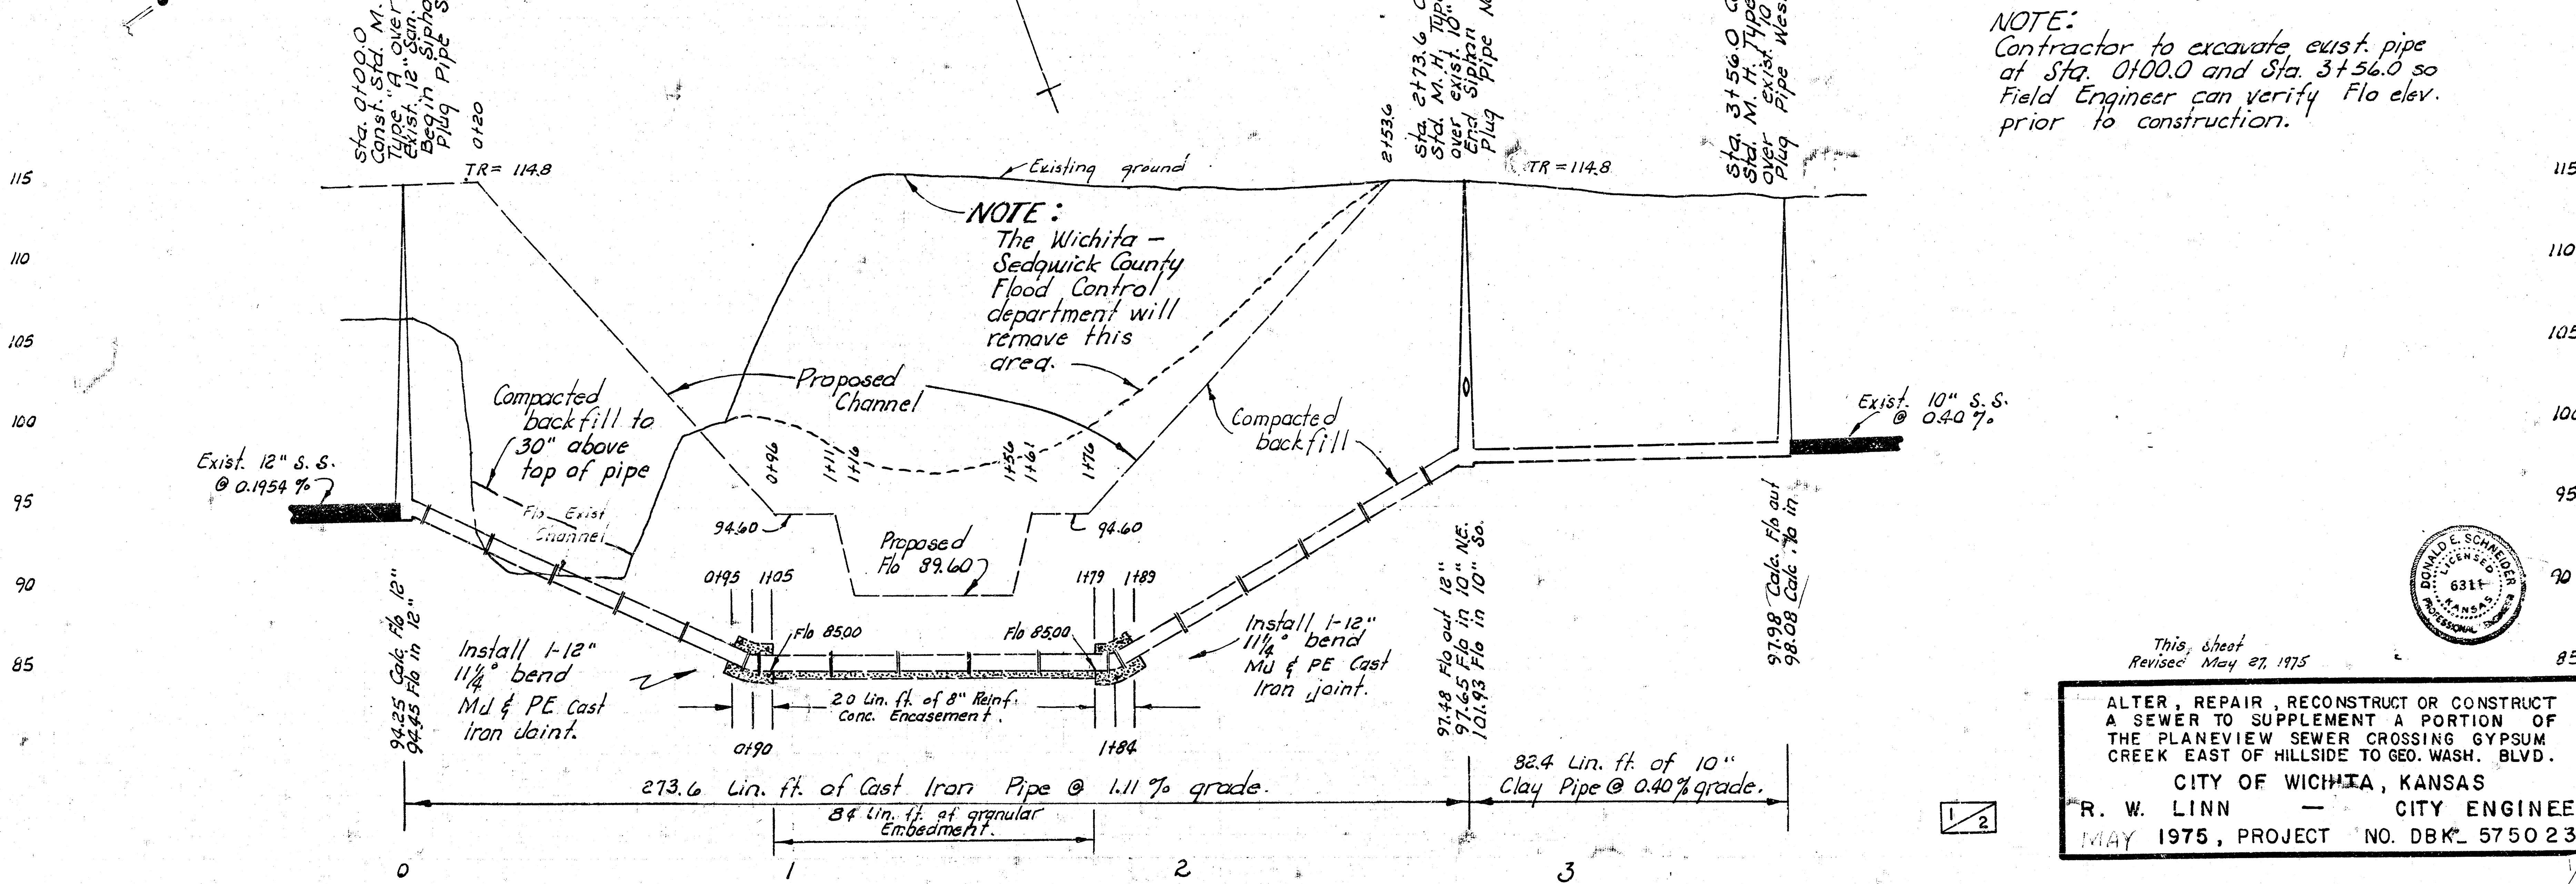



B.M. 117.17 brass Plug top conc. wing wall NE. cor. bridge 1300' S. of Pawnee on Geo. Washington Blvd.
 B.M. 116.24 "A" top cb. ctr. median west on Ross Parkway 214' W. of Geo. Wash. Blvd.
 B.M. 114.55 "A" cut bk. wk. SE. cor. Whitney Lane & Fees St.

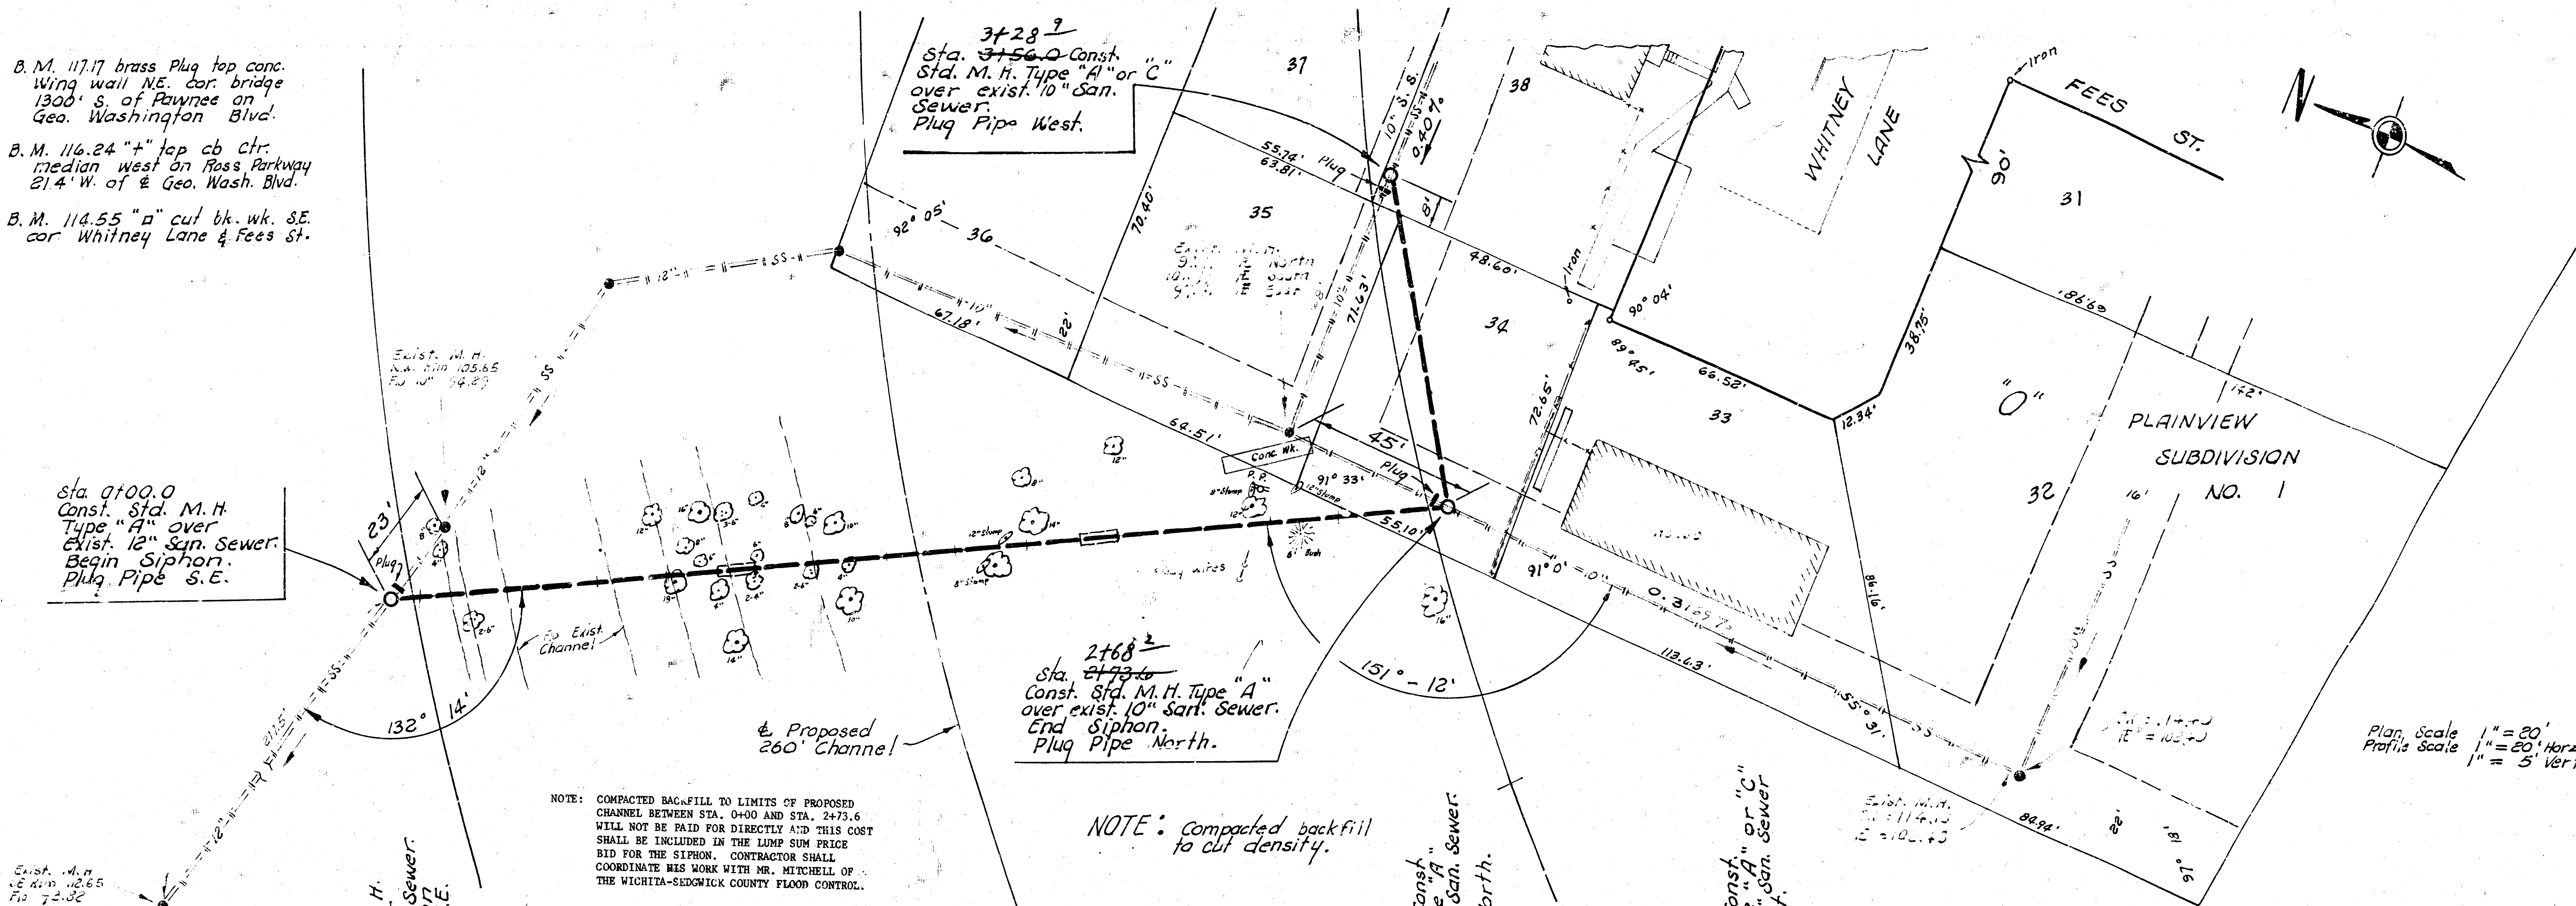



NOTE: Contractor to excavate exist. pipe at Sta. 0+00.0 and Sta. 3+56.0 so Field Engineer can verify Flo elev. prior to construction.

NOTE: The Wichita - Sedgwick County Flood Control department will remove this area.

ALTER, REPAIR, RECONSTRUCT OR CONSTRUCT A SEWER TO SUPPLEMENT A PORTION OF THE PLAINVIEW SEWER CROSSING GYPSUM CREEK EAST OF HILLSIDE TO GEO. WASH. BLVD.
 CITY OF WICHITA, KANSAS
 R. W. LINN — CITY ENGINEER
 MAY 1975, PROJECT NO. DBK- 5750 23

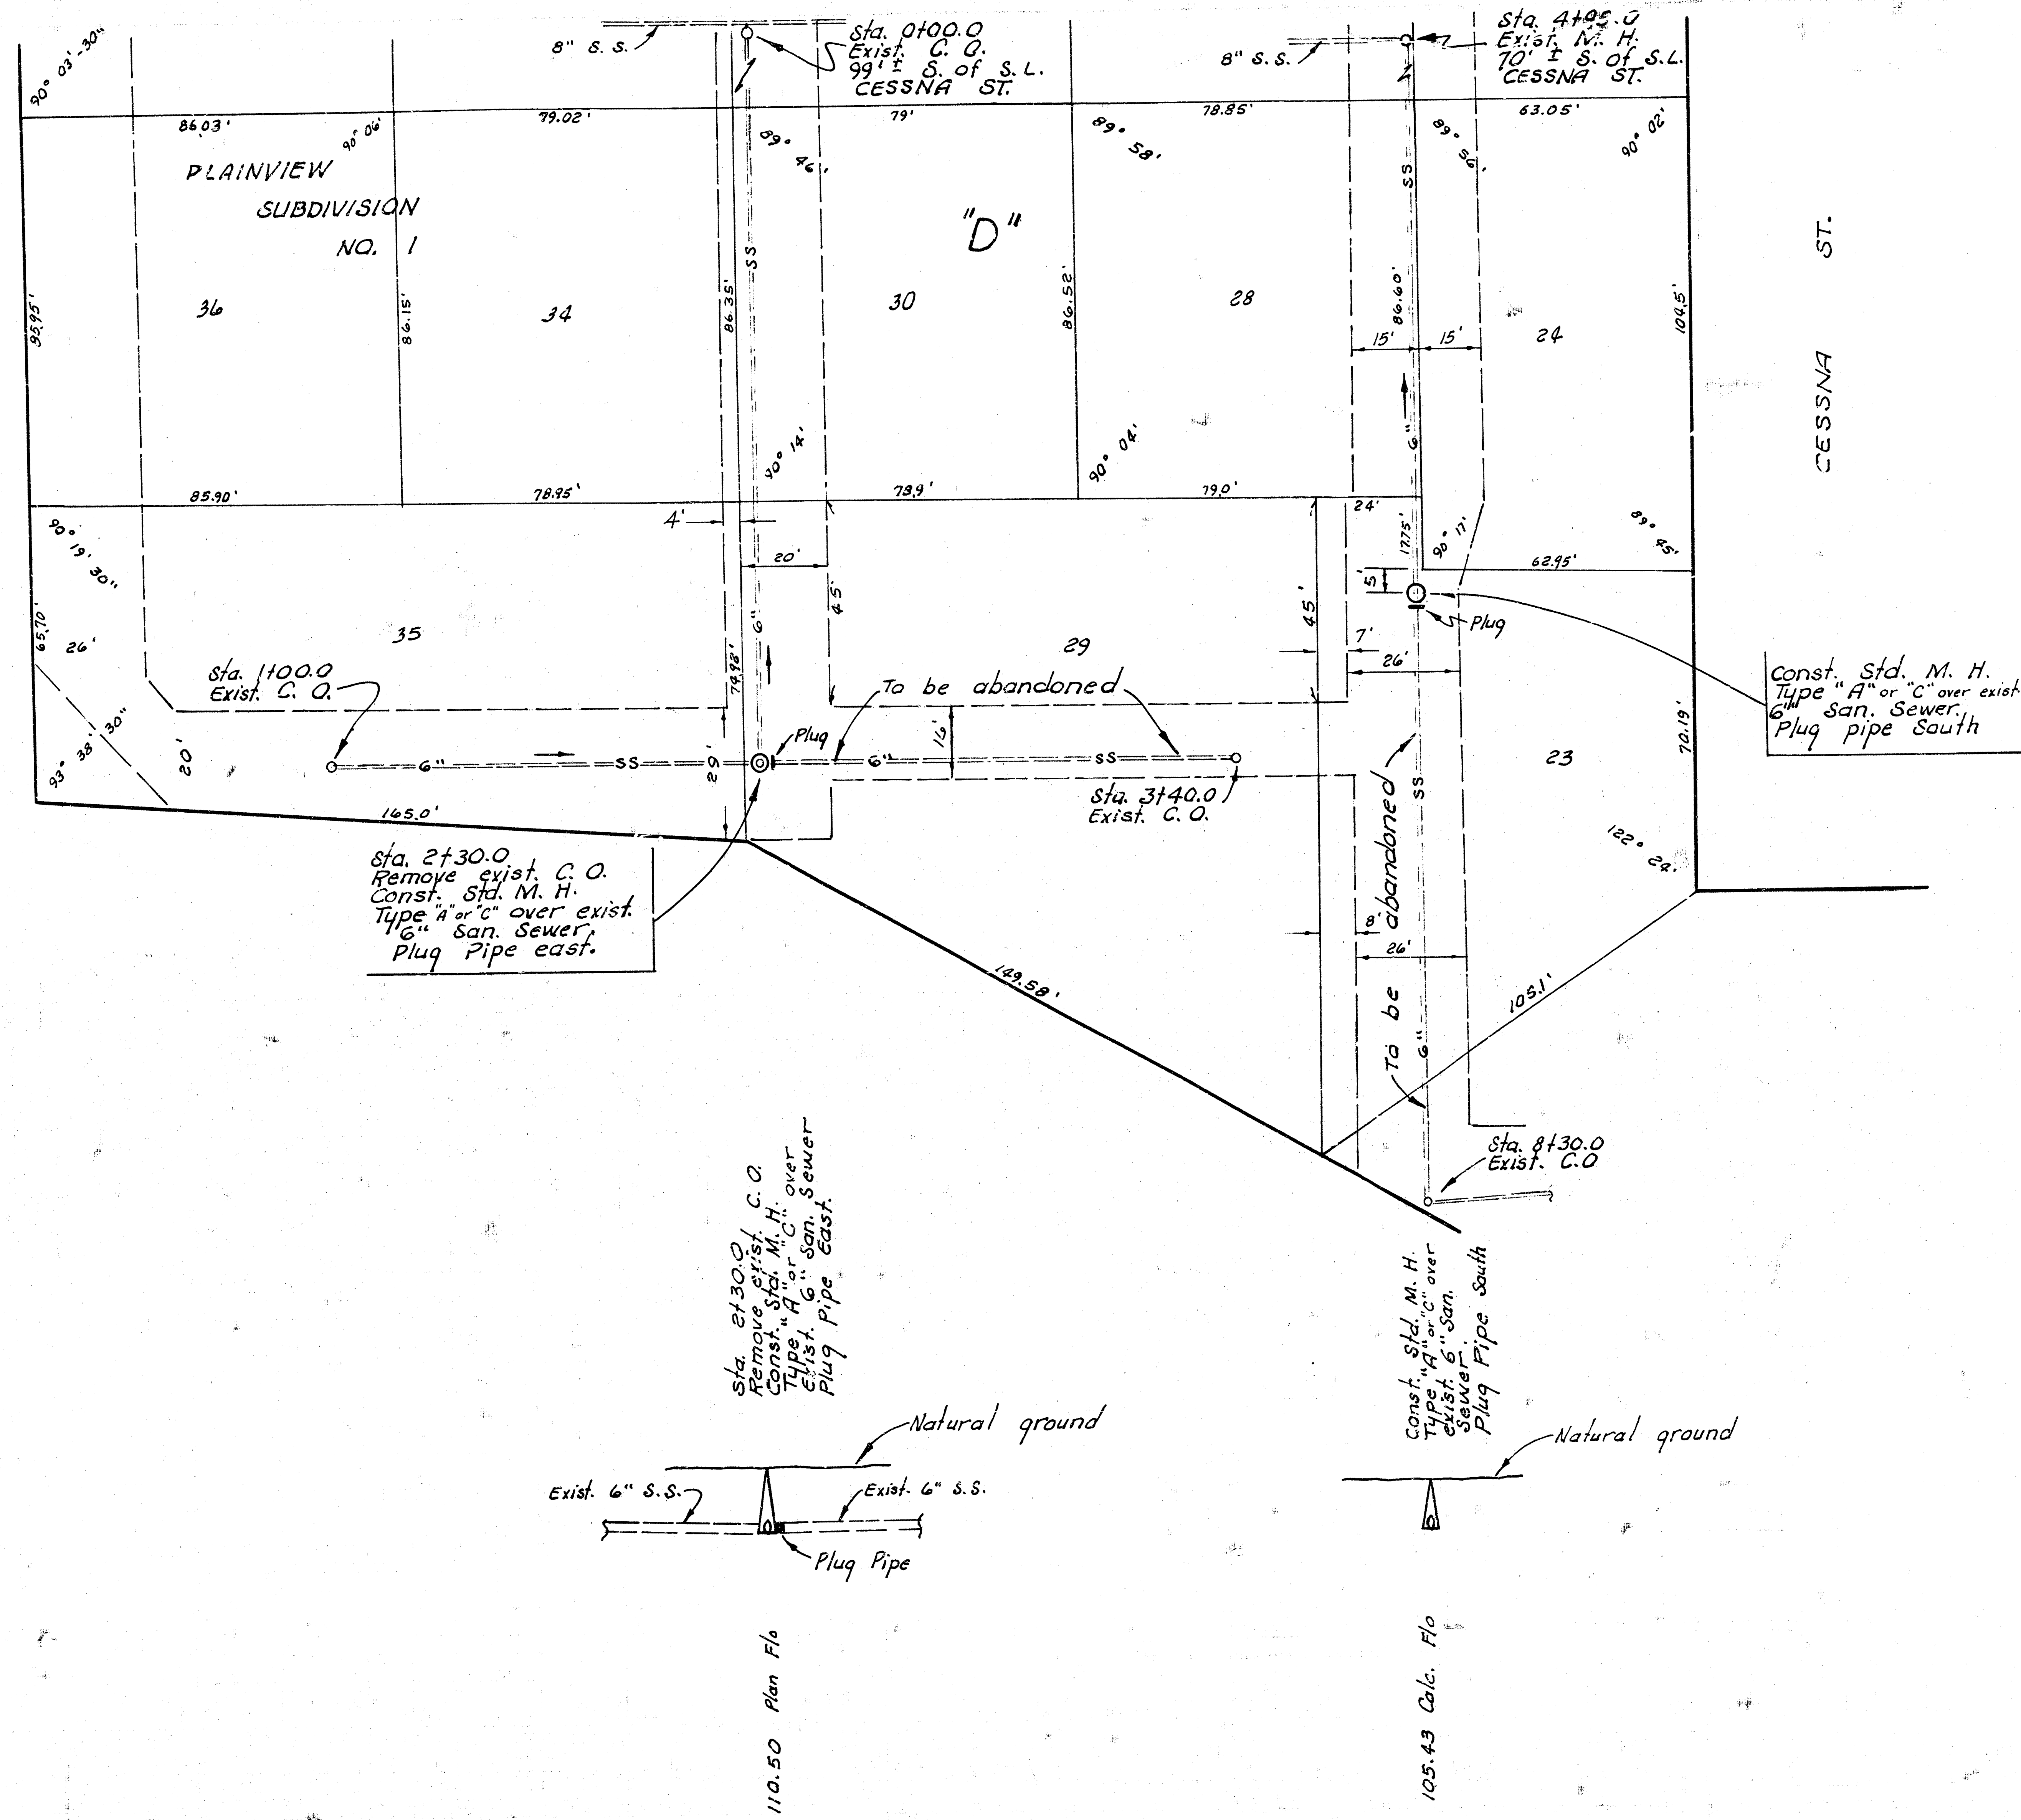

Plan Scale 1" = 20'
 Profile Scale 1" = 20' Horiz.
 1" = 5' Vert.

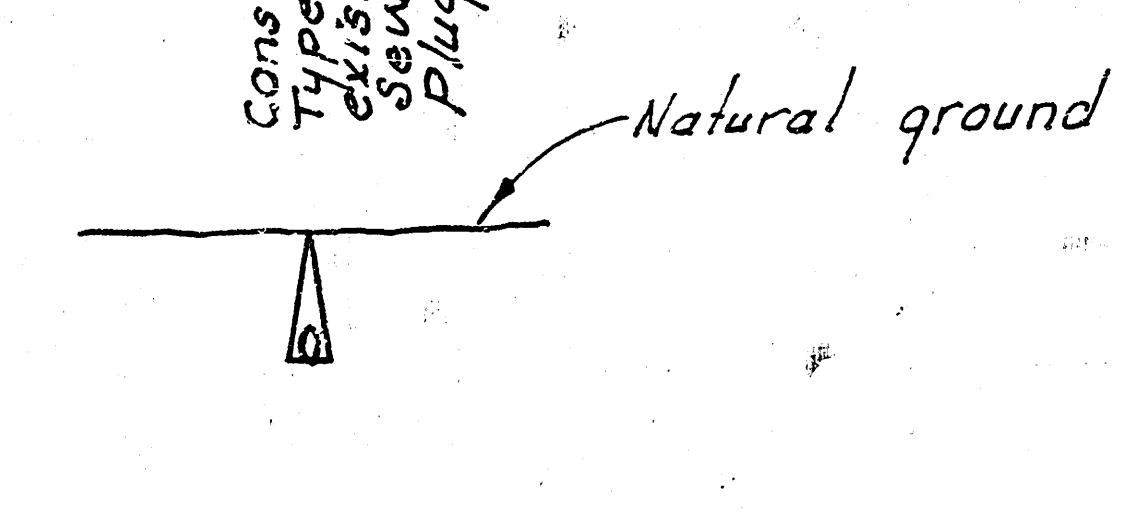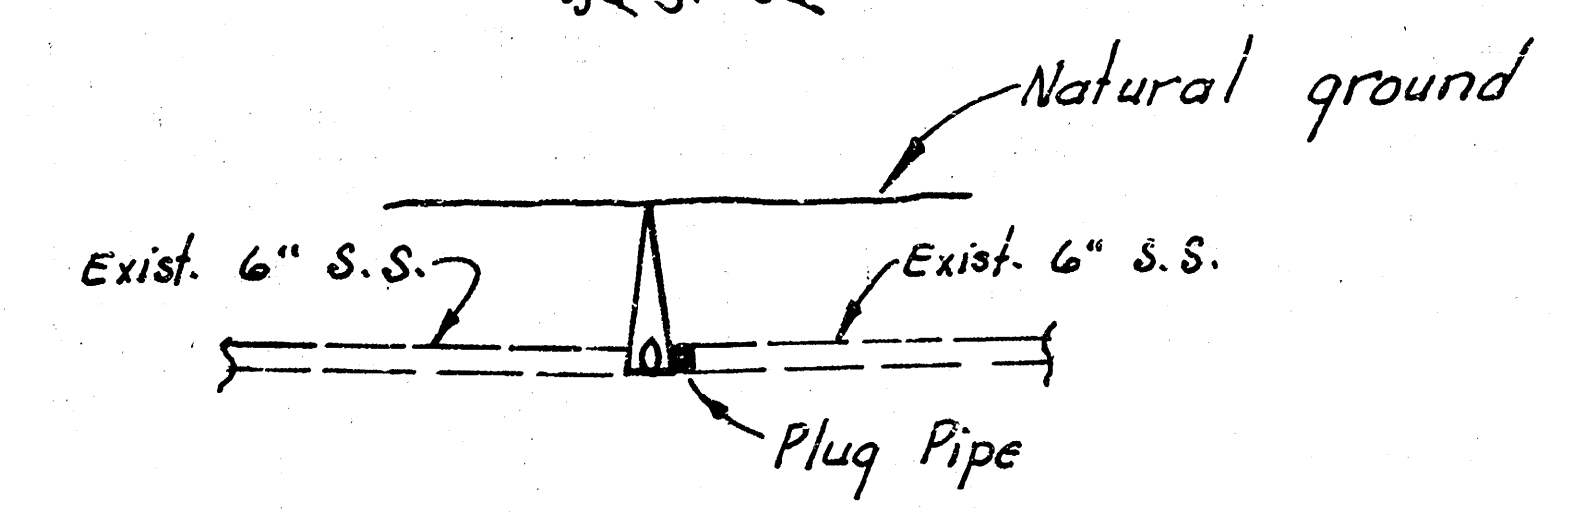

115
 110
 105

115
 110
 105

2/2

PROJECT NO. DBKL 575023 2/2