


2




FAIRVIEW

B.M. 119.16 Brass Rod in concrete post 24.5' N of E
17th St. and 22.5' E. of Ave E of Arkansas Ave.
B.M. 124.57 SW corner bottom conc. step House #
1742 N. Waco.
B.M. 122.87 SE corner conc. porch House # 224 W. 15th St.

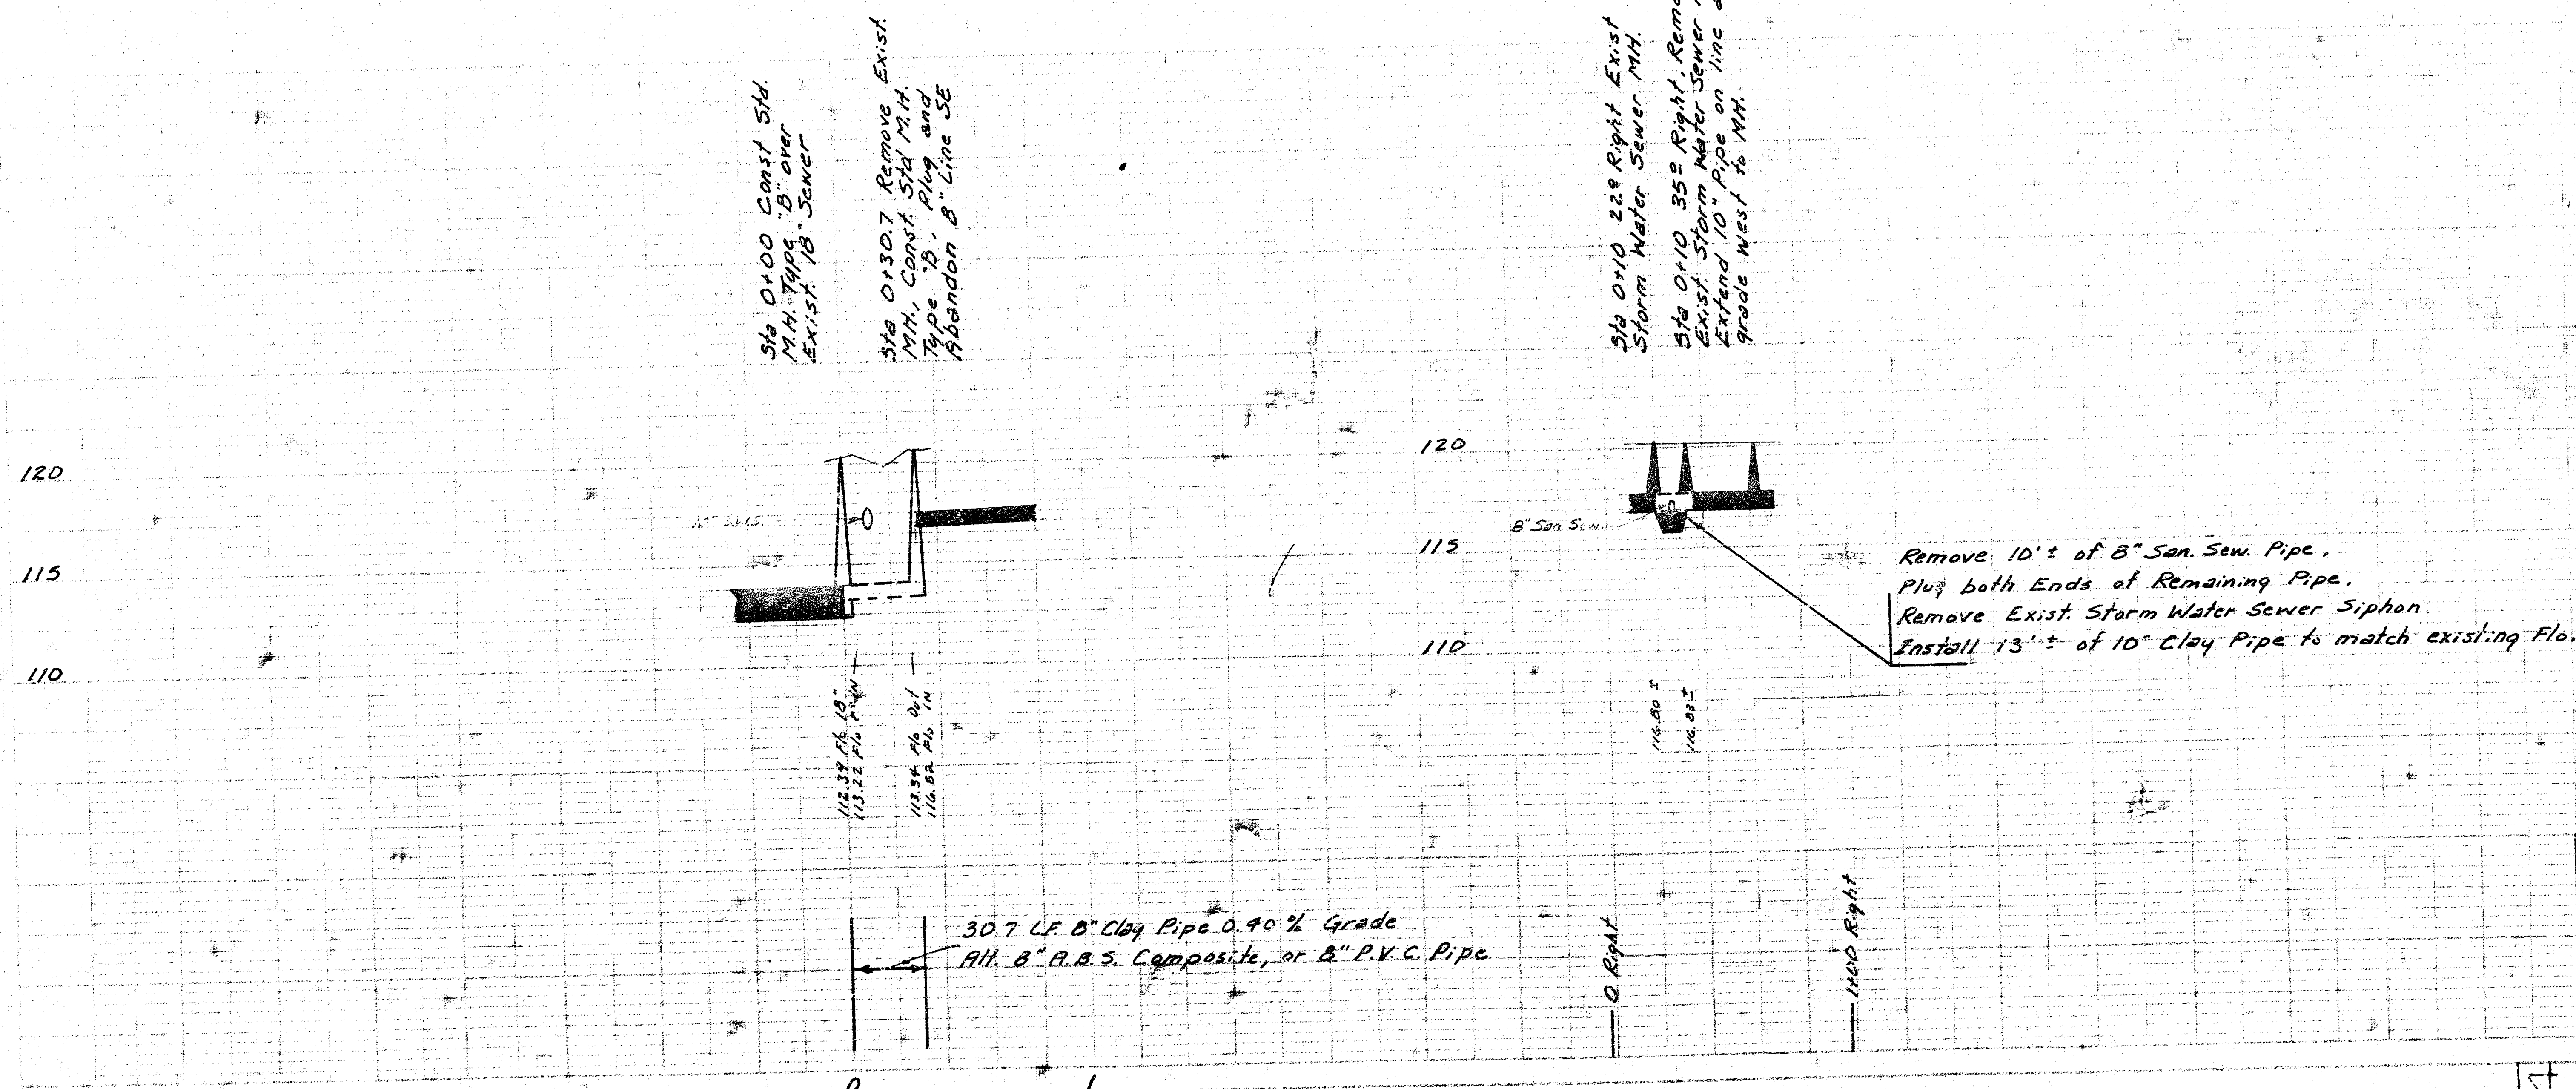

As Built
8/81

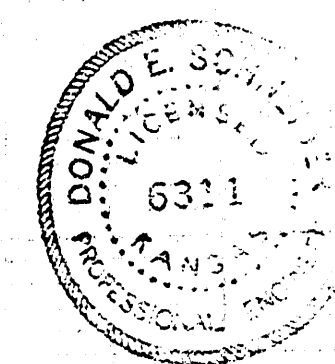

RECONSTRUCTION OF A PORTION OF S.S. #1
BETWEEN WACO AND FAIRVIEW AT 15TH ST. NO.
CITY OF WICHITA, KANSAS
R.W. BRUGGEMAN
DIRECTOR OF ENGINEERING - CITY ENGINEER
PROJ. NO. 542-80-245-80034-000-000-001

FILMED FROM THE BEST AVAILABLE COPY