

MOSLEY

SPECIAL NOTES

SHEET
1 of 2

1. FIELD ENGINEER SHALL DETERMINE IF THE CONDITION OF MANHOLES AT STATIONS 3+45 AND 6+27.7 WARRANTS REMOVAL AND REPLACEMENT OR ONLY INVERT ADJUSTMENTS. IF MANHOLES CAN BE SAVED ADJUST PIPE AND MANHOLE INVERT TO DESIGN GRADES.
2. V.C.P. - D.I.P. JOINT SHALL BE CONSTRUCTED TO OBTAIN A SMOOTH FLOWLINE GRADE AND WATER-TIGHT JOINT BETWEEN PIPES.

GENERAL NOTES

1. CONTRACTOR'S METHOD FOR HANDLING SEWAGE FLOWS DURING CONSTRUCTION SHALL BE APPROVED BY THE ENGINEER.
2. ONLY ACTIVE BUILDING SANITARY SEWER LINES ARE TO BE RECONNECTED TO THE NEW SEWER. CONTRACTOR SHALL VERIFY WHICH LINES ARE ACTIVE.
3. IF DAMAGE TO TRAPS AND CLEAN OUTS IS UNAVOIDABLE DURING PROJECT CONSTRUCTION, THE DAMAGED TRAPS AND CLEAN OUTS SHALL BE REPLACED.
4. INSPECTORS SHALL NOTE LOCATION AND DIRECTION OF RECONNECTED BUILDING SEWER LINES IN INSPECTOR'S REPORT.
5. CONTRACTOR SHALL GIVE ALL PROPERTY OWNERS AND TENANTS AFFECTED BY THE CONSTRUCTION OF THIS PROJECT A MINIMUM OF 48 HOURS ADVANCE NOTICE PRIOR TO START OF CONSTRUCTION.





Scale: 1" = 20' Plan
Vert. 1" = 5' Profile

Bench Mark: 117.17 - North 1" bolt at base of Alcoa sign, N. side of 13th St. N. of Mosley
T.B.M.: 115.62 - N. rim of MH @ Sta 0+00 Line 1A

THE CONTRACTOR SHALL BE RESPONSIBLE FOR PRESERVING PROPERTY IRONS. THE CONTRACTOR SHALL BE REQUIRED TO RE-ESTABLISH ANY PROPERTY IRONS WHICH ARE DAMAGED OR DESTROYED BY HIS CONSTRUCTION OPERATIONS. SUCH IRONS SHALL BE RE-ESTABLISHED BY A LICENSED LAND SURVEYOR OR A LICENSED PROFESSIONAL ENGINEER IN ACCORDANCE WITH STATE LAWS.

CAUTION
UNDERGROUND UTILITIES

Please check with K & E or Southwestern Bell Telephone Co. for Location

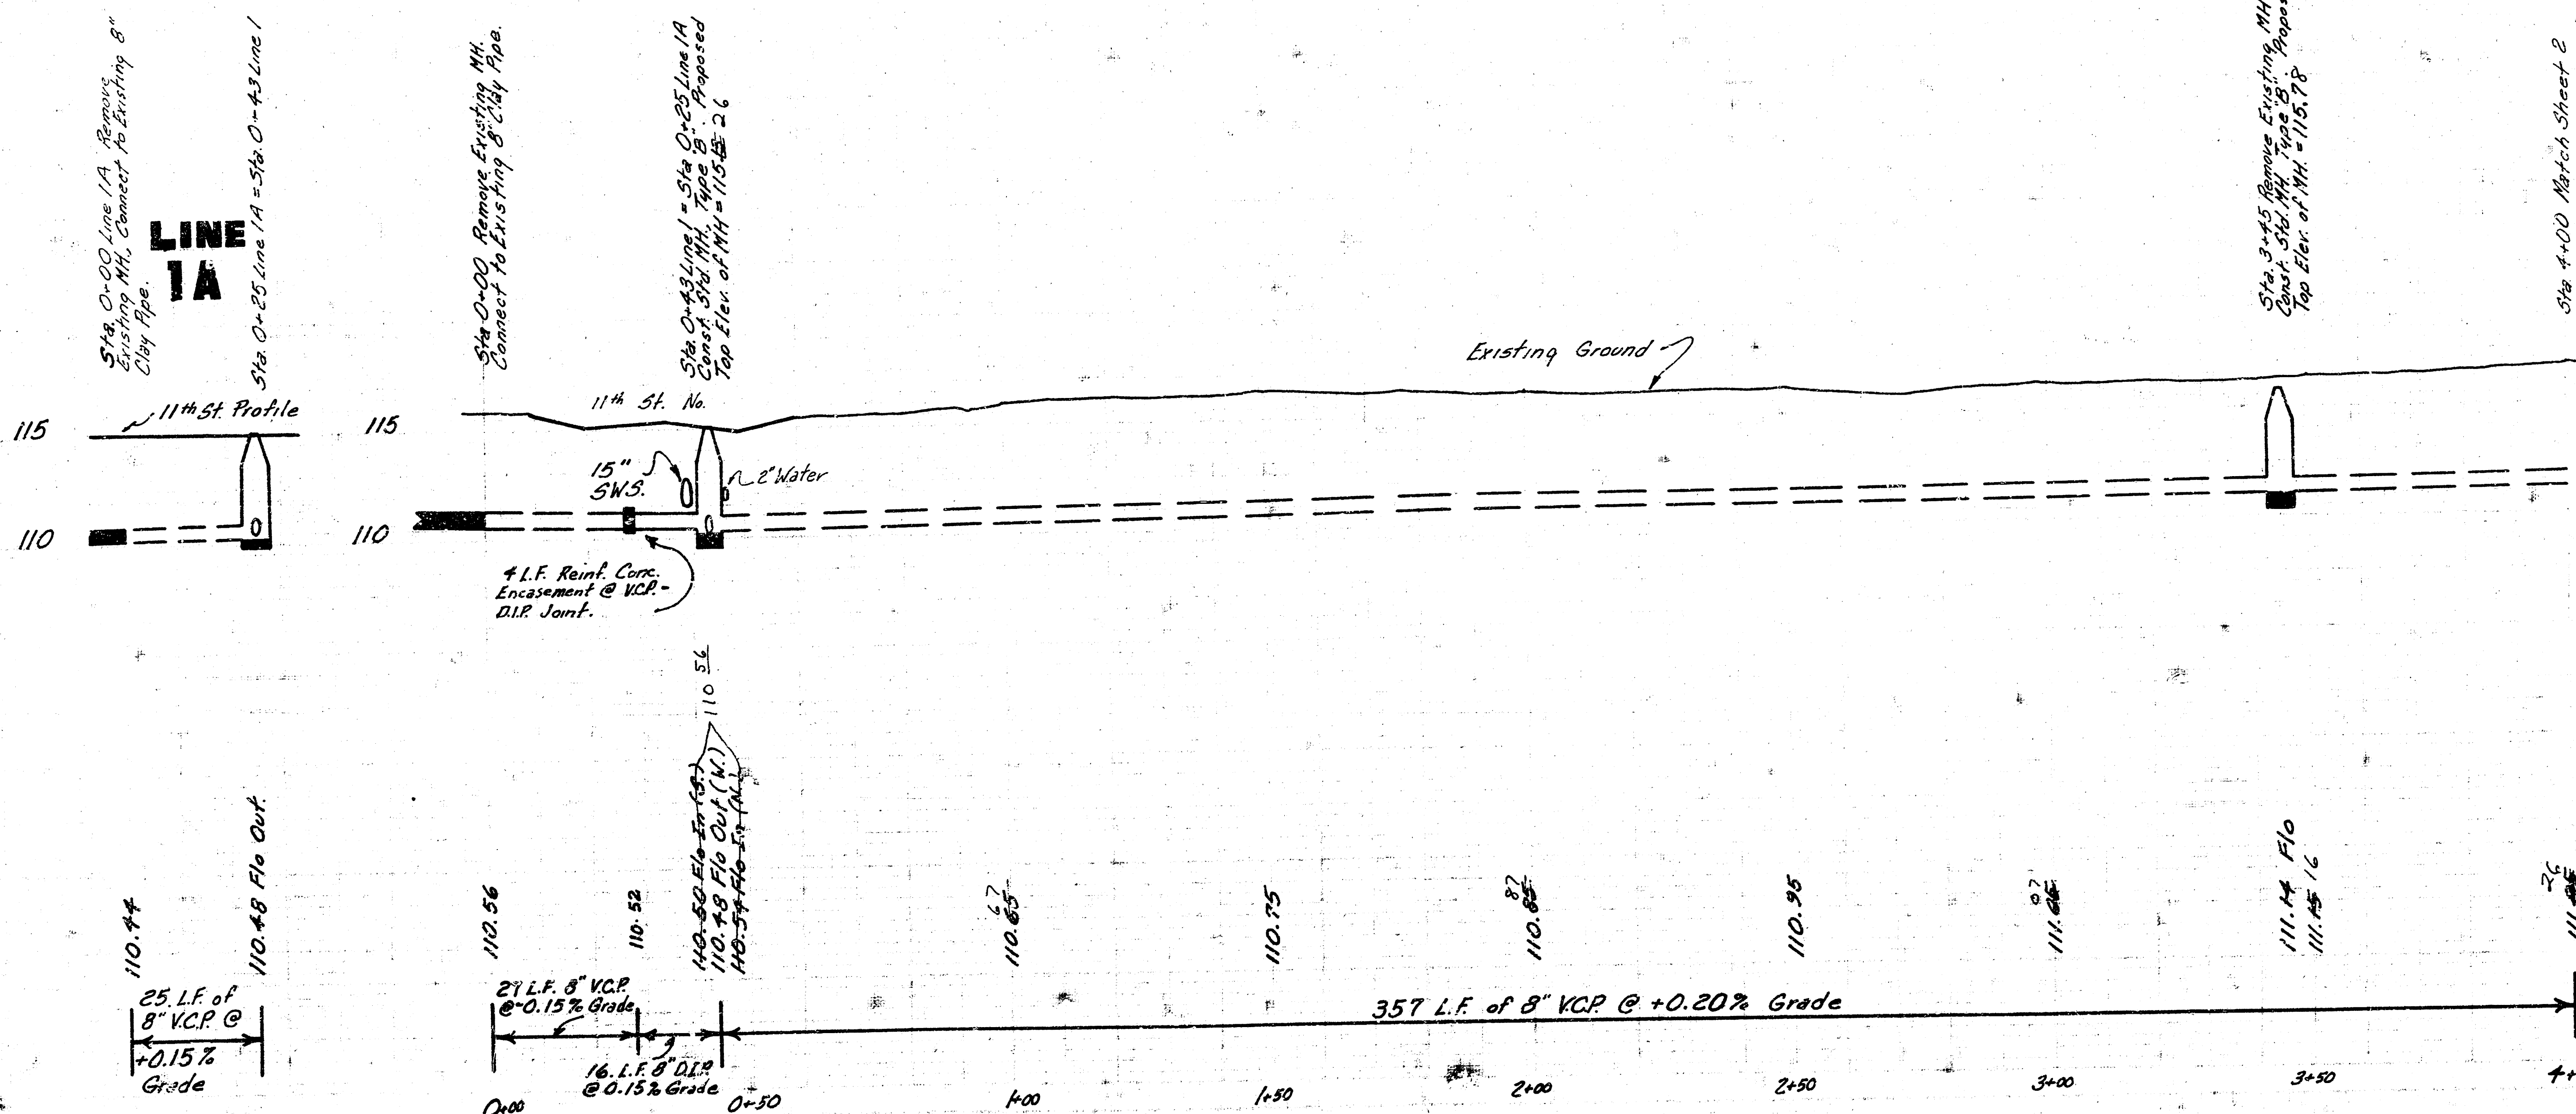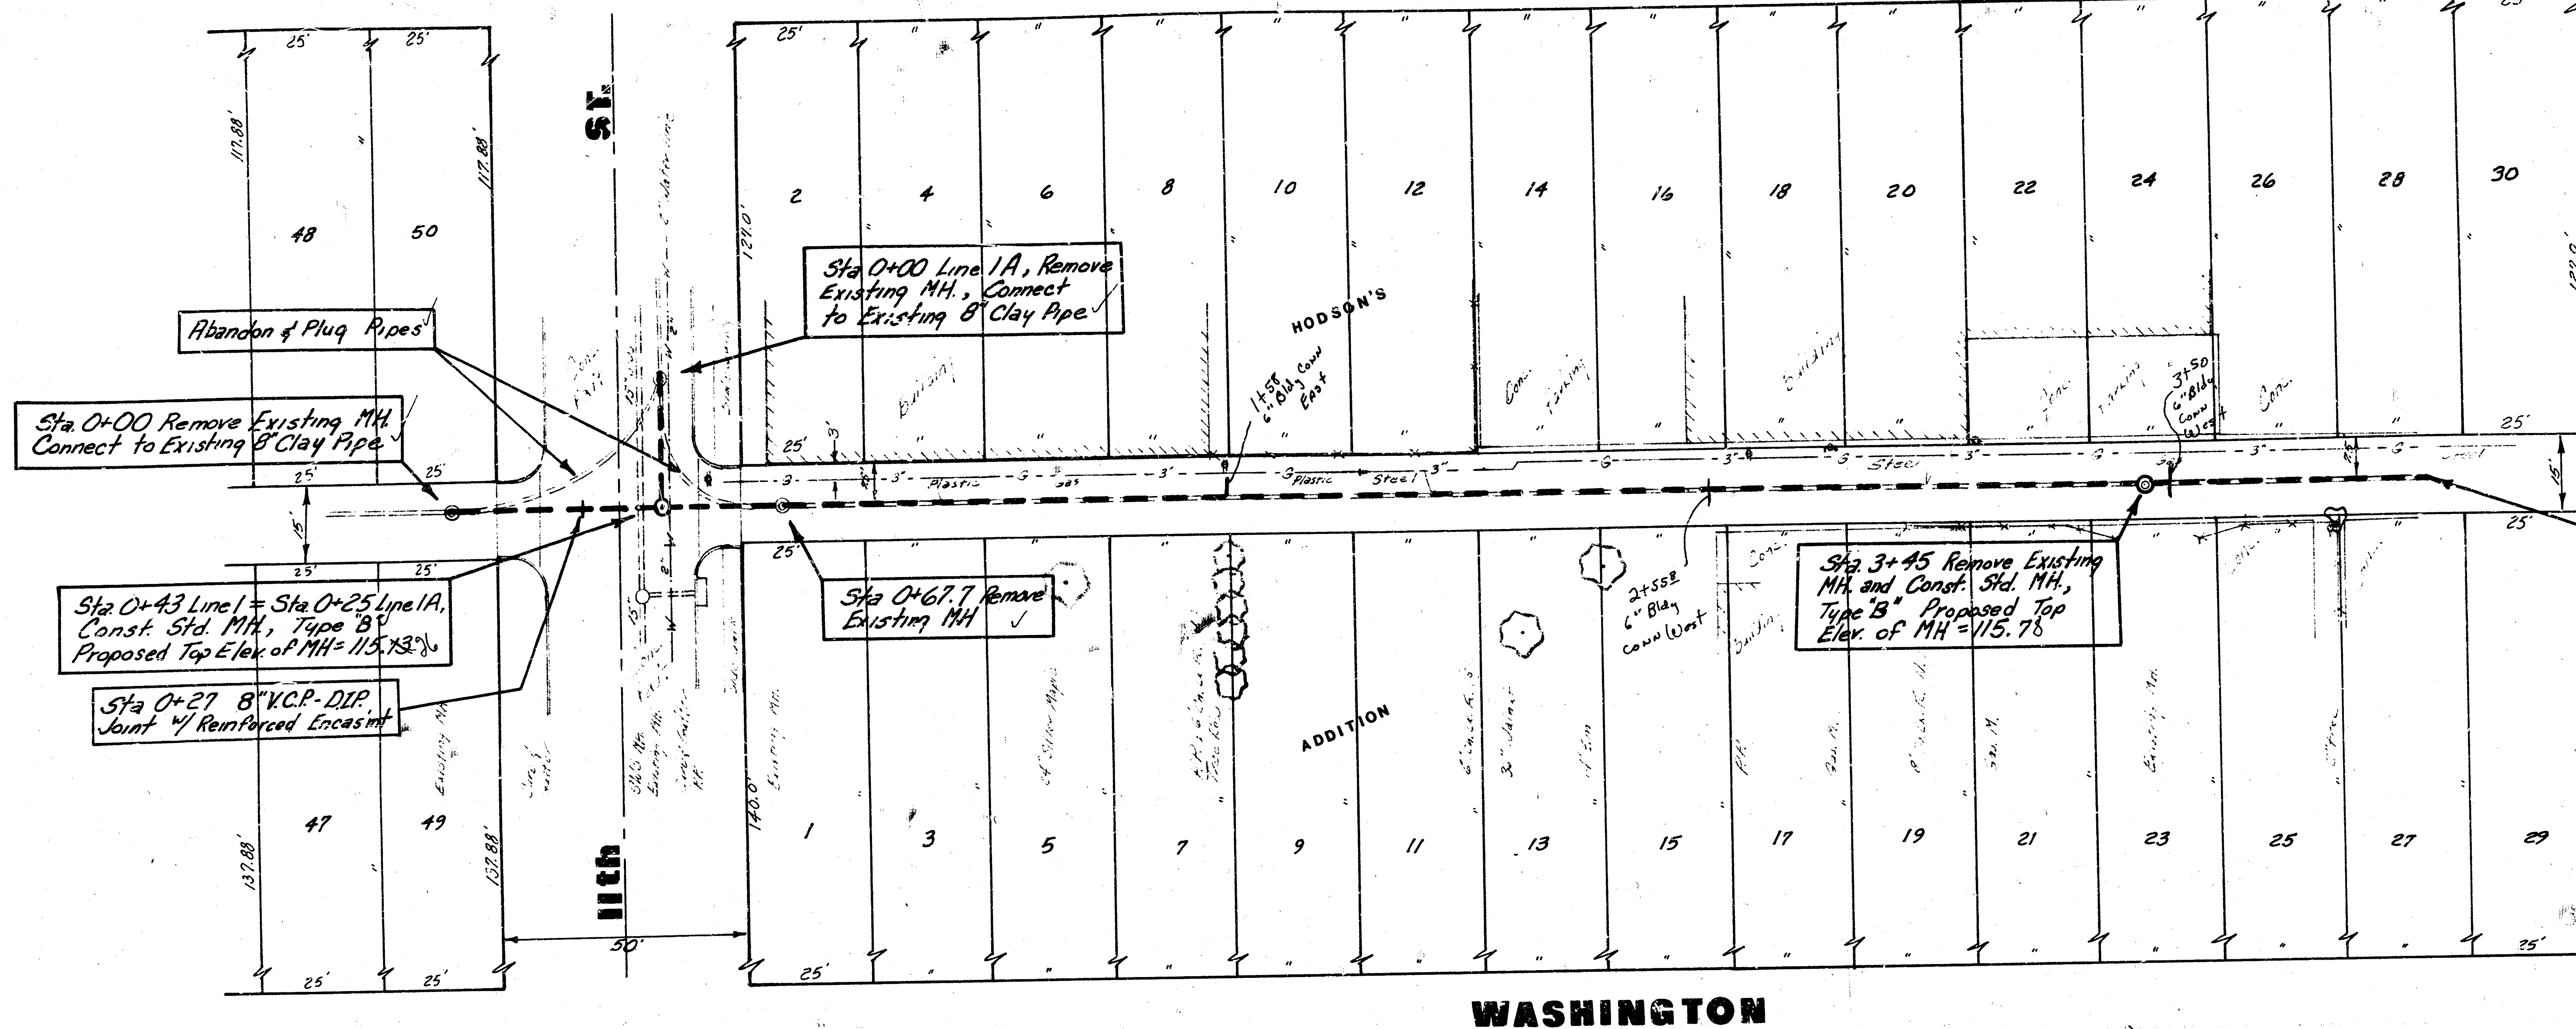


PROJECT DESCRIPTION		
RECONSTRUCTION OF A PORTION OF: East Submain "D" S.S. No. 1 IN THE ALLEY BETWEEN MOSLEY & WASHINGTON FROM 11TH TO 12TH ST. NO.		
PROJECT NUMBER 468-76-245-81200-000-000.001		
BOOK NO. DCD-251	APPROVED BY	DATE 8/82
DRAWN BY LINDSEY		REVISED
CITY OF WICHITA DEPARTMENT OF ENGINEERING		
DIRECTOR OF ENG./CITY ENGINEER R. W. BRUGGERMAN		SCALE

FILMED FROM THE BEST

Sheet
2 of 3

MOSLEY

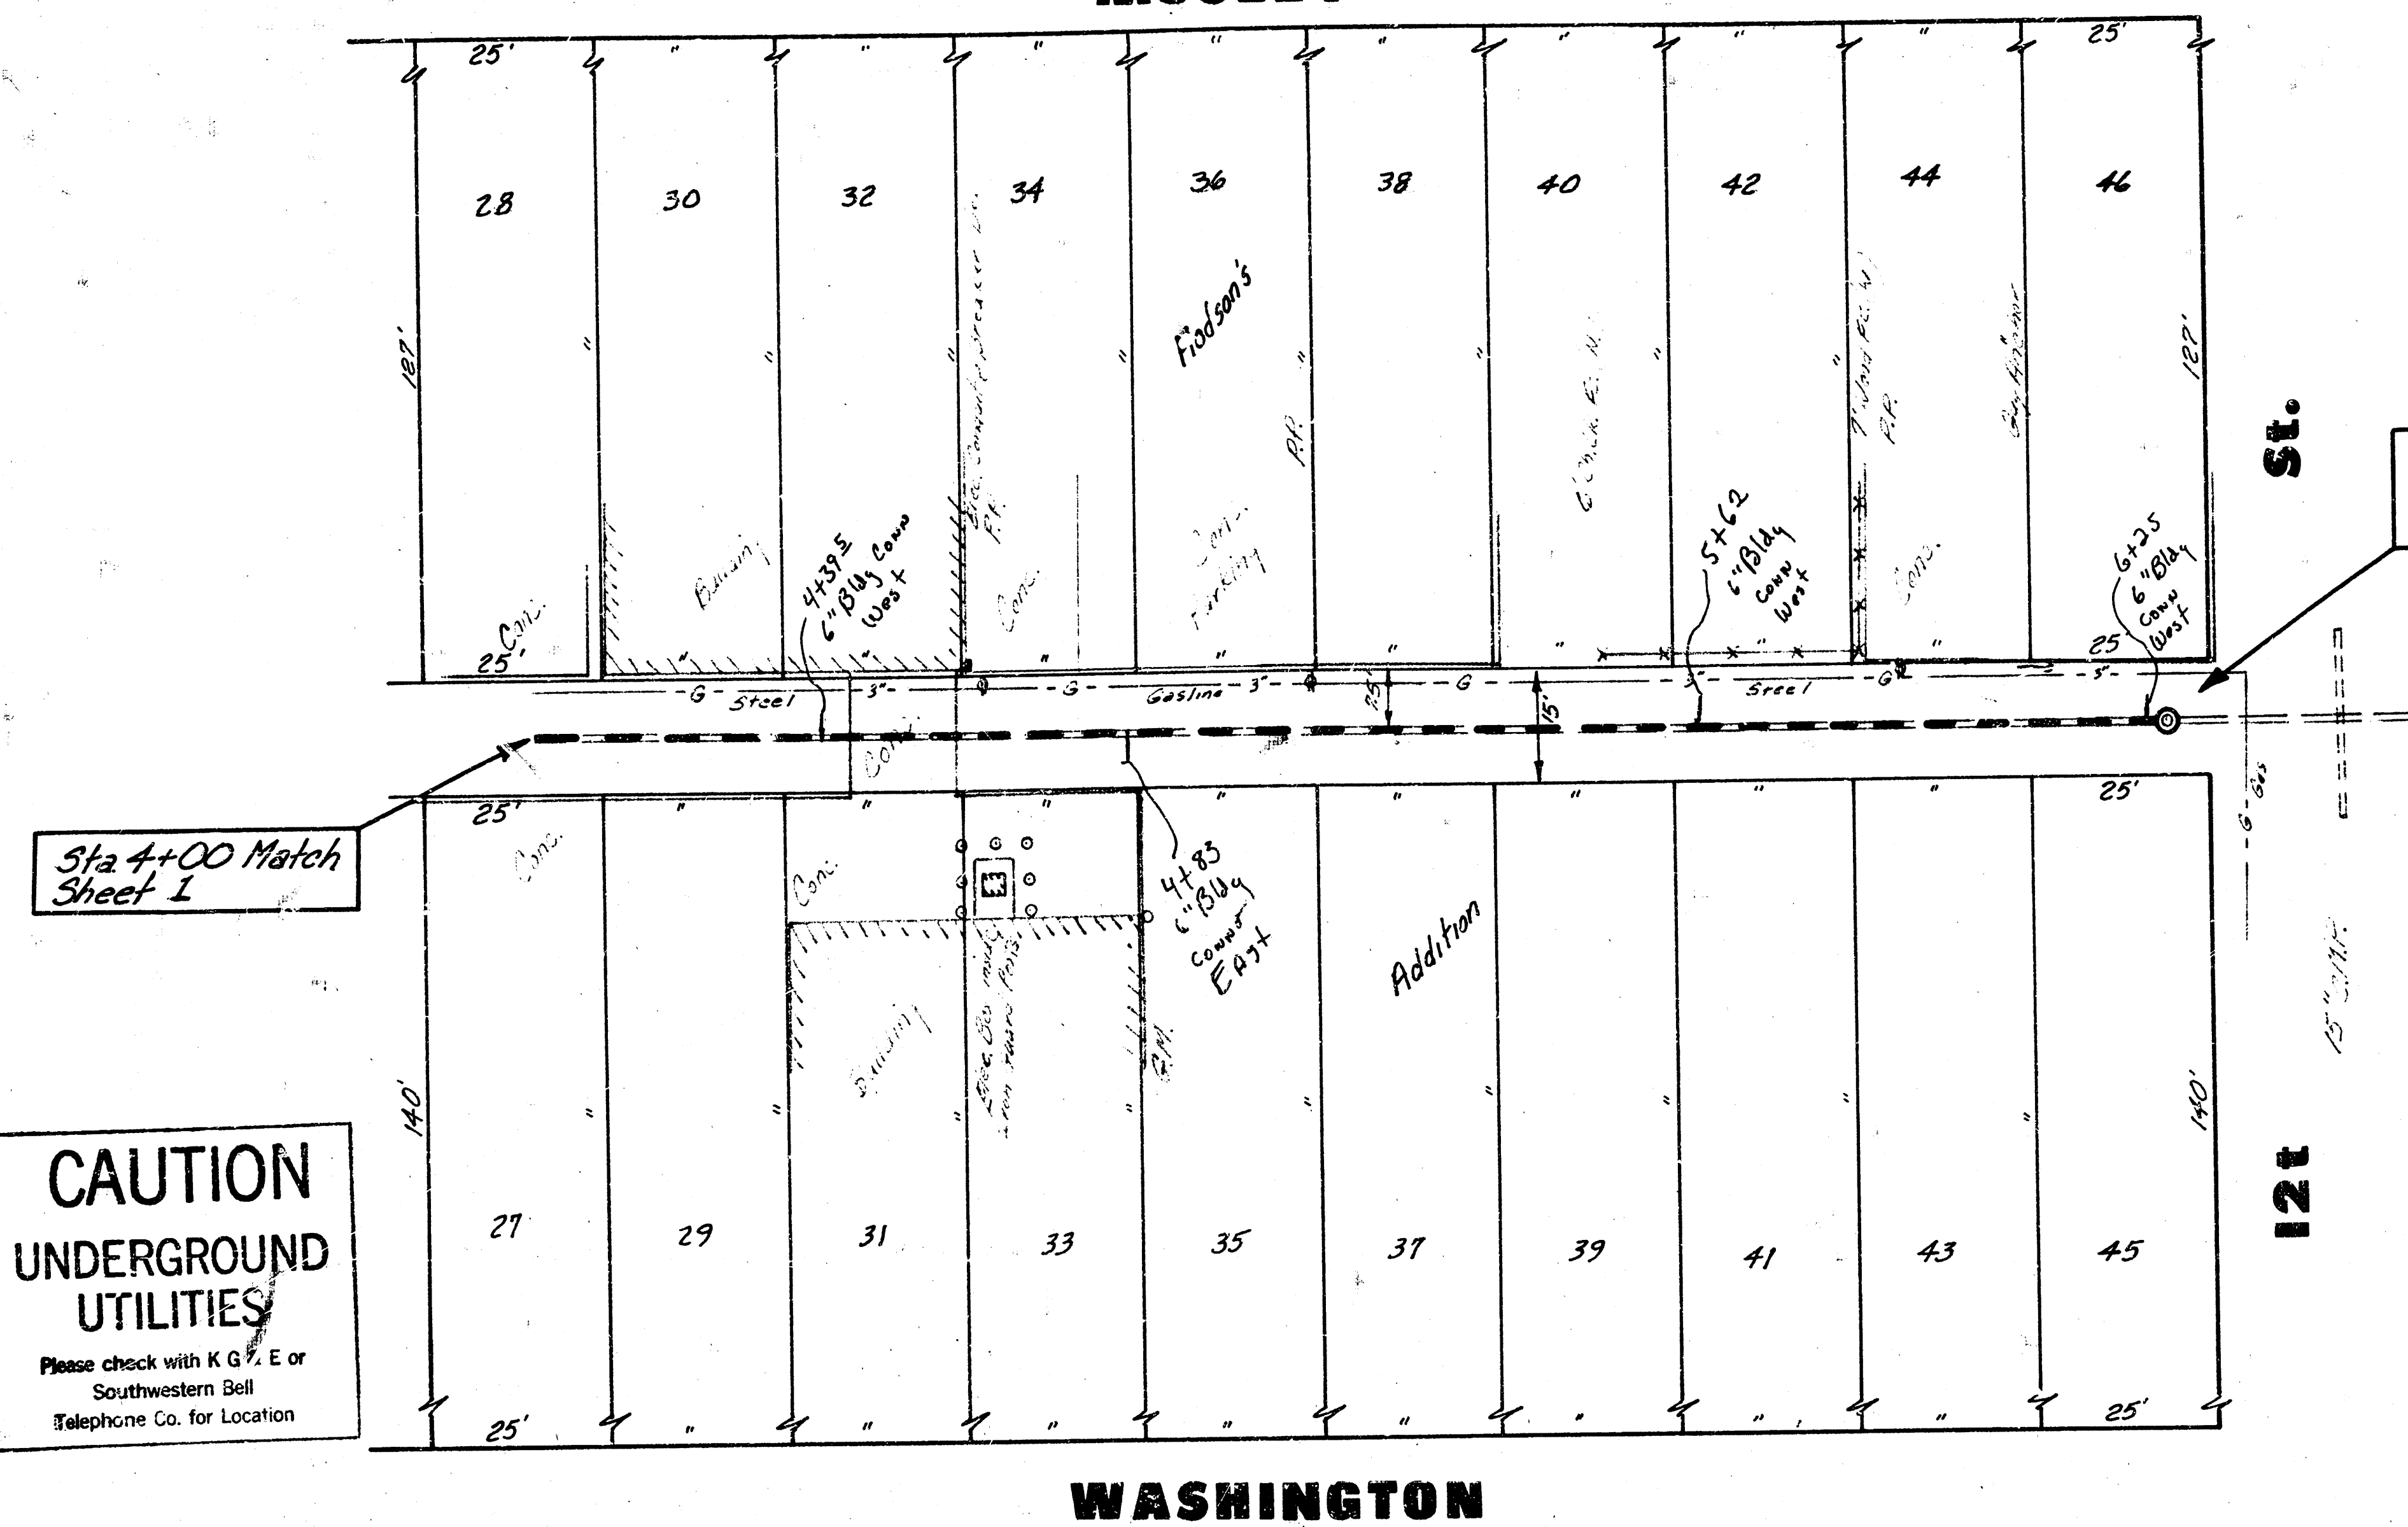


Sta. 6+27.7 Remove Existing
M.H., Const. Std. M.H. Type B
Proposed Top Elev. of M.H. = 116.18

N
Scale 1"=20' Plan
Hors. 1"=20' Profile
Vert. 1"=5'

As Built
J.L.L.
3-83

THE CONTRACTOR SHALL BE RESPONSIBLE
FOR PRESERVING PROPERTY IRONS. THE
CONTRACTOR SHALL BE REQUIRED TO RE-
ESTABLISH ANY PROPERTY IRONS WHICH
ARE DAMAGED OR DESTROYED BY HIS CON-
STRUCTION OPERATIONS. SUCH IRONS SHALL
BE RE-ESTABLISHED BY A LICENSED LAND
SURVEYOR OR A LICENSED PROFESSIONAL
ENGINEER IN ACCORDANCE WITH STATE LAWS.

CAUTION
UNDERGROUND
UTILITIES
Please check with K.G.F. E or
Southwestern Bell
Telephone Co. for Location

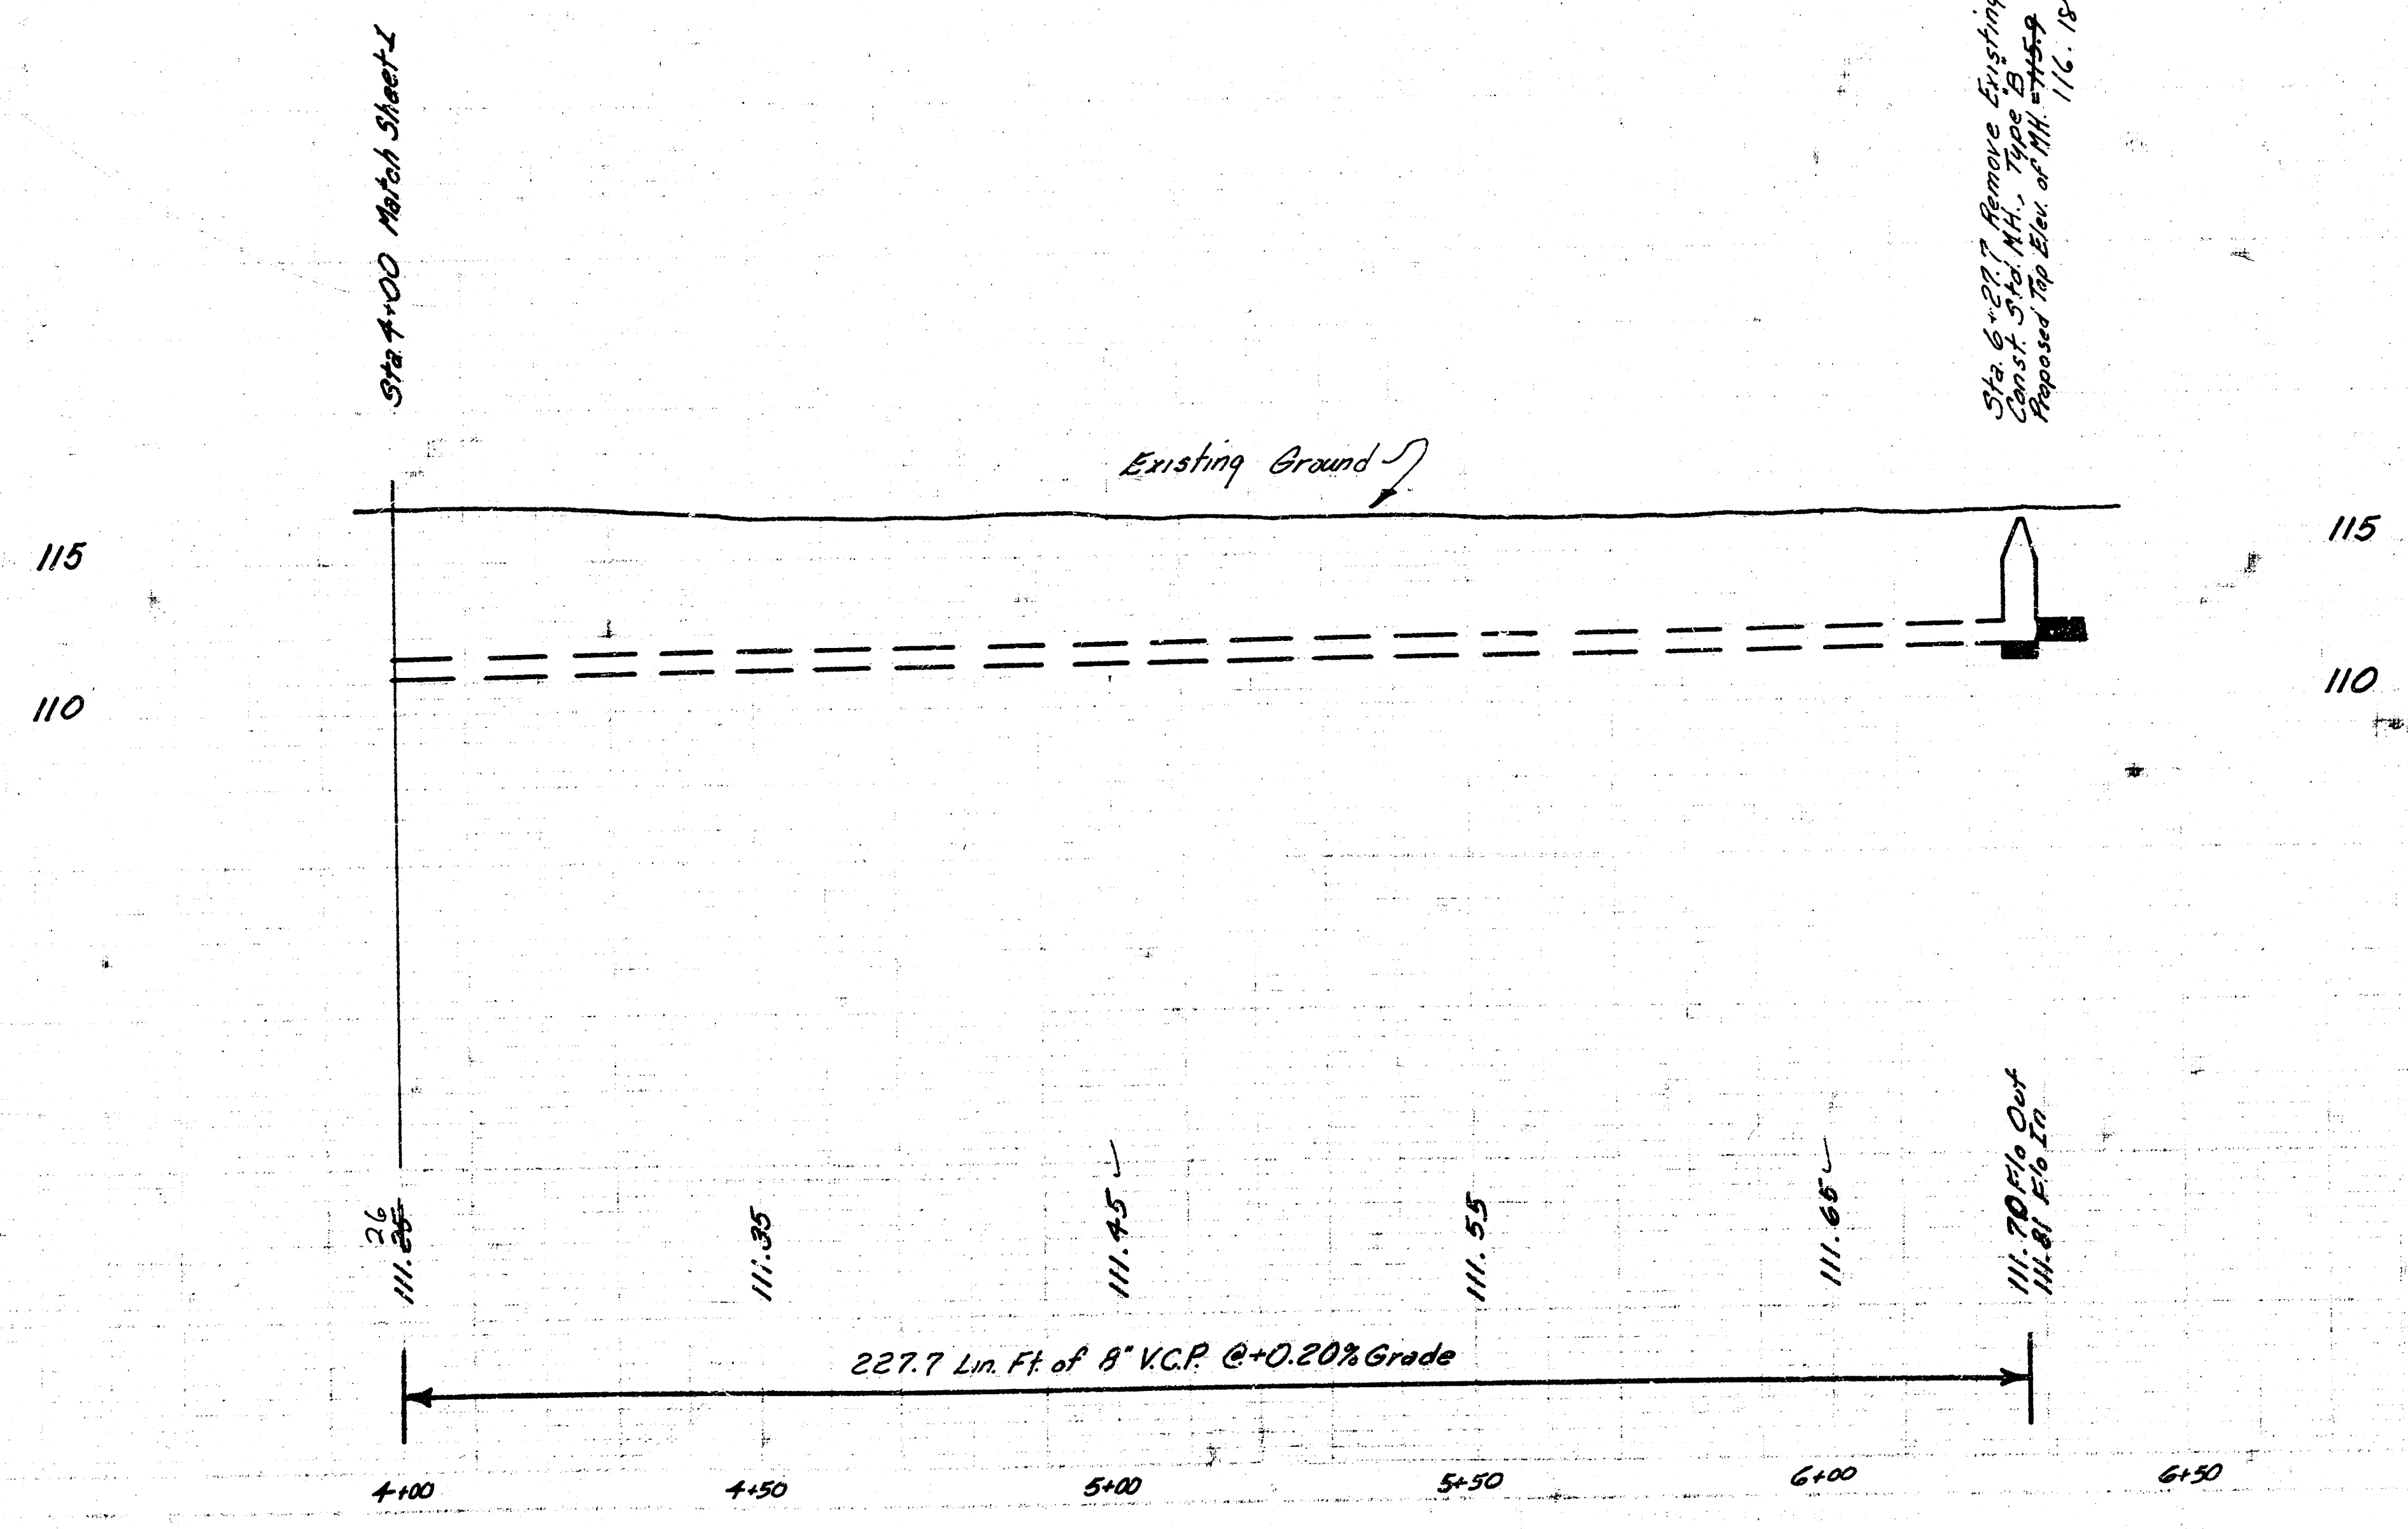

PROJECT DESCRIPTION
RECONSTRUCT A PORTION OF:
East Submain "D", S.S. 0.1
PROJECT NUMBER
458-7-245-81200-000-000-001

FILMED FROM THE BEST