
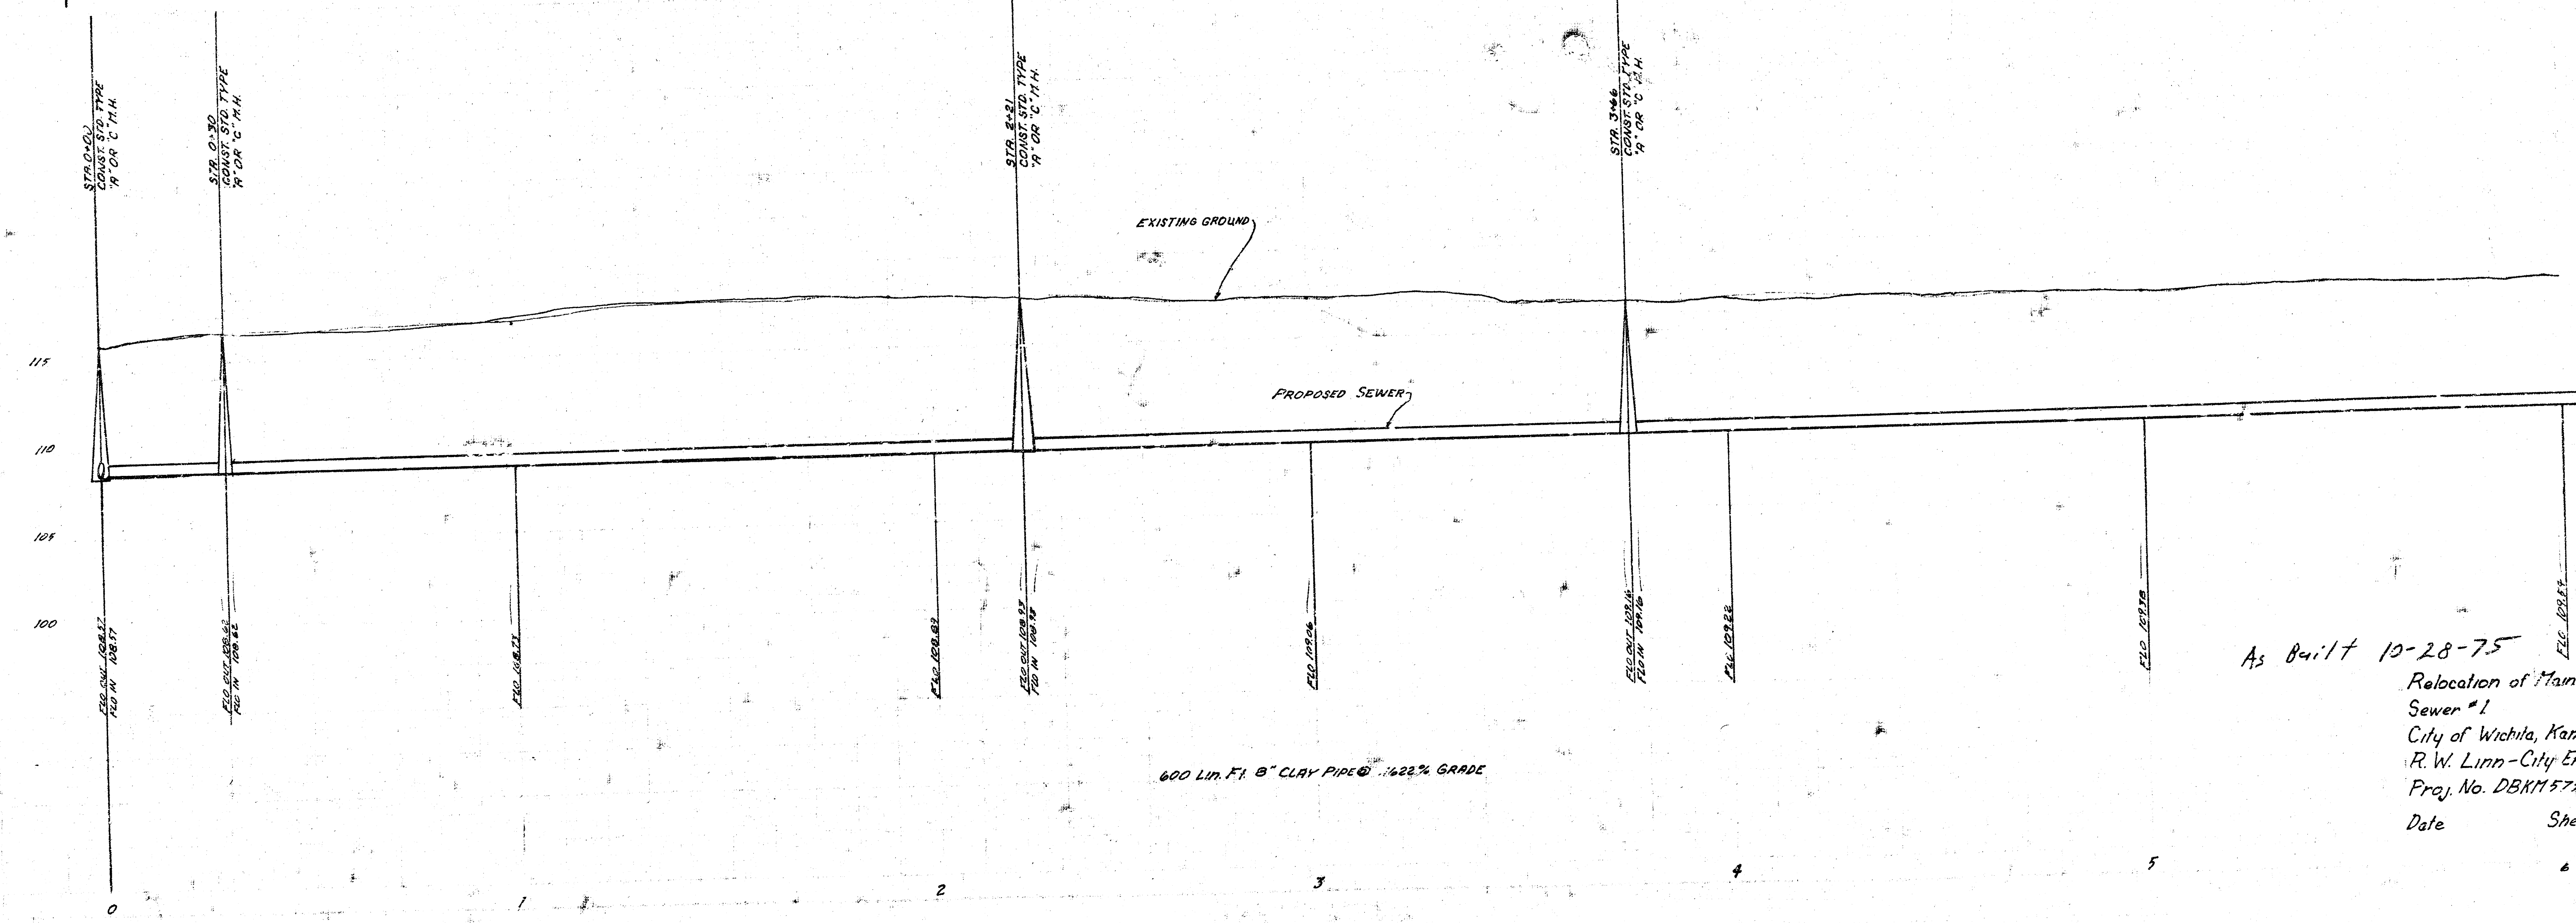


B.M. 116.18 City and 32' S of 26' W of E's Washington 1/3"

NOTES:



1. EXTREME CAUTION TO BE USED WHEN DITCHING BETWEEN STA. 2+21 & STA. 3+66 DUE TO NUMEROUS UNDERGROUND PRIVATE UTILITIES.
2. CONTRACTOR TO CONTACT MR. CHARLES WESTMORELAND OF CARGILL, INC. TO COORDINATE SEWER CONSTRUCTION WITH PLANT OPERATION.

SCALES
PLAN: 1"=20'
PROFILE: VERT 1"=20'
VERT 1"=5'

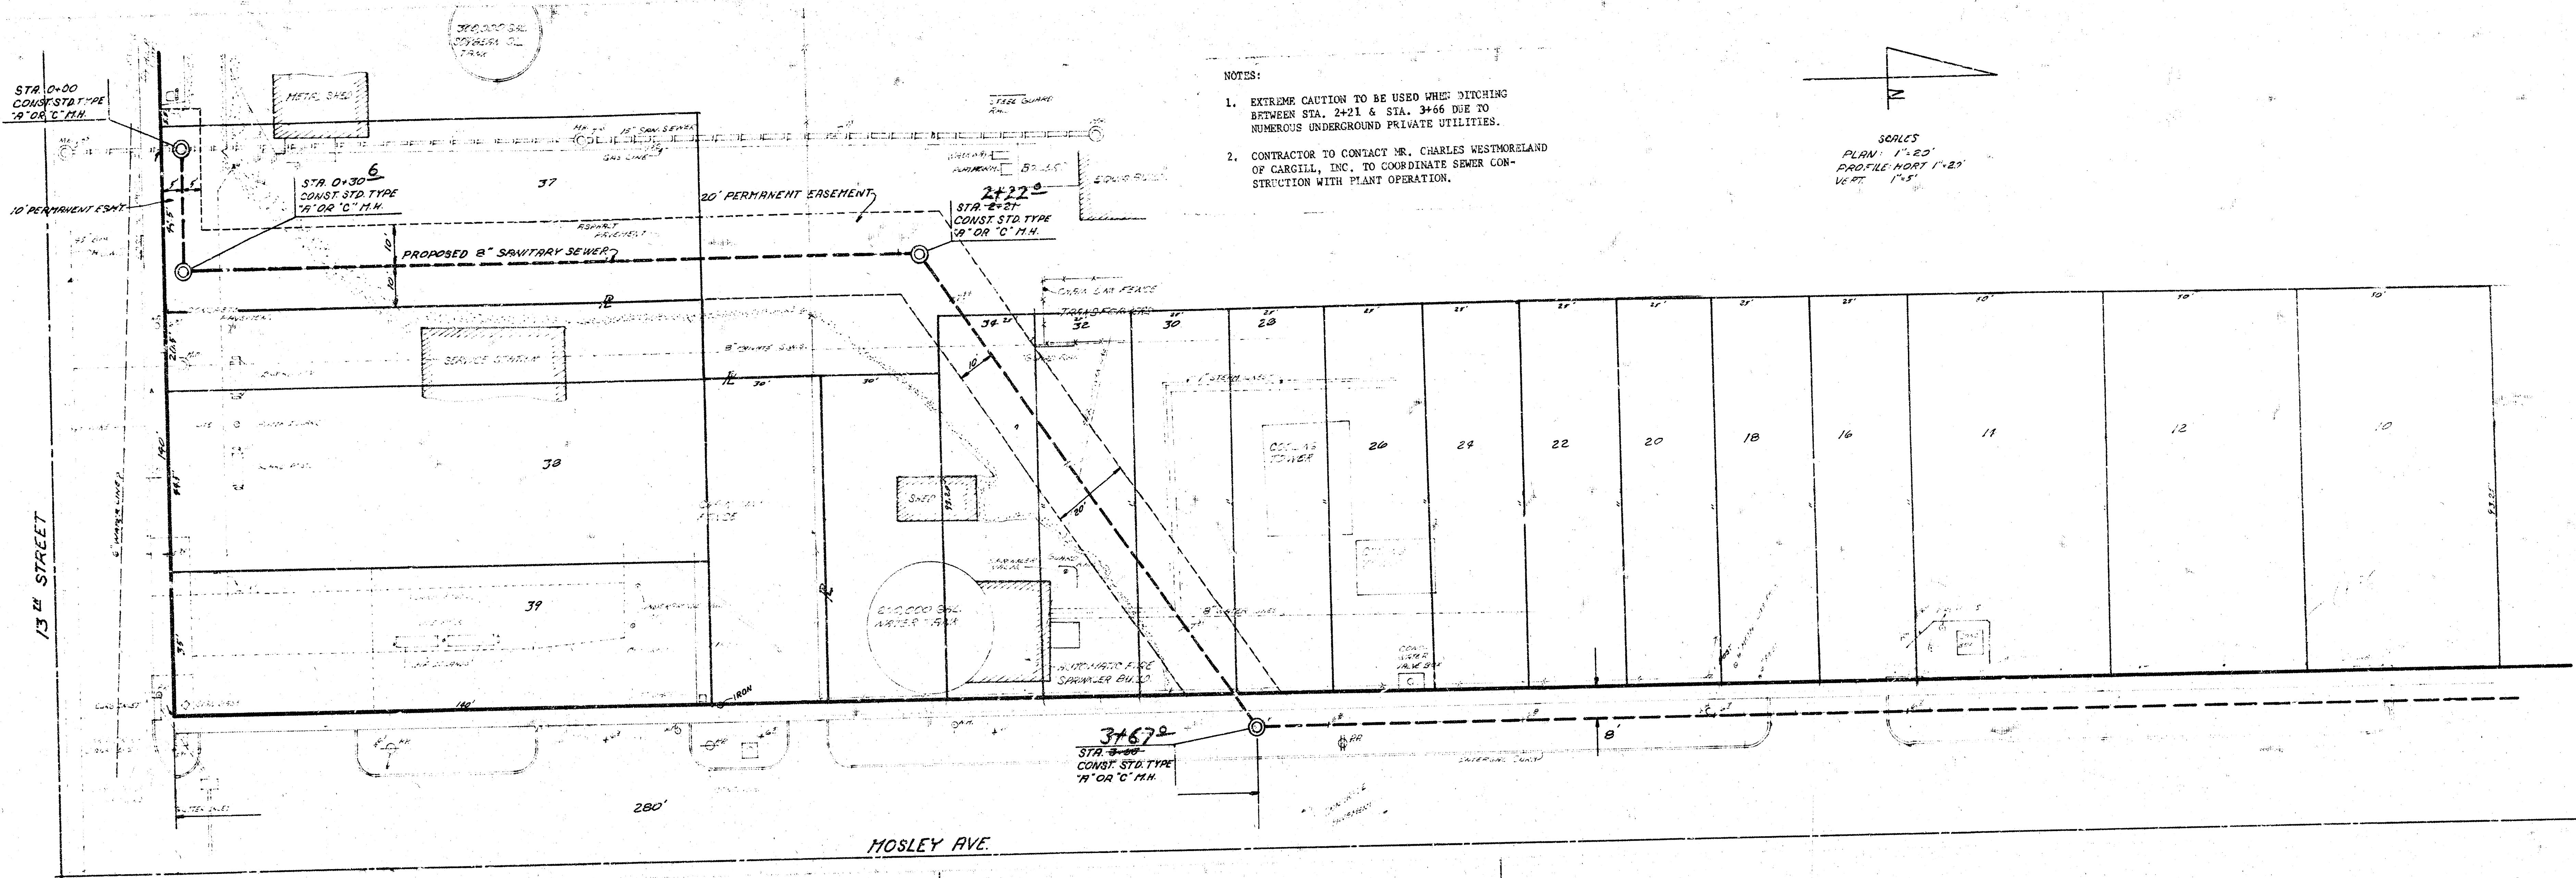

As Built 10-28-75
Relocation of Main 'D' Sanitary
Sewer #1
City of Wichita, Kansas
R.W. Linn - City Engineer
Proj. No. DBK11571002
Date Sheet

B.M. 116.18 City Standard 32° So. & 26° W. of Q's Washington & 13th

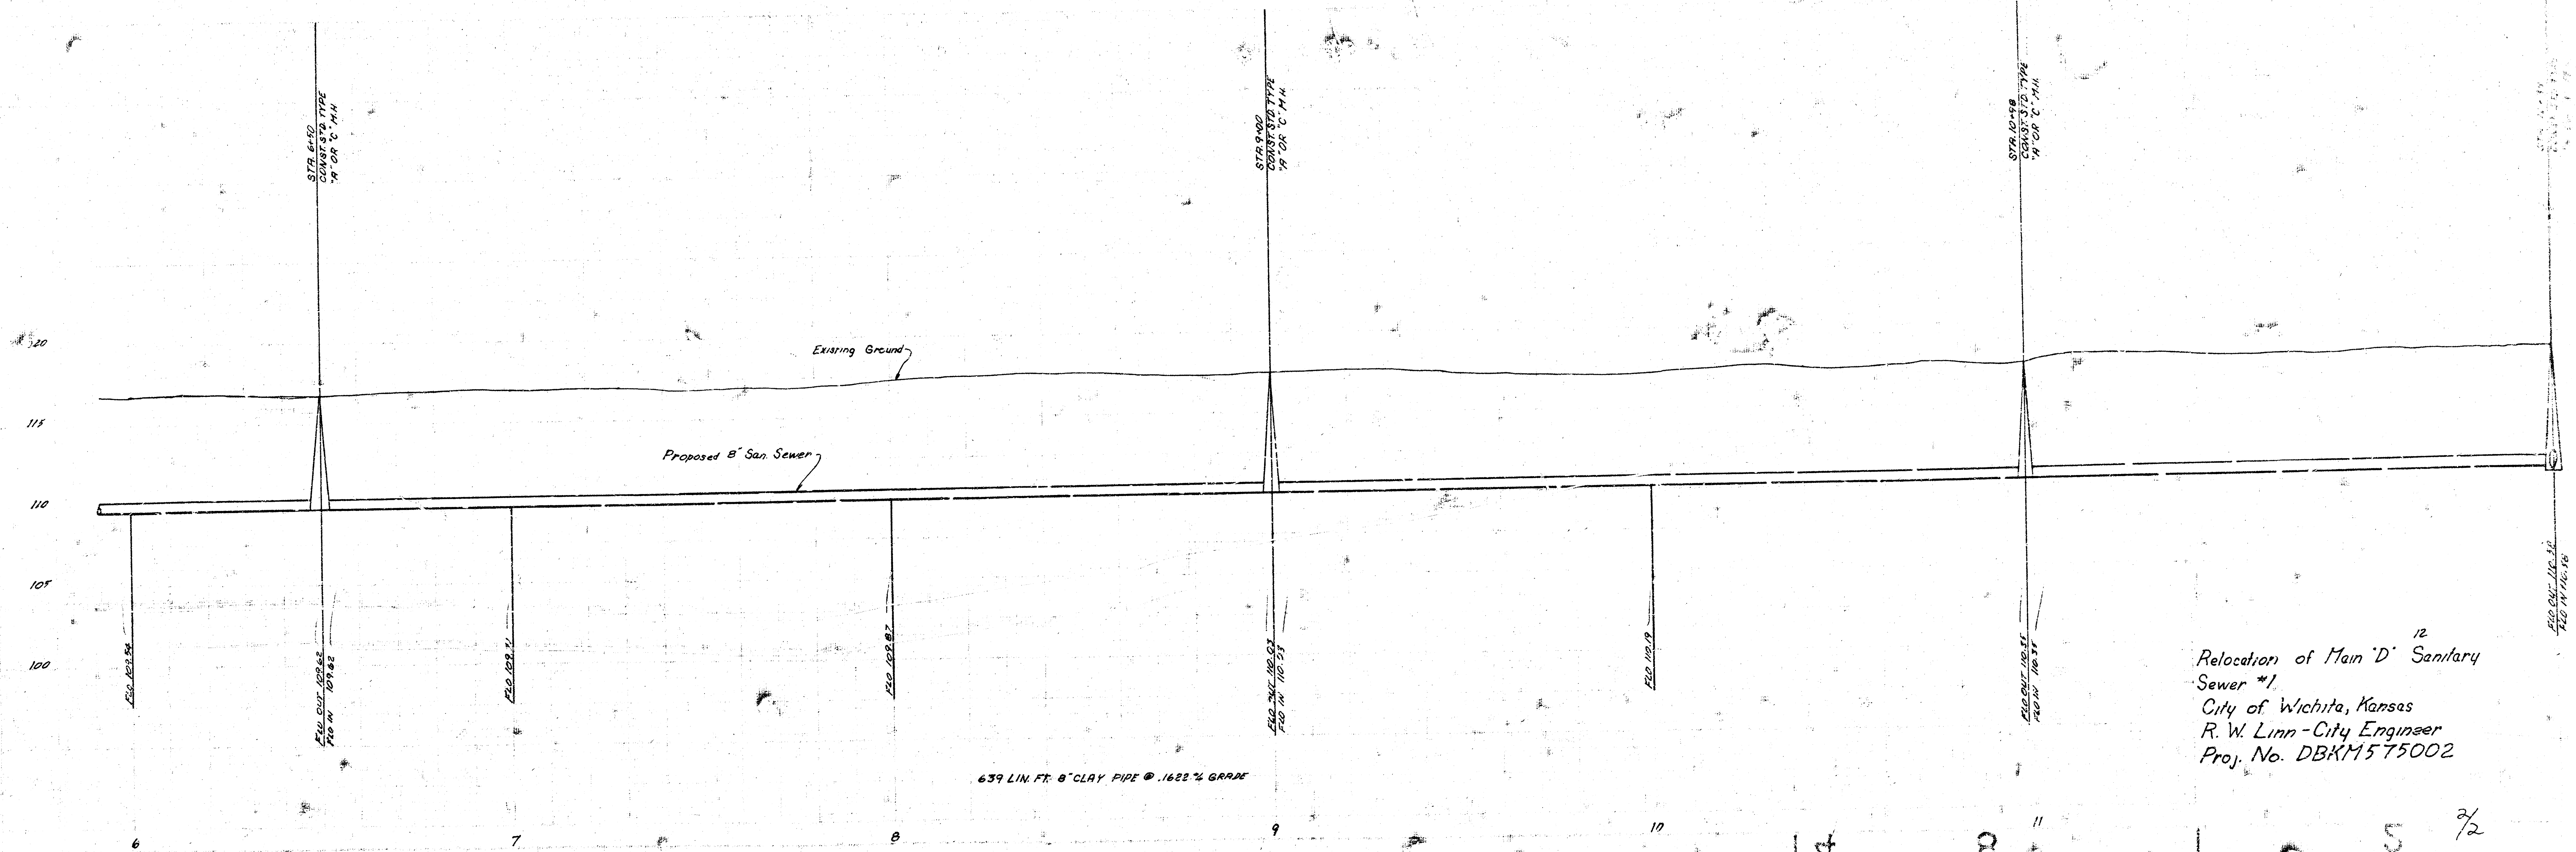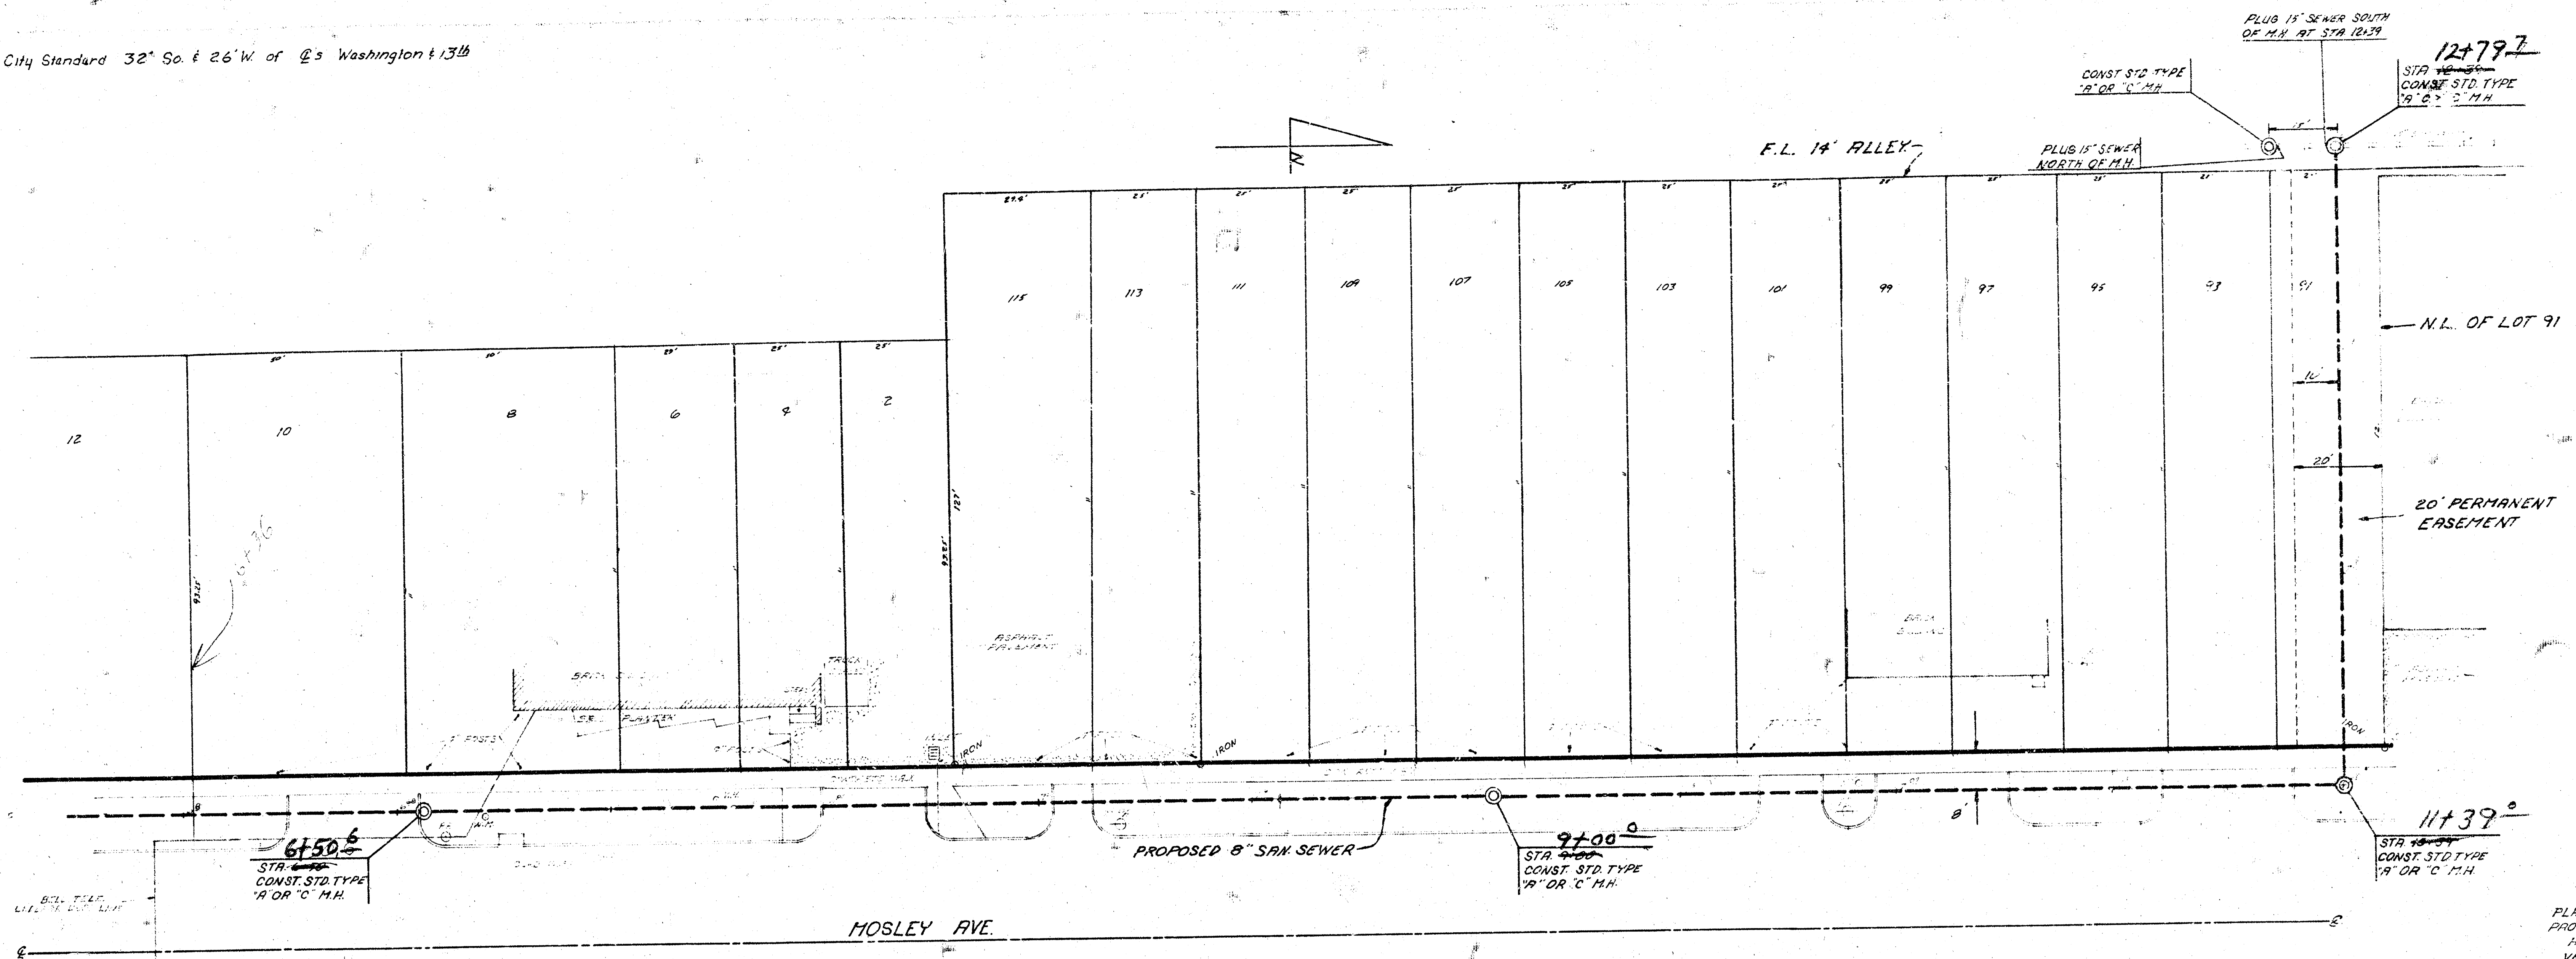

Relocation of Main 'D' Sanitary
Sewer #1.
City of Wichita, Kansas
R. W. Linn - City Engineer
Proj. No. DBKM575002

SCALE
PLAN: 1"=20'
PROFILE: 1"=20'
VERT: 1"=5'

639 LIN. FT. 8" CLAY PIPE @ .1622% GRADE