

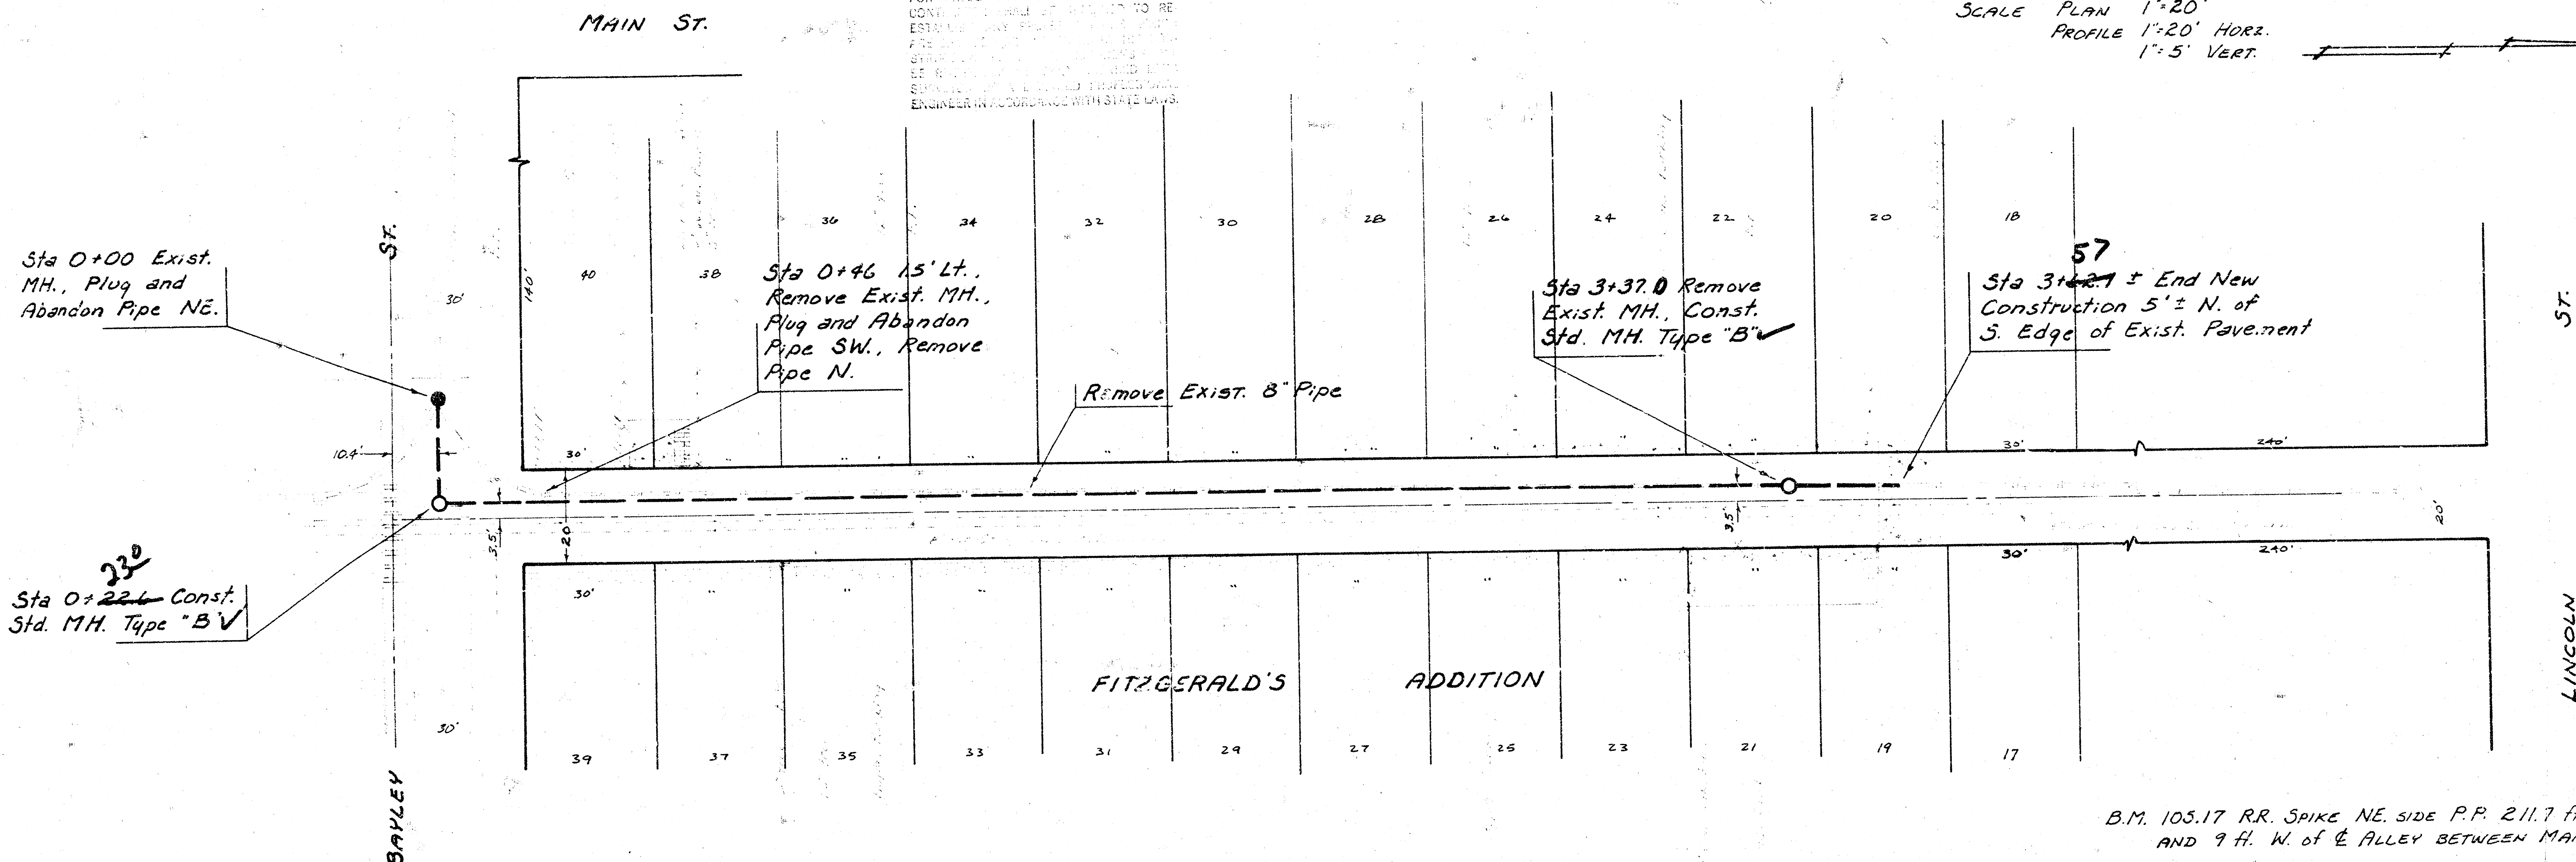


THE CONTRACTOR SHALL BE RESPONSIBLE FOR FURNISHING LABOR, TOOLS, THE CONTRACTOR SHALL BE RESPONSIBLE FOR ESTABLISHING THE LOCATION OF THE PROPOSED NEW PAVEMENT AND APPROX. EXIST. GROUND. THE CONTRACTOR SHALL BE RESPONSIBLE FOR ESTABLISHING THE LOCATION OF THE PROPOSED NEW PAVEMENT AND APPROX. EXIST. GROUND. THE CONTRACTOR SHALL BE RESPONSIBLE FOR ESTABLISHING THE LOCATION OF THE PROPOSED NEW PAVEMENT AND APPROX. EXIST. GROUND.


SCALE PLAN 1"=20'
PROFILE 1"=20' HORIZ.
1"=5' VERT.

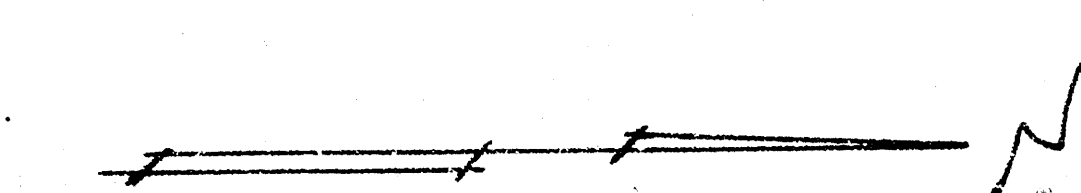

B.M. 103.17 R.R. SPIKE NE. SIDE P.P. 211.7 H. N. of E. BAYLEY AND 9 H. N. of E. ALLEY BETWEEN MAIN AND MARKET.

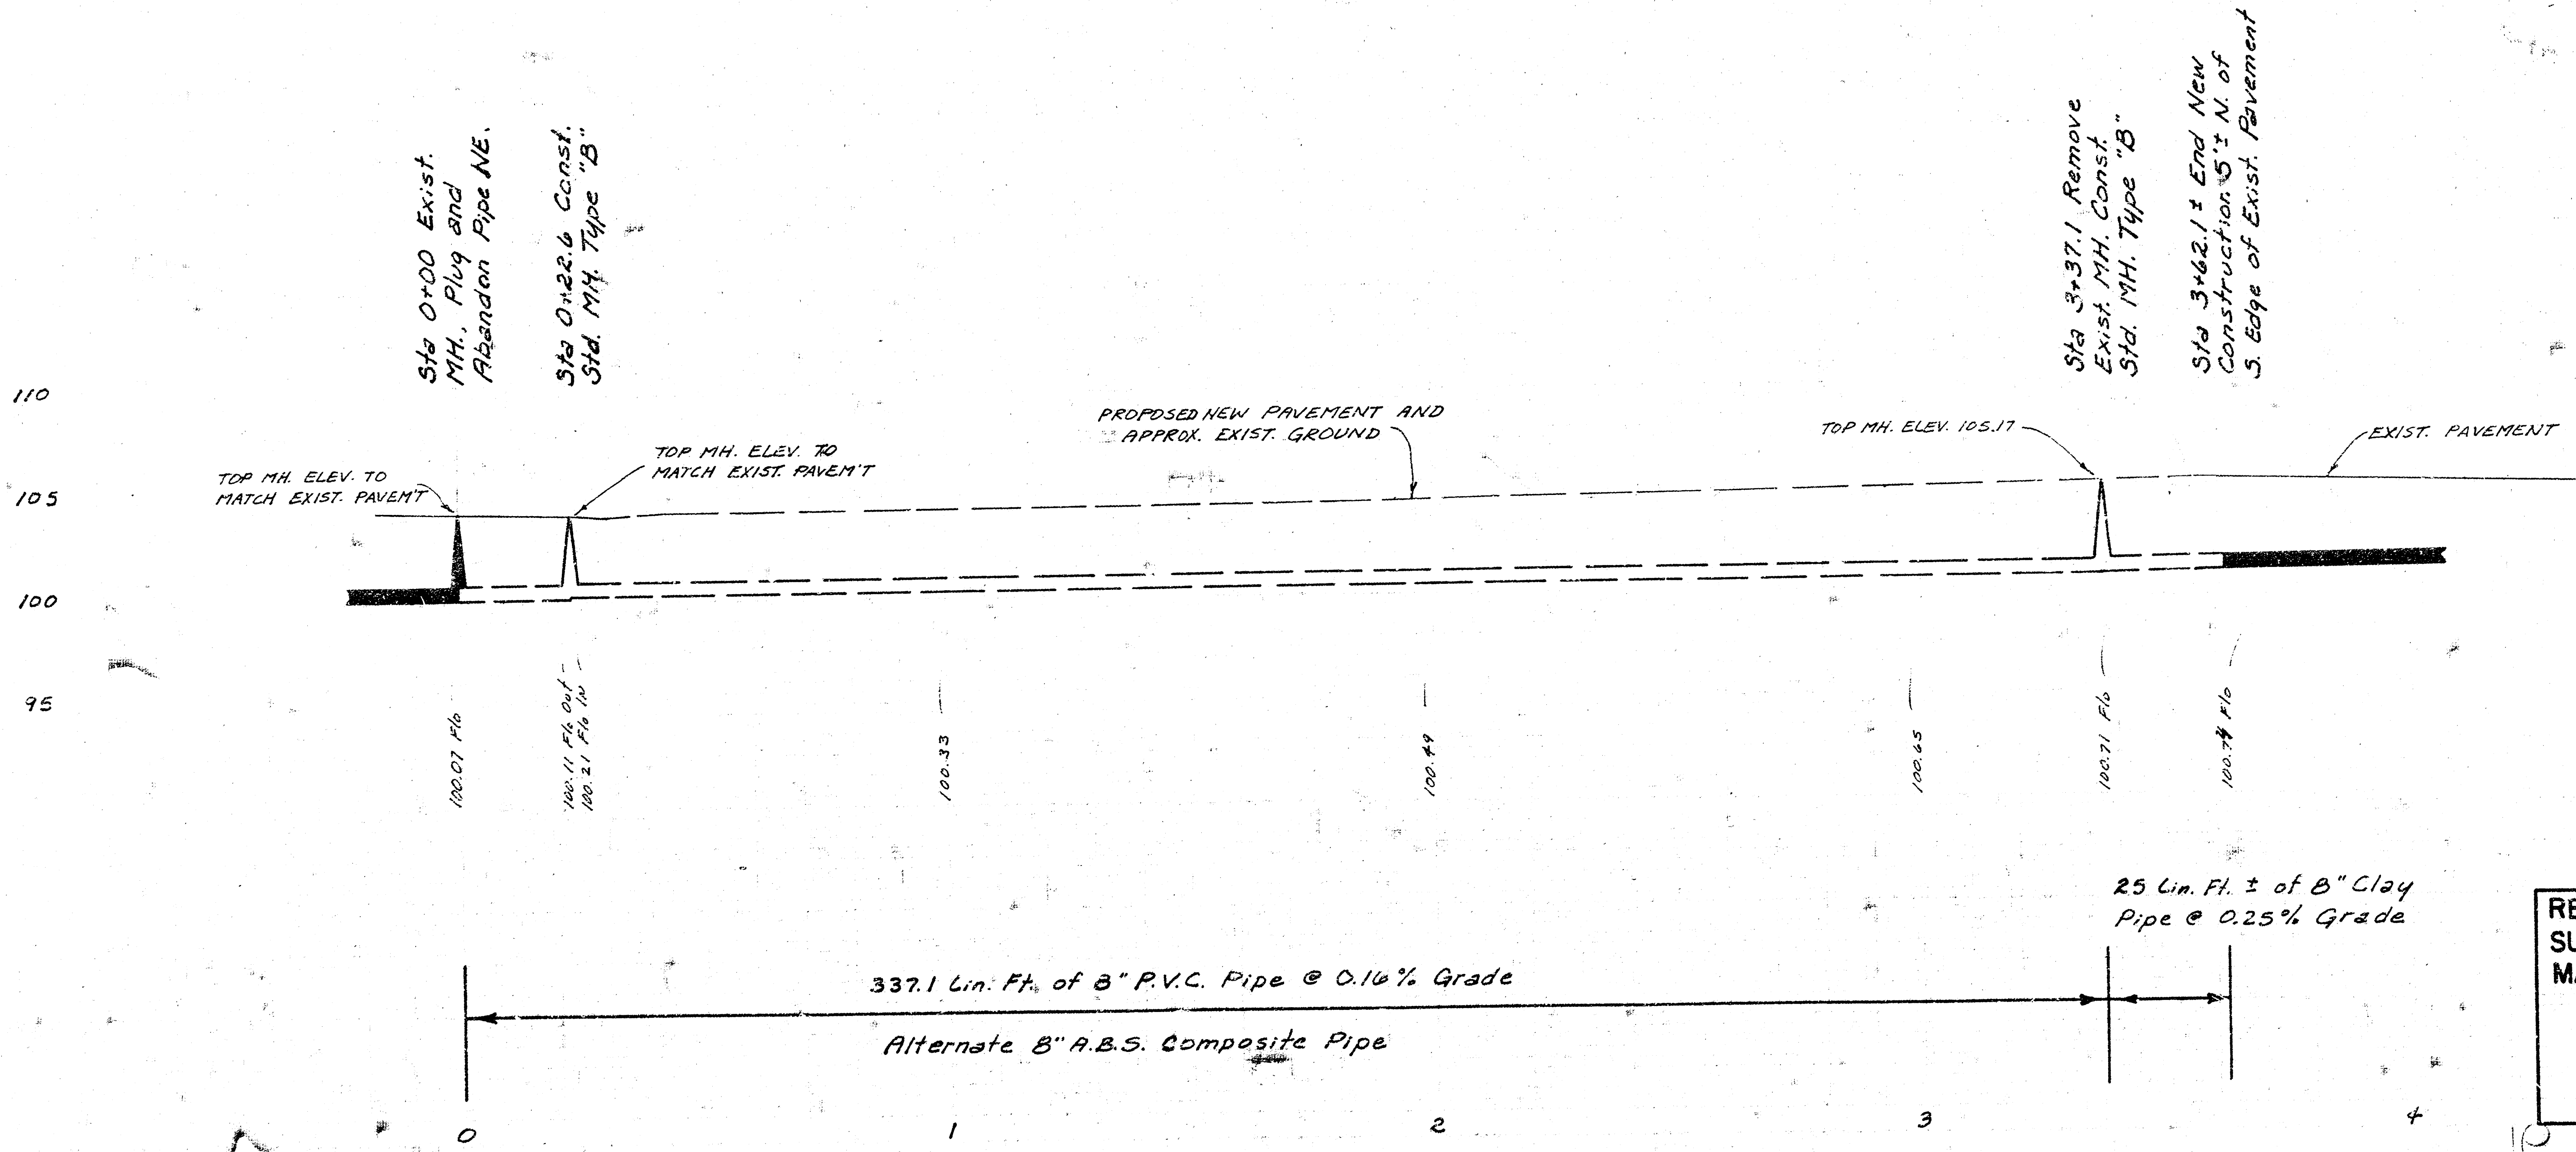

As Built
JSL
2/82

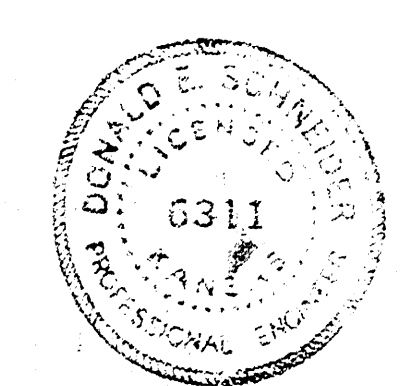

RECONSTRUCTION OF A PORTION OF LAT. N, EAST
SUBMAIN A, S.S. NO. 1 IN THE ALLEY BETWEEN
MAIN AND MARKET FROM BAYLEY TO LINCOLN
CITY OF WICHITA, KANSAS
R.W. BRUGGEMAN
DIRECTOR OF ENGINEERING - CITY ENGINEER
PROJ. NO. 542-80-245-80035-000-000-001